ILLINOIS ROUTE 38 (ROOSEVELT ROAD)

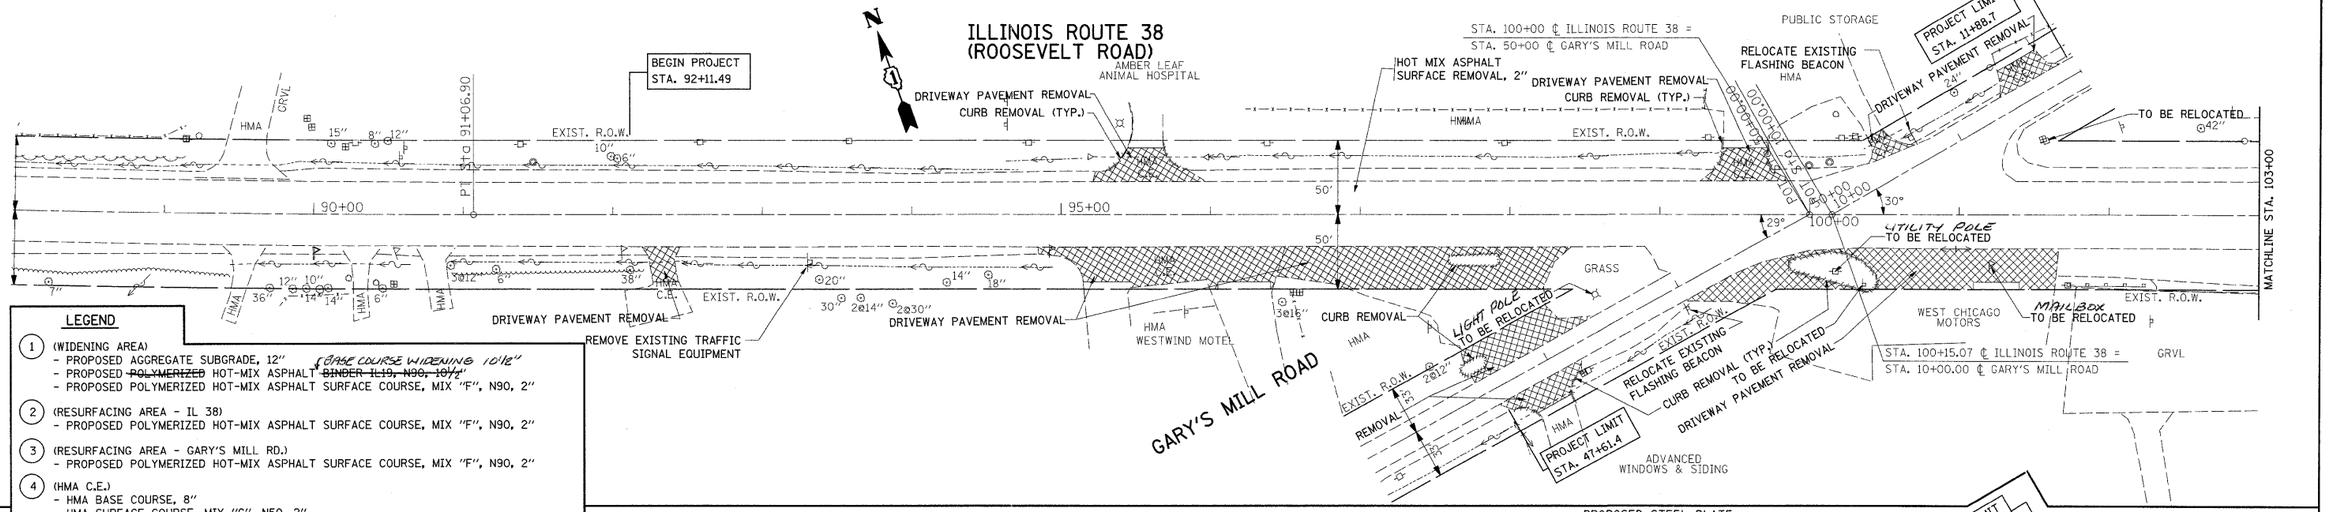

LEGEND

1. (WIDENING AREA)
   - PROPOSED AGGREGATE SUBGRADE, 12″
   - PROPOSED ~~POLYMERIZED~~ HOT-MIX ASPHALT ~~BINDER IL19, N90, 10½″~~ (BASE COURSE WIDENING 10½″)
   - PROPOSED POLYMERIZED HOT-MIX ASPHALT SURFACE COURSE, MIX "F", N90, 2″
2. (RESURFACING AREA - IL 38)
   - PROPOSED POLYMERIZED HOT-MIX ASPHALT SURFACE COURSE, MIX "F", N90, 2″
3. (RESURFACING AREA - GARY'S MILL RD.)
   - PROPOSED POLYMERIZED HOT-MIX ASPHALT SURFACE COURSE, MIX "F", N90, 2″
4. (HMA C.E.)
   - HMA BASE COURSE, 8″
   - HMA SURFACE COURSE, MIX "C", N50, 2″
5. (HMA P.E.)
   - HMA BASE COURSE, 6″
   - HMA SURFACE COURSE, MIX "C", N50, 2″

PLAN — SURVEYED / PLOTTED / ALIGNMENT CHECKED / R.O.W. CHECKED / CADD FILE NAME / NOTE BOOK / NO. / BY / DATE

ILLINOIS ROUTE 38 (ROOSEVELT ROAD)

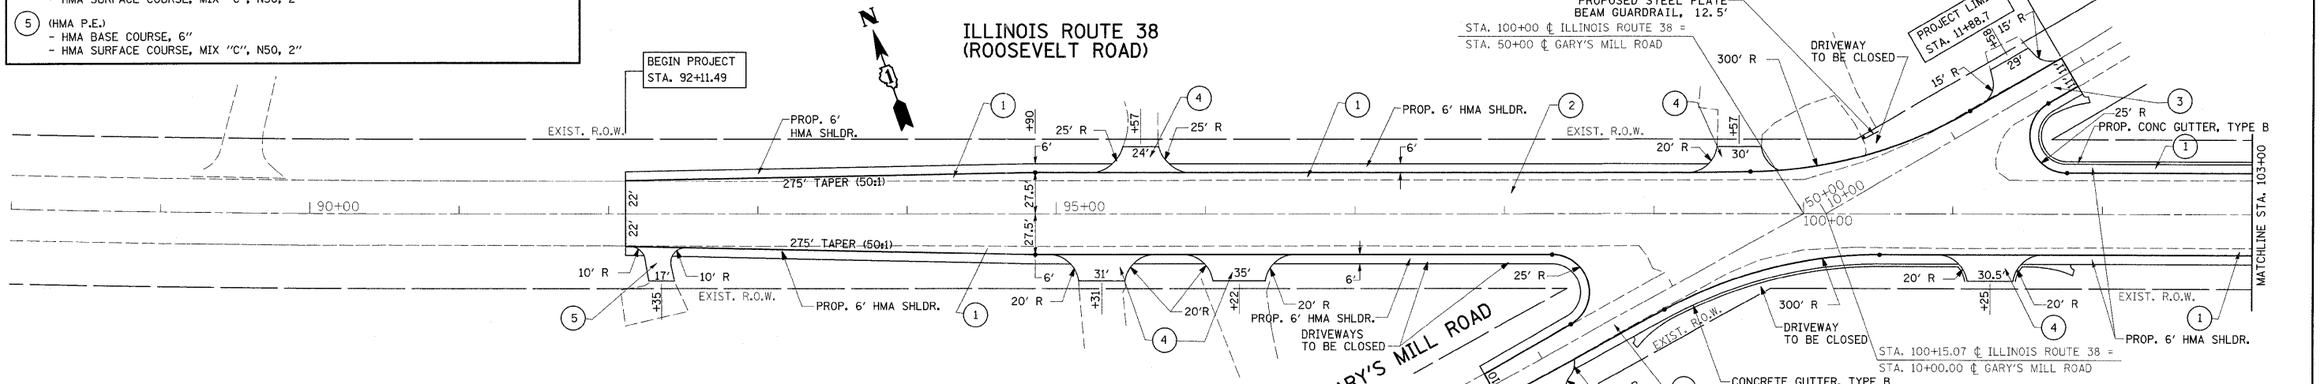

PROFILE — SURVEYED / PLOTTED / GRADES CHECKED / R.O.W. NOTED / STRUCTURE NOTATIONS CHKD / NOTE BOOK / NO. / BY / DATE

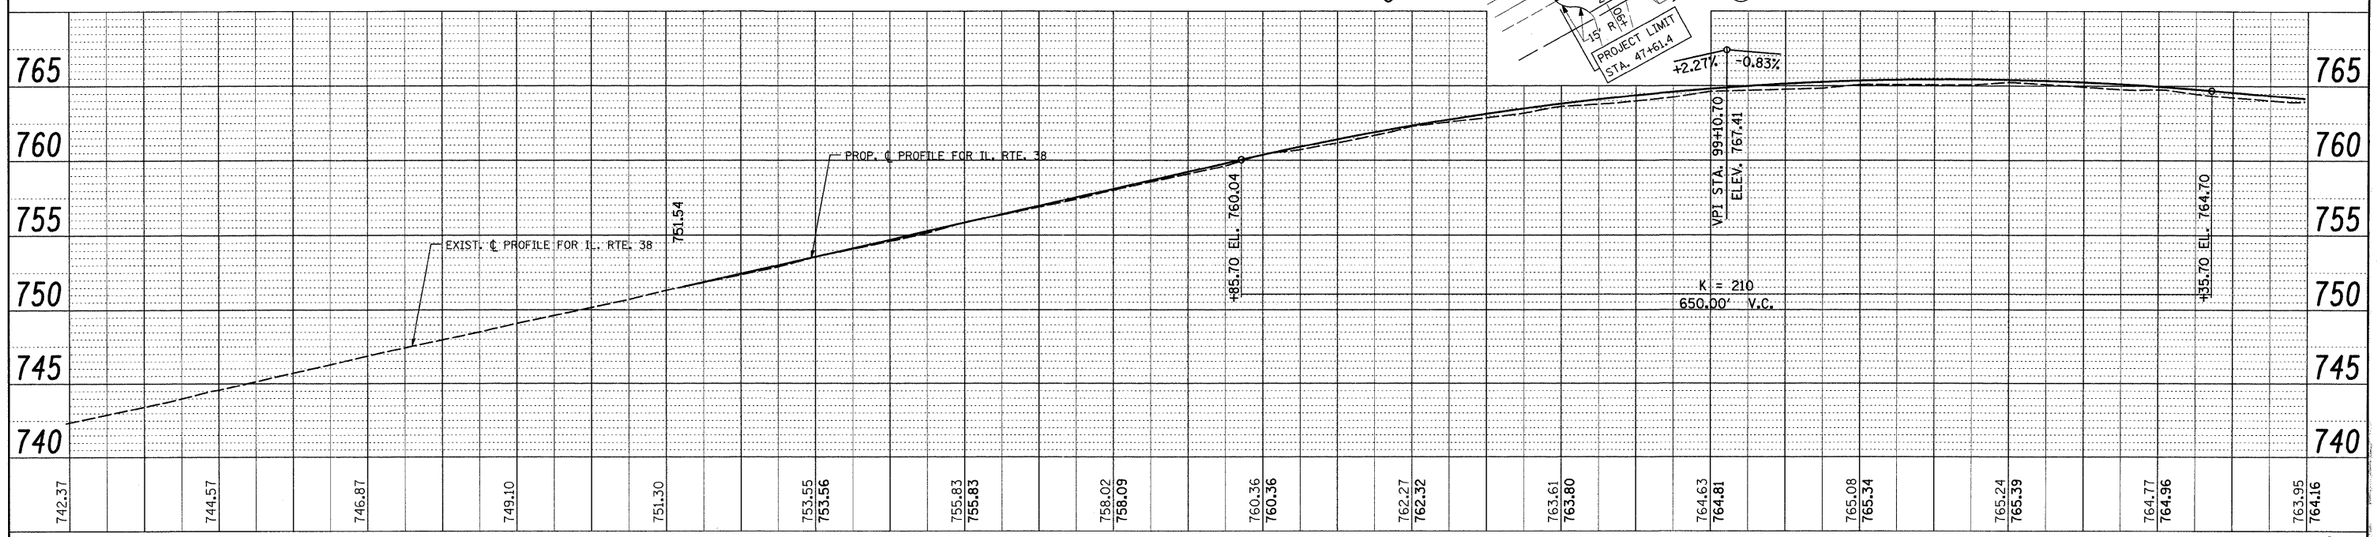

FILE NAME = c:\pw_work\PWIDOT\ULRICHKD\dms93600\P132007-sht-plan.dgn	USER NAME = ulrichkd	DESIGNED -	REVISED -	STATE OF ILLINOIS DEPARTMENT OF TRANSPORTATION	IL. ROUTE 38 AT GARY'S MILL ROAD EXIST. & PROP. ROADWAY PLAN
	PLOT SCALE = 50.0000 ′ / IN.	DRAWN -	REVISED -		SCALE: 1″=50′ | SHEET NO. OF SHEETS | STA. TO STA.
	PLOT DATE = 3/16/2009	CHECKED -	REVISED -		
		DATE -	REVISED -		

Rev.

F.A.P. RTE.	SECTION	COUNTY	TOTAL SHEETS	SHEET NO.
347	2 Y-N	DUPAGE	40	8
		CONTRACT NO. 60E65		
FED. ROAD DIST. NO. 1	ILLINOIS	FED. AID PROJECT		