CONTRACT NO. 62417

F.A. RTE.	SECTION	COUNTY	TOTAL SHEETS	SHEET NO.
	(113&114)R-5	Will	525	264
STA.		TO STA.		
FED. ROAD DIST. NO.		ILLINOIS	FED. AID PROJECT	

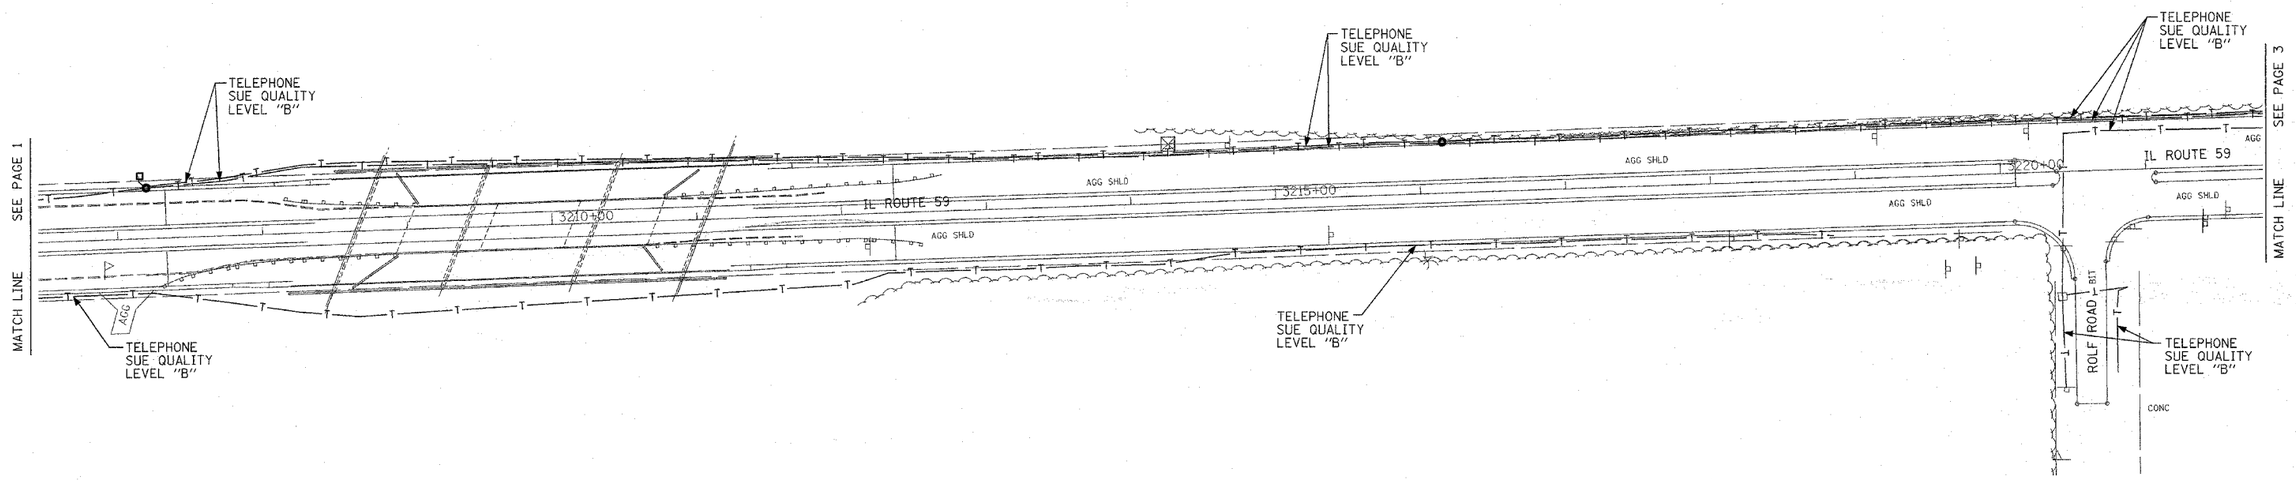

SBC will not provide TBE as-built plans for review purposes only.

TBE GROUP, INC.

CIVIL ENGINEERING * TRANSPORTATION * ENVIRONMENTAL * PLANNING * UTILITY ENGINEERING/LOCATING

SOUTHERN REGION: FL,GA,SC,NC
NORTHERN REGION: IL,IN,MI,OH,MD,NJ,NY PA,VA,CANADA
WESTERN REGION: AZ,NV,NM,TX,CA,OR,UT,WA

IL09500215, IL09500218
TBE SUE PAGE NO: 2 of 11
Checked by: Sandra Zeres PE

SUE Quality Level "A" : Test Holes
SUE Quality Level "B" : Designating

T	TELEPHONE
W	WATER
G	GAS
CTV	CABLE TELEVISION
FO	FIBER OPTIC
E	ELECTRIC
	TEST HOLE

Utilities shown on these plans as depicted in the legend have been investigated by TBE Group, Inc in accordance with SUE Industry Standards. All other information shown has been provided to TBE Group, Inc by others.

205 W. WACKER DRIVE
SUITE 1020
CHICAGO, IL 60606
(312) 704-1970

REVISIONS	
NAME	DATE

ILLINOIS DEPARTMENT OF TRANSPORTATION

SUE Investigation of Underground Utilities
Caton Farm Rd. to Renwick Rd.
Contract Number: 62417

SOL "B" DATE : 6/15/04

DRAWN BY : KLC
SCALE : 1" = 50'