Benchmarks: BM 3553 Set "+" northwest bolt of traffic signal/light base at northeast intersection of 87th St. and State St. El. 8.47

Existing Structure: None.

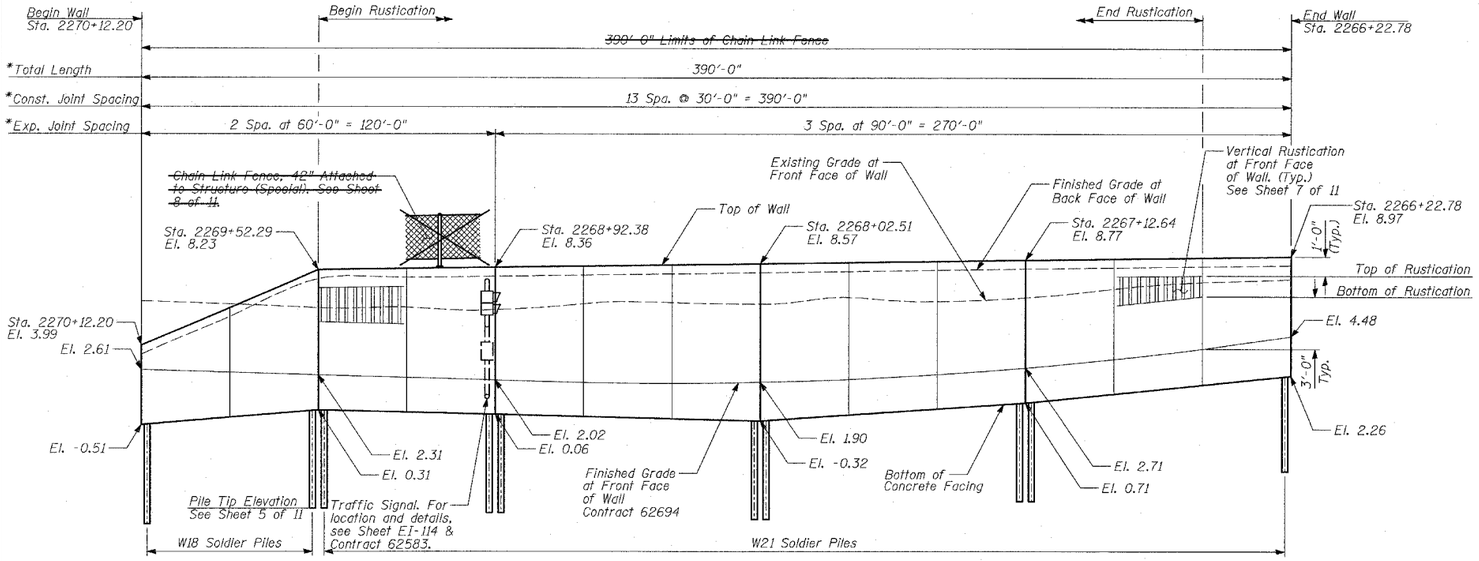

ELEVATION

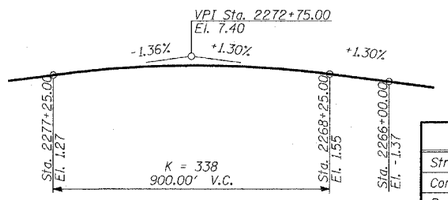

PROFILE GRADE

(N.B. I-94)

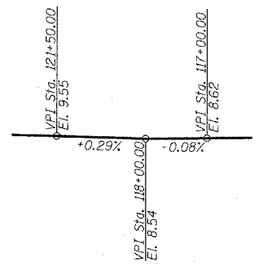

PROFILE GRADE

(State Street)

F.A.I. RTE.	SECTION	COUNTY	TOTAL SHEETS	SHEET NO.
94	*	COOK	860	563
STA. 2200+00.00	TO STA. 2362+00.00			
FED. ROAD DIST. NO.	ILLINOIS	FED. AID PROJECT		
* (1516.1, 1717 & 1818) R-8				62694

TOTAL BILL OF MATERIAL

ITEM	UNIT	TOTAL
Structure Excavation	CU YD	280
Concrete Structures	CU YD	128
Protective Coat	SQ YD	324
Rustication Finish	SQ FT	680
Stud Shear Connectors	EACH	532
Untreated Timber Lagging	SQ FT	2,280
Furnishing Soldier Piles (W Section)	FOOT	1,900
Reinforcement Bars, Epoxy Coated	POUND	11,740
Geocomposite Wall Drain	SQ YD	275
Pipe Underdrains for Structures, 6"	FOOT	390
Drilling and Setting Soldier Piles (in Soil)	CU FT	9,414
~~Chain Link Fence, 42" Attached to Structure (Special)~~	~~FOOT~~	~~390~~

DESIGN SPECIFICATION

AASHTO 2002 Standard Specifications for Highway Bridges

DESIGN STRESSES

FIELD UNITS

f'c = 3,500 psi
fy = 60,000 psi (Reinforcement)
fy = 36,000 psi (M270 Grade 36) Soldier Piles

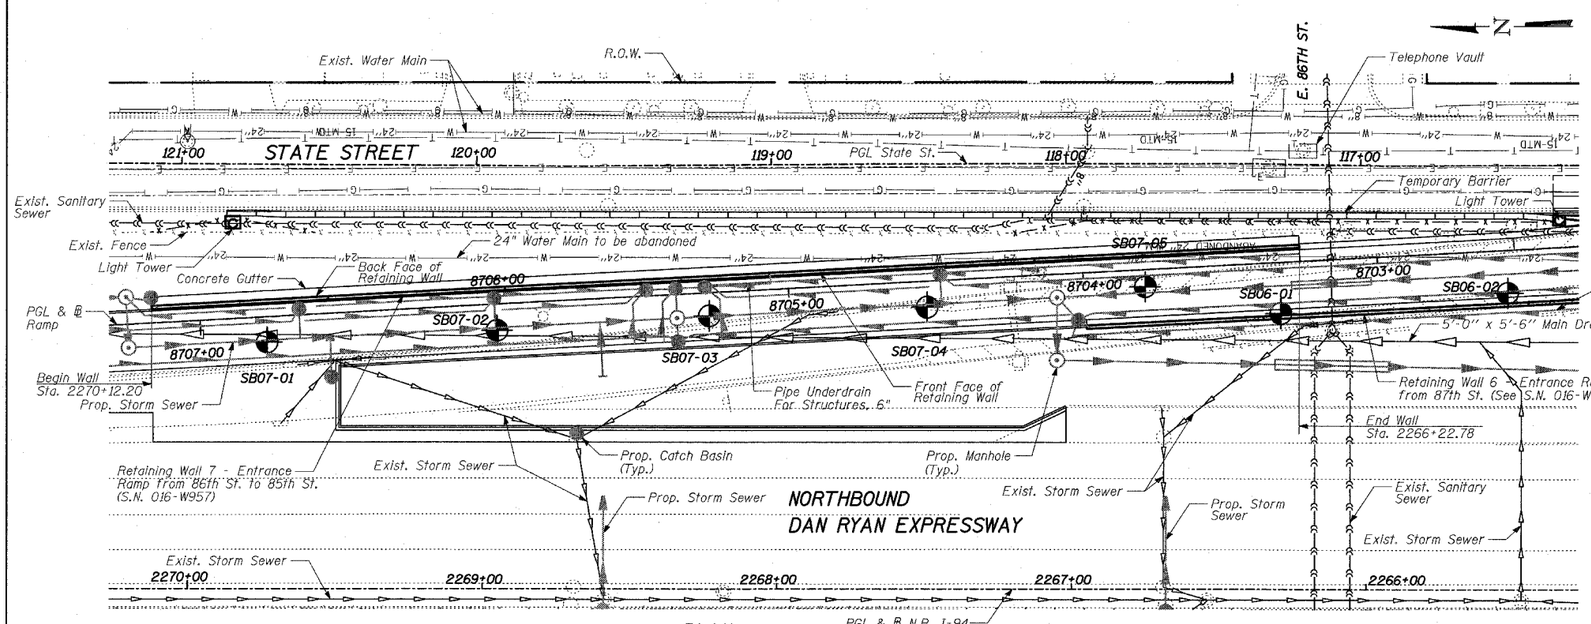

PLAN

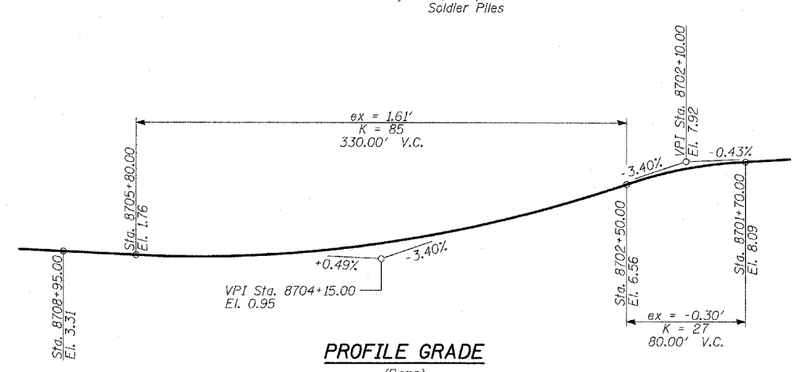

PROFILE GRADE

(Ramp)

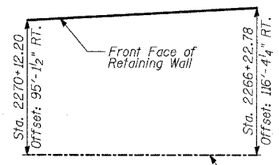

OFFSET SKETCH

INDEX OF SHEETS

1. GENERAL PLAN
2. PLAN AND ELEVATION STA. 2270+12.20 TO STA. 2268+92.38
3. PLAN AND ELEVATION STA. 2268+92.38 TO STA. 2267+12.64
4. PLAN AND ELEVATION STA. 2267+12.64 TO STA. 2266+22.78
5. PILE LAYOUT, DETAILS & BILL OF MATERIAL
6. WALL CROSS SECTIONS & DETAILS
7. RUSTICATION DETAILS
8. ~~CHAIN LINK FENCE, 42" ATTACHED TO STRUCTURE (SPECIAL)~~
9. BORING LOGS SB07-01 & SB07-02
10. BORING LOGS SB07-03 & SB07-04
11. BORING LOG SB07-05

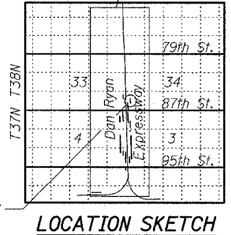

LOCATION SKETCH

LEGEND

Boring Location

* Measured along Front Face of Wall.

GENERAL NOTES:

1. Reinforcement bars shall conform to the requirements of AASHTO M31 or M322 Grade 60.
2. The Contractor is responsible for the design and performance of the lagging using no less than 3" nominal rough-sawn thickness and the minimum tabulated unit stress in bending (f_b), used in the design of timber lagging shall be 1000 psi.
3. The soldier piles shall be cleaned and given one shop coat of Inorganic Zinc-Rich primer.
4. All exposed concrete edges shall be chamfered $\frac{3}{4}$" except as noted.
5. Protective Coat shall be applied to exposed surfaces of the concrete facing.
6. Existing utilities in conflict with soldier pile wall construction shall be abandoned or relocated according to directions given on the roadway plans.
7. All construction joints shall be bonded.
8. All elevations shown are based on the Chicago City Datum of 0.00, which is 579.19 feet above mean tide New York. (NAVD 88)
9. The wall shall be backfilled (where applicable) prior to placing the concrete facing.
10. The Contractor is responsible to coordinate all electrical crossings with this Contract and with Contract 62583.

TYLIN INTERNATIONAL

STATE OF ILLINOIS
PHILLIP D. FREY
081-004826
CHICAGO, ILLINOIS
LICENSED STRUCTURAL ENGINEER

Signed Phillip D. Frey
Phillip D. Frey, S.E. IL Lic. No. 081-004826 Expires 11-30-2006.
For drawings 1 thru 11 of 11

Date 3/18/05

SHEET 1 OF 11

REVISIONS NAME	DATE
REVISED	04/15/05

ILLINOIS DEPARTMENT OF TRANSPORTATION

F.A.I. 94 (DAN RYAN EXPRESSWAY)
RETAINING WALL ALONG STATE ST.
ENTRANCE RAMP FROM 86TH ST. TO 85TH ST.
WALL 7 - GENERAL PLAN
STA. 2270+12.20 TO STA. 2266+22.78

S.N. 016-W957
SCALE: N.T.S.
DATE: MARCH 18, 2005
DESIGNED BY: MI. TB
DRAWN BY: TB, DJR
CHECKED BY: TD, MI

SOUTH STATE