F.A. RTE.	SECTION	COUNTY	TOTAL SHEETS	SHEET NO.
	(1516.1,1717 & 1818)-6	Cook	107	286
STA.		TO STA.		
FED. ROAD DIST. NO.		ILLINOIS	FED. AID PROJECT	

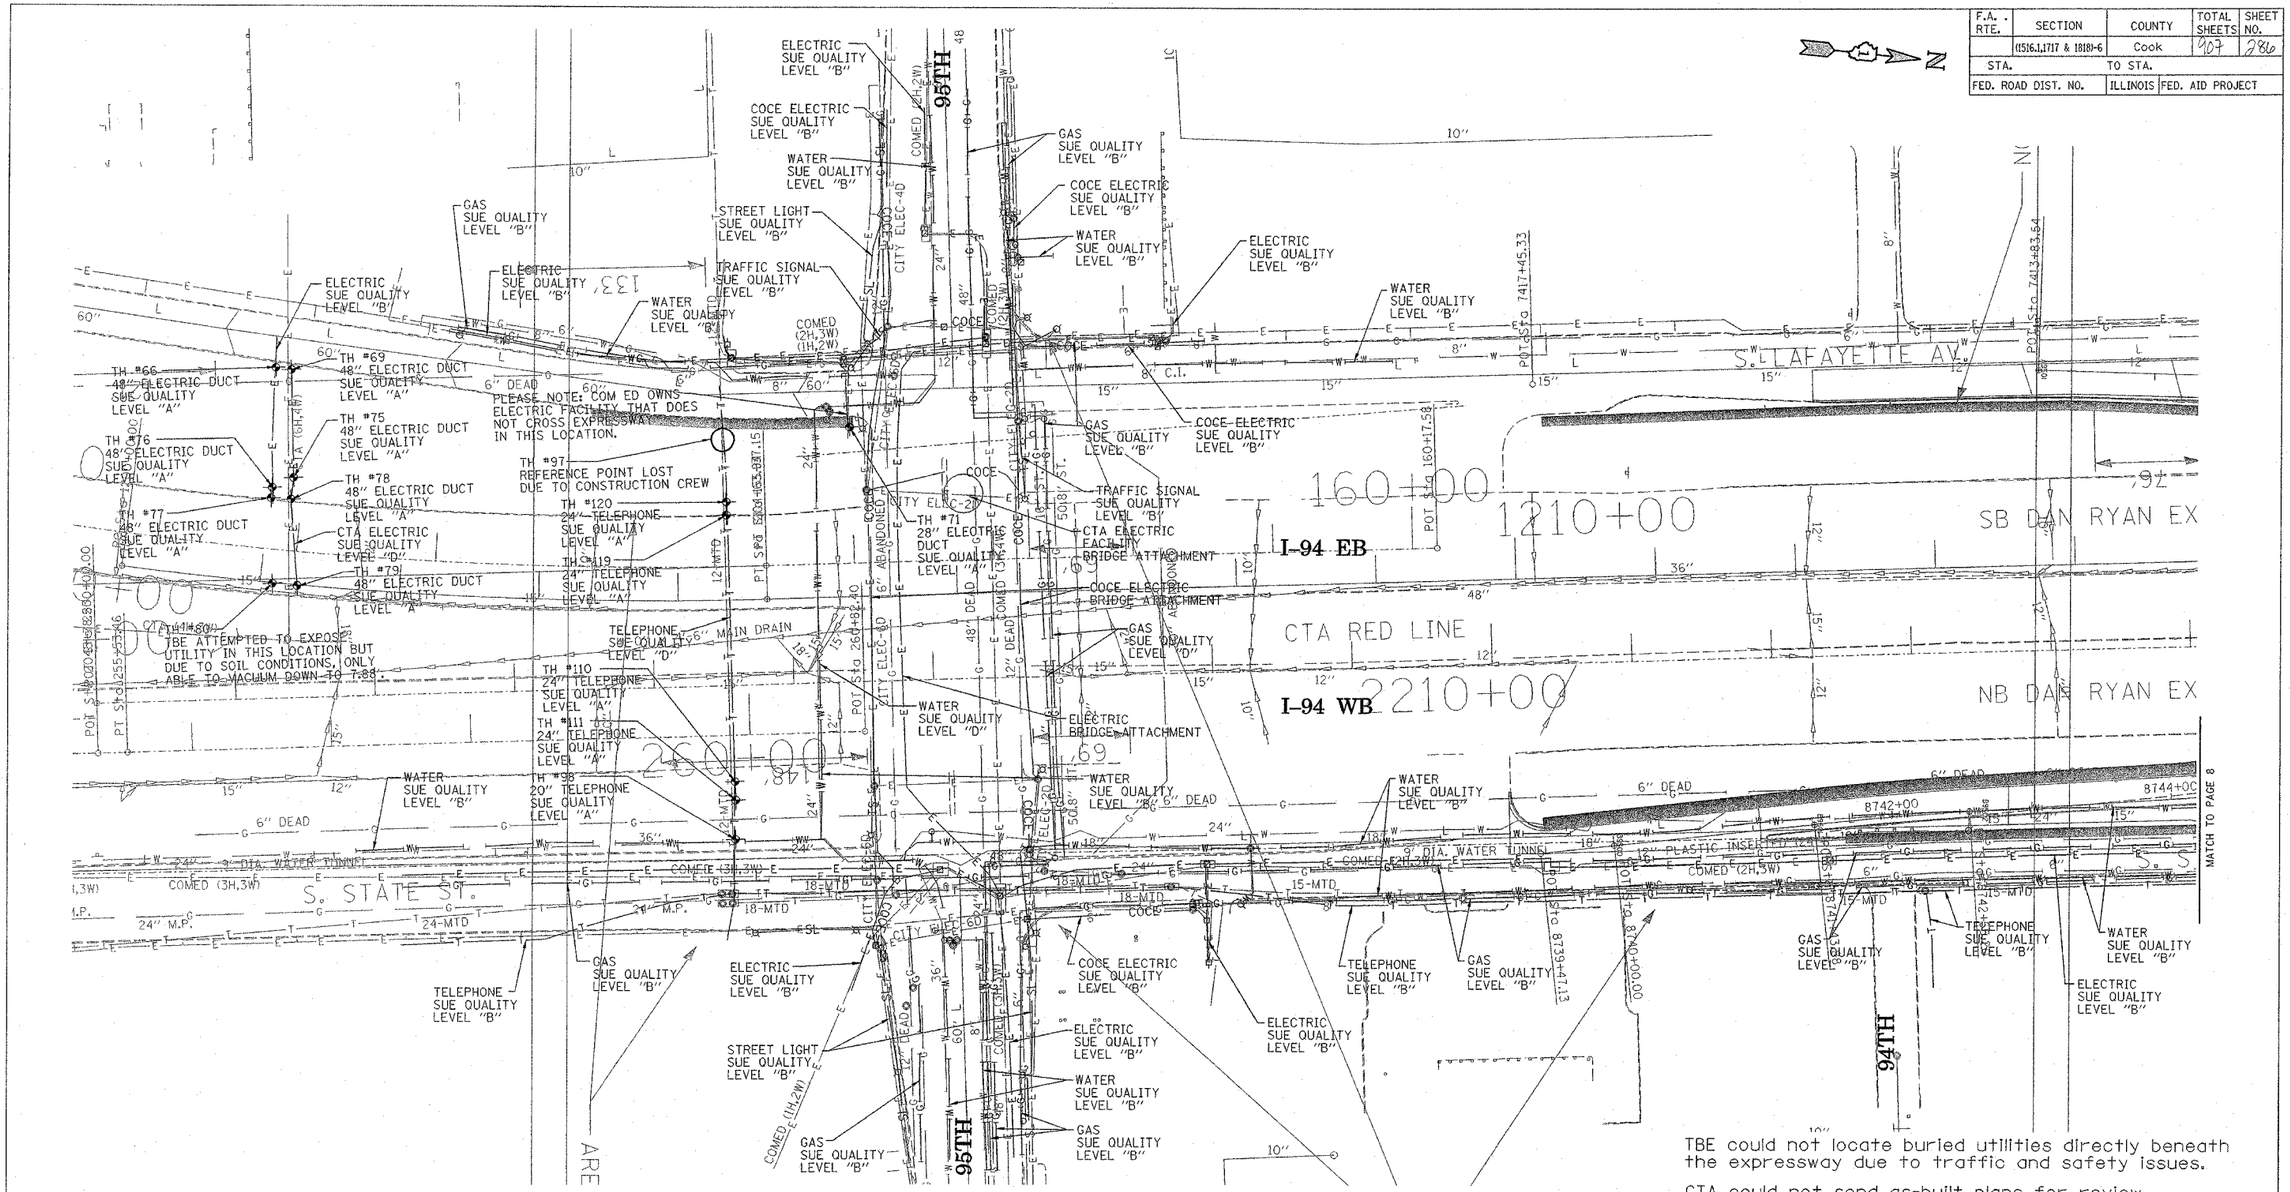

TBE could not locate buried utilities directly beneath the expressway due to traffic and safety issues.

CTA could not send as-built plans for review. TBE met with Leo Bazelewski, Testing Engineer for CTA regarding their facilities.

Size given for Electric Duct is width only.

TBE GROUP, INC.

CIVIL ENGINEERING * TRANSPORTATION * ENVIRONMENTAL * PLANNING * UTILITY ENGINEERING/LOCATING

SOUTHERN REGION: FL,GA,SC,NC
NORTHERN REGION: IL,IN,MI,OH,MD,NJ,NY PA,VA,CANADA
WESTERN REGION: AZ,NV,NM,TX,CA,OR,UT,WA

IL09500164, 167, 168, 170, 171, 179, 180, 182, 204, 205, 206, 211, 212, 219, 221, 225, 226, 227, 228, 230

TBE SUE PAGE NO: 7 of 36

Checked by: 3/4/05

SUE Quality Level "A" : Test Holes

SUE Quality Level "B" : Designating

—TS—TS— TRAFFIC SIGNAL
—SL—SL— STREET LIGHT
—COCE— CITY OF CHICAGO ELECTRIC
—T—T— TELEPHONE
—W—W— WATER
—G—G— GAS
—CTV—CTV— CABLE TELEVISION
—FO—FO— FIBER OPTIC
—E—E— ELECTRIC
TEST HOLE

Utilities shown on these plans as depicted in the legend have been investigated by TBE Group, Inc in accordance with SUE Industry Standards. All other information shown has been provided to TBE Group, Inc by others.

205 W. WACKER DRIVE
SUITE 1020
CHICAGO, IL 60606
(312) 704-1970

REVISIONS NAME	DATE

ILLINOIS DEPARTMENT OF TRANSPORTATION

SUE Investigation of Underground Utilities

I-94 NB & SB of Dan Ryan Expressway
From I-57 to 43rd Street
Contract No: 62586, 62589, 62590, 62594, 62693

SQL "A" DATE : 2/17/05
SQL "B" DATE : 7/22/04

DRAWN BY : KLC
SCALE : 1" = 50'