F.A. RTE.	SECTION	COUNTY	TOTAL SHEETS	SHEET NO.
P856	04-00128-00-TL	DUPAGE	21	10
STA.	TO STA.			
FED. ROAD DIST. NO.	ILLINOIS	FED. AID PROJECT		

CONTRACT NO. 83793

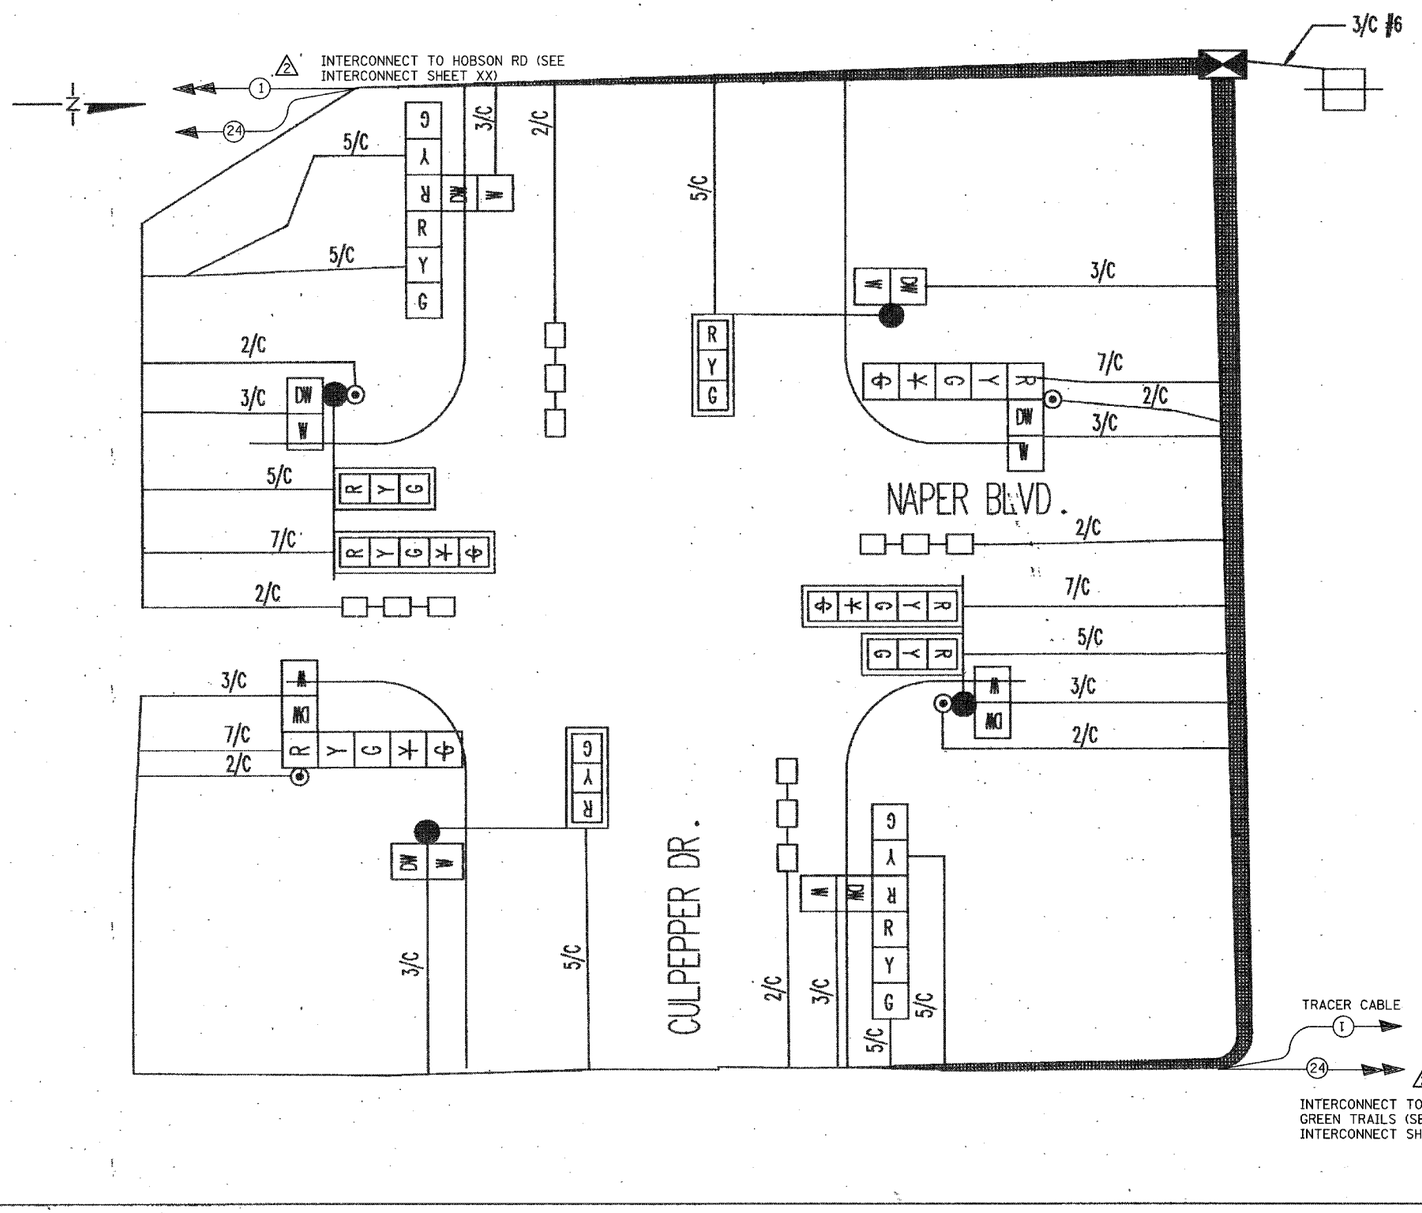

MAST ARM

SERVICE INSTALLATION

CONTROLLER

PEDESTRIAN SIGNAL - 12"

TRAFFIC SIGNAL - 12"

TRAFFIC SIGNAL WITH BACKPLATE - 12"

DETECTOR LOOP

2/C DENOTES NUMBER OF CONDUCTORS (NEW) ALL DETECTOR CABLE SHALL BE SHIELDED ALL CABLE NO. 14 EXCEPT AS INDICATED

PEDESTRIAN PUSH BUTTON DETECTOR

LEGEND

PROPOSED FIBER OPTIC CABLE IN CONDUIT, NO. 62.5/125, MM12F SM12F

PROPOSED ELECTRIC CABLE, 1/C (AS SPECIFIED)

NOTE:
PLANS ARE BASED ON EXISTING "AS-BUILT" DRAWINGS. FIELD CONDITIONS MAY VARY FROM THOSE SHOWN

⚠1 INSTALLATION OF EMERGENCY VEHICLE PREEMPTION 3-25-02 SEE REVISED PLANS PREPARED BY CHRISTOPHER BURKE ENGR.

⚠2 INSTALLATION OF FIBER OPTIC INTERCONNECT ON NAPER BLVD HOBSON TO DUNROBIN

REVISIONS

CABLE PLAN
TRAFFIC SIGNAL
NAPER BLVD. & CULPEPPER DR.
NAPERVILLE, ILLINOIS

SCALE: NONE DRAWN BY: J.B.V.
DATE: JUNE 1999 CHECKED BY: J.B.V.

SHEET 4 OF 5

REVISIONS NAME	DATE

ILLINOIS DEPARTMENT OF TRANSPORTATION
NAPER BOULEVARD INTERCONNECT
CULPEPPER DRIVE
CABLE PLAN

SCALE: NTS DRAWN BY JS
DATE CHECKED BY DJ

TYLIN INTERNATIONAL

PLOT DATE = $DATE$
FILE NAME = $FILE$
PLOT SCALE = $SCALE$
REFERENCE = REF

P:\60240\Road\Cu10P1n.dgn 05/10/2005 12:02:05 PM