F.A. RTE.	SECTION	COUNTY	TOTAL SHEETS	SHEET NO.
P856	04-00128-00-TL	DUPAGE	21	13
STA.	TO STA.			
FED. ROAD DIST. NO.	ILLINOIS	FED. AID PROJECT		

CONTRACT NO. 83793

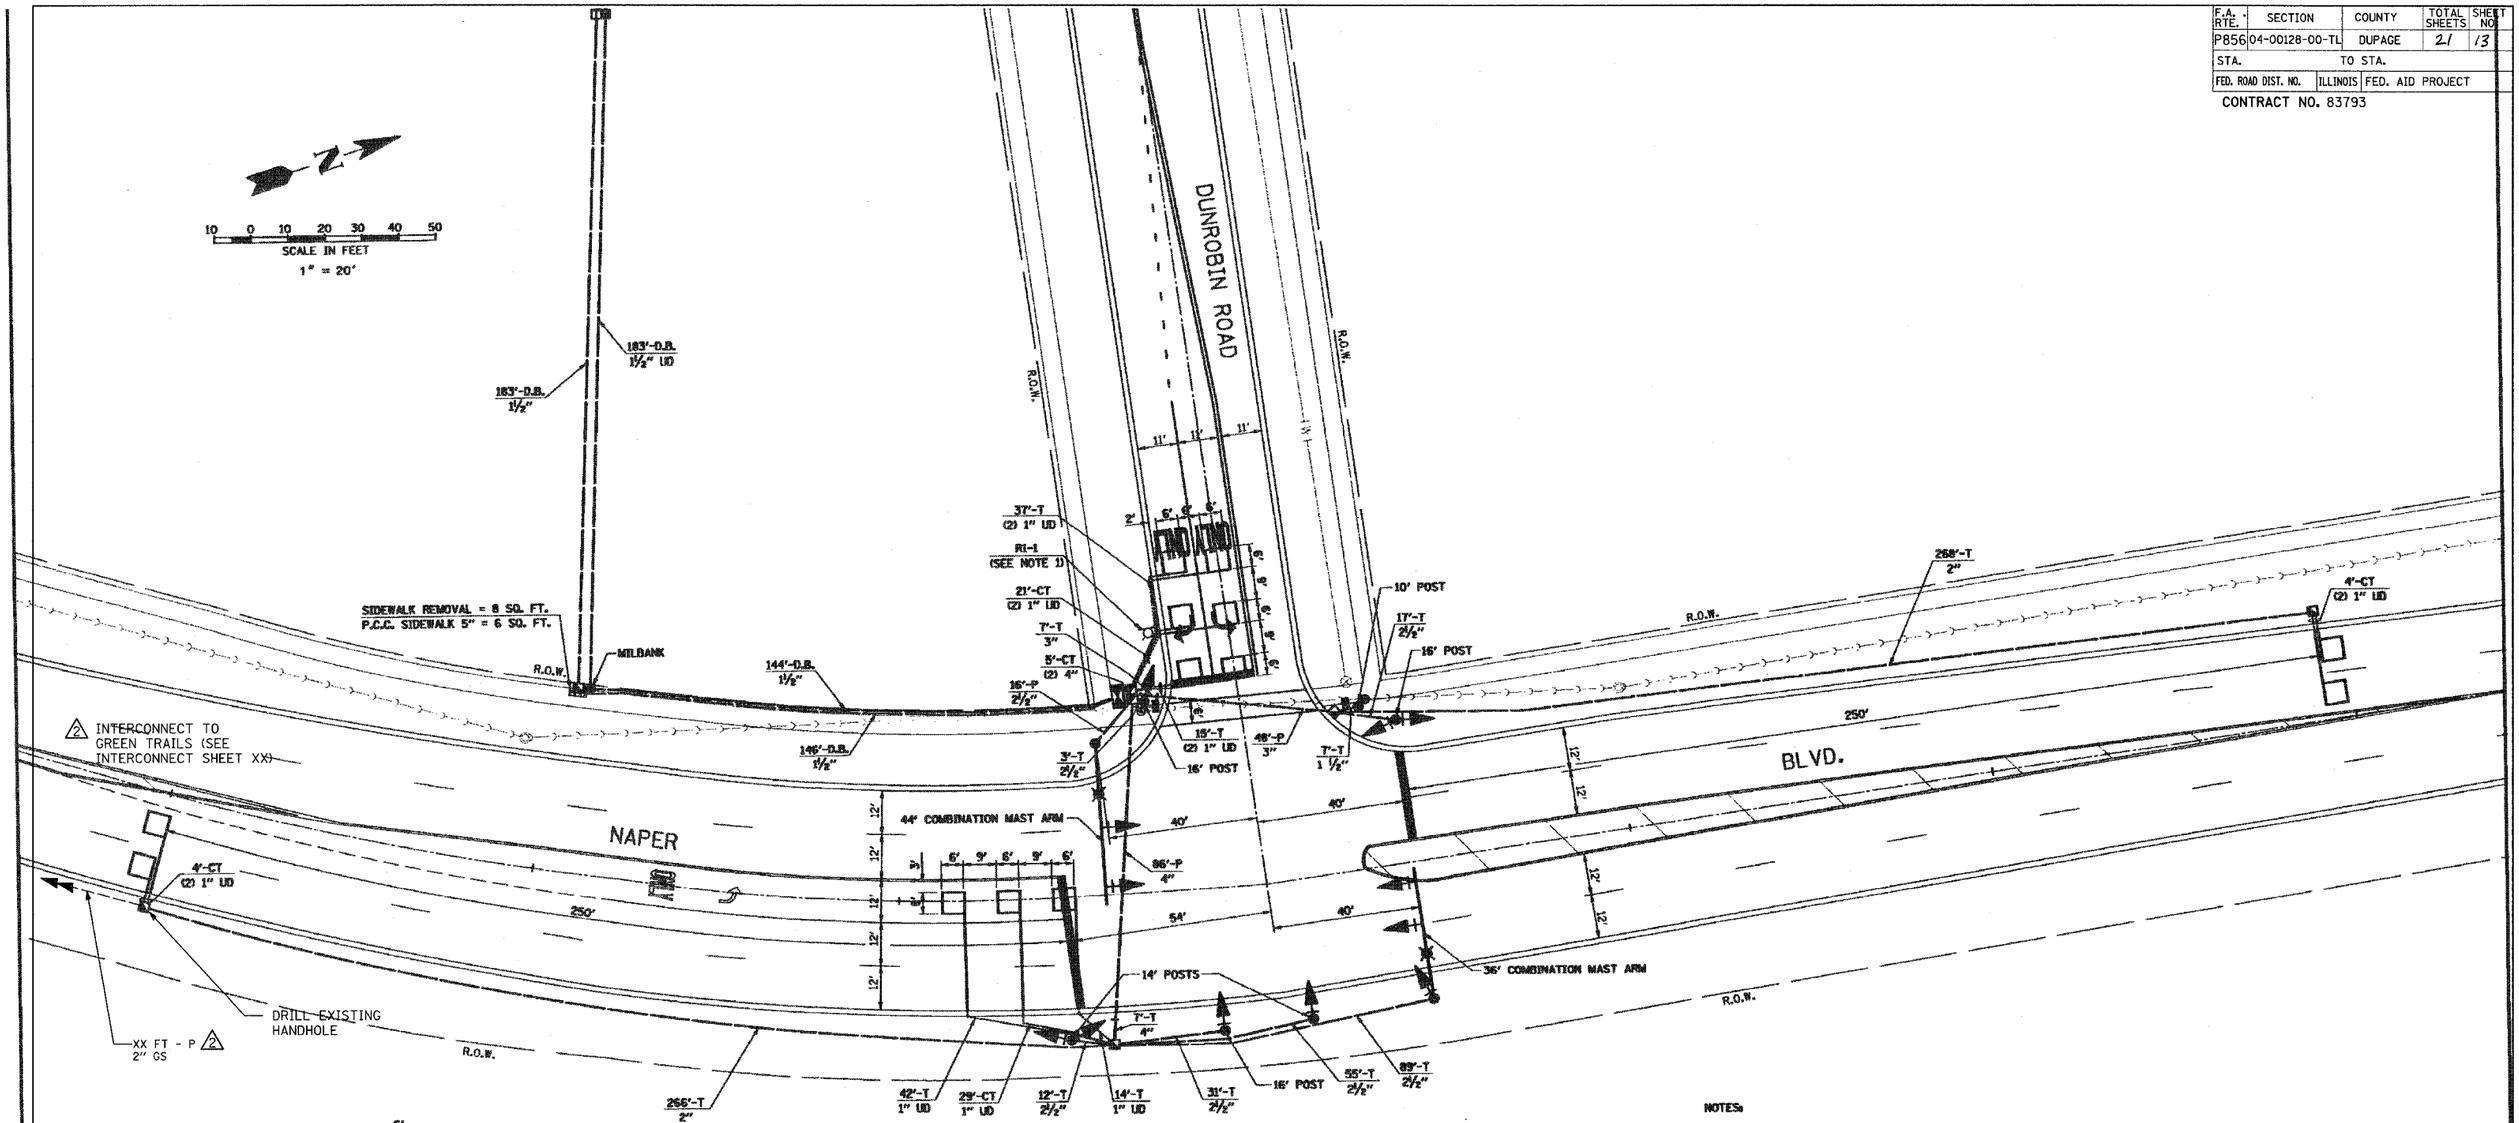

2 INTERCONNECT TO GREEN TRAILS (SEE INTERCONNECT SHEET XX)

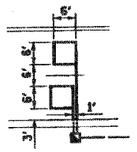

TYPICAL LOOP DETECTOR INSTALLATION DETAIL (FAR BACK DETECTION)

NOTE:
PLANS ARE BASED ON EXISTING "AS-BUILT" DRAWINGS. FIELD CONDITIONS MAY VARY FROM THOSE SHOWN

1 INSTALLATION OF EMERGENCY VEHICLE PREEMPTION 3-25-02 SEE REVISED PLANS PREPARED BY CHRISTOPHER BURKE ENGR.

2 INSTALLATION OF FIBER OPTIC INTERCONNECT ON NAPER BLVD HOBSON TO DUNROBIN

NOTES:

1. THE CITY OF NAPERVILLE DEPARTMENT OF PUBLIC WORKS FORCES SHALL REMOVE THE EXISTING STOP SIGN AND POST FOR DUNROBIN ROAD AT TIME OF TRAFFIC SIGNAL TURN-ON.
2. THE CITY OF NAPERVILLE DEPARTMENT OF PUBLIC WORKS FORCES WILL FABRICATE AND INSTALL THE MAST ARM MOUNTED STREET NAMES SIGNS.
3. THE 24 INCH WHITE THERMOPLASTIC PAVEMENT MARKING LINES FOR THE STOP BARS ON NAPER BOULEVARD SHALL BE INSTALLED AFTER THE TRAFFIC SIGNALS ARE OPERATIONAL.

CHRISTOPHER B. BURKE ENGINEERING LTD.
9575 West Higgins Road, Suite 600
Rosemont, Illinois 60018
(847) 823-0500

CLIENT:
CITY OF NAPERVILLE
400 S. EAGLE STREET
NAPERVILLE, ILLINOIS
Naperville

NO.	DATE	NATURE OF REVISION	CHKD.

DSGN.	TCM
DWN.	FCP
CHKD.	GMZ
SCALE:	1"= 20'
FILE NAME:	TS-DNRBN.DGN

TIT

REVISIONS NAME	DATE

ILLINOIS DEPARTMENT OF TRANSPORTATION

NAPER BOULEVARD INTERCONNECT

DUNROBIN ROAD SIGNAL PLAN

SCALE: NTS
DRAWN BY JS
DATE
CHECKED BY DJ

TYLININTERNATIONAL

PLOT DATE = $DATE$
FILE NAME = $FILE$
PLOT SCALE = $SCALE$
REFERENCE = REF

N:/DGN/TRAFSIG/96-213/H/TS-DNRBN.DGN

\\GD2407\Road\DRSigPln.dgn 05/10/2005 11:56:38 AM