FOR INFORMATION ONLY

1.94 0101.6-IP	COUNTY	TOTAL SHEETS	SHEET NO.
		113	72
		I-94-3(i)-51	

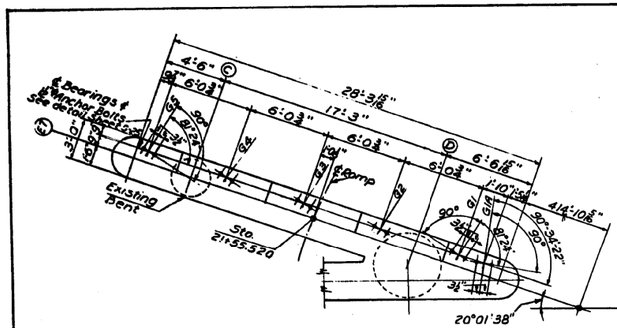

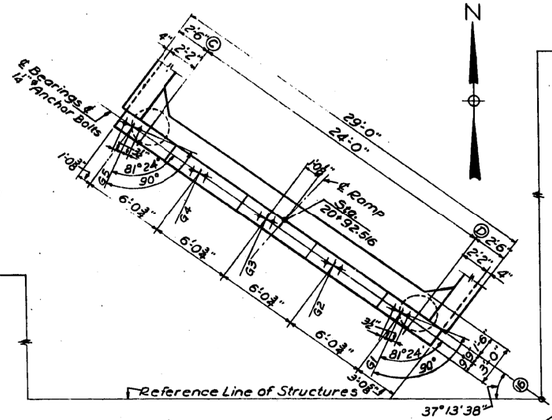

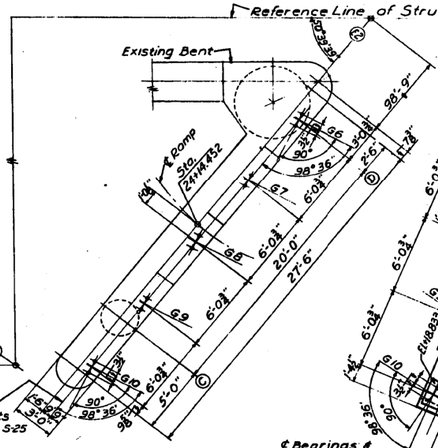

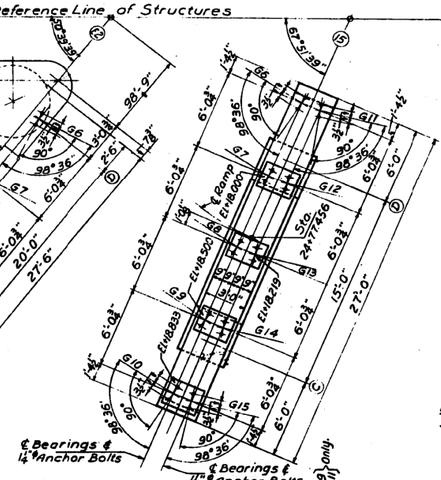

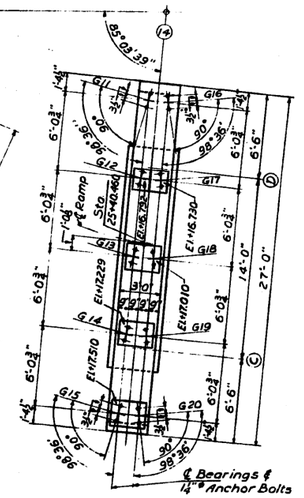

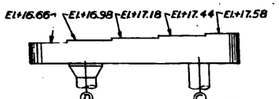

EXISTING BENT E7
Scale: ⅛"=1'-0"

Note: Verify all Existing Elevations at the Site

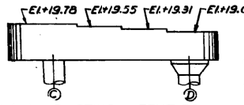

EXISTING BENT E2
Scale: ⅛"=1'-0"

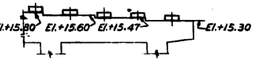

EXISTING BENT E1
Scale: ⅛"=1'-0"

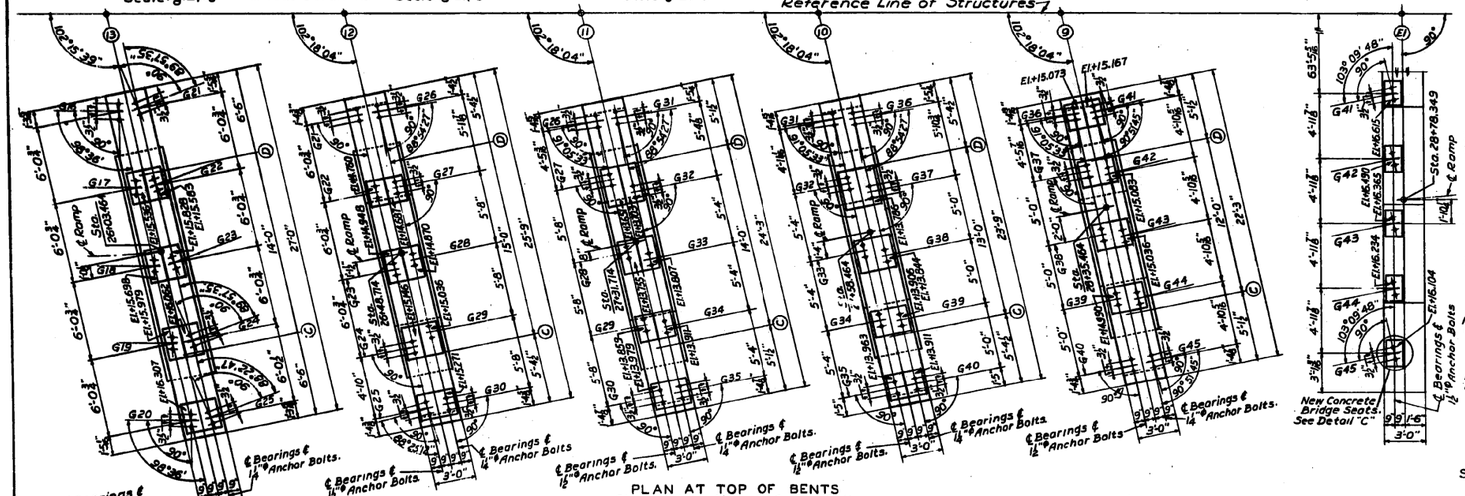

PLAN AT TOP OF BENTS
Showing Location of Anchor Bolts

DETAIL "C"
Scale: 1"=1'-0"

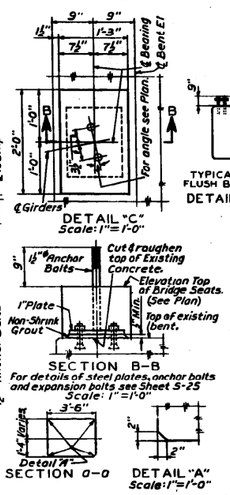

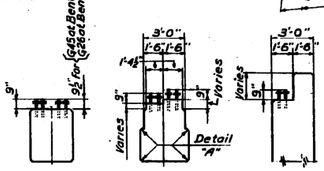

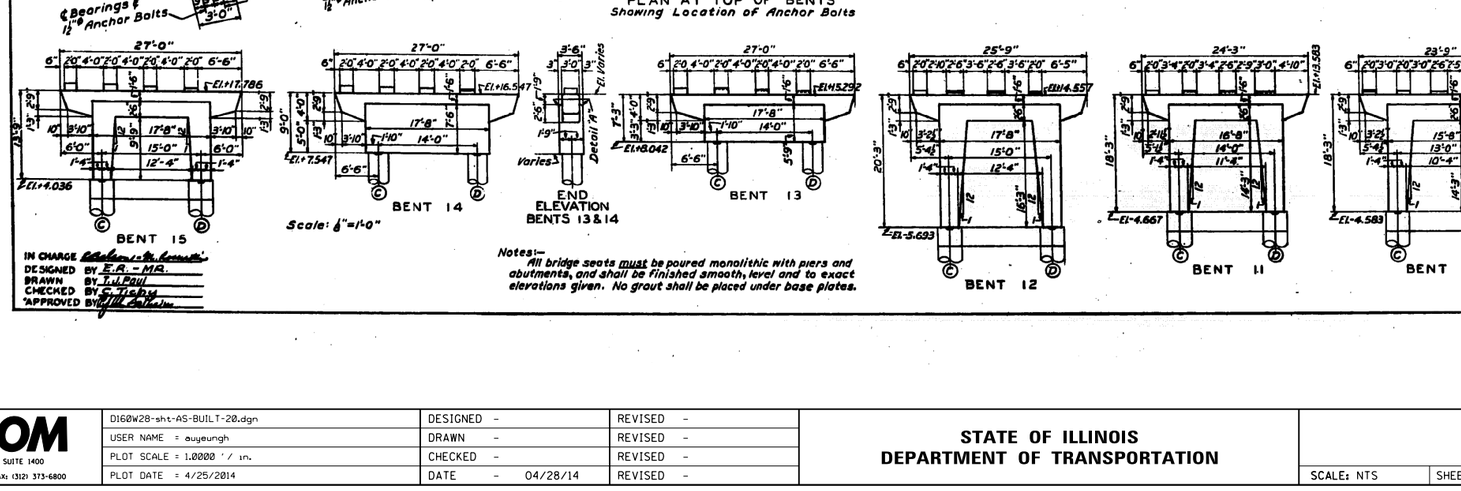

IN CHARGE Edward M. Kennedy
DESIGNED BY E.R. - M.R.
DRAWN BY J.W. Paul
CHECKED BY C. Tighe
*APPROVED BY Jeffrey Ballinger

Notes:- All bridge seats must be poured monolithic with piers and abutments, and shall be finished smooth, level and to exact elevations given. No grout shall be placed under base plates.

References:-

General Notes	Sheet S-1
Reinforcement for Bents	Sheet S-17
Sub-Pier Schedule & Foundation Girders	Sheet S-4
Detail of Anchor Bolts	Sheet S-25
Detail of Abutment 16	Sheet S-8

CITY OF CHICAGO
DEPARTMENT OF PUBLIC WORKS
BUREAU OF ENGINEERING
NORTHWEST ROUTE SUPERHIGHWAY
HALSTED STREET INTERCHANGE
SECTION 0101.6-IP

CONCRETE BENTS SE RAMP DIMENSIONS AND ELEVATIONS

SCALE:- ¼"=1'-0" Except as noted AUGUST 1959
SHEET NO. S-15 OF 113 SHEETS

FILE PATH = C:\Projectwise\14-0425 - 60W28 Structure Builts\D160W28-sht-AS-BUILT-20.dgn

AECOM
303 EAST WACKER DRIVE, SUITE 1400
CHICAGO, IL 60601-5276
PHONE: (312) 373-7700 FAX: (312) 373-6800

D160W28-sht-AS-BUILT-20.dgn	DESIGNED -	REVISED -
USER NAME = auyeungh	DRAWN -	REVISED -
PLOT SCALE = 1.0000 ' / in.	CHECKED -	REVISED -
PLOT DATE = 4/25/2014	DATE - 04/28/14	REVISED -

STATE OF ILLINOIS
DEPARTMENT OF TRANSPORTATION

EXISTING AS-BUILTS
SN 016-2449 & SN 016-2451

SCALE: NTS | SHEET 20 OF 48 SHEETS | STA. | TO STA.

F.A.I. RTE.	SECTION	COUNTY	TOTAL SHEETS	SHEET NO.
90/94/290	2013-010R	COOK	747	490
		CONTRACT NO. 60W28		
		ILLINOIS	FED. AID PROJECT	