FOR INFORMATION ONLY

ROUTE NO	SECTION	COUNTY	JOB NO.	SHEET NO.
I. 94	0101.6-1P	COOK	113	74
FED. ROAD DIV. No. 4			I-94-3(1)-51	

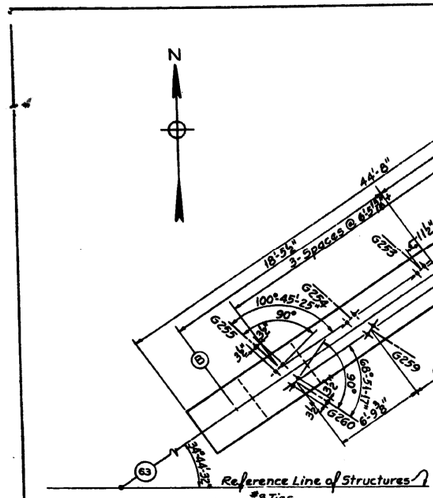

PLAN AT TOP OF BENT 63
(Showing location of Anchor Bolts)

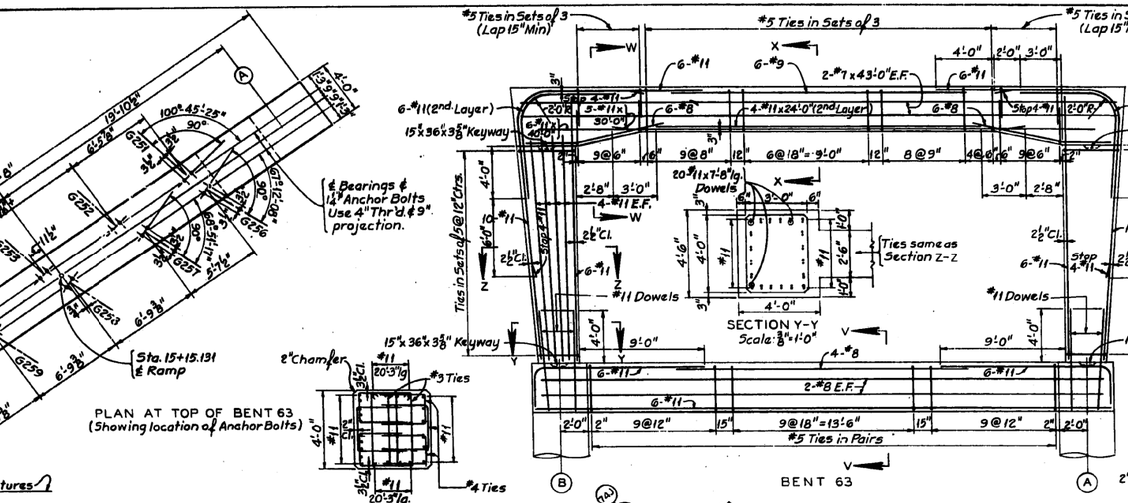

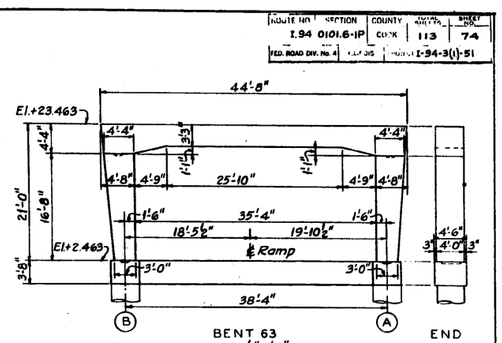

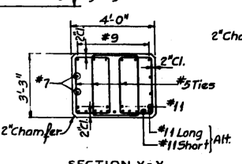

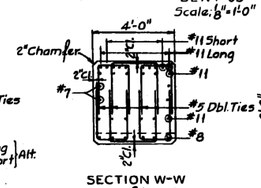

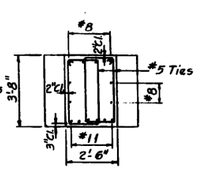

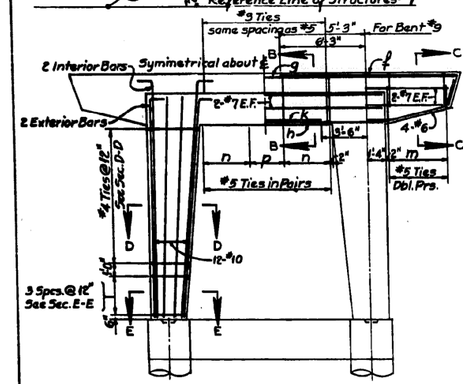

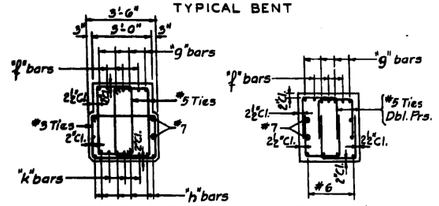

BENT NO.	MAIN REINFORCEMENT f	g	h	k	TIE SPACING m	n	p	r
9	3-#10	4-#7	6-#8	—	4@8"	—	5@15"	—
10	3-#10	4-#7	6-#8	—	4@9"	—	5@18"	—
11	3-#10	4-#7	6-#8	—	4@8"	—	7@14"	—
12	3-#11	4-#7	6-#8	—	4@9"	—	7@16"	—
15,25,28,31&32	3-#11	4-#5	6-#8	—	5@9"	—	7@18"±	—
22	3-#8	4-#7	6-#8	—	9@15"	—	7@17½"	5@11½"
23	3-#10	4-#7	6-#10	—	5@10½"	—	15@11"	5@10"
24	3-#10	4-#9	6-#8	—	6@9½"	—	6@19½"	—
26&27	3-#10	4-#8	6-#8	—	5@9"	—	6@19"	—
40,41&42	3-#10	4-#9	6-#8	—	6@8"	—	8@16"±	—
51,52,53,60&71	3-#9	4-#9	6-#8	—	5@9"	—	7@18"±	—
54	3-#9	4-#9	6-#8	—	5@10"	—	7@17"	4@12"
55	3-#11	4-#5	6-#9	3-#9	6@11"	9@10"	3@18"	6@12"
56	3-#10	4-#9	6-#8	—	7@9"	2@12"	7@18"	—
57	3-#10	4-#9	6-#8	—	6@8"	—	6@16"	—
58&73	3-#10	4-#11	6-#9	3-#8	5@6"	5@10"	3@18"±	—
59	3-#11	4-#9	6-#10	3-#10	6@9"	8@10"	4@18"	5@12"
60	3-#9	4-#7	6-#8	—	3@19"	—	6@18"	4@9"
61&64	3-#8	4-#9	6-#8	—	4@12"	—	7@16"±	—
65	3-#9	4-#7	6-#9	3-#11	5@11"	2@10"	9@15"	—
72	3-#10	4-#10	6-#8	—	6@8"	—	7@16"	—
74	3-#10	4-#8	6-#8	3-#10	5@10"	8@10"	2@18"	5@12"
75	3-#9	4-#8	6-#8	—	5@8"	—	7@16"	3@12"

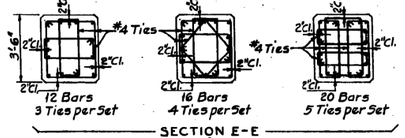

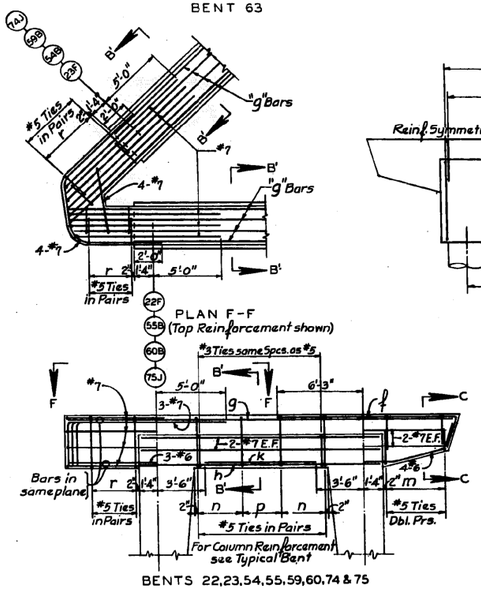

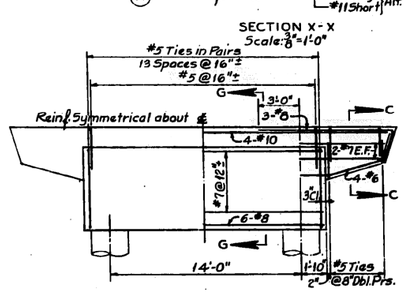

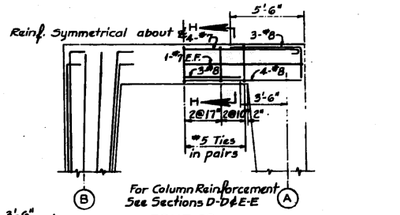

Notes:
No grout shall be placed under base plates.

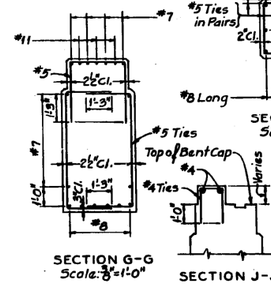

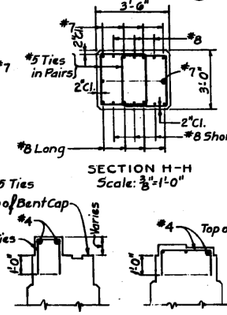

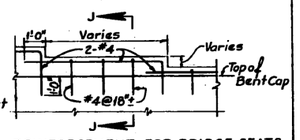

 

References:
General Notes: Sheet 5-1
Dimensions of Concrete Bents and Location of Anchor Bolts: Sheets 5-11 to 5-16
Sub-Pier Schedule and Foundation Girders: Sheet 5-4

IN CHARGE A.Lawanis - E.Solan
DESIGNED BY J.Curtis - W.Mackey
DRAWN BY Christian Walter
CHECKED BY P.S.Hovhannisyan - R.Vinzant
APPROVED BY Ellis Solan

CITY OF CHICAGO
DEPARTMENT OF PUBLIC WORKS
BUREAU OF ENGINEERING

NORTHWEST ROUTE SUPERHIGHWAY
HALSTED STREET INTERCHANGE
SECTION 0101.6-1P

REINFORCEMENT FOR BENTS

SCALE: 1/4"=1'-0" EXCEPT AS NOTED — AUGUST 1959
SHEET NO. 5-17 OF 113 SHEETS

FILE PATH = C:\Projectwise\14-0425 - 60W28 Structs\Builts\D160W28-sht-AS-BUILT-22.dgn

AECOM
303 EAST WACKER DRIVE, SUITE 1400
CHICAGO, IL 60601-5276
PHONE: (312) 373-7700 FAX: (312) 373-6800

D160W28-sht-AS-BUILT-22.dgn	DESIGNED -	REVISED -
USER NAME = auyeungh	DRAWN -	REVISED -
PLOT SCALE = 1.0000 ' / in.	CHECKED -	REVISED -
PLOT DATE = 4/25/2014	DATE - 04/28/14	REVISED -

STATE OF ILLINOIS
DEPARTMENT OF TRANSPORTATION

EXISTING AS-BUILTS
SN 016-2449 & SN 016-2451

SCALE: NTS | SHEET 22 OF 48 SHEETS | STA. | TO STA.

F.A.I. RTE.	SECTION	COUNTY	TOTAL SHEETS	SHEET NO.
90/94/290	2013-010R	COOK	747	492
		CONTRACT NO. 60W28		
	ILLINOIS FED. AID PROJECT			