FOR INFORMATION ONLY

STATE OF ILLINOIS
DEPARTMENT OF TRANSPORTATION

ROUTE	SECTION	COUNTY	TOTAL SHEETS	SHEET NO.
90/94	*	COOK	79	79
STA.		TO STA.		
FED. RD. DIST. NO.	ILLINOIS	FTP. I/D PROJECT		

* 1985-080 R

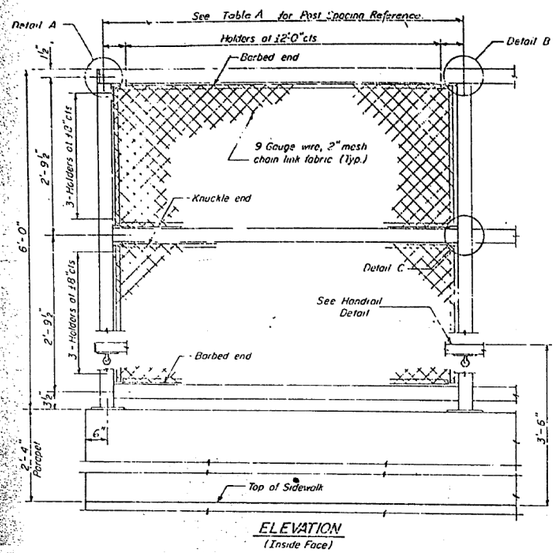

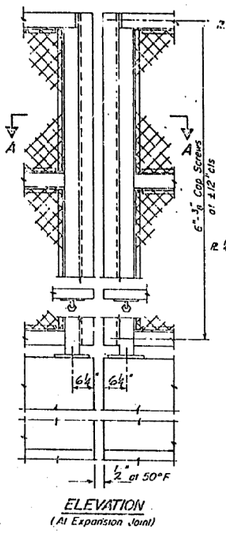

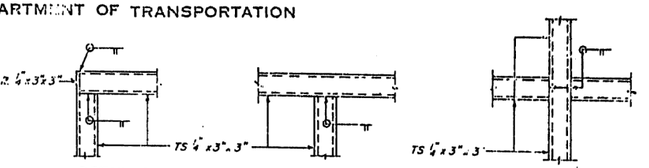

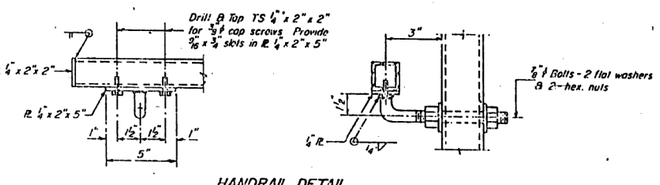

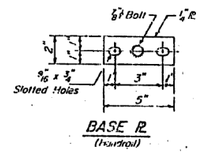

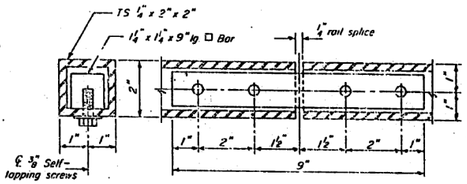

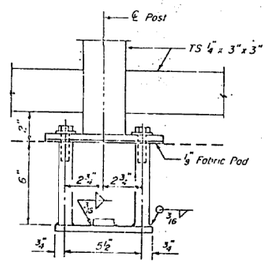

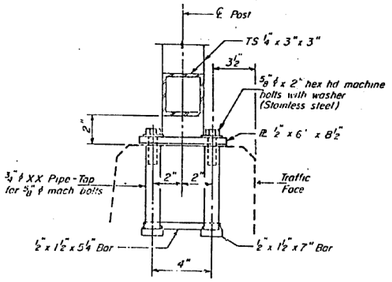

ANCHOR BOLT DETAILS

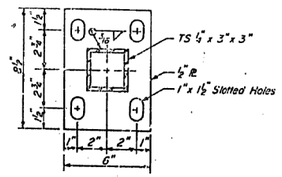

BASE R

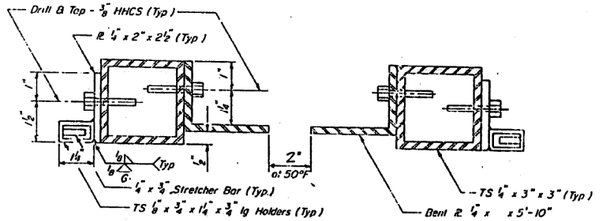

SECTION A-A

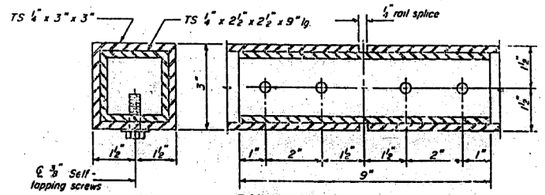

RAIL SPLICE

NOTES

Railing shall be in accordance with Section 506 of the Standard Specifications, except as noted, and shall be paid for at the Contract Unit Price per lineal foot for Pedestrian Railing.

The 9 gauge fabric ties shall be in accordance with Article 710.3311 of the Standard Specifications.

Installation of the chain link fabric shall be in accordance Section 629 of the Standard Specifications.

Hollow structural steel tubing shall conform to the requirements of ASTM designation A 500, Grade B, structural steel tubing.

All other steel shapes and plates shall conform to the requirements of AASHTO M183.

Notes:

All posts, railing, splices, anchor sleeves and bent plates shall be galvanized after shop fabrication in accordance with AASHTO M-111 and ASTM A-385. All bolts, nuts and washers shall be galvanized in accordance with, AASHTO M-232.

Vent holes for galvanizing shall be placed in the posts and rails at locations that will not allow the accumulation of moisture in the members.

The chain link fabric shall conform to the requirements of Article 710.3310(1)(2)or(3) of the Std. Specs.

BILL OF MATERIAL

ITEM	UNIT	QUANTITY
Pedestrian Railing	L.F.	879

③ TABLE A - POST SPACING REFERENCE

STRUCTURE	SEE SHEET No.
Taylor Street Entrance Ramp	ENT 13
Harrison Street over S.B. DAN RYAN EXP.	HAR-5B
Harrison Street over N.B. DAN RYAN EXP.	S-9 & S-15

SHEET NO 6 OF 8

REVISIONS	
Name	Date
③ Revision	3-11-82

STATE OF ILLINOIS
DEPARTMENT OF TRANSPORTATION
F.A.I. ROUTE 90/94 (DAN RYAN EXPRESSWAY)
SECTION 1985-080 R - COOK COUNTY
ROADWAY GRADING AND PAVING
MISCELLANEOUS DETAILS - ALL STRUCTURES
PEDESTRIAN RAILING - 6'
Scale: NONE Drawn By: REP
Date: AUGUST 14, 1987 Checked By: W P K
ENVIROCYTE ENGINEERS INC.
Chicago, Illinois

FILE PATH = C:\Projectwise\13-0020 - Circle 60W26 AsBuilts Final\D160W26-sht-AS-BUILT-16.dgn

D160W26-sht-AS-BUILT-16.dgn	DESIGNED -	REVISED -
USER NAME = auyeungh	DRAWN -	REVISED -
PLOT SCALE = 1.0000 ' / in.	CHECKED -	REVISED -
PLOT DATE = 8/16/2013	DATE - 07/15/13	REVISED -

STATE OF ILLINOIS
DEPARTMENT OF TRANSPORTATION

EXISTING AS-BUILTS SN 016-1087

SCALE: NTS | SHEET AS-16 OF AS-62 SHEETS | STA. | TO STA.

F.A.I. RTE.	SECTION	COUNTY	TOTAL SHEETS	SHEET NO.
90/94/290	2013-008R	COOK	559	314
		CONTRACT NO. 60W26		
		ILLINOIS FED. AID PROJECT		