FOR INFORMATION ONLY

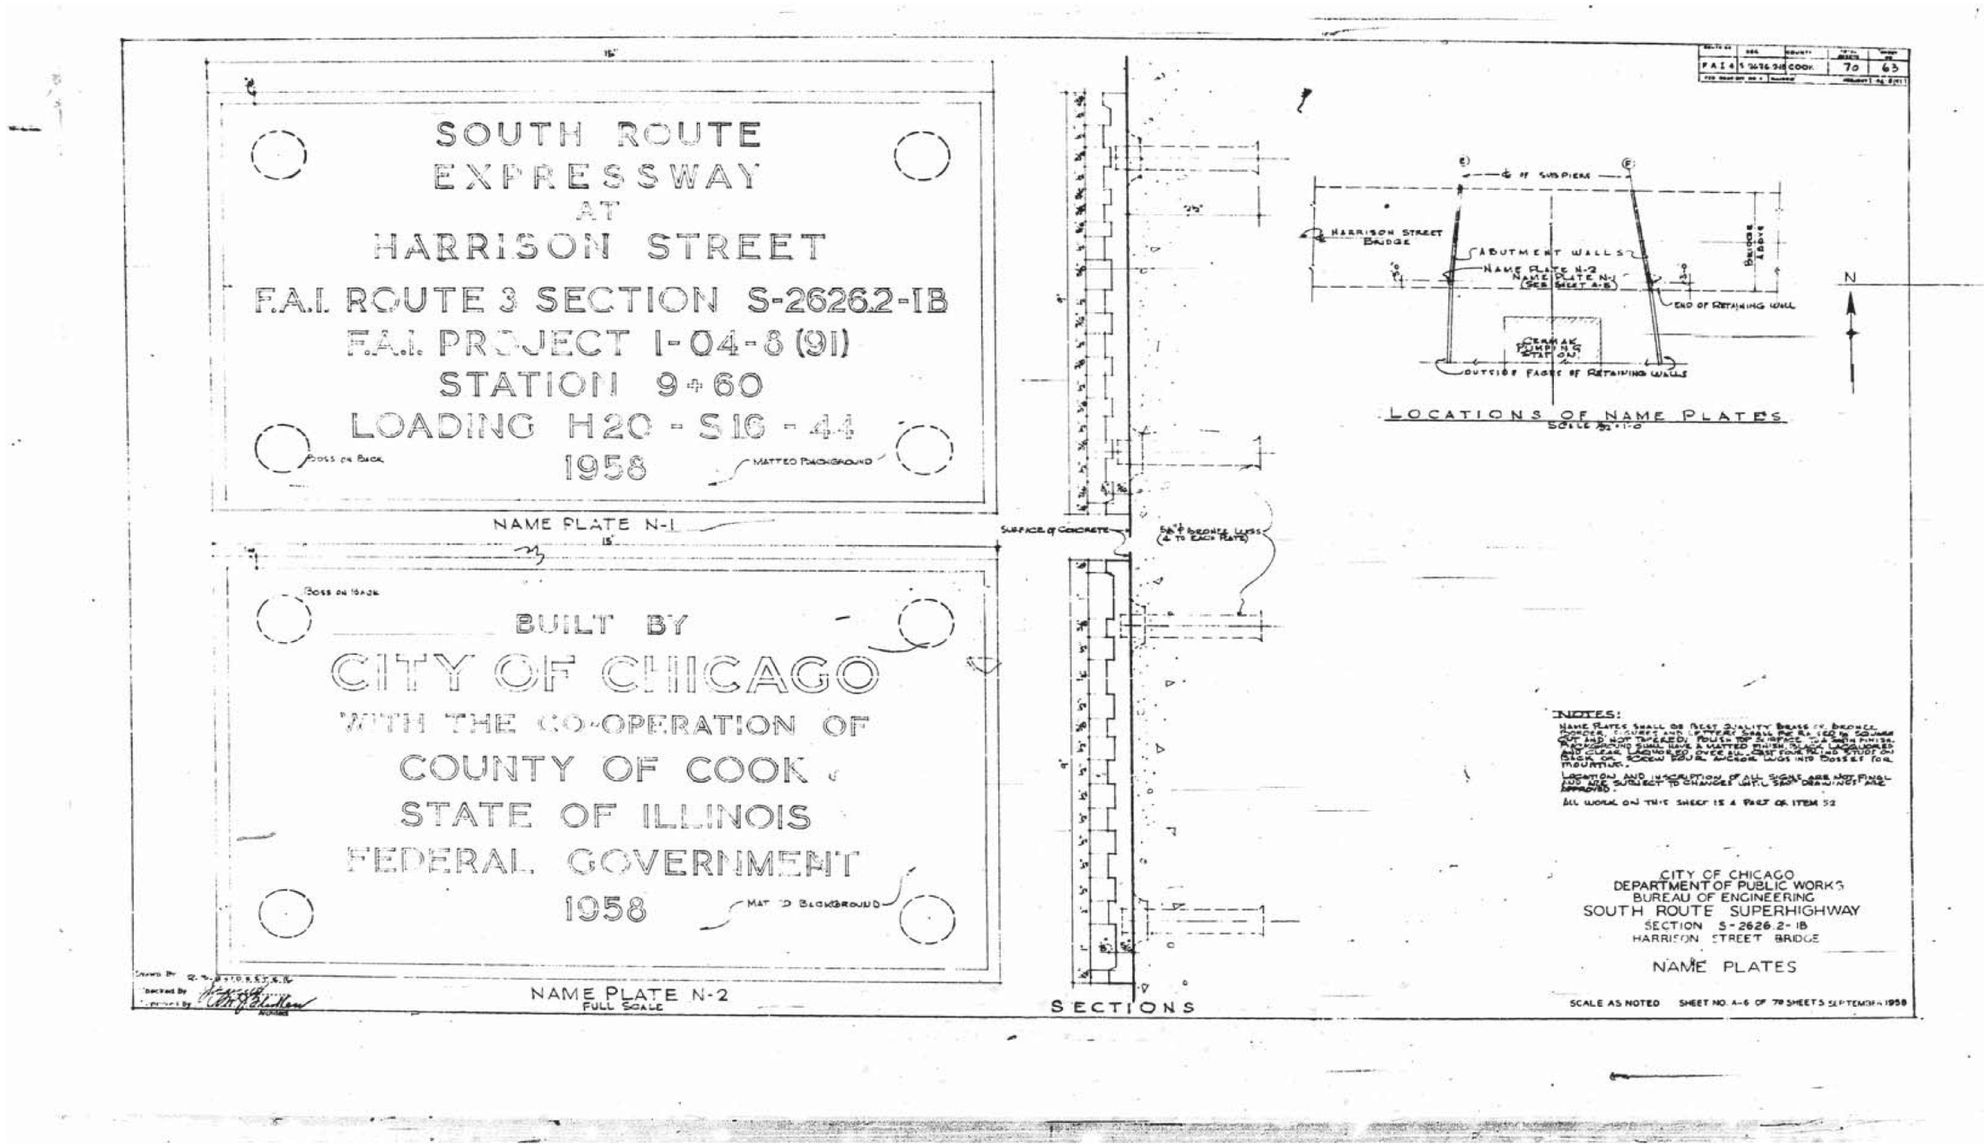

FILE PATH = C:\Projectwise\13-0820 - Circle 60W26 AsBuilts Final\D160W26-sht-AS-BUILT-56.dgn

D160W26-sht-AS-BUILT-56.dgn	DESIGNED -	REVISED -	STATE OF ILLINOIS DEPARTMENT OF TRANSPORTATION
USER NAME = auyeungh	DRAWN -	REVISED -	
PLOT SCALE = 1.0000 ' / in.	CHECKED -	REVISED -	
PLOT DATE = 8/16/2013	DATE - 07/15/13	REVISED -	

EXISTING AS-BUILTS SN 016-1087

SCALE: NTS | SHEET AS-56 OF AS-62 SHEETS | STA. | TO STA.

F.A.I. RTE.	SECTION	COUNTY	TOTAL SHEETS	SHEET NO.
90/94/290	2013-008R	COOK	559	354

CONTRACT NO. 60W26

ILLINOIS FED. AID PROJECT