FOR INFORMATION ONLY

INTERSTATE HIGHWAY IMPROVEMENT
CONSTRUCTED BY
CITY OF CHICAGO
HARRISON STREET BRIDGE
TO CARRY TRAFFIC OVER THE
SOUTH ROUTE EXPRESSWAY
FINANCED BY MOTOR FUEL TAX AND SUPERHIGHWAY BONDS
COOPERATING AGENCIES
DEPARTMENT OF COMMERCE BUREAU OF PUBLIC ROADS | ILLINOIS DIVISION OF HIGHWAYS | COOK COUNTY HIGHWAY DEPARTMENT

BARRICADE SIGN

COURTESY SIGN
2 Required

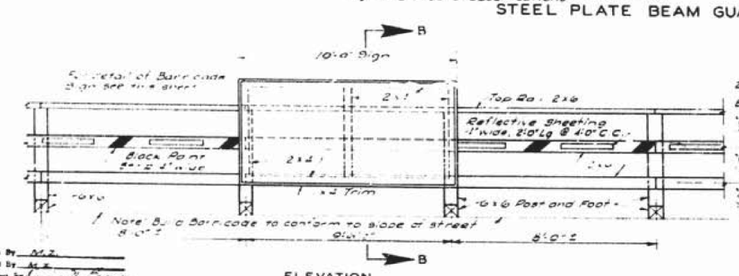

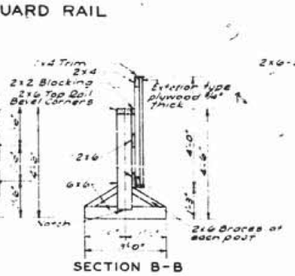

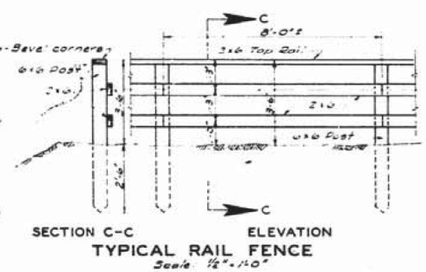

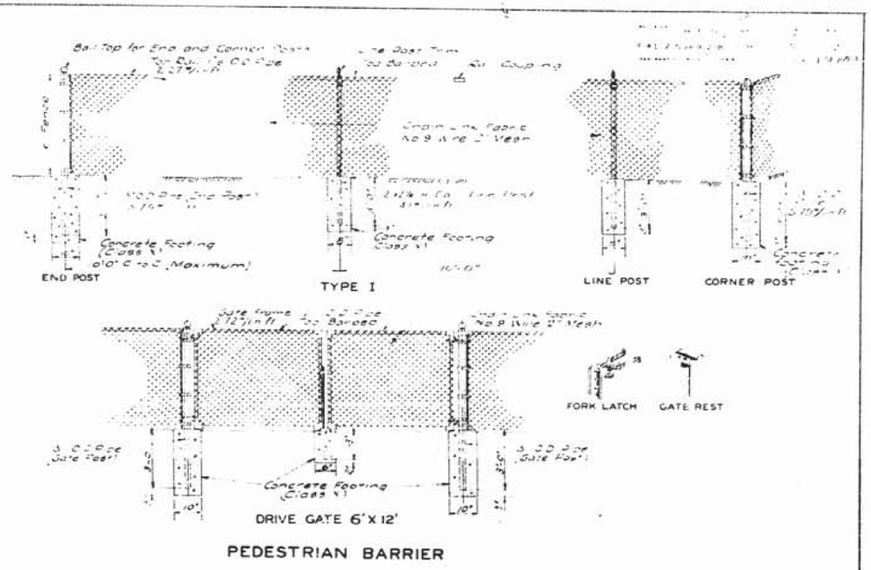

CITY OF CHICAGO
DEPARTMENT OF PUBLIC WORKS
BUREAU OF ENGINEERING
SOUTH ROUTE SUPERHIGHWAY
SECTION S-2626 2-1B
HARRISON STREET BRIDGE

PEDESTRIAN BARRIER
GUARD RAIL AND SIGN DETAILS

SCALE: AS NOTED — SEPTEMBER 1958
SHEET NO. G-12 OF 70 SHEETS

FILE PATH = C:\Projectwise\13-0820 - Cicle 60W26 AsBuilts Final\D160W26-sht-AS-BUILT-62.dgn

D160W26-sht-AS-BUILT-62.dgn	DESIGNED -	REVISED -
USER NAME = auyeungh	DRAWN -	REVISED -
PLOT SCALE = 1.0000 ' / in.	CHECKED -	REVISED -
PLOT DATE = 8/16/2013	DATE - 07/15/13	REVISED -

STATE OF ILLINOIS
DEPARTMENT OF TRANSPORTATION

EXISTING AS-BUILTS SN 016-1087

SCALE: NTS | SHEET AS-62 OF AS-62 SHEETS | STA. | TO STA.

F.A.I. RTE.	SECTION	COUNTY	TOTAL SHEETS	SHEET NO.
90/94/290	2013-008R	COOK	559	360
		CONTRACT NO. 60W26		
	ILLINOIS	FED. AID PROJECT		