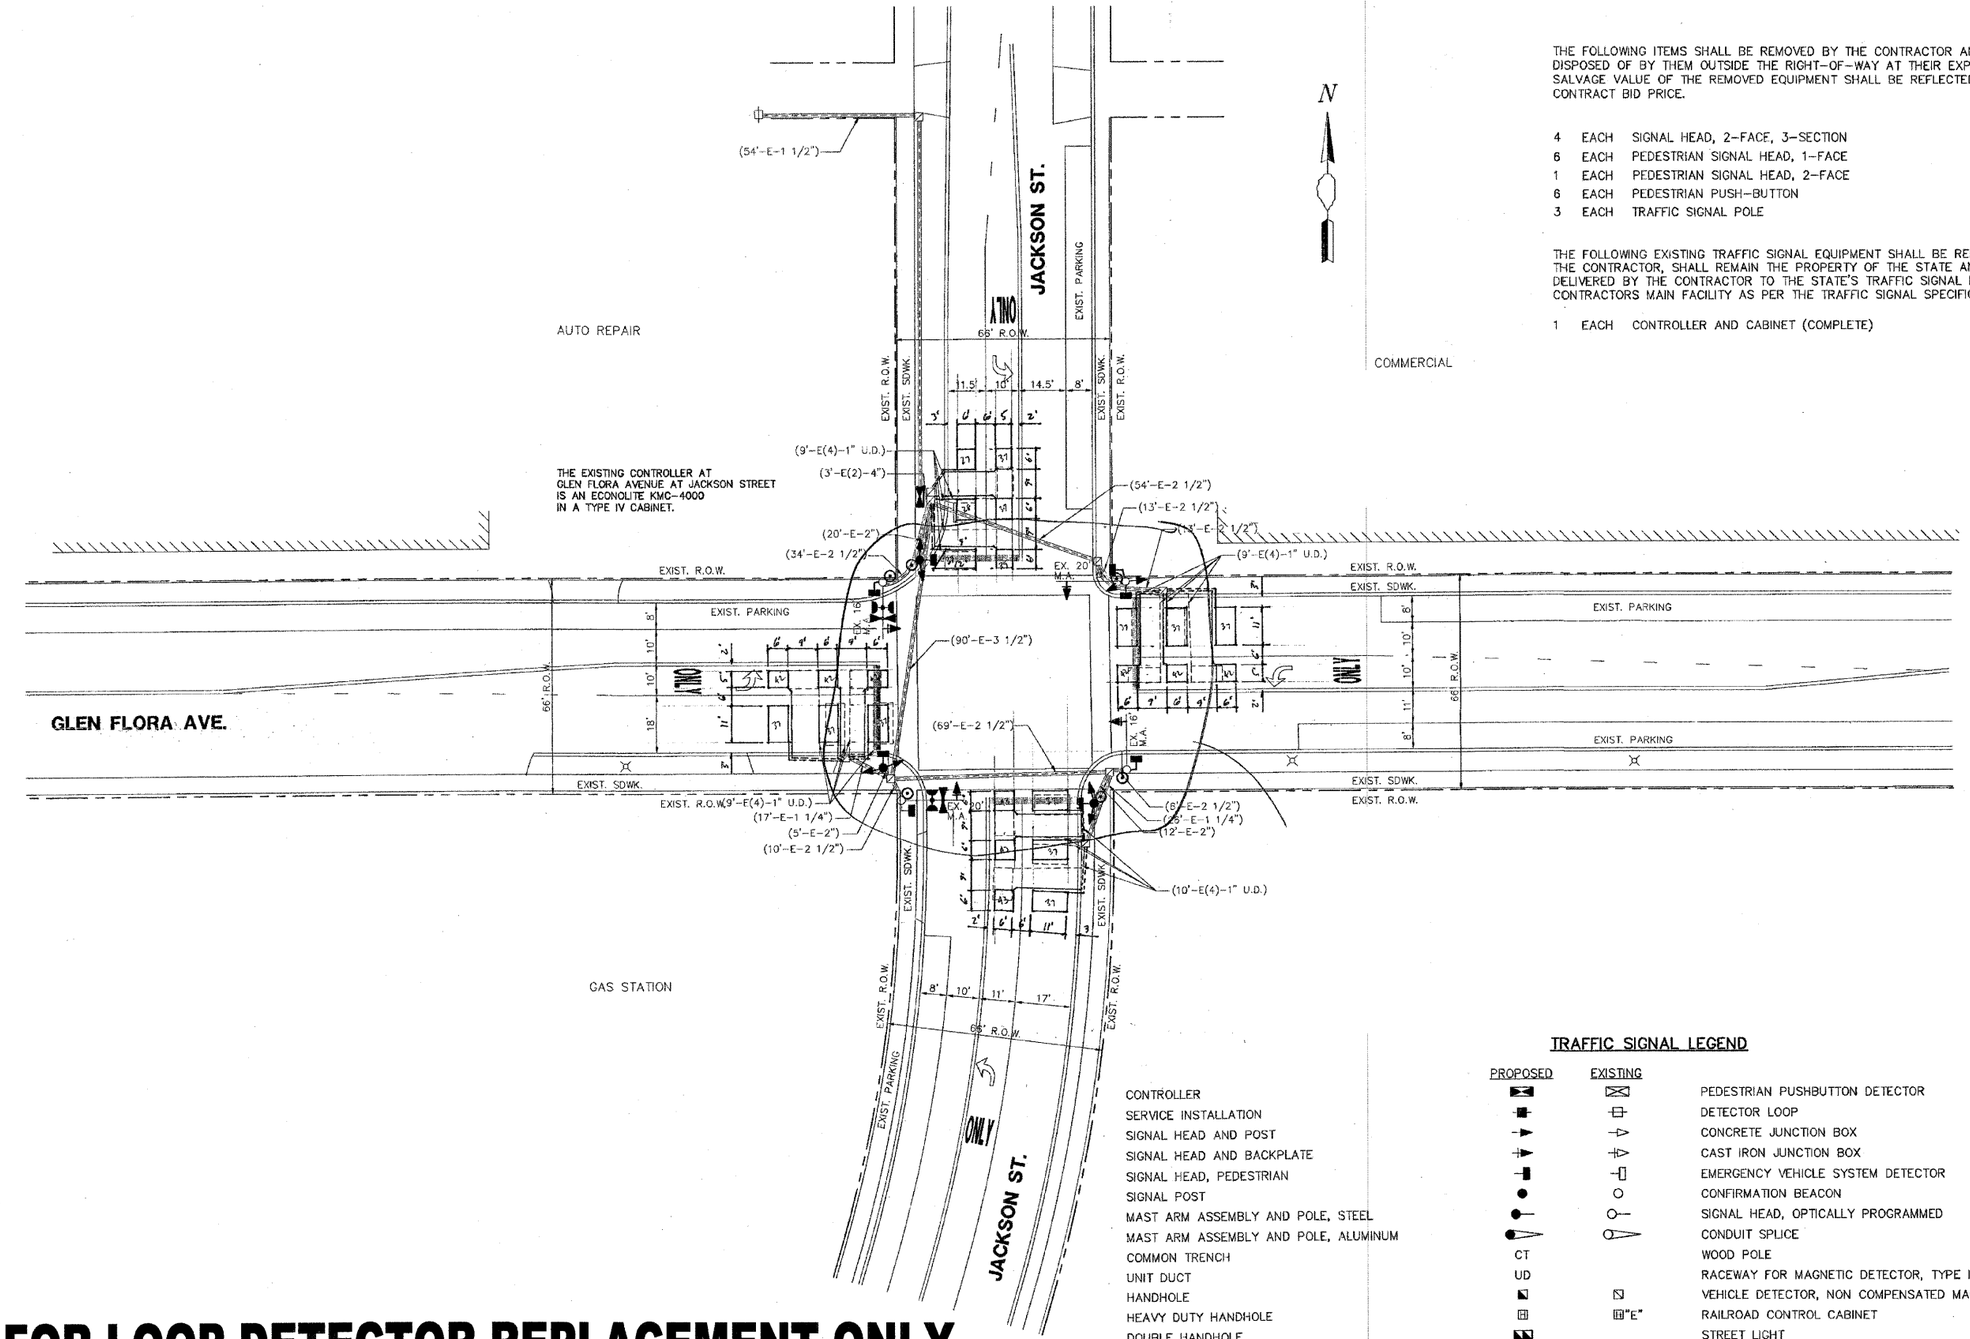

THE EXISTING CONTROLLER AT GLEN FLORA AVENUE AT JACKSON STREET IS AN ECONOLITE KMC-4000 IN A TYPE IV CABINET.

THE FOLLOWING ITEMS SHALL BE REMOVED BY THE CONTRACTOR AND SHALL BE DISPOSED OF BY THEM OUTSIDE THE RIGHT-OF-WAY AT THEIR EXPENSE. THE SALVAGE VALUE OF THE REMOVED EQUIPMENT SHALL BE REFLECTED IN THE CONTRACT BID PRICE.

4	EACH	SIGNAL HEAD, 2-FACE, 3-SECTION
6	EACH	PEDESTRIAN SIGNAL HEAD, 1-FACE
1	EACH	PEDESTRIAN SIGNAL HEAD, 2-FACE
6	EACH	PEDESTRIAN PUSH-BUTTON
3	EACH	TRAFFIC SIGNAL POLE

THE FOLLOWING EXISTING TRAFFIC SIGNAL EQUIPMENT SHALL BE REMOVED BY THE CONTRACTOR, SHALL REMAIN THE PROPERTY OF THE STATE AND SHALL BE DELIVERED BY THE CONTRACTOR TO THE STATE'S TRAFFIC SIGNAL MAINTENEANCE CONTRACTORS MAIN FACILITY AS PER THE TRAFFIC SIGNAL SPECIFICATIONS.

1	EACH	CONTROLLER AND CABINET (COMPLETE)

TRAFFIC SIGNAL LEGEND

	PROPOSED	EXISTING
CONTROLLER		
SERVICE INSTALLATION		
SIGNAL HEAD AND POST		
SIGNAL HEAD AND BACKPLATE		
SIGNAL HEAD, PEDESTRIAN		
SIGNAL POST		
MAST ARM ASSEMBLY AND POLE, STEEL		
MAST ARM ASSEMBLY AND POLE, ALUMINUM		
COMMON TRENCH	CT	
UNIT DUCT	UD	
HANDHOLE		
HEAVY DUTY HANDHOLE		"E"
DOUBLE HANDHOLE		
GALVANIZED STEEL CONDUIT IN TRENCH OR PUSHED		

	PROPOSED	EXISTING
PEDESTRIAN PUSHBUTTON DETECTOR		
DETECTOR LOOP		
CONCRETE JUNCTION BOX	J	J "E"
CAST IRON JUNCTION BOX	I	I "E"
EMERGENCY VEHICLE SYSTEM DETECTOR		
CONFIRMATION BEACON		
SIGNAL HEAD, OPTICALLY PROGRAMMED	"P"	"P"
CONDUIT SPLICE		
WOOD POLE		"E"
RACEWAY FOR MAGNETIC DETECTOR, TYPE I OR TYPE II		"E"
VEHICLE DETECTOR, NON COMPENSATED MAGNETIC TYPE		
RAILROAD CONTROL CABINET		"E"
STREET LIGHT		

FOR LOOP DETECTOR REPLACEMENT ONLY

COPYRIGHT NOTICE
This drawing is the property of Gewalt-Hamilton Assoc., Inc. and is not to be used for any purpose other than the specific project and site named herein, and cannot be reproduced in any manner without the express written permission from Gewalt-Hamilton Associates, Inc.

GLEN FLORA AVENUE AT JACKSON STREET
TRAFFIC SIGNAL MODIFICATION PLAN

TRAFFIC SIGNAL MODIFICATIONS
SOUTH STREET AT SHERIDAN ROAD AND AT VARIOUS INTERSECTIONS
CITY OF WAUKEGAN, ILLINOIS

NO.	BY	DATE	REVISION
1	JRD	1-18-02	PER IDOT REVIEW COMMENTS (12/20/01 & 1/2/02)

NO.	BY	DATE	REVISION

FILE: 3180-600-TR2	PROJ. # 3180.600	SHEET NUMBER:	
DRAWN BY: BDB DATE: 6-19-01	SCALE: 1"=20'	9	
CHECKED BY: BLS DATE: 1-29-02		OF 17 SHEETS	

DESIGNED - RHL	REVISED -		
DRAWN - PTO	REVISED -		
CHECKED -	REVISED -		
DATE - 08/21/09	REVISED -		

STATE OF ILLINOIS
DEPARTMENT OF TRANSPORTATION

JACKSON STREET LAPP PROJECT
DUGDALE ROAD TO GOLF ROAD

SCALE: N\A | SHEET NO. 10 OF 10 SHEETS

F.A.U. RTE.	SECTION	COUNTY	TOTAL SHEETS	SHEET NO.
2738	09-00235-00-RS	LAKE	16	14
		CONTRACT NO. 63342		
		ILLINOIS	FED. AID PROJECT	