FOR INFORMATION ONLY

FEDERAL AID ROUTE NO.	SECTION	COUNTY	TOTAL SHEETS	SHEET NO.
90/94	85	COOK	79	55
STA.		TO STA.		
FED. RD. DIST. NO.	ILLINOIS	FED. AID PROJECT		

* 1985-080 R

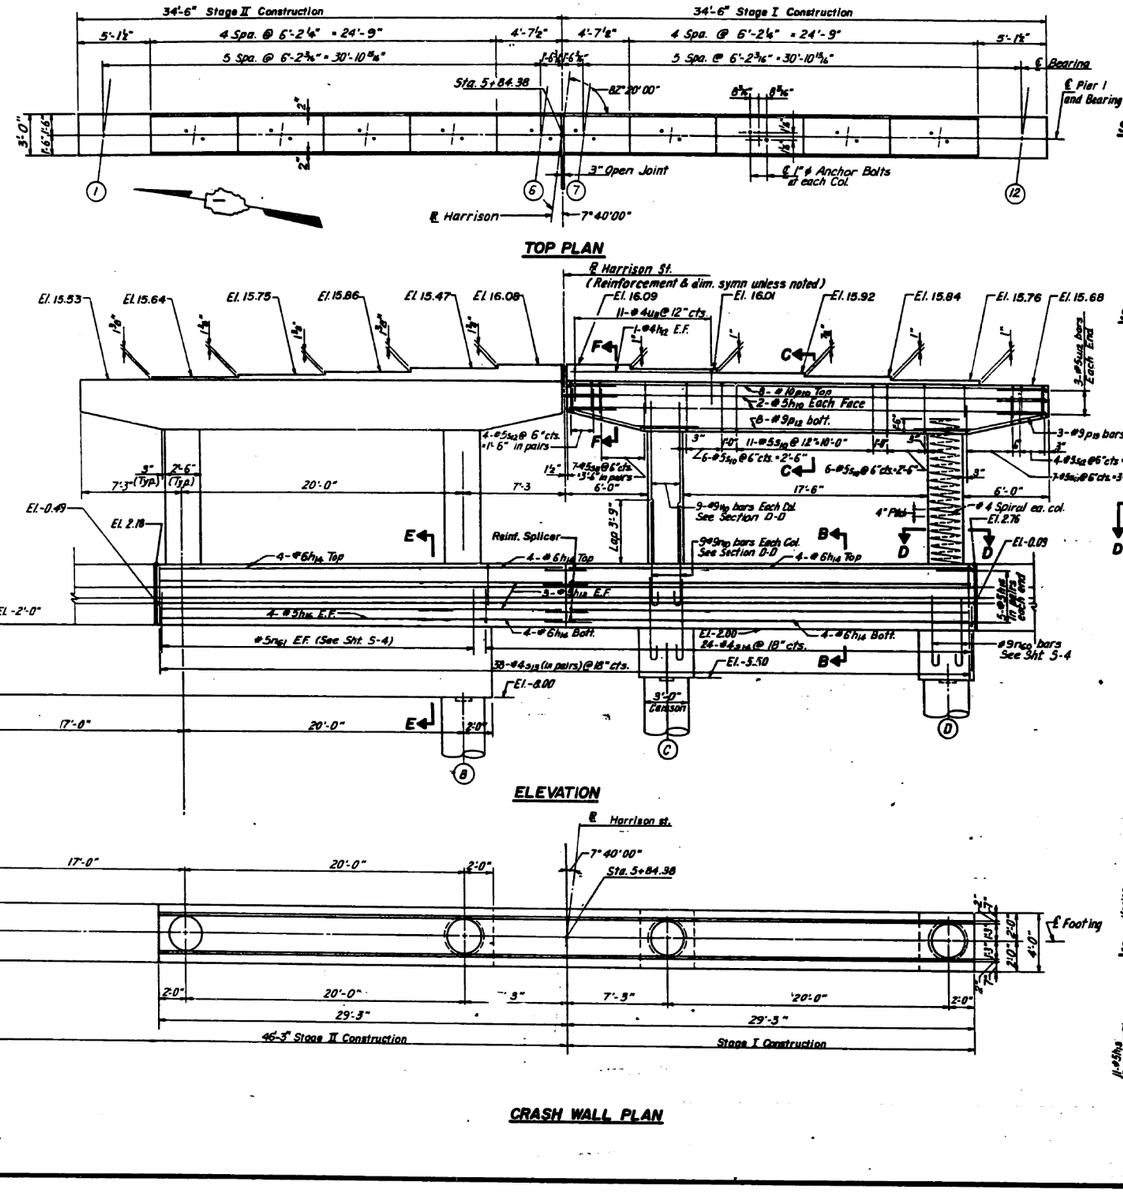

BILL OF MATERIAL

Bar	No.	Size	Length	Shape
h_{18}	8	#5	34'-8"	
h_{12}	4	#4	10'-6"	
h_{11}	12	#5	29'-0"	
h_{14}	16	#6	29'-0"	
h_{16}	20	#5	3'-10"	
n_{10}	36	#9	9'-0	
p_{18}	16	#10	34'-2"	
p_{12}	16	#9	22'-6"	
p_{13}	12	#9	10'-3"	
s_{10}	46	#5	12'-7"	
s_{11}	56	#5	7'-4"	
s_{12}	32	#5	6'-2"	
s_{13}	76	#4	6'-3"	
s_{14}	24	#4	9'-4"	
s_p	4	#4	225'-0"	
u_{11}	22	#4	6'-4"	
u_{12}	12	#5	9'-8"	
v_{18}	36	#9	11'-6"	
Reinforcement Bars		Lbs.	10390	
Class X-Concrete		Cu. Yds.	69.2	

Bar	A	B
s_{11}	2'-4"	2'-8"
s_{12}	1'-9"	2'-8"
u_{11}	2'-0"	2'-4"
u_{12}	3'-6"	2'-8"

PLANS PREPARED BY
P.G. ENGINEERING ASSOCIATES, INC.
600 WEST JACKSON BLVD.
CHICAGO ILLINOIS 60606

SHEET S-13 OF S-17

REVISIONS	
Name	Date

STATE OF ILLINOIS
DEPARTMENT OF TRANSPORTATION
F.A.I. ROUTE 90/94 (DAN RYAN EXPRESSWAY)
SECTION 1985-080 R - COOK COUNTY
HARRISON STREET OVER DAN RYAN EXPRESSWAY
PIER 1

Scale : None
Date : AUGUST 14, 1987
Drawn By: S.D.D.
Checked By:

ENVIRODYNE ENGINEERS INC.
Chicago, Illinois

D160W71-sht-AS-BUILT-16.dgn

USER NAME = dunkerleyb	DESIGNED -	REVISED
	CHECKED -	REVISED
PLOT SCALE = N.T.S.	DRAWN -	REVISED
PLOT DATE = 11/26/2013	CHECKED -	REVISED

STATE OF ILLINOIS
DEPARTMENT OF TRANSPORTATION

EXISTING AS-BUILTS SN 016-1088

SHEET NO. AS-16 OF AS-72 SHEETS

F.A.I. RTE.	SECTION	COUNTY	TOTAL SHEETS	SHEET NO.
90/94/290	2013-036R	COOK	256	158
		CONTRACT NO. 60W71		
	ILLINOIS	FED. AID PROJECT -NUMBER-		