F.A.I.	SECTION	COUNTY	TOTAL SHEETS	SHEET NO.
94/90	2005-086 I	COOK	228	15
STA.		TO STA.		
FED. ROAD DIST. NO.	ILLINOIS	FED. AID PROJECT		

60B07

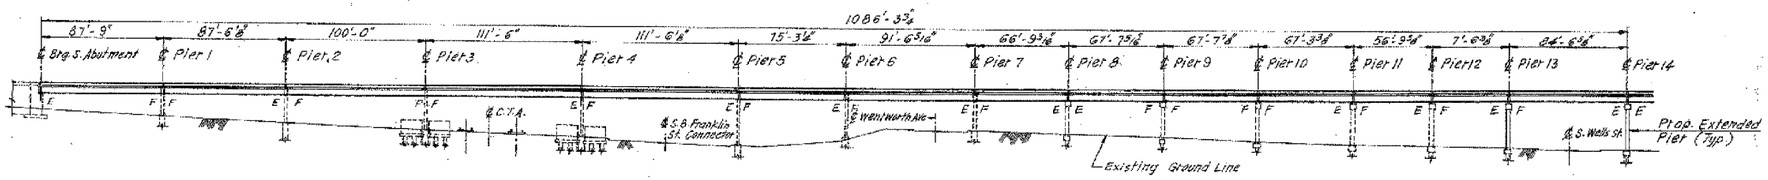

ELEVATION

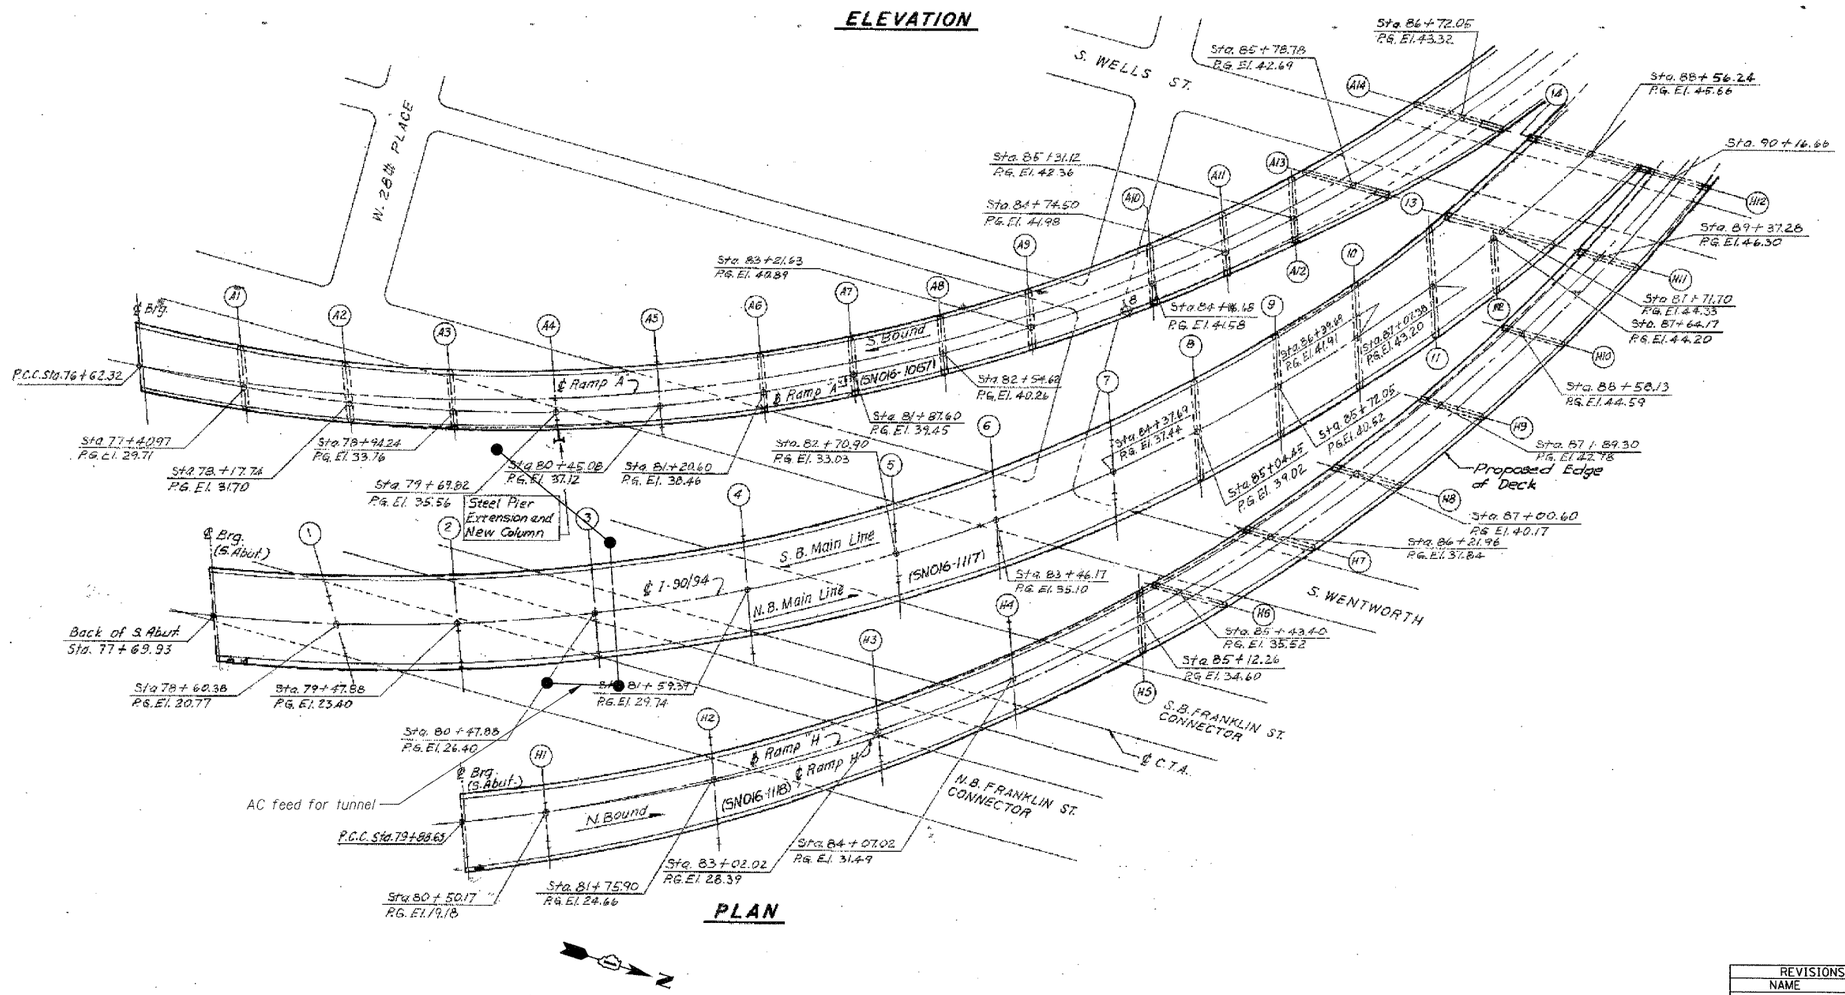

PLAN

BOWMAN, BARRETT & ASSOCIATES INC.
CONSULTING ENGINEERS
Chicago, Illinois
312.228.0100
www.bbandainc.com

Note:
This sheet created from original 1988-89 reconstruction as-builts. These are provided for general reference to structure number, span lengths, etc. Work Items for this contract are identified on the partial framing plans and detail sheets that follow.

REVISIONS	
NAME	DATE

ILLINOIS DEPARTMENT OF TRANSPORTATION
F.A.I. 94/90 (DAN RYAN EXPRESSWAY)
DAN RYAN ELEVATED BRIDGE
BEARING REPLACEMENT & STEEL REPAIR
GENERAL PLAN AND ELEVATION
SN 016-1117, SN 016-1067, SN 016-1118

SCALE: NTS — DRAWN BY: LAM
DATE: 5/18/2007 — CHECKED BY: BLU

N:\060\060\BRIDGE\2\IA\SHEETS\060_2IA_016-1117-GPE09.dgn
5/24/2007 5:13:45 PM