FOR INFORMATION ONLY

ROUTE NO	SECTION	COUNTY	TOTAL SHEETS	SHEET NO.
A. I. 94	0101.6-1P	COOK	113	67
F.C. ROAD DIV. No 4	ILLINOIS	PROJECT I-94-3(1)-51		

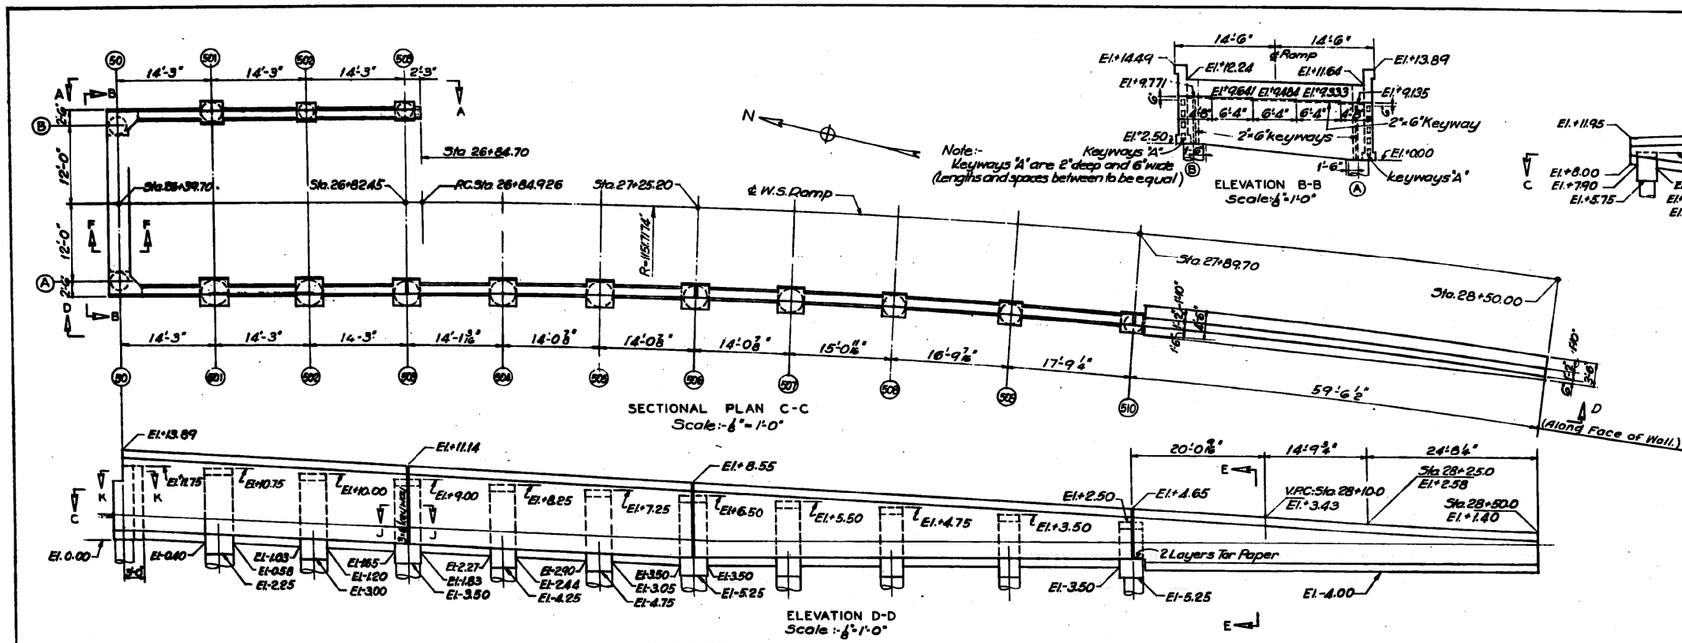

MARK	DIMENSIONS A	B	C	5" bars	7" bars
501B & 509A	1'-0"	2'-5"	1'-6"	4-#6	4-#6
501A & 502A	1'-6"	2'-9"	2'-0"	6-#9	6-#7
502B	7½"	2'-1"	1'-6"	4-#6	4-#6
503A	1'-4½"	2'-7½"	2'-0"	6-#9	6-#7
504A	1'-4½"	2'-7½"	1'-10½"	6-#9	6-#7
505A	1'-3"	2'-6"	1'-9"	6-#9	6-#7
506A	1'-3"	2'-6"	2'-0"	6-#9	6-#6
507A	1'-1½"	2'-4½"	1'-7½"	4-#9	4-#7
508A	1'-1½"	2'-4½"	1'-7½"	4-#8	4-#6
510A	10½"	2'-1½"	2'-0"	6-#7	6-#6

References:-

General Notes	Sheet S-1
Foundation Plan	Sheet S-3
Sub Pier Schedule	Sheet S-4
Location of Anchor Bolts in Abutment	Sheet S-11

IN CHARGE R. Vimtrup
DESIGNED BY R. Vimtrup
DRAWN BY C.H. Tichy
CHECKED BY W. Mackey-O. Pedersen
APPROVED BY W.M. Sallaum

CITY OF CHICAGO
DEPARTMENT OF PUBLIC WORKS
BUREAU OF ENGINEERING
NORTHWEST ROUTE SUPERHIGHWAY
HALSTED STREET INTERCHANGE
SECTION 0101.6-1P

ABUTMENT AND RETAINING WALLS
WS RAMP

SCALE: ⅜"=1'-0" EXCEPT AS NOTED AUGUST 1959
SHEET NO S-10 OF 113 SHEETS

FILE PATH = G:\Projects\se\14-0425 - 60W28 Structs\Built\D160W28-sht-AS-BUILT-15.dgn

AECOM
303 EAST WACKER DRIVE, SUITE 1400
CHICAGO, IL 60601-5276
PHONE: (312) 373-7700 FAX: (312) 373-6800

D160W28-sht-AS-BUILT-15.dgn	DESIGNED -	REVISED -
USER NAME = auyeungh	DRAWN -	REVISED -
PLOT SCALE = 1.0000 ' / in.	CHECKED -	REVISED -
PLOT DATE = 4/25/2014	DATE - 04/28/14	REVISED -

STATE OF ILLINOIS
DEPARTMENT OF TRANSPORTATION

EXISTING AS-BUILTS
SN 016-2449 & SN 016-2451

SCALE: NTS | SHEET 15 OF 48 SHEETS | STA. | TO STA.

F.A.I. RTE.	SECTION	COUNTY	TOTAL SHEETS	SHEET NO.
90/94/290	2013-010R	COOK	747	485
		CONTRACT NO. 60W28		
	ILLINOIS FED. AID PROJECT			