



Illinois Department of Transportation

Division of Aeronautics

1 Langhorne Bond Drive / Capital Airport / Springfield, Illinois / 62707-8415

September 13, 2013

SUBJECT: Chicago Executive Airport
Wheeling/Prospect Heights, Illinois
Cook County
Illinois Project Number: PWK-4182
SBG Project Number: 3-17-0018-B48
Contract No. PA056
Item No. 1A, September 20, 2013 Letting
Addendum A

NOTICE TO PROSPECTIVE BIDDERS

Attached is an addendum to the plans or proposal. This addendum involves revised and/or added material.

Reason for Addendum:

Construction Safety Plan Review Revisions & DBE Utilization Plan Revisions.

To All Plan Holders:

Plan Revisions Summary:

Plan Sheet 4 of 24, **Sequence of Construction Plan:**

Added additional barricades across taxiways and runway 16-34 and reference to Sheet 5.

Plan Sheet 5 of 24, **Sequence of Construction General Notes:**

Added view for locations of additional barricades across taxiways and runway 16-34.

Plan Sheet 6 of 24, **Sequence of Construction Schedule and Details:**

Revised "Closed Runway Marker Notes" to reference airport lighted closure "X"s.

Revised "Closed Taxiway Marker Detail" distance to runway centerline leader.

Item 1A Contract Revisions Summary:

Page 25, **DBE Utilization Plan**, Section (3) Project and Bid Identification:

Revised Contract DBE Goal to 1.0%.

Page 39, **Notice to Bidders**, Section 6. Disadvantaged Business Policy:

Revised DBE goal for this contract to 1.0%.

Page 59, **Special Provision for Disadvantaged Business Enterprise Participation**,

Paragraph 6, CONTRACT GOAL TO BE ACHIEVED BY THE CONTRACTOR:

Revised 4th sentence to read "...DBE companies can be expected to perform 1.0% of the work."

Prime contractors must utilize the enclosed material when preparing their bid and must include any Schedule of Prices changes in their bidding proposal.

Bidders using computer-generated bids are cautioned to reflect any and all Schedule of Prices changes, if involved, into their computer programs.

Questions on this addendum may be directed to Jeremy R. Linke of Crawford, Murphy & Tilly, Inc. at 630-820-1022.

GENERAL NOTES

- THE SUGGESTED SEQUENCE OF CONSTRUCTION SHOWN IS INTENDED TO ALLOW FOR THE ORDERLY CONSTRUCTION OF THE PROPOSED IMPROVEMENTS WHILE MAINTAINING AIRCRAFT ACCESS AT ALL TIMES. THE PHASING SHOWN IS A SUGGESTED SEQUENCE OF CONSTRUCTION ONLY. THIS SEQUENCE MAY BE MODIFIED HOWEVER, ALTERNATE STAGING PLANS MUST MAINTAIN AIRPORT OPERATIONS TO THE SATISFACTION OF THE AIRPORT MANAGER AND RESIDENT ENGINEER AND BE APPROVED BY THE DIVISION OF AERONAUTICS AND FEDERAL AVIATION ADMINISTRATION.
- ALL OPERATIONS SHALL BE IN CONFORMANCE WITH AC 150/5370-2F (LATEST EDITION) OPERATIONAL SAFETY ON AIRPORTS DURING CONSTRUCTION.
- CONTRACTOR'S EQUIPMENT SHALL BE STORED IN THE EQUIPMENT AND MATERIAL STORAGE/STAGING AREA WHEN CONSTRUCTION IS NOT IN PROGRESS.
- THE AIRPORT MANAGER IN CONSULTATION WITH THE RESIDENT ENGINEER SHALL HAVE FINAL SAY IN THE APPROVAL OF THE CONSTRUCTION OPERATING PHASING AND SEQUENCE AS IT RELATES TO PEDESTRIAN, VEHICULAR AND AIRCRAFT SAFETY.
- ALL EXISTING PAVEMENTS, DRIVES OR ANY OTHER AREAS USED AS A HAUL ROAD OR STORAGE AREA BY THE CONTRACTOR SHALL BE RESTORED IN KIND TO THEIR PRE-CONSTRUCTION CONDITION OR TO THE SATISFACTION OF THE RESIDENT ENGINEER AND AIRPORT MANAGER. THE COST OF MAINTAINING, REPAIRING OR CONSTRUCTING THESE PAVEMENTS AND AREAS SHALL BE INCIDENTAL TO THE CONTRACT. EXISTING AREAS OUTSIDE THE PROJECT LIMITS WHICH ARE DISTURBED BY THE CONTRACTOR'S OPERATIONS SHALL BE RESTORED BY HIM AT HIS EXPENSE TO THE SATISFACTION OF THE RESIDENT ENGINEER AND THE AIRPORT MANAGER.
- THE CONTRACTOR SHALL KEEP ALL TRUCKS, EQUIPMENT AND MATERIALS OFF OF THE EXISTING TAXIWAYS, APRONS AND RUNWAYS OUTSIDE OF THE PROJECT LIMITS EXCEPT AS SHOWN OR WITH THE PRIOR PERMISSION OF THE ENGINEER AND AIRPORT.
- WORK PERFORMED BY THE CONTRACTOR OUTSIDE OF DAYLIGHT HOURS SHALL BE DONE UNDER SUFFICIENT ARTIFICIAL LIGHTING TO ALLOW FOR PROPER CONSTRUCTION METHODS AND INSPECTIONS. LIGHT SHALL CONSIST OF MOVABLE POLE MOUNTED FLOODLIGHTS AND/OR SPOTLIGHTS OF SUFFICIENT NUMBER TO ILLUMINATE THE WORK AREA. VEHICLE HEADLIGHTS WILL BE ALLOWED ONLY IN ADDITION TO OTHER LIGHTS MENTIONED ABOVE. LIGHTING SHALL BE AS APPROVED BY THE ENGINEER AND SHALL NOT BE USED IF THEY AFFECT FLIGHT SAFETY. CONTRACTOR'S WORK HOURS SHALL BE IN ACCORDANCE WITH LOCAL ORDINANCES.
- THE CONTRACTOR SHALL PROVIDE PORTABLE FLOOD LIGHTING FOR NIGHTTIME CONSTRUCTION. SUFFICIENT UNITS SHALL BE PROVIDED SO THAT WORK AREAS ARE ILLUMINATED TO A LEVEL OF FIVE HORIZONTAL FOOT CANDLES. THE LIGHTING LEVELS SHALL BE CALCULATED AND MEASURED IN ACCORDANCE WITH THE CURRENT STANDARDS OF THE ILLUMINATION ENGINEERING SOCIETY. LIGHTS SHALL BE POSITIONED SO AS NOT TO INTERFERE WITH AIRPORT OPERATIONS.
- THE CONTRACTOR WILL BE REQUIRED TO HAVE A SWEEPER AVAILABLE FOR USE AT ALL TIMES. WHEN ACTIVE AIRFIELD PAVEMENTS ARE UTILIZED AS HAUL ROADS BY THE CONTRACTOR, MATERIAL TRACKED ON TO THE PAVEMENT SHALL BE CONTINUALLY REMOVED WITH SAID SWEEPER. THIS SWEEPING SHALL NOT BE PAID FOR SEPARATELY BUT SHALL BE CONSIDERED INCIDENTAL TO THE CONTRACT.
- MATERIALS REMOVED FROM THE PROJECT WILL BECOME PROPERTY OF THE CONTRACTOR AND SHALL BE DISPOSED OF OFF AIRPORT PROPERTY, UNLESS NOTED OTHERWISE.
- PAYMENT FOR TRAFFIC CONTROL INCLUDING, BUT NOT LIMITED TO BARRICADES, CONSTRUCTION FENCE, SIGNING, RUNWAY AND TAXIWAY CLOSED MARKERS, SAFETY AND OBJECT FREE AREAS, LATHE AND RIBBON, ETC. SHALL NOT BE PAID SEPARATELY, BUT SHALL BE CONSIDERED INCIDENTAL TO THE CONTRACT. LOW PROFILE BARRICADES END TO END AND IDOT TYPE II BARRICADES AT 10'-FOOT CENTERS WITH TWO ORANGE FLAGS (20" x 20") BETWEEN EACH SET OF BARRICADES OR 4' HIGH ORANGE CONSTRUCTION FENCE SECURELY ATTACHED TO EACH BARRICADE SHALL BE PLACED AT THE LOCATIONS SHOWN ON THE PLANS OR AS DIRECTED BY THE ENGINEER. BARRICADES SHALL BE WEIGHTED TO PREVENT BLOWING OVER. BARRICADES SHALL HAVE FLASHING RED LIGHT(S) AND CONFORM TO IDOT STANDARD 701901-02, TYPE II AND LOW PROFILE BARRICADES SHALL CONFORM TO THE DETAILS IN THE PLANS AND SEQUENCE OF CONSTRUCTION. BARRICADE INSTALLATION WILL BE REQUIRED PRIOR TO ACCESS TO THE WORK AREA BY CONTRACTOR'S WORKERS, EQUIPMENT OR MATERIAL. SIGNS SHALL BE PLACED AT EACH TAXIWAY/RUNWAY CLOSURE LOCATION AND SHALL BE ATTACHED TO THE BARRICADES. EACH BARRICADE LOCATION SHALL CONSIST OF ONE "DO NOT ENTER" SIGN AND ONE "AIRCRAFT MOVEMENT AREA" SIGN. SIGNS SHALL BE CONSIDERED INCIDENTAL TO THE CONTRACT. ALL BARRICADES SHALL BE PLACED OUTSIDE OF ACTIVE SAFETY AREAS AND OBJECT FREE AREAS.
- THE CONTRACTOR SHALL CONTACT THE AIRPORT MANAGER THROUGH THE RESIDENT ENGINEER TEN (10) WORKING DAYS IN ADVANCE OF THE START OF CONSTRUCTION SO THAT THE APPROPRIATE NOTAMS MAY BE ISSUED.
- THE CONTRACTOR SHALL BE RESPONSIBLE FOR KEEPING ALL CONSTRUCTION ACCESS GATES CLOSED DURING NON WORKING HOURS. THE CONTRACTOR SHALL PROVIDE A SIGN AT THE ACCESS GATE SAYING "AUTHORIZED PERSONNEL ONLY". THE CONTRACTOR SHALL CLOSE AND LOCK THE ACCESS GATE UPON LEAVING THE SITE. THROUGHOUT THE DURATION OF THE CONTRACT, ANY DAMAGES TO THE ACCESS ROAD, ACCESS GATE OR FENCING ADJACENT TO THE PROJECT SHALL BE REPAIRED BY THE CONTRACTOR TO THE SATISFACTION OF THE RESIDENT ENGINEER. ALL COST RELATING TO CONTRACTOR'S ACCESS AND SECURITY SHALL BE THE RESPONSIBILITY OF THE CONTRACTOR.
- CONTRACTOR WILL BE REQUIRED TO PUT AIRPORT FLAGS OR A WORKING BEACON LIGHT ON ALL EQUIPMENT AT ALL TIMES DURING CONSTRUCTION. SEE FLAG DETAIL, THIS SHEET.
- IN THE CASE OF AN EMERGENCY, CONTRACTOR SHALL NOTIFY AIRPORT MANAGER AND THE RESIDENT ENGINEER IMMEDIATELY.
- DURING ADVERSE WEATHER, THE CONTRACTOR SHALL MAKE PROVISIONS FOR ACCESS TO THE WORK AT NO ADDITIONAL COST TO THE CONTRACT. NO EXTENSION OF CONTRACT TIME WILL BE CONSIDERED FOR DELAYS DUE TO LACK OF ADEQUATE ACCESS TO THE WORK.
- THE TALLEST PIECE OF CONSTRUCTION EQUIPMENT IS ANTICIPATED TO BE AN ASPHALT/STONE TRUCK WHICH HAS A MAXIMUM HEIGHT OF 25 FEET IN A DUMP POSITION.
- IF RUNWAY NUMERALS ARE PRESENT DURING CONSTRUCTION THEN CONTRACTOR SHALL PLACE CLOSED RUNWAY MARKER OVER NUMERALS AS DETAILED, OTHERWISE PLACE RUNWAY CLOSED MARKER IN TURF AT ENDS OF RUNWAY AS DETAILED.
- CHICAGO EXECUTIVE AIRPORT WILL BE IN OPERATION DURING THE CONSTRUCTION OF THIS PROJECT. COORDINATION OF WORK WITH THE AIRPORT IS MANDATORY SO AS TO MINIMIZE IMPACTS ON AIRPORT OPERATIONS.
- APPROXIMATE LOCATION OF HAUL ROUTES ON THE AIRPORT SITE ARE SHOWN ON THE GENERAL PROJECT LAYOUT AND THE PHASING PLANS. IT SHALL BE THE CONTRACTOR'S RESPONSIBILITY TO COORDINATE OFF-SITE HAUL ROUTES (STATE HIGHWAYS, COUNTY ROADS OR CITY STREETS) WITH THE APPROPRIATE OWNER WHO HAS JURISDICTION OVER THE AFFECTED ROUTE. ON-SITE ROADS USED AS HAUL ROUTES SHALL BE MAINTAINED BY THE CONTRACTOR AND SHALL BE RESTORED AT THE CONTRACTOR'S EXPENSE TO THEIR ORIGINAL CONDITION UPON COMPLETION OF BEING USED AS A HAUL ROUTE. BEFORE AND AFTER CONDITION OF ON-SITE HAUL ROUTES SHALL BE JOINTLY INSPECTED AND DETERMINED BY THE CONTRACTOR AND THE ENGINEER. FENCING, DRAINAGE, GRADING AND OTHER MISCELLANEOUS CONSTRUCTION REQUIRED TO CONSTRUCT TEMPORARY HAUL ROUTES OR ACCESS POINTS ON THE AIRPORT WILL BE THE CONTRACTOR'S TOTAL RESPONSIBILITY AND SHALL BE APPROVED BY THE ENGINEER PRIOR TO THE WORK. ALL ON-SITE ACCESS ROADS TO AIRPORT FACILITIES SHALL REMAIN OPEN AND MAINTAINED AT ALL TIMES.
- MOBILIZATION/EQUIPMENT STORAGE AREA WILL BE MADE AVAILABLE FOR CONTRACTOR'S MOBILIZATION AND STORAGE AS SHOWN ON THE PLANS. THIS AREA SHALL BE RESTORED TO THE ORIGINAL CONDITION UPON COMPLETION OF THE PROJECT AT THE CONTRACTOR'S EXPENSE.

- LOCATION OF KNOWN EXISTING AIRPORT UNDERGROUND CABLES ARE SHOWN ON THE PLANS AND MUST BE VERIFIED BY THE CONTRACTOR. REPAIR OF DAMAGED CABLE MUST BE STARTED IMMEDIATELY AND CONTINUED UNTIL COMPLETED. ALL SUCH REPAIRS SHALL BE IN ACCORDANCE WITH THE SPECIFICATIONS, OR AS DIRECTED BY THE OWNER OF THE CABLE OR FACILITY, AND SHALL BE AT THE CONTRACTOR'S EXPENSE. IF FAA CABLES ARE DAMAGED, REPAIRS SHALL BE DONE FROM PREVIOUS EXISTING TERMINATION POINT TO PREVIOUS EXISTING TERMINATION POINT IN ACCORDANCE WITH FAA REQUIREMENTS AND IN THE PRESENCE OF A FAA REPRESENTATIVE. THE OWNER MAY ELECT TO HAVE THE REPAIR PERFORMED BY OTHERS IN WHICH CASE THE CONTRACTOR SHALL BE RESPONSIBLE FOR PAYING THE INCURRED COSTS OF REPAIRS.
- COORDINATION MEETINGS - THE CONTRACTOR SHALL CONDUCT WEEKLY COORDINATION MEETINGS TO DISCUSS WORK AREAS AND SCHEDULING, ETC. WITH THE ENGINEER, AIRPORT OPERATIONS, FAA, AND OTHER APPROPRIATE OFFICIALS. MINUTES FROM THE WEEKLY MEETINGS SHALL BE PREPARED BY THE CONTRACTOR, FURNISHED TO ALL ATTENDEES PRIOR TO THE SUBSEQUENT MEETING, AND KEPT ON FILE AT THE FIELD OFFICE. THE COORDINATION MEETING COSTS SHALL BE CONSIDERED INCIDENTAL TO THE PROJECT.
- THE CONTRACTOR SHALL PROVIDE THE PHONE NUMBERS OF THREE PERSONNEL, INCLUDING THE PROJECT SUPERINTENDENT, WHO MAY BE CONTACTED IN AN EMERGENCY. PERSONNEL SHALL BE ON CALL 24 HOURS PER DAY FOR MAINTAINING AIRPORT HAZARD LIGHTING AND BARRICADES.
- DRAINAGE MODIFICATIONS SHALL BE SEQUENCED TO PROVIDE POSITIVE DRAINAGE AT ALL TIMES AT NO ADDITIONAL COST TO THE CONTRACT.
- VEHICLES AND EQUIPMENT SHALL NOT BE ALLOWED WITHIN THE TAXIWAY OBJECT FREE AREA AND RUNWAY SAFETY AREA OF ACTIVE TAXIWAYS AND RUNWAYS.
- CONTRACTOR SHALL STORE EQUIPMENT AND MATERIALS IN SUCH A MANNER AS NOT TO VIOLATE FEDERAL AVIATION ADMINISTRATION PART 77 IMAGINARY SURFACES OR RUNWAY AND TAXIWAY SAFETY AREAS.
- ALL EXISTING TAXIWAY AND RUNWAY AIRFIELD LIGHTING CIRCUITS, FAA CABLES AND OTHER ELECTRICAL CABLES SHALL REMAIN IN SERVICE AT ALL TIMES. ALL EXISTING LIGHTING AND VAULT EQUIPMENT SHALL REMAIN IN SERVICE UNTIL PROPOSED IMPROVEMENTS ARE INSTALLED AND OPERATIONAL, UNLESS OTHERWISE APPROVED BY THE ENGINEER. ANY CABLES DAMAGED BY THE CONTRACTOR SHALL BE IMMEDIATELY REPAIRED AT HIS EXPENSE. ANY NECESSARY TEMPORARY JUMPER CABLES SHALL BE CONSIDERED INCIDENTAL TO THE CONTRACT.
- COORDINATION BY THE CONTRACTOR WITH THE EXISTING UTILITIES SHALL BE COMPLETED BEFORE CONSTRUCTION IS STARTED. CONTRACTOR IS REFERRED TO SECTION 50-17 OF THE SPECIAL PROVISIONS FOR SPECIFIC REQUIREMENTS. THE LOCATION OF UNDERGROUND UTILITIES AS INDICATED ON THE PLANS HAS BEEN OBTAINED FROM EXISTING RECORDS. NEITHER THE OWNER OR THE DESIGN ENGINEER ASSUME ANY RESPONSIBILITY WHATSOEVER IN RESPECT TO THE ACCURACY, COMPLETENESS OR SUFFICIENCY OF THE INFORMATION. THERE IS NO GUARANTEE, EITHER EXPRESSED OR IMPLIED THAT THE LOCATIONS, SIZE AND TYPE MATERIAL OF EXISTING UNDERGROUND UTILITIES AS INDICATED ARE REPRESENTATIVE OF THOSE TO BE ENCOUNTERED DURING CONSTRUCTION. IT SHALL BE THE CONTRACTOR'S RESPONSIBILITY TO DETERMINE THE ACTUAL LOCATION OF ALL SUCH FACILITIES, INCLUDING SERVICE CONNECTIONS TO UNDERGROUND UTILITIES. PRIOR TO CONSTRUCTION, THE CONTRACTOR SHALL NOTIFY THE UTILITY COMPANY OF HIS OPERATIONAL PLANS. THE CONTRACTOR SHALL MAKE ARRANGEMENTS FOR DETAILED INFORMATION AND ASSISTANCE IN LOCATING UTILITIES. IN THE EVENT AN UNEXPECTED UTILITY INTERFERENCE IS ENCOUNTERED DURING CONSTRUCTION, THE CONTRACTOR SHALL IMMEDIATELY NOTIFY THE UTILITY COMPANY, THE RESIDENT ENGINEER AND THE AIRPORT MANAGER. ANY SUCH MAINS AND/OR SERVICES DISTURBED BY THE CONTRACTOR'S OPERATIONS SHALL BE RESTORED IMMEDIATELY AT HIS EXPENSE TO THE SATISFACTION OF THE RESIDENT ENGINEER AND AIRPORT MANAGER.
- ALL AIRFIELD LIGHTING AND LIGHTING GUIDANCE SYSTEMS (NAVAIDS) LOCATED WITHIN AND IMMEDIATELY ADJACENT TO THE CONTRACTORS WORK ZONE SHALL BE CHECKED FOR OPERATIONAL CONDITION PRIOR TO THE DEPARTURE FROM THE AIRPORT WITH THE AIRPORT MANAGER. ANY DEFICIENCIES IN THESE SYSTEMS DUE TO THE ACTS OF CONTRACTOR OR HIS SUBCONTRACTORS, SUPPLIERS OR CONSULTANTS SHALL BE REPAIRED IMMEDIATELY.

CONTRACTOR CROSSING RUNWAY SAFETY AREAS (RSA) AND TAXIWAY OBJECT FREE AREAS (TOFA)

- ANYTIME THE CONTRACTOR IS REQUIRED TO UTILIZE OR CROSS ACTIVE AIRFIELD PAVEMENTS FOR ACCESS TO AND FROM THE WORK ZONE, A FULL TIME CROSSING GUARD IN RADIO CONTACT WITH THE CONTROL TOWER SHALL BE FURNISHED BY THE CONTRACTOR FOR MOVEMENTS OF VEHICLES OR EQUIPMENT TO AND FROM THE WORK ZONE. THE RADIO OPERATOR SHALL BE FAMILIAR WITH AIRPORT GROUND CONTROL PROCEDURES AND DEMONSTRATE KNOWLEDGE OF SAME TO THE AIRPORT. THE AIRPORT RESERVES THE RIGHT TO APPROVE THE CROSSING GUARDS. THE CONTRACTOR SHALL PROVIDE THEIR OWN RADIOS. THIS COST SHALL BE CONSIDERED INCIDENTAL TO THE CONTRACT. THE CONTRACTOR SHALL BE RESPONSIBLE FOR PAYMENT OF MUNICIPAL FINES (\$500 PER OCCURRENCE) DUE TO AIRFIELD INCURSIONS BY HIS EMPLOYEES, SUBCONTRACTORS, SUPPLIERS, CONSULTANTS AND/OR AGENTS.
- ANY PAVEMENT DAMAGED BY CONTRACTOR'S OPERATIONS SHALL BE REPAIRED IMMEDIATELY BY HIM TO THE SATISFACTION OF THE RESIDENT ENGINEER AND AIRPORT MANAGER AT NO ADDITIONAL COST TO THE OWNER. PAVEMENT SHALL BE CONTINUALLY SWEEPED TO PROVIDE DEBRIS FREE SURFACE DURING ALL HAUL ROAD OPERATIONS. THIS COST SHALL NOT BE PAID SEPARATELY BUT SHALL BE CONSIDERED INCIDENTAL TO THE CONTRACT.

LIMITATIONS ON CONSTRUCTION WITHIN RUNWAY SAFETY AREAS (RSA) AND TAXIWAY OBJECT FREE AREAS (TOFA)

- RUNWAYS:**
- THE CONTRACTOR SHALL NOTIFY THE RESIDENT ENGINEER AND AIRPORT MANAGER TEN (10) WORKING DAYS IN ADVANCE OF ANY PLANNED CONSTRUCTION WITHIN THESE LIMITS. ANY WORK WITHIN THE RUNWAY SAFETY AREA WILL REQUIRE A RUNWAY CLOSURE. WORK SHALL BE EXPEDITED IN THESE AREAS AND AT THE END OF EACH WORKING PERIOD THESE AREAS SHALL BE SMOOTHLY GRADED TO ALLOW THE RUNWAY TO BE REOPENED PER FAA REQUIREMENTS. AT LEAST ONE OF THE RUNWAYS SHALL REMAIN IN OPERATION AT ALL TIMES. IF NECESSARY, STEEL PLATES SHALL BE FURNISHED AND INSTALLED BY THE CONTRACTOR TO COVER ANY OPEN TRENCHES OR EXCAVATION WITHIN THE RSA AT NO ADDITIONAL COST TO THE CONTRACT. NO MATERIAL SHALL BE STOCKPILED WITHIN THE RSA. IF DURING RUNWAY CLOSURE AN EMERGENCY IS DECLARED, THE CONTRACTOR SHALL IMMEDIATELY CLEAR THE RUNWAY OF ALL VEHICLES, MEN, EQUIPMENT AND BARRICADES.
- TAXIWAYS:**
- THE CONTRACTOR SHALL NOTIFY THE RESIDENT ENGINEER AND AIRPORT MANAGER FIVE (5) WORKING DAYS IN ADVANCE FOR WORK WITHIN THE TAXIWAY OBJECT FREE AREA. ANY WORK WITHIN THE TAXIWAY OBJECT FREE AREA WILL REQUIRE A TAXIWAY CLOSURE. CONSTRUCTION MAY BE ALLOWED UP TO THE EDGE OF THE TAXIWAY PAVEMENTS WITHOUT CLOSURE ON A LIMITED BASIS AS DETERMINED BY THE AIRPORT MANAGER AND THE CONTRACTOR WILL BE REQUIRED TO HAVE WING WALKERS AND FLAGGERS AT HIS OWN COST. WORK WITHIN THE TAXIWAY OBJECT FREE AREA SHALL BE EXPEDITED AND AT THE END OF EACH WORKING PERIOD THESE AREAS SHALL BE SMOOTHLY GRADED TO ALLOW THE TAXIWAY TO BE REOPENED PER FAA REQUIREMENTS. IF NECESSARY, STEEL PLATES SHALL BE FURNISHED AND INSTALLED BY THE CONTRACTOR TO COVER ANY OPEN TRENCHES OR EXCAVATION WITHIN THE TOFA AT NO ADDITIONAL COST TO THE CONTRACT. NO MATERIAL SHALL BE STOCKPILED WITHIN THE TOFA. SHOULD IT BE NECESSARY FOR THE CONTRACTOR TO TEMPORARILY RELOCATE EQUIPMENT TO ALLOW AIRCRAFT TO PASS, THEY SHALL DO SO AT NO EXTRA COST TO THE PROJECT.

**DESIGN AIRCRAFT APPROACH CATEGORY: D
DESIGN AIRPORT GROUP: III**

RUNWAY 34 END EMAS
MAXIMUM ANTICIPATED WINGSPAN OF ADG III
GULFSTREAM G500 - WINGSPAN = 93.5'
COMPUTED TAXILANE CENTERLINE TO OBJECT
SEPARATION (TOFA) = 66.1'

CONTRACTOR SHALL PLAN AND PERFORM HIS WORK SO AS NOT TO INTERFERE OR HINDER THE PROGRESS, WORK OR HAUL ROAD ACCESS OF OTHER CONTRACTORS (SEE SPECIAL PROVISIONS SECTION 30-05). THE PRIME CONTRACTOR WILL BE RESPONSIBLE TO COORDINATE CONSTRUCTION ACTIVITIES AND ACCESS BETWEEN ALL ON-SITE CONTRACTORS SUBCONTRACTORS. IT IS ANTICIPATED THE FOLLOWING PROJECTS MAY BE UNDER CONSTRUCTION CONCURRENTLY WITH THIS PROJECT. NO ADDITIONAL COMPENSATION SHALL BE CONSIDERED FOR ANY EFFORTS TO COORDINATE AND ACCESS THE TAXIWAY SITE DUE TO ADJACENT BUILDING CONSTRUCTION

- REHABILITATION OF 34 HOLD PAD IN SE QUADRANT.
- CONSTRUCTION OF BYPASS TAXIWAY IN NW QUADRANT
- HAWTHORNE/SOVEREIGN DEVELOPMENT IN SE QUADRANT
- REHABILITATION OF EAST QUADRANT APRON IN EAST QUADRANT
- RELOCATE AIRPORT BEACON IN NE QUADRANT
- EAST QUADRANT HANGAR AND APRON DEVELOPMENT IN EAST QUADRANT

GROUND CONTROL FREQUENCY: 121.7 MHz
AIR CONTROL FREQUENCY: 119.9 MHz

MAXIMUM ANTICIPATED HEIGHT OF CONSTRUCTION EQUIPMENT:
DUMP TRUCK IN DUMP POSITION - 25'


IN THE EVENT THE CONTRACTOR PROPOSES TO UTILIZE CONSTRUCTION EQUIPMENT THAT IS TALLER THAN WHAT IS LISTED, THE CONTRACTOR WILL BE RESPONSIBLE TO SUBMIT FAA FORM 7460 FOR AIRSPACE APPROVAL. THE RESIDENT ENGINEER WILL PROVIDE BASE AIRPORT INFORMATION FOR THE CONTRACTOR'S USE.

TABLE 1 - CRITICAL POINTS

POINT	APPROXIMATE ELEVATION OF GROUND (1929 DATUM)	ANTICIPATED EQUIPMENT AND HEIGHT	APPROXIMATE ELEVATION OF EQUIPMENT (1929 DATUM)	LATITUDE (NAD 83)	LONGITUDE (NAD 83)
C1	645	PAINT TRUCK - 20'	665	42°06'40.46"	87°54'02.26"
C2	642	PAINT TRUCK - 20'	662	42°06'39.33"	87°53'58.33"
C3	645	SEMI/DUMP TRUCK - 25'	670	42°06'37.89"	87°54'01.23"
C4	643	SEMI/DUMP TRUCK - 25'	668	42°06'38.32"	87°53'59.78"
B1	642	PICK UP TRUCK - 10'	652	42°06'40.52"	87°53'56.91"
B2	639	PICK UP TRUCK - 10'	649	42°06'38.35"	87°53'49.13"
S1	639	SEMI/DUMP TRUCK - 25'	664	42°06'34.67"	87°53'48.50"
S2	639	SEMI/DUMP TRUCK - 25'	664	42°06'37.00"	87°53'46.31"
X1	639	PICK UP TRUCK - 10'	649	42°06'39.13"	87°53'46.77"
X2	642	PICK UP TRUCK - 10'	652	42°06'43.83"	87°53'58.65"

NOTES - ALL PHASES

- ALL EXISTING TAXIWAY AND RUNWAY AIRFIELD LIGHTING CIRCUITS, FAA CABLES AND OTHER AIRPORT ELECTRICAL CABLES SHALL REMAIN IN SERVICE UNTIL REPLACED AS ACCEPTABLE TO THE RESIDENT ENGINEER. ALL TEMPORARY CABLING AND SPLICING NECESSARY TO KEEP THE CIRCUITS IN OPERATION SHALL BE CONSIDERED INCIDENTAL TO CONTRACT.
- ALL TEMPORARY FENCING SHALL BE 6' CHAIN LINK FENCING AS APPROVED BY THE AIRPORT AND SHALL BE CONSIDERED INCIDENTAL TO THE CONTRACT, UNLESS SPECIFICALLY OUT ON THE PLANS.

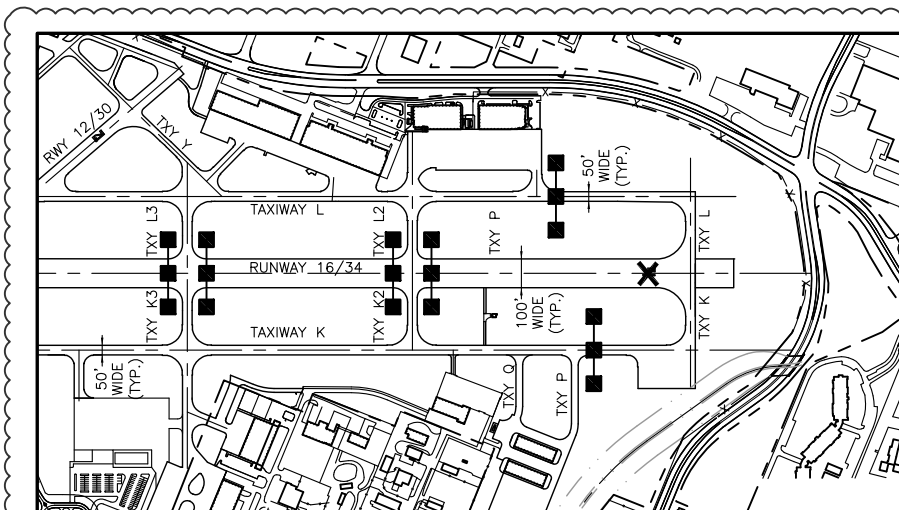

NOTE

- IDOT TYPE II BARRICADES SHALL BE PLACED 100' FROM ADJACENT CENTERLINE(S) OF INTERSECTING TAXIWAYS AT THE LOCATIONS SHOWN ABOVE OR AS DIRECTED BY THE AIRPORT MANAGER.

IL CONTRACT: **PA056**

IL LETTING ITEM: **1A**

IL PROJECT: **PWK-4182**

S.B.G. PROJECT: **3-17-0018-B48**

SURVEY BOOK # BOOK #

REVISIONS

NUMBER	BY	DATE
1	JRL	9-13-13

0 1 2
THIS BAR IS EQUAL TO 2"
AT FULL SCALE (34X22).

**CHICAGO EXECUTIVE AIRPORT
WHEELING/PROSPECT HEIGHTS, ILLINOIS
CONSTRUCT EMAS - RUNWAY 34 END (16 DEPARTURE END)**

**SEQUENCE OF CONSTRUCTION
GENERAL NOTES**

© Copyright CMT, Inc.

CMT
CONSULTING ENGINEERS
License No. 84-000693




DESIGN BY:	JRL
DRAWN BY:	JRO
CHECKED BY:	DLP
APPROVED BY:	BW
DATE:	08/1/2013
JOB No:	11290-03

DATE: Monday, September 16, 2013 9:22:13 AM
FILE: K:\Chicago\Design\11290-03_Amp\4EMAS\Draw\Sheet\4EMAS-Seq-Notes-Layout.dwg
UPDATE BY: Jeremy Linke
LAYOUT: 5-34EMAS-Seq-Notes-Layout1
Dwg (2) 139
IMAGE FILE: pwk\emal\GOV_GEA-4-Color-Std.dwg
Dwg: 134
Emas: 34

DATE: Friday, September 13, 2013 3:03:42 PM
 FILE: K:\ChicagoExecutiv\11290-03_Amp\34EMAS\Draw\Sheet\34EMAS-Sch\Schedule - Layout.dwg
 UPDATE BY: Jeremy Linke
 LAYOUT: 6_34EMAS-Sch\Schedule - Layout1
 Bdf(Z) jlpml
 IMAGE FILES: pwkrunway_GCA-4-Cor-Std
 KRF-DWG: bchml_34_ems.dwg

		ANTICIPATED ACCELERATED CONSTRUCTION SCHEDULE								
		PHASE 1 - SITEWORK - WEEKENDS					PHASE 2 - EMAS - WEEKNIGHTS			
ITEM	DESCRIPTION	Weekend 1	Weekend 2	Weekend 3	Weekend 4	Weekend 5	Nights	Nights	Nights	
		10PM Fri -6AM Mon 5	10PM Fri -6AM Mon 5	10PM Fri -6AM Mon 5	10PM Fri -6AM Mon 5	10PM Fri -6AM Mon 5	10PM-6AM 7	10PM-6AM 7	10PM-6AM 2	
		WORK PERIODS	WORK PERIODS	WORK PERIODS	WORK PERIODS	WORK PERIODS	WORK PERIODS	WORK PERIODS	WORK PERIODS	
ALL PHASES - PRIOR TO CLOSING RUNWAY										
-	Coordinate temporary Runway 16/34 closure with Engineer and Airport.									
-	Coordinate FAA NAVaids shutdown with FAA.									
-	Disconnect appropriate electrical circuits in airfield vault.									
-	Place temporary runway closure markers at ends of Runway 16 and 34.									
-	Place barricades and cones as shown or as directed by the Airport.									
ALL PHASES - PRIOR TO OPENING RUNWAY										
-	Patch/fill all trenches and grade in conformance with plans in runway safety area.									
-	Turn on and check all appropriate electrical circuits in airfield vault.									
-	Sweep Runway, perform safety inspection with Airport and coordinate runway opening.									
PHASE 1 - SITEWORK										
AR108XXX	CABLE									
AR110XXX	DUCT									
AR110 / 125 / 800 / 910	ELEC. ITEMS, ADJUSTMENTS, MARKERS & SIGNS									
AR152410	UNCLASSIFIED EXCAVATION									
AR156XXX	EROSION CONTROL & SWPPP									
AR208515	POROUS GRANULAR EMBANKMENT									
AR209XXX	CRUSHED AGG. BASE COURSE									
AR401610	BITUMINOUS SURFACE COURSE									
AR401XXX	BIT. PAVEMENT MILLING & REMOVAL									
AR403610	BITUMINOUS BASE COURSE									
AR6205XX	PAVEMENT MARKING									
AR705506	6" PERFORATED UNDERDRAIN									
AR800207	EMAS CONCRETE GRADE BEAM									
AR901 & AR908	SEEDING & MULCHING									
PHASE 2 - EMAS INSTALLATION										
AR800208 & AR800209	EMAS BED INSTALLATION									
AR800206	ELEVATED RETROREFLECTIVE MARKER - TYPE 2									
END OF PROJECT										
-	Coordinate turning on FAA NAVaids with FAA.									
-	Coordinate FAA Flight Check with Engineer, Airport and FAA.									




NOTES 1) ASSUMPTIONS: 1 WORK PERIOD = 8 HOURS OF WORK
1 WEEKEND 10PM FRI - 6AM MON = 56 HOURS. ANTICIPATE PUTTING IN 40 HOURS PER WEEKEND = 5 WORK PERIODS, REMAINING TIME IS BUFFER FOR OPENING, EMERGENCIES AND WEATHER
2) AS APPROVED BY THE AIRPORT, ADDITIONAL WEEK NIGHT CLOSURES AND/OR WEEKEND CLOSURES MAY BE REQUIRED TO COMPLETE THE PROJECT IF CLOSURES ARE CANCELED DUE TO ANTICIPATED ADVERSE WEATHER CONDITIONS.
3) PHASE 1 SITEWORK SHALL NOT BE INITIATED UNTIL A FIRM SHIPPING DATE IS ESTABLISHED BETWEEN THE CONTRACTOR AND THE EMAS MANUFACTURER.

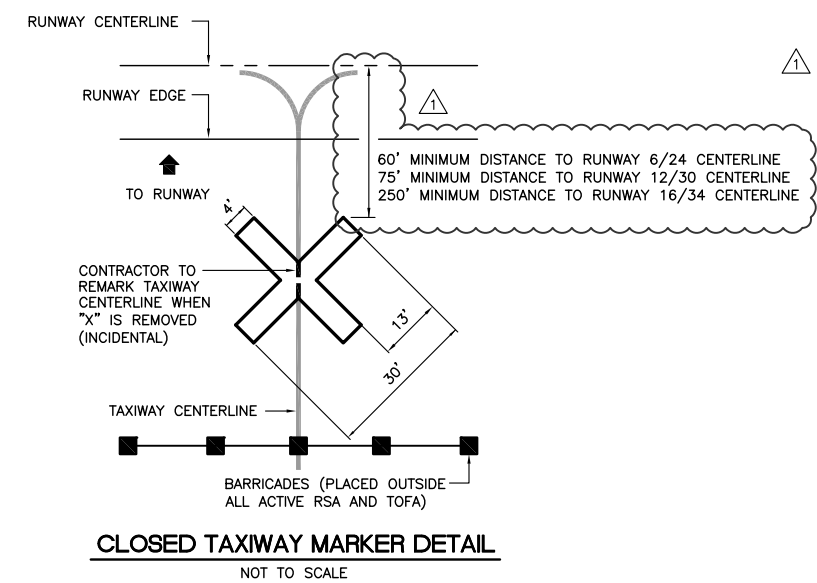

- CLOSED TAXIWAY MARKER DETAIL NOTES**
- CLOSED TAXIWAY MARKERS SHALL BE PAINTED YELLOW WITH TEMPORARY MARKING CAPABLE OF BEING REMOVED WITH LOW PRESSURE WATER BLASTING OR OTHER MATERIAL THAT DOES NOT VIOLATE THE OBJECT FREE AREA CRITERIA AND RUNWAY SAFETY AREA CRITERIA PER ADVISORY CIRCULAR 150/5300-13A (LATEST EDITION) AND ARE APPROVED BY THE AIRPORT.
 - CONTRACTOR SHALL MAINTAIN AND RELOCATE MARKERS AS SHOWN ON THE PLANS OR AS NEEDED TO FACILITATE CONSTRUCTION
 - COST OF FURNISHING, INSTALLING, MAINTAINING AND REMOVING MARKERS SHALL BE CONSIDERED INCIDENTAL TO THE CONTRACT.
 - PLACE MARKERS OVER TAXIWAY CENTERLINE.
 - MARKERS SHALL BE ADEQUATELY SECURED TO PREVENT MOVEMENT BY PROPELLER WASH, JET BLAST OR OTHER WIND CURRENTS.

CLOSED RUNWAY MARKER NOTES

- DURING VARIOUS PHASES OF WORK, IT WILL BE NECESSARY TO CLOSE RUNWAYS TO AIR TRAFFIC ON A TEMPORARY BASIS AS COORDINATED WITH THE AIRPORT AND TOWER PERSONNEL.
- FOR RUNWAY CLOSURES INVOLVING A SINGLE RUNWAY, IT IS ANTICIPATED THAT THE AIRPORT SHALL MOBILIZE AND MAINTAIN THE AIRPORT OWNED LIGHTED "X" S ON EACH END OF THE CLOSED RUNWAY. IF ANY DAMAGE IS INCURRED TO THE AIRPORT LIGHTED "X" S DURING CONSTRUCTION, THE CONTRACTOR SHALL REPLACE THE LIGHT "X" IN KIND AT NO COST TO THE CONTRACT OR AIRPORT.
- FOR RUNWAY CLOSURES INVOLVING MORE THAN ONE RUNWAY, OR IF THE AIRPORT OWNED LIGHTED "X" S ARE NOT AVAILABLE, THE CONTRACTOR SHALL MARK THE RUNWAYS TO BE CLOSED BY PLACING YELLOW CROSS AT THE LOCATION AND DIMENSIONS DETAILED ON THE SEQUENCE OF CONSTRUCTION. THE CROSSES ARE SHOWN ON THE RESPECTIVE RUNWAYS ACCORDING TO THE VARIOUS PHASES OF WORK AS DELINEATED IN THE SUGGESTED SEQUENCE OF CONSTRUCTION.
- TEMPORARY CLOSED RUNWAY MARKERS SHALL BE YELLOW.
- TEMPORARY MARKERS SHALL BE MATERIAL APPROVED BY THE ENGINEER.
- CONTRACTOR SHALL MAINTAIN AND RELOCATE MARKERS AS SHOWN ON THE PLANS OR AS NEEDED TO FACILITATE CONSTRUCTION
- MARKERS ON PAVEMENT SHALL BE PLACED OVER EXISTING RUNWAY NUMERALS AS SHOWN.
- COST OF FURNISHING, INSTALLING, MAINTAINING AND REMOVING MARKERS SHALL BE CONSIDERED INCIDENTAL TO THE CONTRACT.

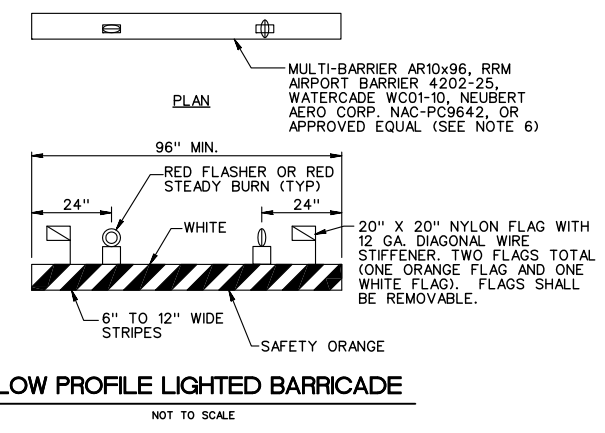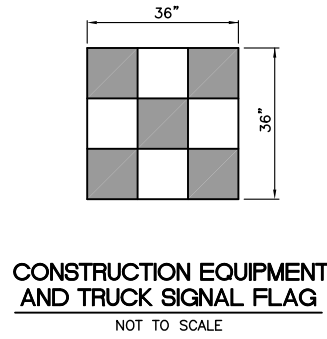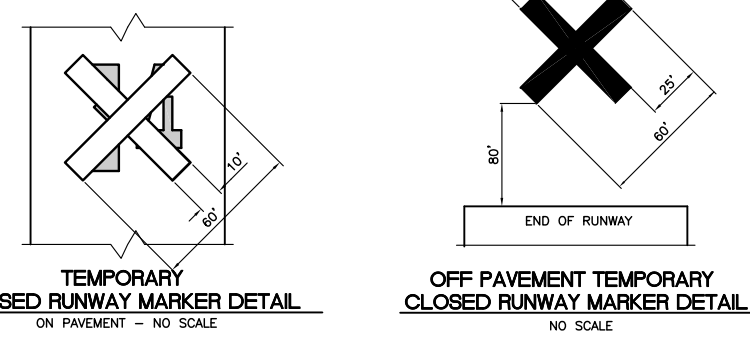

- BARRICADE NOTES:**
- FLASHER OR STEADY BURN LIGHTS SHALL BE BATTERY OR SOLAR POWER OPERATED. LENS SHALL BE RED AND BE ABLE TO ROTATE 90°.
 - FACING OF BARRICADE SHALL BE COVERED WITH REFLECTIVE TAPE OR PAINT.
 - BARRICADES TO BE PLACED END TO END AS INDICATED AT THE LOCATIONS SHOWN ON THE PLANS, ALONG OPERATIONAL PAVEMENT ADJACENT TO CONSTRUCTION OR AS DIRECTED BY THE RESIDENT ENGINEER OR AIRPORT. ALTERNATE FLASHER OR STEADY BURN LENSES SO THAT EVERY OTHER LENS IS ROTATED 90°.
 - FLASHER OR STEADY BURN LIGHTS SHALL BE SECURED TO THE BARRICADES, AS APPROVED BY THE RESIDENT ENGINEER.
 - BARRICADES SHALL BE OF LOW MASS, EASILY COLLAPSIBLE UPON CONTACT WITH AN AIRCRAFT OR ANY OF ITS COMPONENTS, AND WEIGHTED TO AVOID BEING BLOWN OVER.
 - BARRICADES SHALL BE OF A COMMERCIAL DESIGN.

IL. CONTRACT: **PA056**
 IL. LETTING ITEM: **1A**
 IL. PROJECT: **PWK-4182**
 S.B.G. PROJECT: **3-17-0018-B48**

SURVEY BOOK # BOOK #

REVISIONS		
NUMBER	BY	DATE
1	JRL	9-13-13

0 1 2
 THIS BAR IS EQUAL TO 2" AT FULL SCALE (34X22).

CHICAGO EXECUTIVE AIRPORT
WHEELING/PROSPECT HEIGHTS, ILLINOIS
CONSTRUCT EMAS - RUNWAY 34 END (16 DEPARTURE END)
SEQUENCE OF CONSTRUCTION SCHEDULE AND DETAILS

© Copyright CMT, Inc.
CMT
 CRANFORD MERRY & TLLY, INC.
 CONSULTING ENGINEERS
 License No. 84-000693
CHICAGO EXECUTIVE AIRPORT

DESIGN BY:	JRL
DRAWN BY:	JRO
CHECKED BY:	DKP
APPROVED BY:	BW
DATE:	08/1/2013
JOB No:	11290-03



NOTICE TO BIDDERS

1. **TIME AND PLACE OF OPENING BIDS.** Sealed proposals for the improvement described herein will be received by the Department of Transportation at the Harry R. Hanley Building, 2300 South Dirksen Parkway in Springfield, Illinois until 10:00 o'clock a.m., September 20, 2013. All bids will be gathered, sorted, publicly opened and read in the auditorium at the Department of Transportation's Harry R. Hanley Building shortly after the 10:00 a.m. cut off time.

2. **DESCRIPTION OF WORK.** The proposed improvement is identified and advertised for bids in the Invitation for Bids as:

Contract No. PA056
Chicago Executive Airport
Wheeling/Prospect Heights, Illinois
Cook County
Illinois Project No. PWK-4182
SBG Project No. 3-17-0018-B48

Sitework and Installation for Engineered Material Arresting System (EMAS)

3. **INSTRUCTIONS TO BIDDERS.**

(a) This Notice, the invitation for bids, proposal and letter of award shall, together with all other documents in accordance with Article 10-18 of the Illinois Standard Specifications for Construction of Airports, become part of the contract. Bidders are cautioned to read and examine carefully all documents, to make all required inspections, and to inquire or seek explanation of the same prior to submission of a bid.

(b) State law, and, if the work is to be paid wholly or in part with Federal-aid funds, Federal law requires the bidder to make various certifications as a part of the proposal and contract. By execution and submission of the proposal, the bidder makes the certification contained therein. A false or fraudulent certification shall, in addition to all other remedies provided by law, be a breach of contract and may result in termination of the contract.

4. **AWARD CRITERIA AND REJECTION OF BIDS.** This contract will be awarded within 60 calendar days to the lowest responsive and responsible bidder considering conformity with the terms and conditions established by the Department in the proposal and contract documents. The issuance of plans and proposal forms for bidding based upon a prequalification rating shall not be the sole determinant of responsibility. The Department reserves the right to determine responsibility at the time of award, to reject any or all proposals, to readvertise the proposed improvement, and to waive technicalities.

5. **PRE-BID CONFERENCE.** There will be a pre-bid conference held at Thursday, September 12, 2013 at 11:00am, Chicago Executive Airport, 1020 S. Plant Road, Wheeling, IL. at the Chicago Executive Airport administration building. For engineering information, contact Jeremy Linke, P.E. of Crawford, Murphy & Tilly, Inc. at (630) 820-1022.

6. **DISADVANTAGED BUSINESS POLICY.** The DBE goal for this contract is 1.0%.

7. **SPECIFICATIONS AND DRAWINGS.** The work shall be done in accordance with the Illinois Standard Specifications for Construction of Airports, the Illinois Division of Aeronautics Supplemental Specifications and Recurring Special Provisions, the Special Provisions dated August 1, 2013 and the Construction Plans dated August 1, 2013 as approved by the Department of Transportation, Division of Aeronautics.

8. **BIDDING REQUIREMENTS AND BASIS OF AWARD.** When alternates are included in the proposal, the following shall apply:

a. Additive Alternates

(1) Bidders must submit a bid for the Base Bid and for all Additive Alternates.

(2) Award of this contract will be made to the lowest responsible qualified bidder computed as follows:

The lowest aggregate amount of (i) the Base Bid plus (ii) any Additive Alternate(s) which the Department elects to award.

The Department may elect not to award any Additive Alternates. In that case, award will be to the lowest responsible qualified bidder of the Base Bid.

b. Optional Alternates

(1) Bidders must submit a bid for the Base Bid and for either Alternate A or Alternate B or for both Alternate A and

achieve the overall goal. The dollar amount paid to all approved DBE companies performing work called for in this contract is eligible to be credited toward fulfillment of the Department's overall goal.

CONTRACT GOAL TO BE ACHIEVED BY THE CONTRACTOR: This contract includes a specific DBE utilization goal established by the Department. The goal has been included because the Department has determined that the work of this contract has subcontracting opportunities that may be suitable for performance by DBE companies. This determination is based on an assessment of the type of work, the location of the work, and the availability of DBE companies to do a part of the work. The assessment indicates that, in the absence of unlawful discrimination, and in an arena of fair and open competition, DBE companies can be expected to perform 1.0% of the work. This percentage is set as the DBE participation goal for this contract. Consequently, in addition to the other award criteria established for this contract, the Department will only award this contract to a bidder who makes a good faith effort to meet this goal of DBE participation in the performance of the work. A bidder makes a good faith effort for award consideration if either of the following is done in accordance with the procedures set forth in this Special Provision:

- (a) The bidder documents that enough DBE participation has been obtained to meet the goal; or
- (b) The bidder documents that a good faith effort has been made to meet the goal, even though the effort did not succeed in obtaining enough DBE participation to meet the goal.

DBE LOCATOR REFERENCES: Bidders shall consult the IL UCP DBE Directory as a reference source for DBE-certified companies. In addition, the Department maintains a letting and item specific DBE locator information system whereby DBE companies can register their interest in providing quotes on particular bid items advertised for letting. Information concerning DBE companies willing to quote work for particular contracts may be obtained by contacting the Department's Bureau of Small Business Enterprises at telephone number (217)785-4611, or by visiting the Department's web site at www.dot.il.gov.

BIDDING PROCEDURES: Compliance with this Special Provision is a material bidding requirement. The failure of the bidder to comply will render the bid not responsive.

- (a) The bidder shall submit a Disadvantaged Business Utilization Plan on Department forms SBE 2025 and 2026 with the bid.
- (b) The Utilization Plan shall indicate that the bidder either has obtained sufficient DBE participation commitments to meet the contract goal or has not obtained enough DBE participation commitments in spite of a good faith effort to meet the goal. The Utilization Plan shall further provide the name, telephone number and telefax number of a responsible official of the bidder designated for purposes of notification of plan approval or disapproval under the procedures of this Special Provision.
- (c) The Utilization Plan shall include a DBE Participation Commitment Statement, Department form SBE 2025, for each DBE proposed for the performance of work to achieve the contract goal. For bidding purposes, submission of the completed SBE 2025 forms, signed by the DBEs and faxed to the bidder will be acceptable as long as the original is available and provided upon request. All elements of information indicated on the said form shall be provided, including but not limited to the following:
 - (1) The name and address of DBE firms that will participate in the contract;
 - (2) A description, including pay item numbers, of the work each DBE will perform;
 - (3) The dollar amount of the participation of each DBE firm participating. The dollar amount of participation for identified work shall specifically state the quantity, unit price and total subcontract price for the work to be completed by the DBE. If partial pay items are to be performed by the DBE, indicate the portion of each item, a unit price where appropriate and the subcontract price amount;
 - (4) DBE Participation Commitment Statements, form SBE 2025, signed by the bidder and each participating DBE firm documenting the commitment to use the DBE subcontractors whose participation is submitted to meet the contract goal;
 - (5) If the bidder is a joint venture comprised of DBE companies and non-DBE companies, the plan must also include a clear identification of the portion of the work to be performed by the DBE partner(s); and,
 - (6) If the contract goal is not met, evidence of good faith efforts.

GOOD FAITH EFFORT PROCEDURE: The contract will not be awarded until the Utilization Plan submitted by the apparent successful bidder is approved. All information submitted by the bidder must be complete, accurate and adequately document that enough DBE participation has been obtained or document the good faith efforts of the bidder, in the event enough DBE participation has not been obtained, before the Department will commit to the performance of the contract by the bidder. The Utilization Plan will be approved by the Department if the Utilization Plan commits sufficient commercially useful DBE work performance to meet the contract goal or the bidder submits sufficient documentation of a good faith effort to meet the contract goal pursuant to 49 CFR part 26, Appendix A.

The Utilization Plan will not be approved by the Department if the Utilization Plan does not commit sufficient DBE participation to meet the contract goal unless the apparent successful bidder documented in the Utilization Plan that it made a good faith effort to meet the goal. This means that the bidder must show that all necessary and reasonable steps were taken to achieve the contract goal. Necessary and reasonable steps are those which, by their scope, intensity and appropriateness to the objective, could reasonably be