F.A.I.	SECTION	COUNTY	TOTAL SHEETS	SHEET NO.
94/90	*	COOK	565	374
STA.		TO STA.		
FED. ROAD DIST. NO.	ILLINOIS	FED. AID PROJECT		

62301 *(2021-922 PT2 ETC 2324.6-1P) R-10

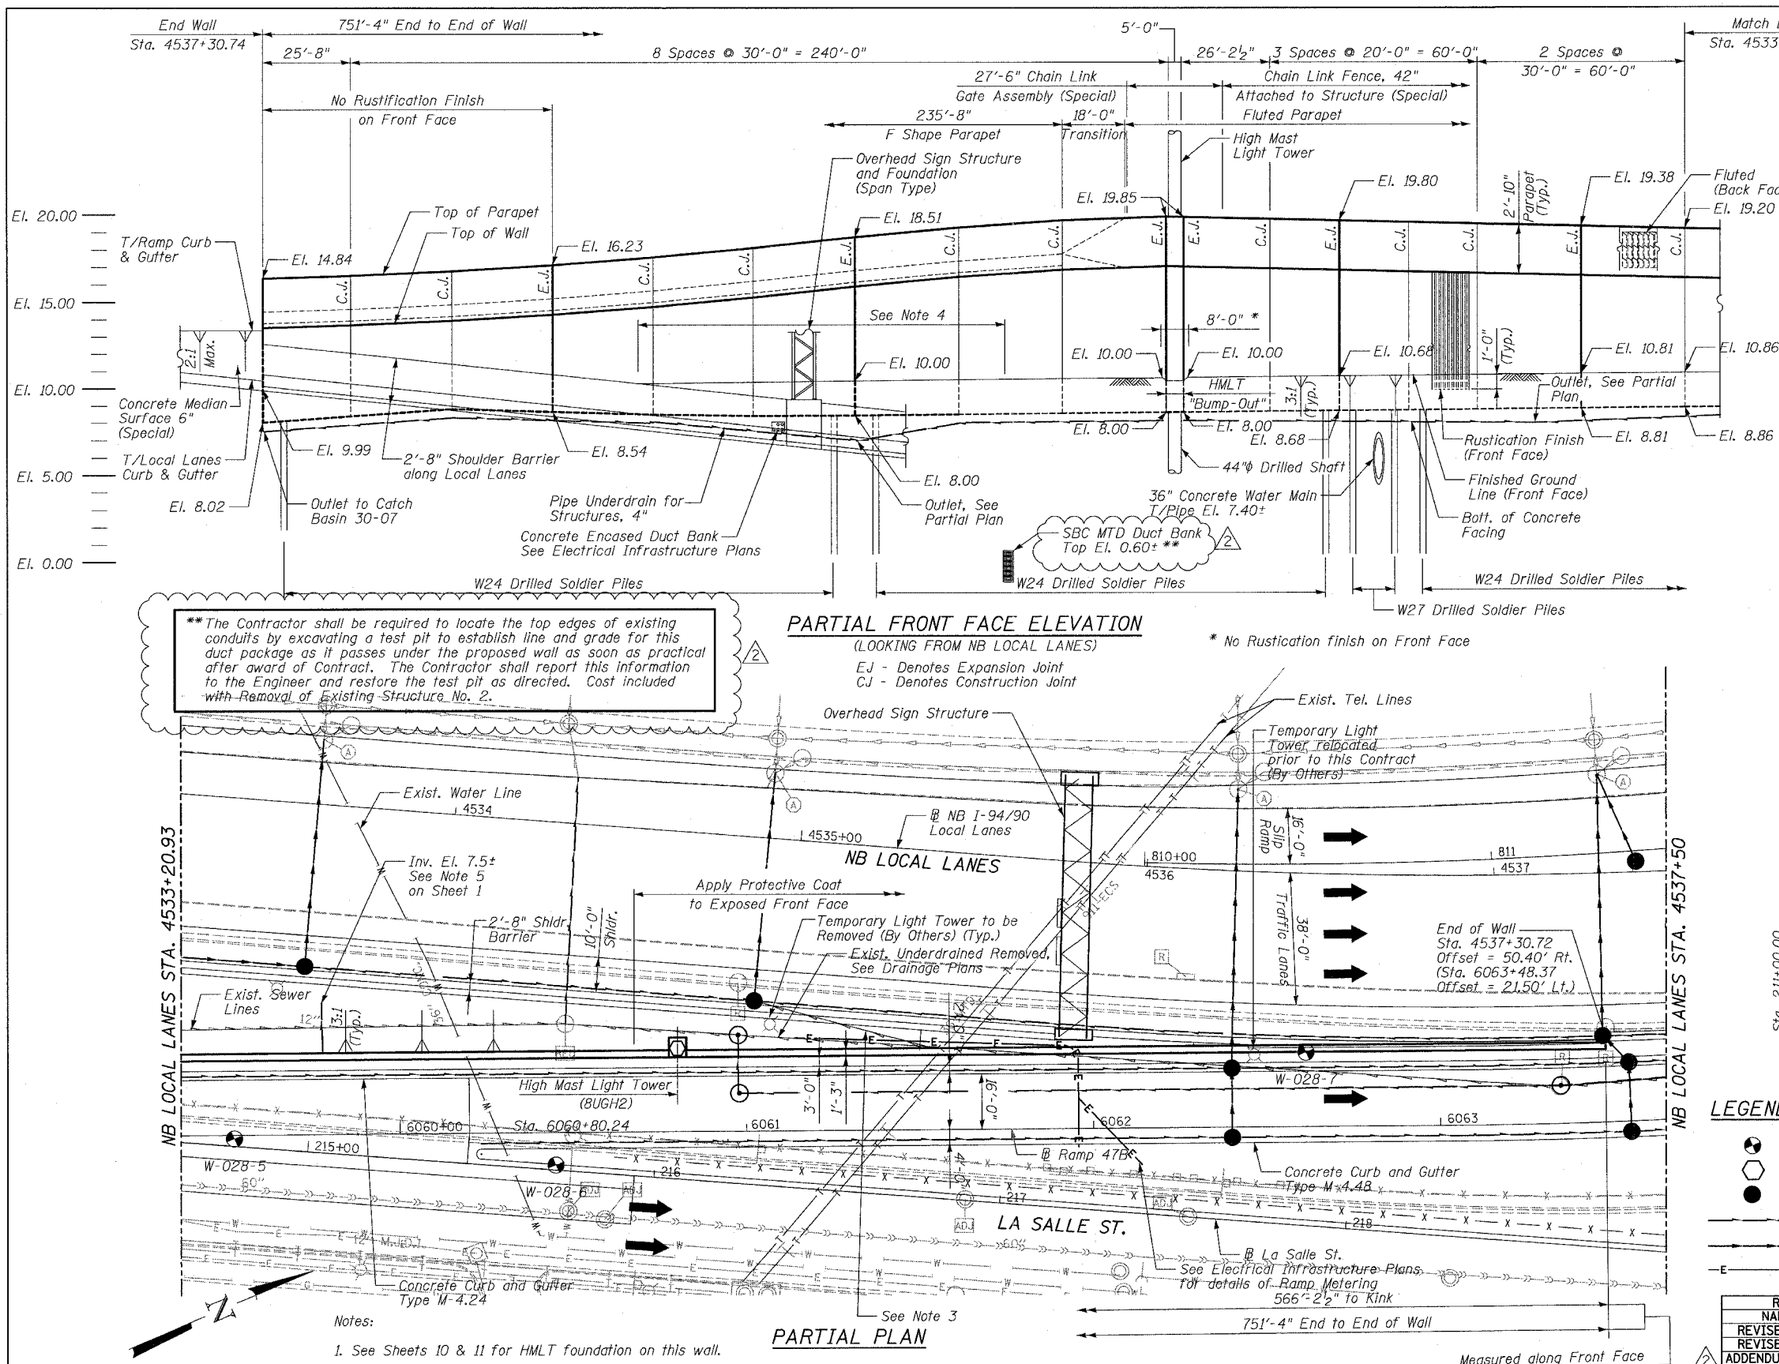

PARTIAL FRONT FACE ELEVATION

(LOOKING FROM NB LOCAL LANES)

EJ - Denotes Expansion Joint
CJ - Denotes Construction Joint

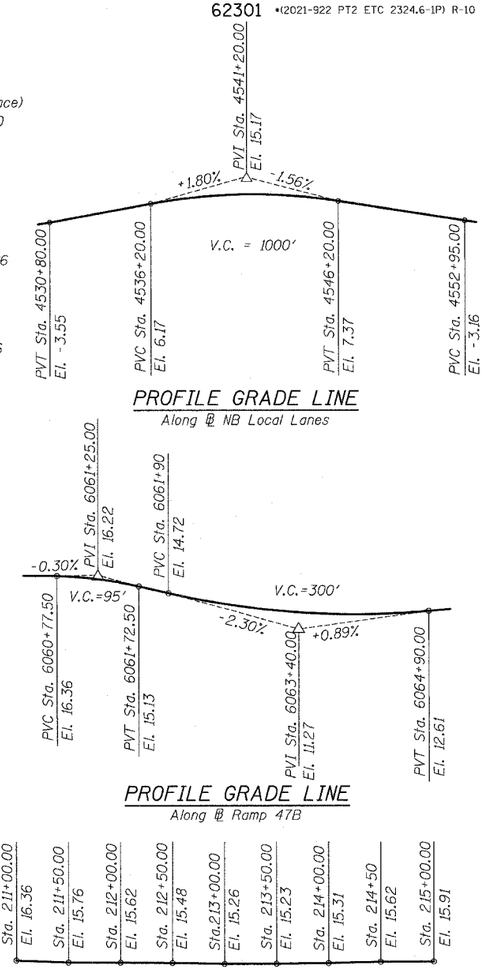

PROFILE GRADE LINE

Along ℄ NB Local Lanes

PROFILE GRADE LINE

Along ℄ Ramp 47B

BASELINE ELEVATIONS

At La Salle St.

PARTIAL PLAN

Notes:

1. See Sheets 10 & 11 for HMLT foundation on this wall.
2. Take notice of existing utilities. See Drainage and Utility Plans and Special Provisions for Status of Utilities to be Adjusted. Piles have been spaced to avoid utilities based upon best available information. Contractor shall verify utility locations, as directed by Engineer, before drilled shaft construction. Cost of verifying utility locations is included with Drilling and Setting Soldier Piles (in Soil).
3. Connect underdrain to Catch Basin at Inv. El. 0.0. Cost included with Pipe Underdrains for Structures, 4".
4. Concrete Median Surface 6" (Special) between front face of wall and back of shoulder barrier, see Roadway Plans for details. Worp paving as required to drain and fit around OHSS foundation.

LEGEND

- Soil Boring Location
- High Mast Lighting (Wall Mounted)
- Proposed Drainage Structure
- Proposed Underdrain
- Proposed Storm Sewer
- Proposed Electrical Line

SHEET 2 OF 24

REVISIONS	
NAME	DATE
REVISED	06/23/06
REVISED	07/13/06
2 ADDENDUM 2	8/04/06

ILLINOIS DEPARTMENT OF TRANSPORTATION

F.A.I. 94/90 (DAN RYAN EXPRESSWAY)
GARFIELD BLVD TO 31ST STREET (NB LOCAL LANES)
COOK COUNTY
STA. 4529+75.90 TO STA. 4537+30.74
RETAINING WALL N-47N-R
GENERAL PLAN AND ELEVATION 2
S.N. 016-W977

SCALE: NTS — DRAWN BY: MTR
DATE: JUNE 9, 2006 — CHECKED BY: BLU

BOWMAN, BARRETT & ASSOCIATES INC.
CONSULTING ENGINEERS
Chicago, Illinois
312.228.0100
www.bbandainc.com

N:\660\cad\MVR\RET WALLS\660_BSSP4MTNR_01.dgn
8/10/2006 3:48:18 PM