F.A.P. RTE.	SECTION	COUNTY	TOTAL SHEETS	SHEET NO.
VAR.	2013-040TS	COOK	84	23
				CONTRACT NO. 60W85
FED. ROAD DIST. NO. _	ILLINOIS	FED. AID PROJECT		

FOR INFORMATION ONLY

SEQUENCE OF OPERATIONS

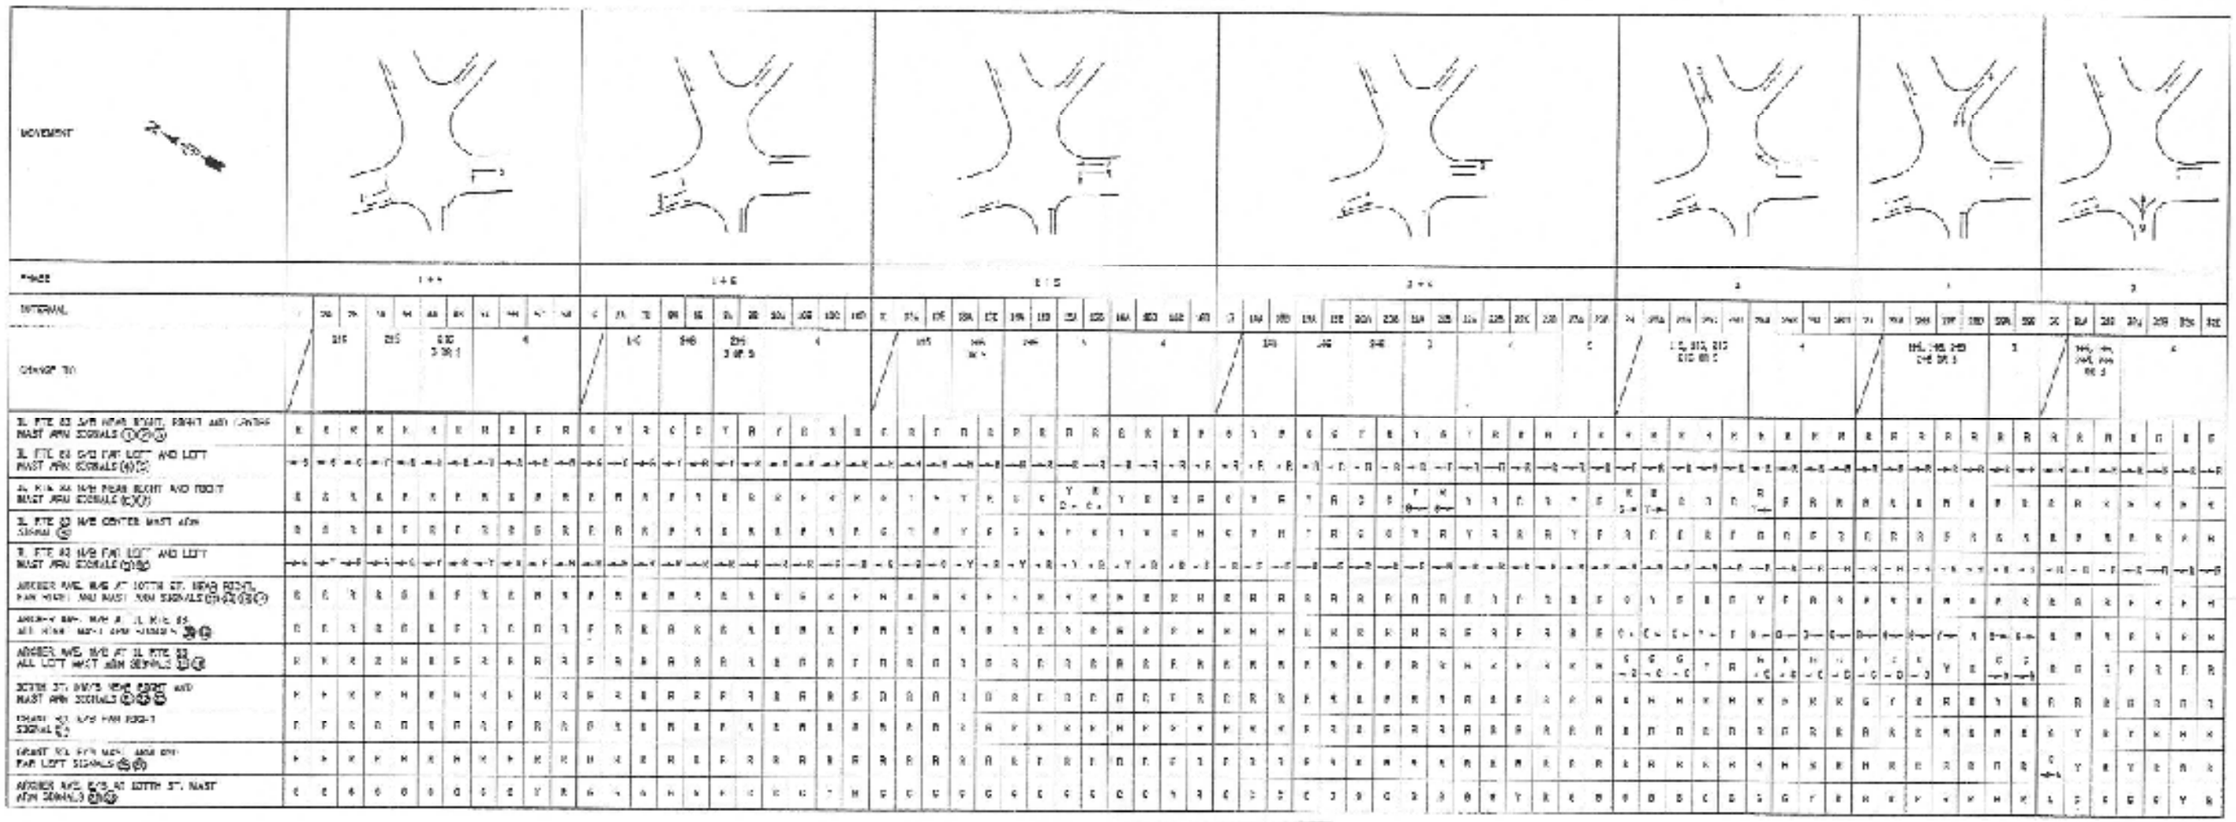

RECORD DRAWINGS
Lyons / Pinner Electric Inc.
(708) 598-6800
Bernie Fay
SUPERVISING ELECTRICIAN
DATE: 3-31-08

REVISIONS	
REMARK	DATE

ILLINOIS DEPARTMENT OF TRANSPORTATION

SEQUENCE OF OPERATIONS
IL ROUTE 171 (ARCHER AVENUE)
AT IL ROUTE 83
PERMIT, ILLINOIS

SCALE: N.T.S.
DATE 08-15-13
DRAWN BY EA
DESIGNED BY PKG
CHECKED BY PKG

TS# 3365
LEMONT

FILE NAME = $FILE$	USER NAME = $USER$	DESIGNED - PKG	REVISED -
		DRAWN - EA, EB, WC	REVISED -
	PLOT SCALE = $SCALE$	CHECKED - PKG	REVISED -
	PLOT DATE = $DATE$	DATE - 8/15/2013	REVISED -

STATE OF ILLINOIS
DEPARTMENT OF TRANSPORTATION

SEQUENCE OF OPERATIONS
IL RTE 171 (ARCHER AVENUE) AT IL RTE 83 /107TH STREET /GRANT AVENUE
(SHEET 2 OF 2)

SCALE: N.T.S. | SHEET NO. OF SHEETS | STA. TO STA.