
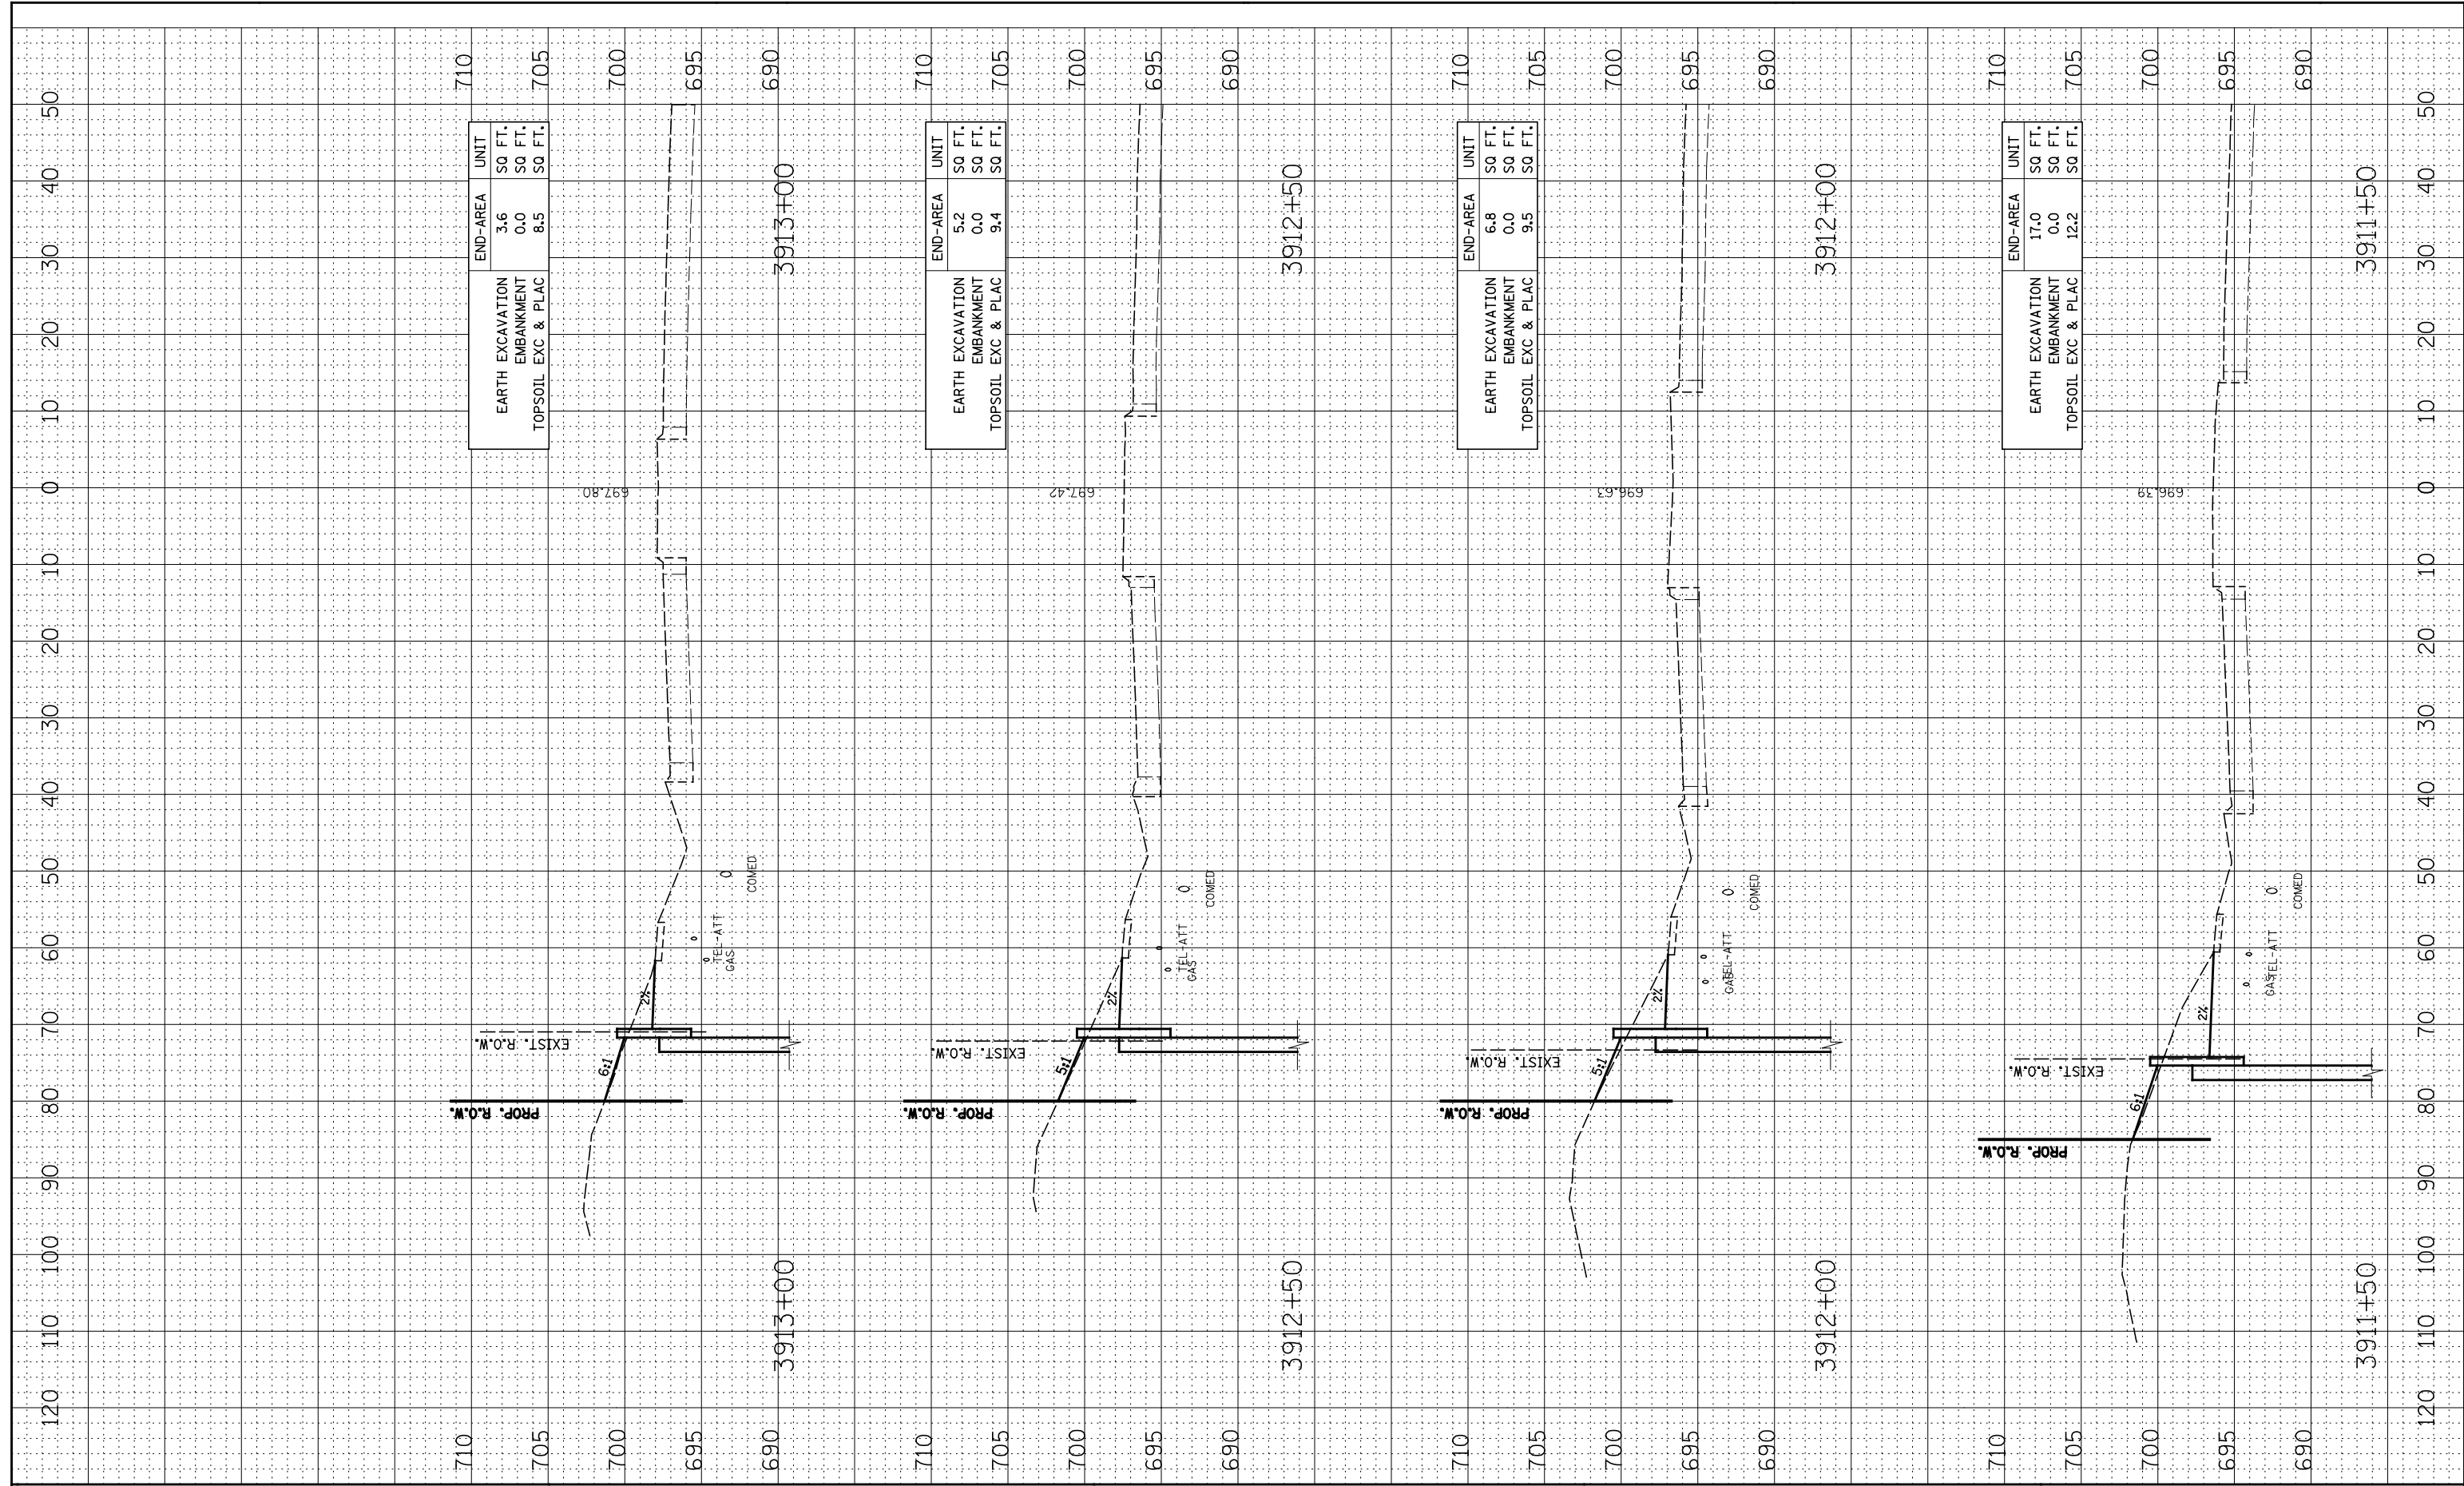



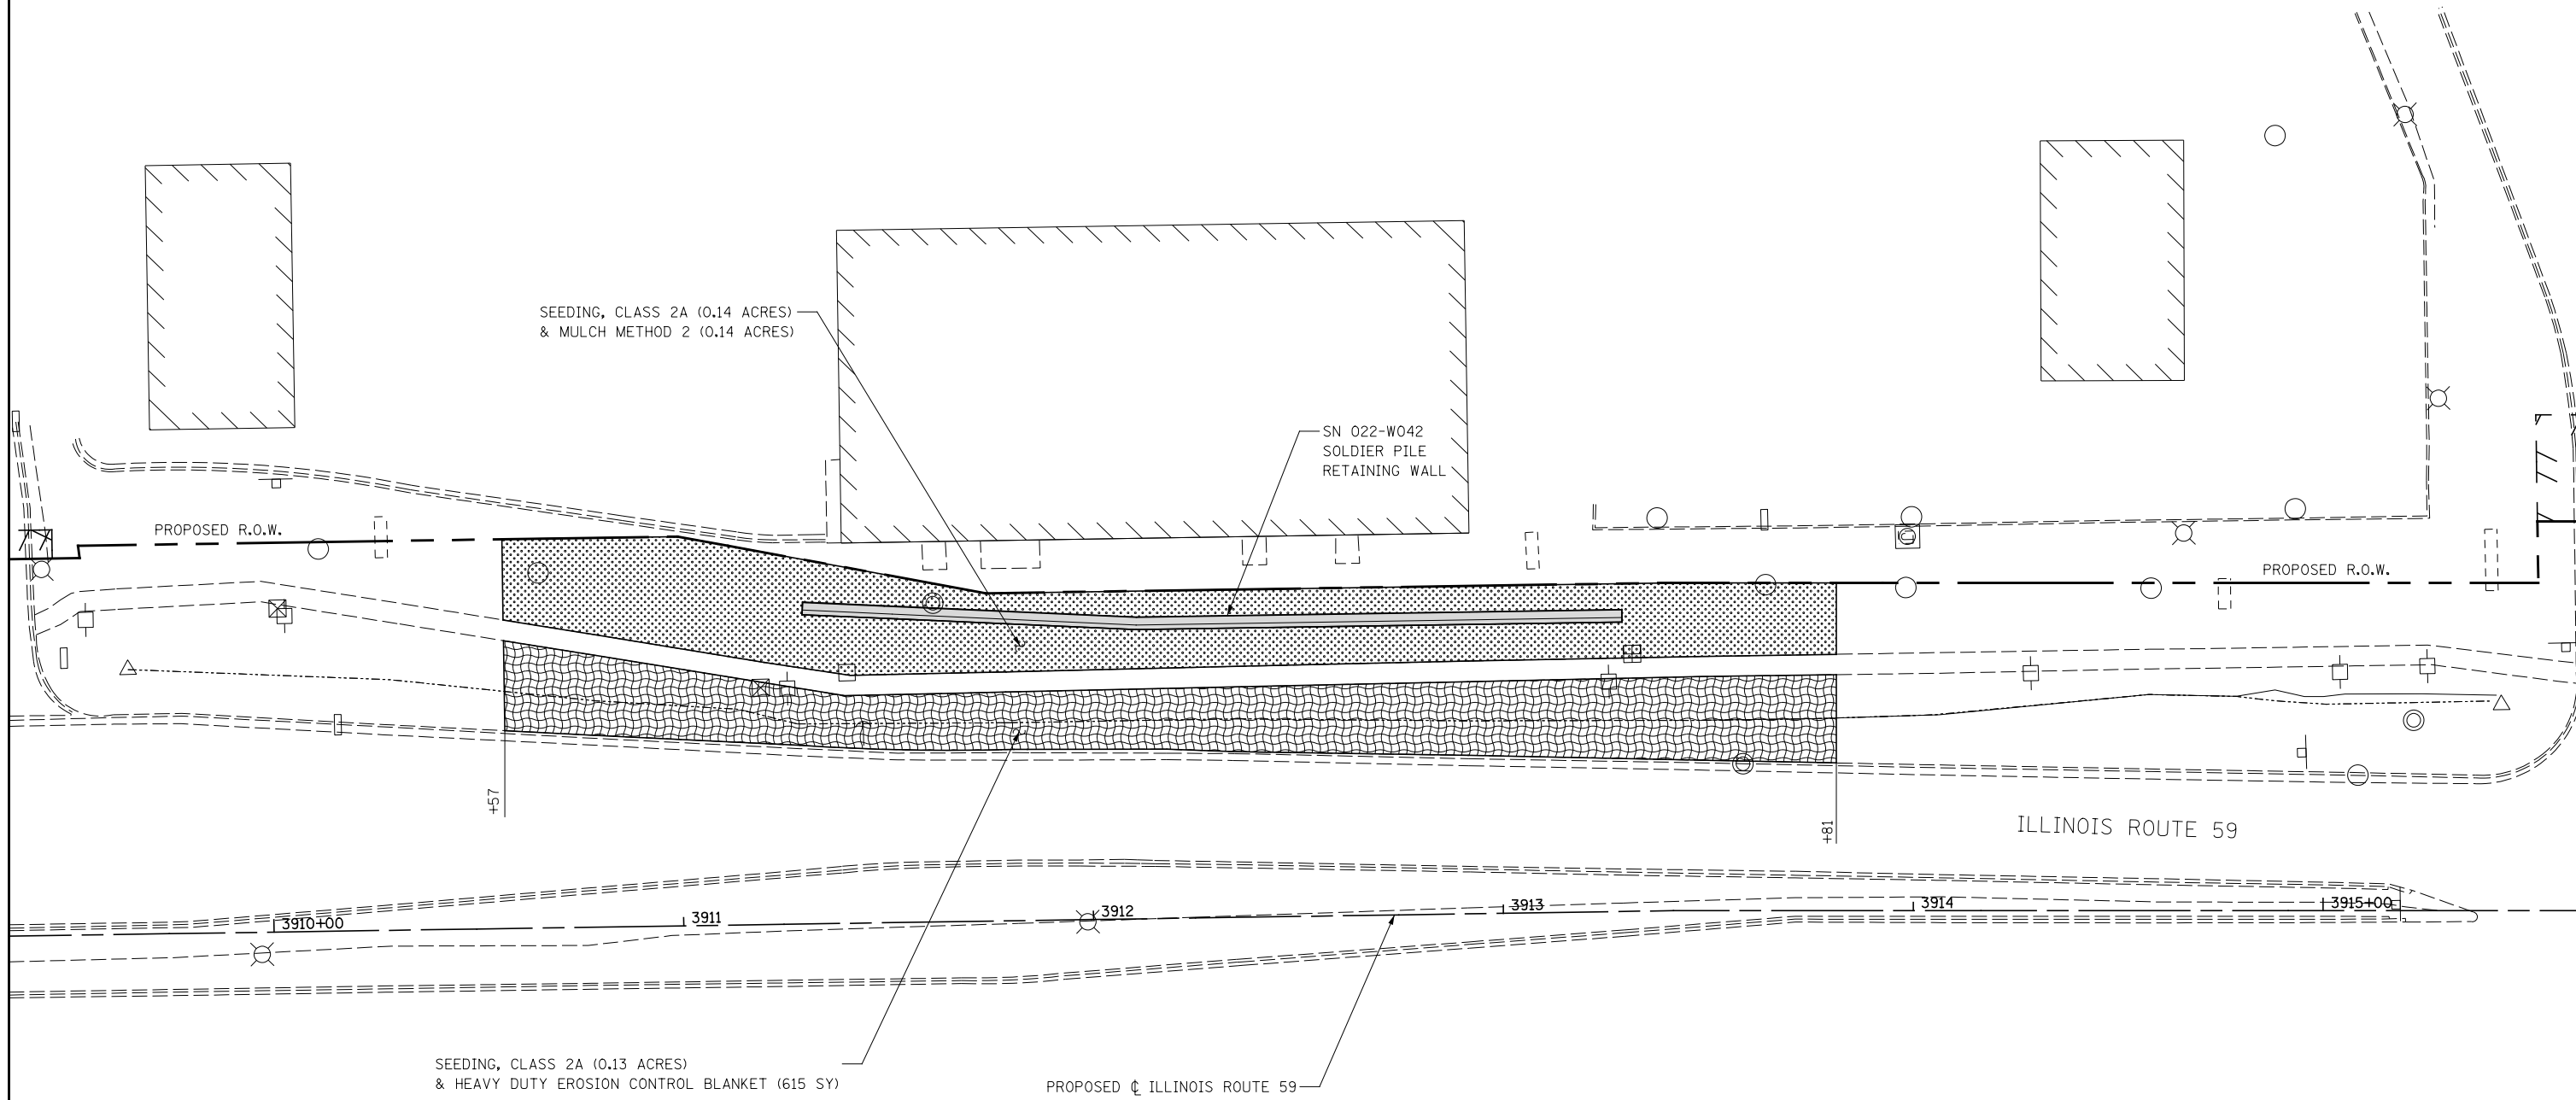
BY	DATE

ORIGINAL SURVEY	SURVEYED
NOTE BOOK	PLOTTED
AREAS CHECKED	TEMPLATE
	AREAS CHECKED

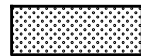

LEGEND

-  TOPSOIL EXCAVATION & PLACEMENT
SEEDING, CLASS 2A
MULCH METHOD 2
-  TOPSOIL EXCAVATION & PLACEMENT
SEEDING, CLASS 2A
HEAVY DUTY EROSION CONTROL BLANKET




NOTES

1. IF ANY DAMAGE OCCURS TO THE EXISTING SIDEWALK, IT SHALL BE REMOVED AND REPLACED AT NO ADDITIONAL COST TO THE CONTRACT.

FILE NAME =	USER NAME = #USER#	DESIGNED <i>NAV</i>	REVISED	STATE OF ILLINOIS DEPARTMENT OF TRANSPORTATION	SN 022-W042 – RESTORATION PLAN	F.A.P. RTE.	SECTION	COUNTY	TOTAL SHEETS	SHEET NO.	
#FILE#		DRAWN <i>KES</i>	REVISED			338	2011-036-I	DUPAGE	234	102	
		CHECKED <i>PJO</i>	REVISED			CONTRACT NO. 60P42					
		DATE <i>05-11-12</i>	REVISED			ILLINOIS FED. AID PROJECT					
					SCALE: AS SHOWN	SHEET NO. 1 OF 1 SHEETS		STA.	TO STA.		


LEGEND

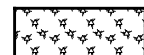

TEMPORARY EROSION CONTROL SEEDING
MULCH METHOD 2



INLET FILTERS

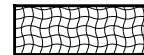


TEMPORARY EROSION CONTROL SEEDING
HEAVY DUTY EROSION CONTROL BLANKET



TEMPORARY DITCH CHECK



PERIMETER EROSION BARRIER

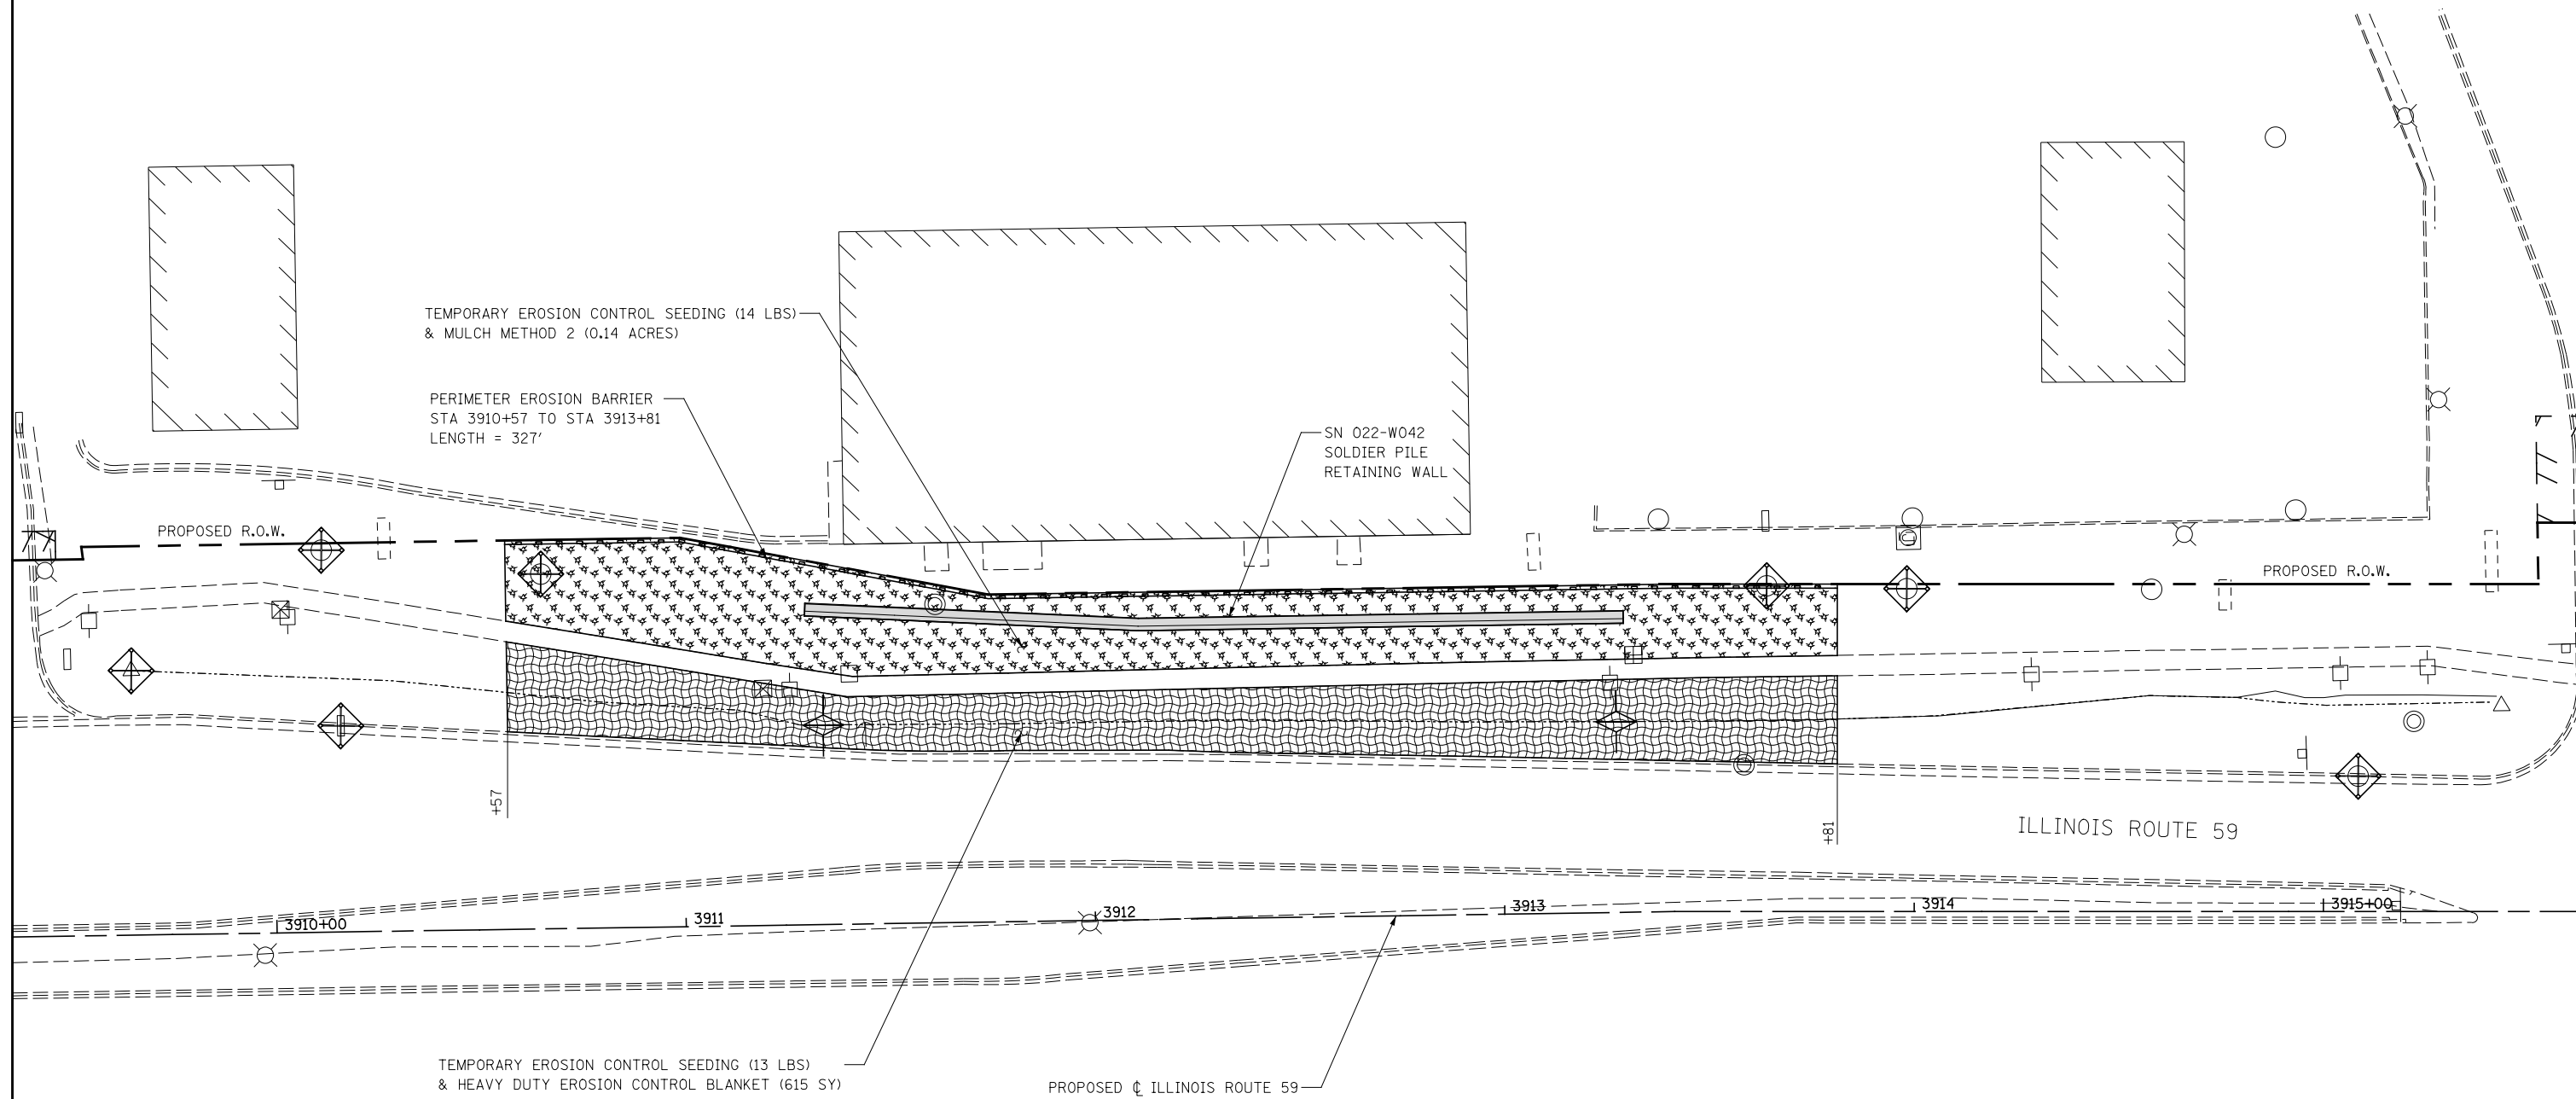

NOTES

- SEE SUGGESTED CONSTRUCTION SEQUENCING SHEET FOR CONSTRUCTION ACTIVITY INFORMATION.

FILE NAME =	USER NAME = \$USER\$	DESIGNED <i>NAV</i>	REVISED
\$FILEL\$		DRAWN <i>KES</i>	REVISED
	PLOT SCALE = \$SCALE\$	CHECKED <i>PJO</i>	REVISED
	PLOT DATE = \$DATE\$	DATE <i>05-11-12</i>	REVISED

**STATE OF ILLINOIS
DEPARTMENT OF TRANSPORTATION**

SN 022-W042 – EROSION CONTROL PLAN

SCALE: AS SHOWN | SHEET NO. 1 OF 1 SHEETS | STA. TO STA.

F.A.P. RTE.	SECTION	COUNTY	TOTAL SHEETS	SHEET NO.
338	2011-036-I	DUPAGE	234	103
CONTRACT NO. 60P42				
ILLINOIS FED. AID PROJECT				

THIS SHEET INTENTIONALLY
LEFT BLANK

FILE NAME = *FILEL*	USER NAME = *USER*	DESIGNED <i>NAV</i>	REVISED	STATE OF ILLINOIS DEPARTMENT OF TRANSPORTATION	SN 022-W042 - EROSION CONTROL PLAN	F.A.P. RTE.	SECTION	COUNTY	TOTAL SHEETS	SHEET NO.	
		DRAWN <i>KES</i>	REVISED			338	2011-036-I	DUPAGE	234	104	
		CHECKED <i>PJO</i>	REVISED			CONTRACT NO. 60P42					
		PLOT DATE = *DATE*	DATE <i>05-11-12</i>			SCALE: AS SHOWN	SHEET NO.	OF	SHEETS	STA.	TO STA.

THIS SHEET INTENTIONALLY
LEFT BLANK

FILE NAME = *FILEL*	USER NAME = *USER*	DESIGNED <i>NAV</i>	REVISED	STATE OF ILLINOIS DEPARTMENT OF TRANSPORTATION	SN 022-W042 - EROSION CONTROL PLAN	F.A.P. RTE.	SECTION	COUNTY	TOTAL SHEETS	SHEET NO.
	DRAWN <i>KES</i>	REVISED	338			2011-036-I	DUPAGE	234	105	
	PLOT SCALE = *SCALE*	CHECKED <i>PJO</i>	REVISED			CONTRACT NO. 60P42			ILLINOIS FED. AID PROJECT	
	PLOT DATE = *DATE*	DATE <i>05-11-12</i>	REVISED			SCALE: AS SHOWN	SHEET NO.	OF	SHEETS	STA.

THIS SHEET INTENTIONALLY
LEFT BLANK

FILE NAME = *FILEL*	USER NAME = *USER*	DESIGNED <i>NAV</i>	REVISED	STATE OF ILLINOIS DEPARTMENT OF TRANSPORTATION	SN 022-W042 - EROSION CONTROL PLAN	F.A.P. RTE.	SECTION	COUNTY	TOTAL SHEETS	SHEET NO.
	DRAWN <i>KES</i>	REVISED	338			2011-036-I	DUPAGE	234	106	
	PLOT SCALE = *SCALE*	CHECKED <i>PJO</i>	REVISED			CONTRACT NO. 60P42				
	PLOT DATE = *DATE*	DATE <i>05-11-12</i>	REVISED			ILLINOIS FED. AID PROJECT				
				SCALE: AS SHOWN		SHEET NO. OF SHEETS		STA. TO STA.		

THIS SHEET INTENTIONALLY
LEFT BLANK

FILE NAME = *FILEL*	USER NAME = *USER*	DESIGNED <i>NAV</i>	REVISED	STATE OF ILLINOIS DEPARTMENT OF TRANSPORTATION	SN 022-W042 - EROSION CONTROL PLAN	F.A.P. RTE.	SECTION	COUNTY	TOTAL SHEETS	SHEET NO.
	DRAWN <i>KES</i>	REVISED	338			2011-036-I	DUPAGE	234	107	
PLOT SCALE = *SCALE*	CHECKED <i>PJO</i>	REVISED	CONTRACT NO. 60P42							
PLOT DATE = *DATE*	DATE <i>05-11-12</i>	REVISED	ILLINOIS FED. AID PROJECT							
				SCALE: AS SHOWN		SHEET NO.	OF	SHEETS	STA.	TO STA.

THIS SHEET INTENTIONALLY
LEFT BLANK

FILE NAME = *FILEL*	USER NAME = *USER*	DESIGNED <i>NAV</i>	REVISED	STATE OF ILLINOIS DEPARTMENT OF TRANSPORTATION	SN 022-W042 - EROSION CONTROL PLAN	F.A.P. RTE.	SECTION	COUNTY	TOTAL SHEETS	SHEET NO.	
	DRAWN <i>KES</i>	REVISED	338			2011-036-I	DUPAGE	234	108		
	PLOT SCALE = *SCALE*	CHECKED <i>PJO</i>	REVISED			CONTRACT NO. 60P42					
	PLOT DATE = *DATE*	DATE <i>05-11-12</i>	REVISED			SCALE: AS SHOWN	SHEET NO.	OF	SHEETS	STA.	TO
ILLINOIS FED. AID PROJECT											

THIS SHEET INTENTIONALLY
LEFT BLANK

FILE NAME = *FILEL*	USER NAME = *USER*	DESIGNED <i>NAV</i>	REVISED	STATE OF ILLINOIS DEPARTMENT OF TRANSPORTATION	SN 022-W042 - EROSION CONTROL PLAN	F.A.P. RTE.	SECTION	COUNTY	TOTAL SHEETS	SHEET NO.	
	DRAWN <i>KES</i>	REVISED	338			2011-036-I	DUPAGE	234	109		
	PLOT SCALE = *SCALE*	CHECKED <i>PJO</i>	REVISED			CONTRACT NO. 60P42					
	PLOT DATE = *DATE*	DATE <i>05-11-12</i>	REVISED			SCALE: AS SHOWN	SHEET NO.	OF	SHEETS	STA.	TO STA.

THIS SHEET INTENTIONALLY
LEFT BLANK

FILE NAME = *FILEL*	USER NAME = *USER*	DESIGNED <i>NAV</i>	REVISED	STATE OF ILLINOIS DEPARTMENT OF TRANSPORTATION	SN 022-W042 - EROSION CONTROL PLAN	F.A.P. RTE.	SECTION	COUNTY	TOTAL SHEETS	SHEET NO.	
	DRAWN <i>KES</i>	REVISED	338			2011-036-I	DUPAGE	234	110		
	PLOT SCALE = *SCALE*	CHECKED <i>PJO</i>	REVISED			CONTRACT NO. 60P42					
	PLOT DATE = *DATE*	DATE <i>05-11-12</i>	REVISED			SCALE: AS SHOWN	SHEET NO.	OF	SHEETS	STA.	TO STA.

Bench Mark: Square "□" cut in west side of light pole base at northwest corner of Chase Bank located at southeast corner of IL Rte 59 and Brookdale Road, Sta. 4012+67. 79' Right, Elev. 714.28


Existing Structure: None

INDEX OF SHEETS

- SE-1. General Plan & Elevation
- SE-2. General Plan & Elevation 2
- SE-3. Soldier Pile Layout 1
- SE-4. Soldier Pile Layout 2
- SE-5. Typical Section
- SE-6. Details
- SE-7. Concrete Facing 1
- SE-8. Concrete Facing 2
- SE-9. Concrete Facing 3
- SE-10. Concrete Facing & Details
- SE-11. Bicycle Railing
- SE-12. Architectural Finish Details
- SE-13. Boring Logs 1
- SE-14. Boring Logs 2



Deborah A. Zerk
 Signature Date
 November 30, 2012
 Expires

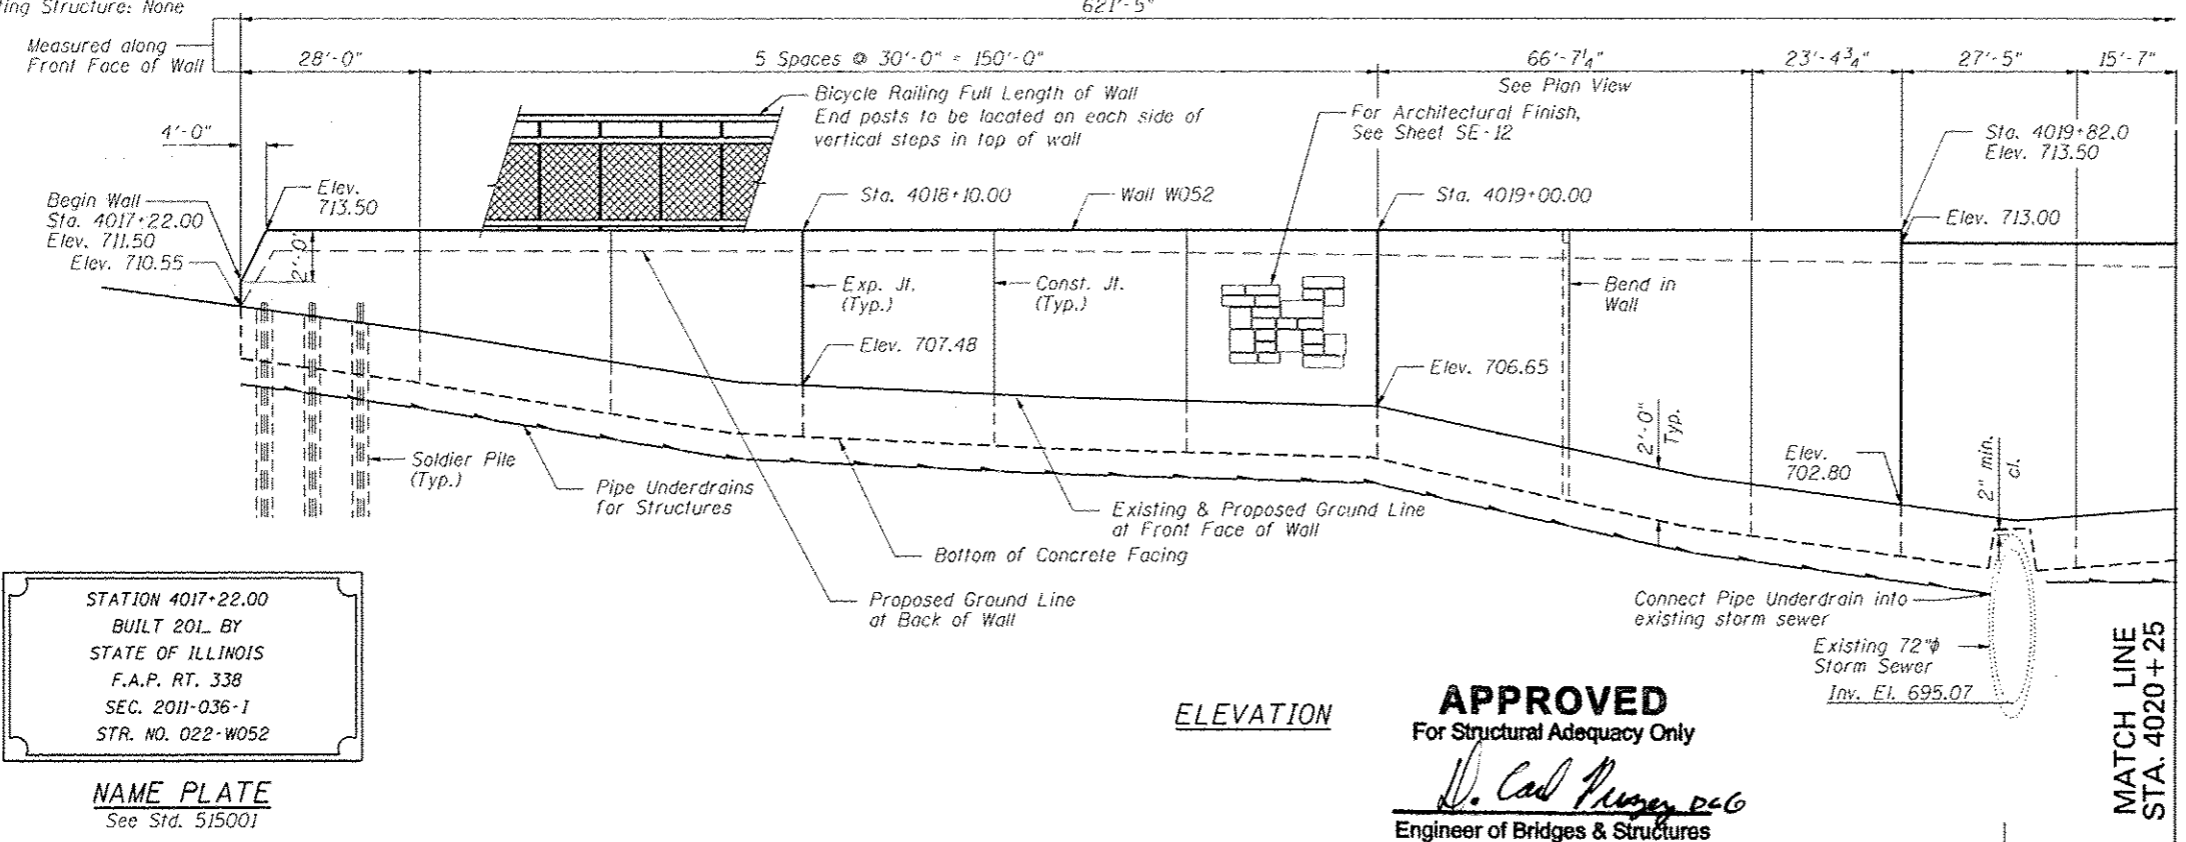


STATION 4017+22.00
 BUILT 201 BY
 STATE OF ILLINOIS
 F.A.P. RT. 338
 SEC. 2011-036-1
 STR. NO. 022-W052

NAME PLATE
 See Std. 515001

ELEVATION

APPROVED
 For Structural Adequacy Only
D. Carl Pusey, P.E.
 Engineer of Bridges & Structures

MATCH LINE
 STA. 4020+25

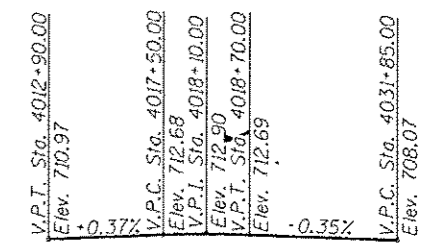

LVC = 120'

PROFILE GRADE

(along inside edge of pavement, proposed IL Route 59)


DESIGN SPECIFICATIONS

2002 AASHTO Standard Specifications for Highway Bridges, 17th Edition

DESIGN STRESSES

FIELD UNITS

- $f'_c = 3,500$ psi
- $f_y = 60,000$ psi (reinforcement)
- $f_y = 36,000$ psi (M270 Grade 36)

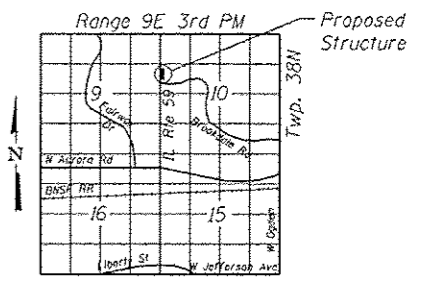

LOCATION SKETCH

GENERAL PLAN & ELEVATION

IL RTE 59 FAP RTE 338

SECTION 2011-036-1

DUPAGE COUNTY

STA. 4017+22.00 TO STA. 4023+28.14


SN 022-W052

Rev. 7-24-12


Note: Offsets are measured from the \odot Proposed IL Rte. 59 to the front face of the wall. Front face of wall does not include architectural finish. See Section on Sheet SE-5.

Soldier piles not shown for clarity.

Roadway work will be in future Contract 60R31.

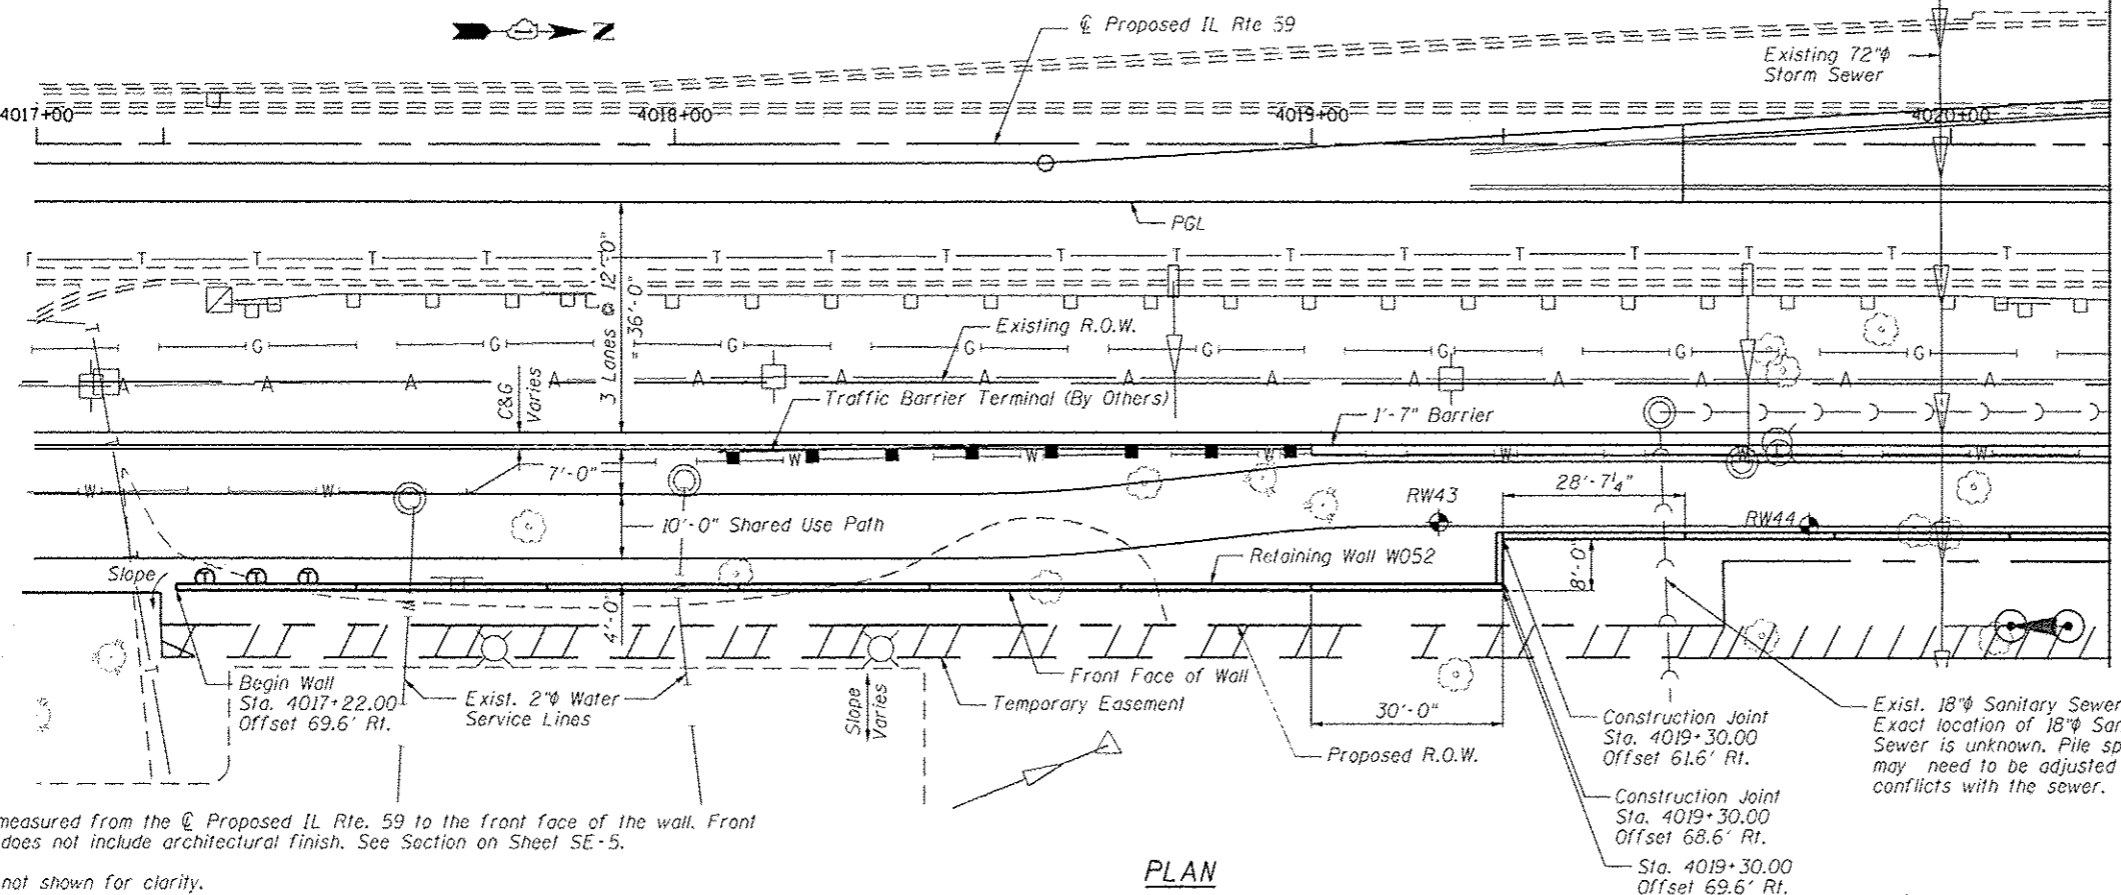

PLAN

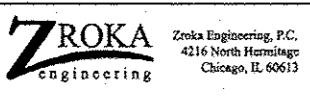


USER NAME - SAW	DESIGNED - LAS	REVISIONS
PL01 SCALE - 3/8" = 1' IN.	CHECKED - DAZ	REVISIONS
PL01 DATE - 7/10/2012	DRAWN - SAW	REVISIONS
	CHECKED - LAS	REVISIONS

STATE OF ILLINOIS
 DEPARTMENT OF TRANSPORTATION

GENERAL PLAN & ELEVATION
 STA. 4017+22.00 TO STA. 4023+28.14 SN 022-W052

SHEET NO. SE-1 OF SE-14 SHEETS


F.A.P. RTE.	SECTION	COUNTY	TOTAL SHEETS	SHEET NO.
338	2011-036-1	DUPAGE	234	111
CONTRACT NO. 60P42			ILLINOIS FED. AID PROJECT	

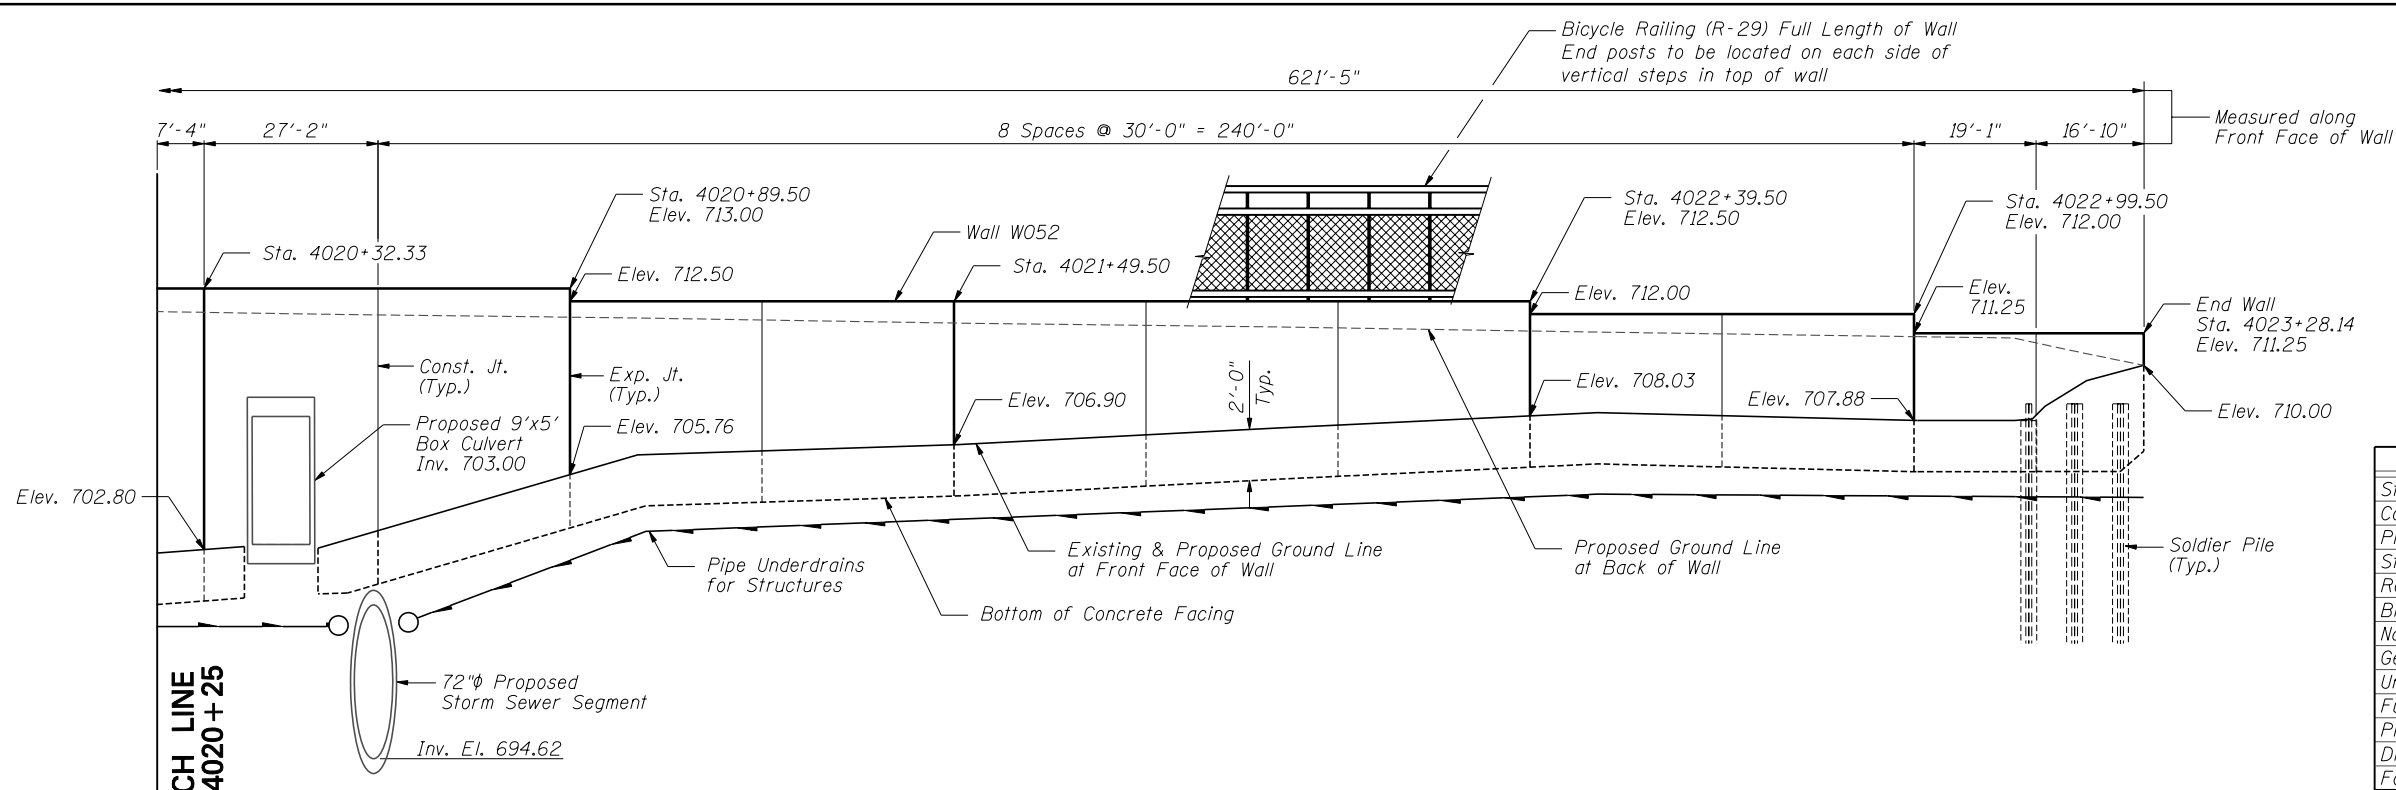

TOTAL BILL OF MATERIAL

ITEM	UNIT	TOTAL
Structure Excavation	Cu. Yd.	389
Concrete Structures	Cu. Yd.	214.1
Protective Coat	Sq. Yd.	181
Stud Shear Connectors	Each	507
Reinforcement Bars, Epoxy Coated	Pound	31,720
Bicycle Railing	Foot	622
Name Plates	Each	1
Geocomposite Wall Drain	Sq. Yd.	282
Untreated Timber Lagging	Sq. Ft.	3,221
Furnishing Soldier Piles (W Section)	Foot	2,155
Pipe Underdrains for Structures, 4"	Foot	645
Drilling and Setting Soldier Piles (In Soil)	Cu. Ft.	12,205
Form Liner Textured Surface	Sq. Ft.	4,505

MATCH LINE
STA. 4020+25

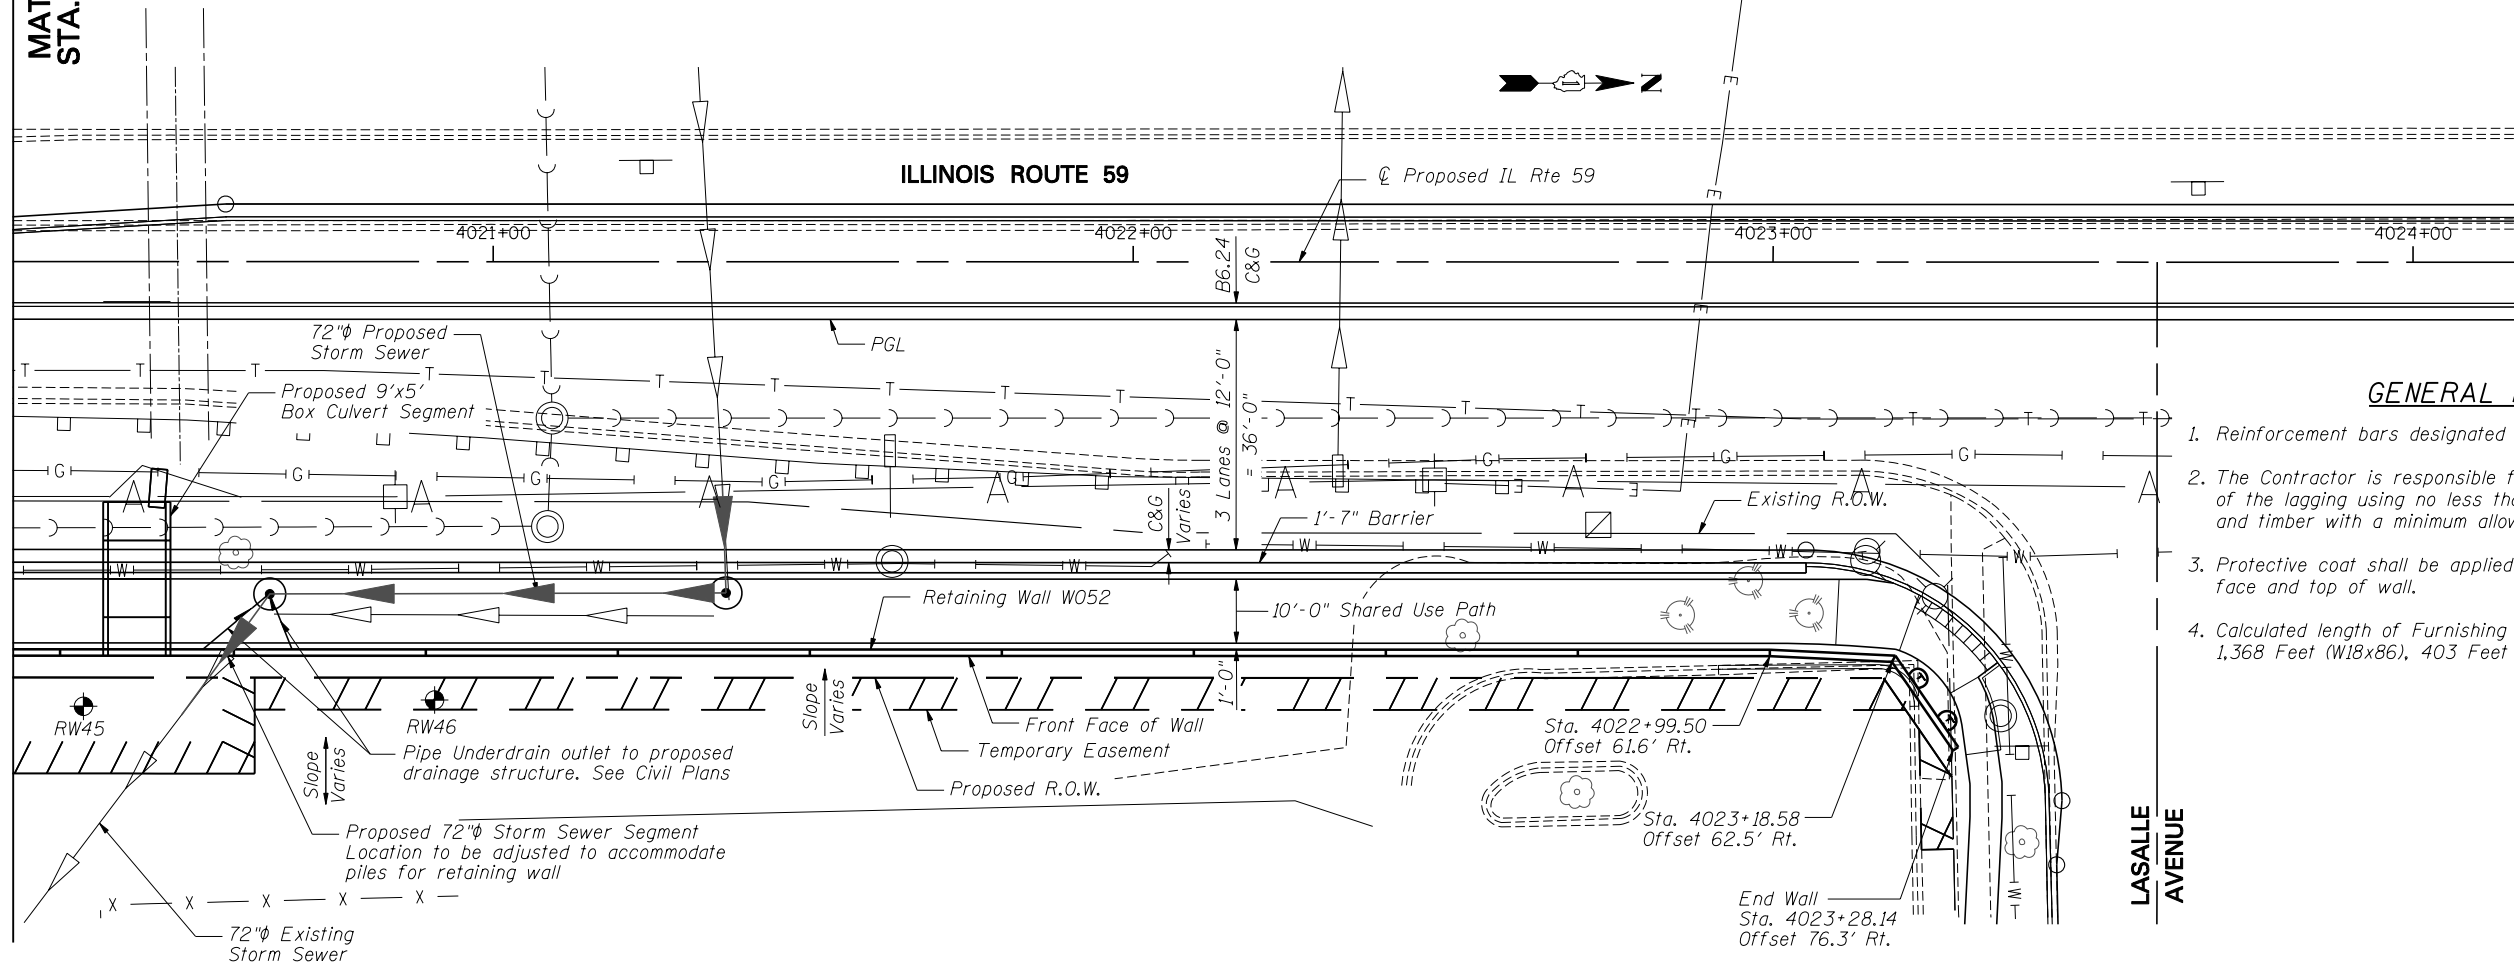

- GENERAL NOTES**
1. Reinforcement bars designated (E) shall be epoxy coated.
 2. The Contractor is responsible for the design and performance of the lagging using no less than 3" nominal rough-sawn thickness and timber with a minimum allowable bending stress of 1000 psi.
 3. Protective coat shall be applied to exposed surfaces of the back face and top of wall.
 4. Calculated length of Furnishing Soldier Piles (W Section) = 1,368 Feet (W18x86), 403 Feet (W33x141), and 384 Feet (W36x160)

Note:
Offsets are measured from the ϕ Proposed IL Rte. 59 to the front face of the wall. Front face of wall does not include architectural finish. See Section on Sheet SE-5.

Soldier piles not shown for clarity.
Roadway work will be in future Contract 60R31.

PLAN

GENERAL PLAN & ELEVATION 2
SN 022-W052



USER NAME = SAW	DESIGNED - LAS	REVISED -
	CHECKED - DAZ	REVISED -
PLOT SCALE = 3/8" = 1' IN.	DRAWN - SAW	REVISED -
PLOT DATE = 5/4/2012	CHECKED - LAS	REVISED -

STATE OF ILLINOIS
DEPARTMENT OF TRANSPORTATION



GENERAL PLAN & ELEVATION 2
STA. 4017+22.00 TO STA. 4023+28.14 SN 022-W052

F.A.P. RTE.	SECTION	COUNTY	TOTAL SHEETS	SHEET NO.
338	2011-036-1	DUPAGE	234	112
CONTRACT NO. 60P42				

SHEET NO. SE-2 OF SE-14 SHEETS

ILLINOIS FED. AID PROJECT


FILE NAME = ...60P42-W052-002-GPEZ.dgn

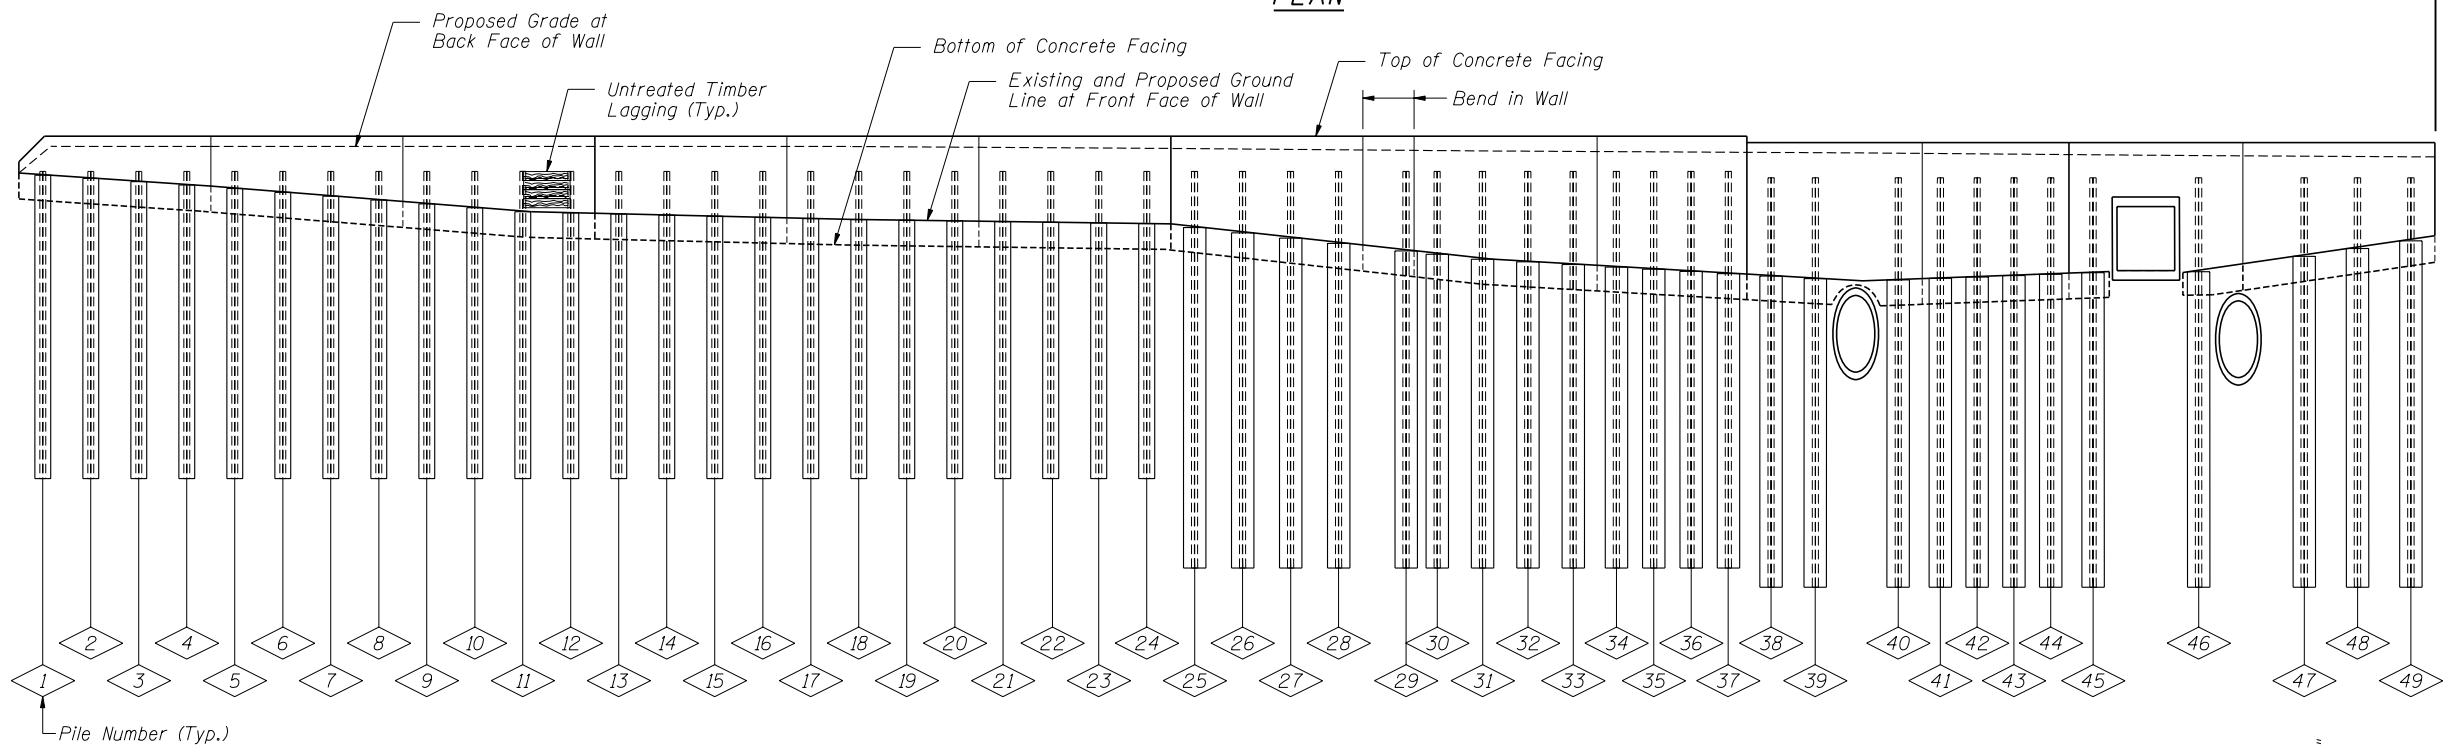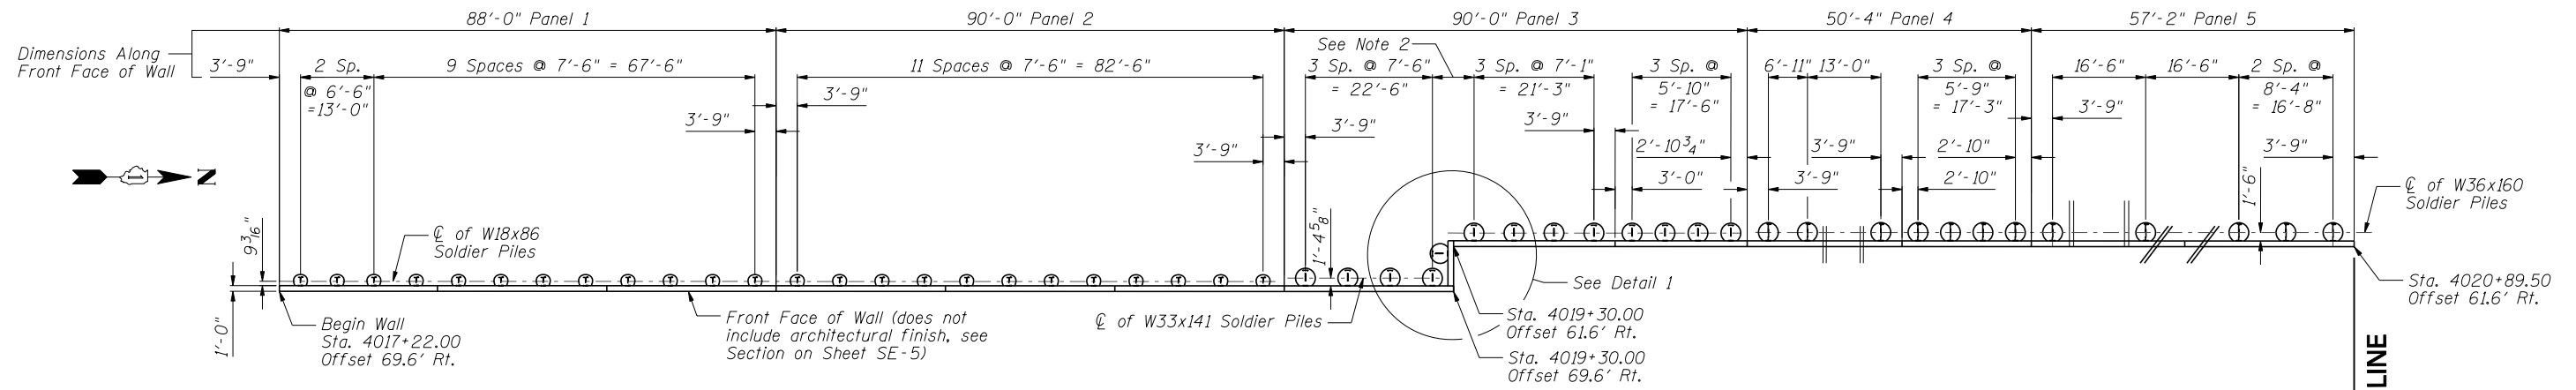

DEVELOPED ELEVATION

PILE SUMMARY

Pile No.	Station	Offset to ϕ Pile	Pile Designation	Length	Bottom Elevation	Top Elevation	Pile No.	Station	Offset to ϕ Pile	Pile Designation	Length	Bottom Elevation	Top Elevation	Pile No.	Station	Offset to ϕ Pile	Pile Designation	Length	Bottom Elevation	Top Elevation	
1	4017+25.75	67.84	W18x86	24'-0"	686.75	710.75	18	4018+51.25	67.84	W18x86	24'-0"	686.75	710.75	35	4019+67.44	59.21	W33x141	31'-0"	679.75	710.75	
2	4017+32.25	67.84	W18x86	24'-0"	686.75	710.75	19	4018+58.75	67.84	W18x86	24'-0"	686.75	710.75	36	4019+73.27	59.21	W33x141	31'-0"	679.75	710.75	
3	4017+38.75	67.84	W18x86	24'-0"	686.75	710.75	20	4018+66.25	67.84	W18x86	24'-0"	686.75	710.75	37	4019+79.11	59.21	W33x141	31'-0"	679.75	710.75	
4	4017+46.25	67.84	W18x86	24'-0"	686.75	710.75	21	4018+73.75	67.84	W18x86	24'-0"	686.75	710.75	38	4019+85.75	59.10	W36x160	32'-0"	678.25	710.25	
5	4017+53.75	67.84	W18x86	24'-0"	686.75	710.75	22	4018+81.25	67.84	W18x86	24'-0"	686.75	710.75	39	4019+92.67	59.10	W36x160	32'-0"	678.25	710.25	
6	4017+61.25	67.84	W18x86	24'-0"	686.75	710.75	23	4018+88.75	67.84	W18x86	24'-0"	686.75	710.75	40	4020+05.67	59.10	W36x160	32'-0"	678.25	710.25	
7	4017+68.75	67.84	W18x86	24'-0"	686.75	710.75	24	4018+96.25	67.84	W18x86	24'-0"	686.75	710.75	41	4020+12.25	59.10	W36x160	32'-0"	678.25	710.25	
8	4017+76.25	67.84	W18x86	24'-0"	686.75	710.75	25	4019+03.75	67.22	W33x141	31'-0"	679.75	710.75	42	4020+18.00	59.10	W36x160	32'-0"	678.25	710.25	
9	4017+83.75	67.84	W18x86	24'-0"	686.75	710.75	26	4019+11.25	67.22	W33x141	31'-0"	679.75	710.75	43	4020+23.75	59.10	W36x160	32'-0"	678.25	710.25	
10	4017+91.25	67.84	W18x86	24'-0"	686.75	710.75	27	4019+18.75	67.22	W33x141	31'-0"	679.75	710.75	44	4020+29.50	59.10	W36x160	32'-0"	678.25	710.25	
11	4017+98.75	67.84	W18x86	24'-0"	686.75	710.75	28	4019+26.25	67.22	W33x141	31'-0"	679.75	710.75	45	4020+36.08	59.10	W36x160	32'-0"	678.25	710.25	
12	4018+06.25	67.84	W18x86	24'-0"	686.75	710.75	29	4019+27.62	62.85	W33x141	31'-0"	679.75	710.75	46	4020+52.58	59.10	W36x160	32'-0"	678.25	710.25	
13	4018+13.75	67.84	W18x86	24'-0"	686.75	710.75	30	4019+33.61	59.21	W33x141	31'-0"	679.75	710.75	47	4020+69.08	59.10	W36x160	32'-0"	678.25	710.25	
14	4018+21.25	67.84	W18x86	24'-0"	686.75	710.75	31	4019+40.69	59.21	W33x141	31'-0"	679.75	710.75	48	4020+77.42	59.10	W36x160	32'-0"	678.25	710.25	
15	4018+28.75	67.84	W18x86	24'-0"	686.75	710.75	32	4019+47.77	59.21	W33x141	31'-0"	679.75	710.75	49	4020+85.75	59.10	W36x160	32'-0"	678.25	710.25	
16	4018+36.25	67.84	W18x86	24'-0"	686.75	710.75	33	4019+54.86	59.21	W33x141	31'-0"	679.75	710.75								
17	4018+43.75	67.84	W18x86	24'-0"	686.75	710.75	34	4019+61.61	59.21	W33x141	31'-0"	679.75	710.75								

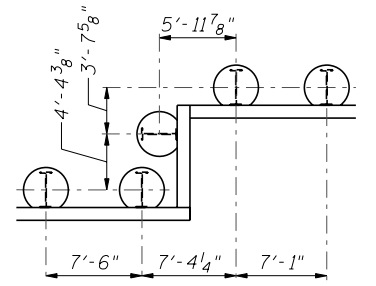

DETAIL 1

- Notes:
- All offsets are to the right of ϕ IL Rte. 59
 - The distance from Pile 28 to Pile 29 along the front face of wall is 10'-6". The distance from Pile 29 to Pile 30 along the front face of wall is 4'-10 1/4".
 - See Sheet SE-4 for Bill of Material.

SOLDIER PILE LAYOUT 1
SN 022-W052



USER NAME = SAW	DESIGNED - LAS	REVISED -
	CHECKED - DAZ	REVISED -
PLOT SCALE = 3/8" = 1' / IN.	DRAWN - SAW	REVISED -
PLOT DATE = 5/4/2012	CHECKED - LAS	REVISED -


STATE OF ILLINOIS
DEPARTMENT OF TRANSPORTATION

SOLDIER PILE LAYOUT 1
STA. 4017+22.00 TO STA. 4023+28.14 SN 022-W052

SHEET NO. SE-3 OF SE-14 SHEETS


F.A.P. RTE. 338	SECTION 2011-036-1	COUNTY DUPAGE	TOTAL SHEETS 234	SHEET NO. 113
CONTRACT NO. 60P42				
ILLINOIS FED. AID PROJECT				

FILE NAME = ...G0P42-W052-003-F1.eia.dgn

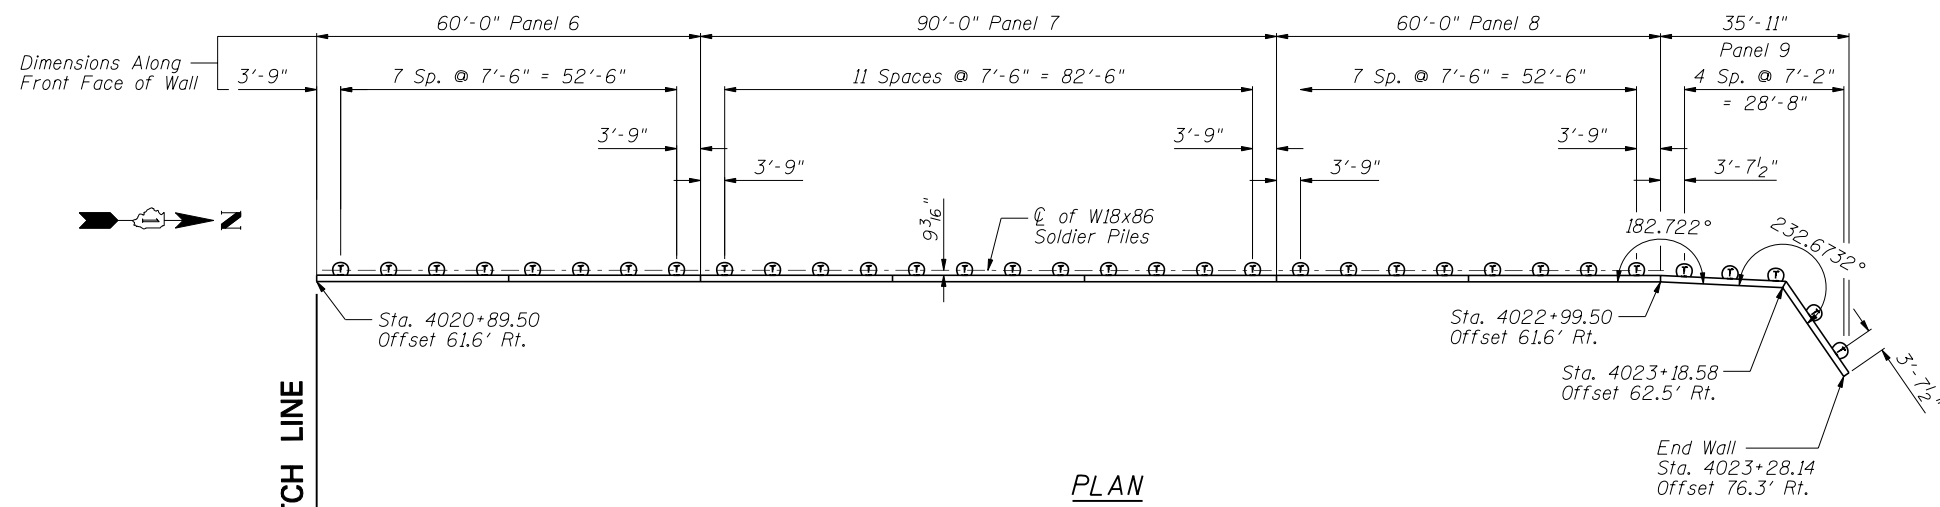

MATCH LINE

PLAN

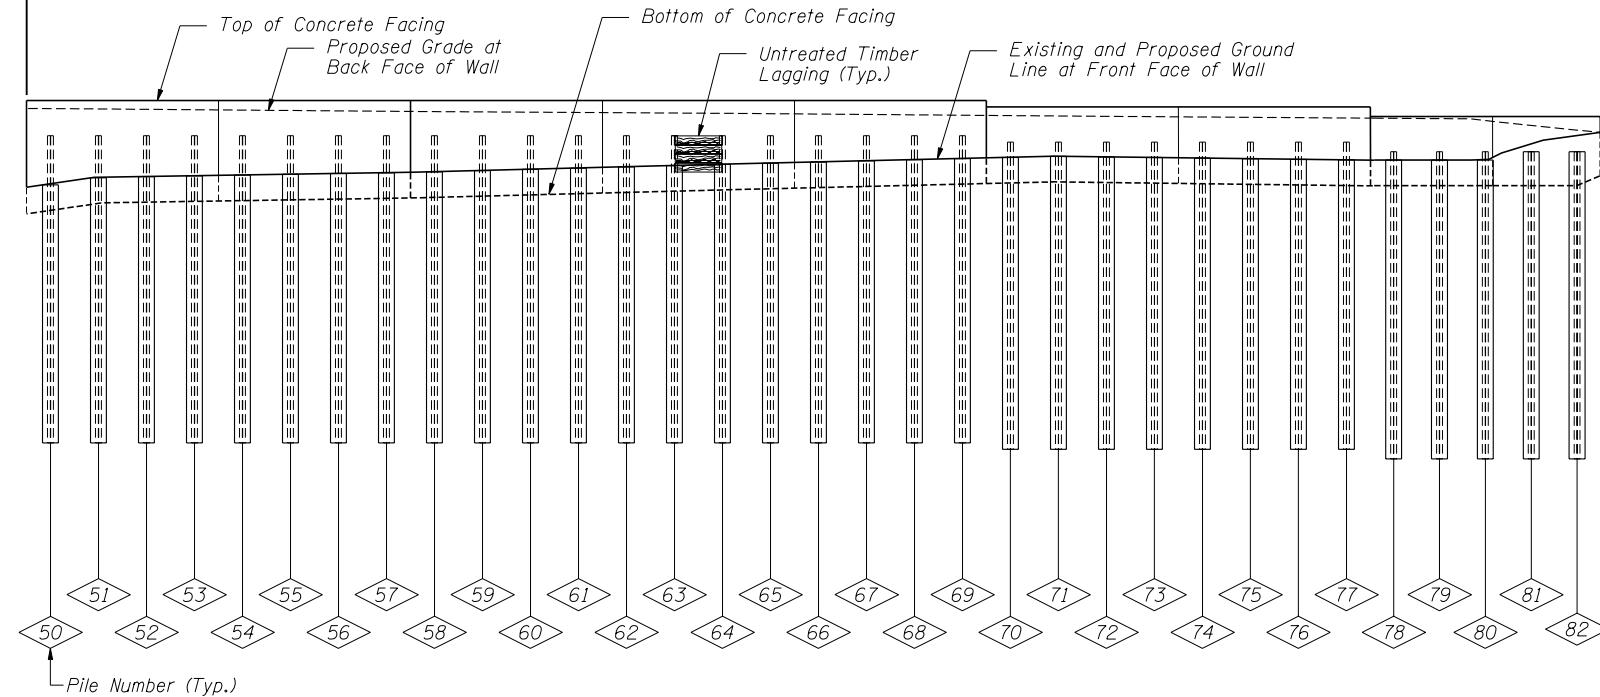

DEVELOPED ELEVATION

PILE SUMMARY

Pile No.	Station	Offset to C/Pile	Pile Designation	Length	Bottom Elevation	Top Elevation	Pile No.	Station	Offset to C/Pile	Pile Designation	Length	Bottom Elevation	Top Elevation	Pile No.	Station	Offset to C/Pile	Pile Designation	Length	Bottom Elevation	Top Elevation
50	4020+93.25	59.82	W18x86	24'-0"	685.75	709.75	61	4021+75.75	59.82	W18x86	24'-0"	685.75	709.75	72	4022+58.25	59.82	W18x86	24'-0"	685.25	709.25
51	4021+00.75	59.82	W18x86	24'-0"	685.75	709.75	62	4021+83.25	59.82	W18x86	24'-0"	685.75	709.75	73	4022+65.75	59.82	W18x86	24'-0"	685.25	709.25
52	4021+08.25	59.82	W18x86	24'-0"	685.75	709.75	63	4021+90.75	59.82	W18x86	24'-0"	685.75	709.75	74	4022+73.25	59.82	W18x86	24'-0"	685.25	709.25
53	4021+15.75	59.82	W18x86	24'-0"	685.75	709.75	64	4021+98.25	59.82	W18x86	24'-0"	685.75	709.75	75	4022+80.75	59.82	W18x86	24'-0"	685.25	709.25
54	4021+23.25	59.82	W18x86	24'-0"	685.75	709.75	65	4022+05.75	59.82	W18x86	24'-0"	685.75	709.75	76	4022+88.25	59.82	W18x86	24'-0"	685.25	709.25
55	4021+30.75	59.82	W18x86	24'-0"	685.75	709.75	66	4022+13.25	59.82	W18x86	24'-0"	685.75	709.75	77	4022+95.75	59.82	W18x86	24'-0"	685.25	709.25
56	4021+38.25	59.82	W18x86	24'-0"	685.75	709.75	67	4022+20.75	59.82	W18x86	24'-0"	685.75	709.75	78	4023+03.20	59.99	W18x86	24'-0"	684.50	708.50
57	4021+45.75	59.82	W18x86	24'-0"	685.75	709.75	68	4022+28.25	59.82	W18x86	24'-0"	685.75	709.75	79	4023+10.36	60.33	W18x86	24'-0"	684.50	708.50
58	4021+53.25	59.82	W18x86	24'-0"	685.75	709.75	69	4022+35.75	59.82	W18x86	24'-0"	685.75	709.75	80	4023+17.52	60.67	W18x86	24'-0"	684.50	708.50
59	4021+60.75	59.82	W18x86	24'-0"	685.75	709.75	70	4022+43.25	59.82	W18x86	24'-0"	685.25	709.25	81	4023+23.46	66.44	W18x86	24'-0"	684.50	708.50
60	4021+68.25	59.82	W18x86	24'-0"	685.75	709.75	71	4022+50.75	59.82	W18x86	24'-0"	685.25	709.25	82	4023+27.53	72.34	W18x86	24'-0"	684.50	708.50

BILL OF MATERIAL

Item	Unit	Quantity
Furnishing Soldier Piles (W Section)	Foot	2,155
Drilling and Setting Soldier Piles (In Soil)	Cu Ft	12,205
Untreated Timber Lagging	Sq Ft	3,221
Stud Shear Connectors	Each	507

Note: All offsets are to the right of C IL Rte. 59

**SOLDIER PILE LAYOUT 2
SN 022-W052**

FILE NAME = ...EGP42-WB52-084-F1.epl.ppt.dgn




USER NAME = SAW	DESIGNED - LAS	REVISED -
	CHECKED - DAZ	REVISED -
PLOT SCALE = 38.00' / IN.	DRAWN - SAW	REVISED -
PLOT DATE = 5/4/2012	CHECKED - LAS	REVISED -

**STATE OF ILLINOIS
DEPARTMENT OF TRANSPORTATION**

**SOLDIER PILE LAYOUT 2
STA. 4017 + 22.00 TO STA. 4023 + 28.14 SN 022-W052**

SHEET NO. SE-4 OF SE-14 SHEETS

F.A.P. RTE. 338	SECTION 2011-036-1	COUNTY DUPAGE	TOTAL SHEETS 234	SHEET NO. 114
CONTRACT NO. 60P42				
ILLINOIS FED. AID PROJECT				

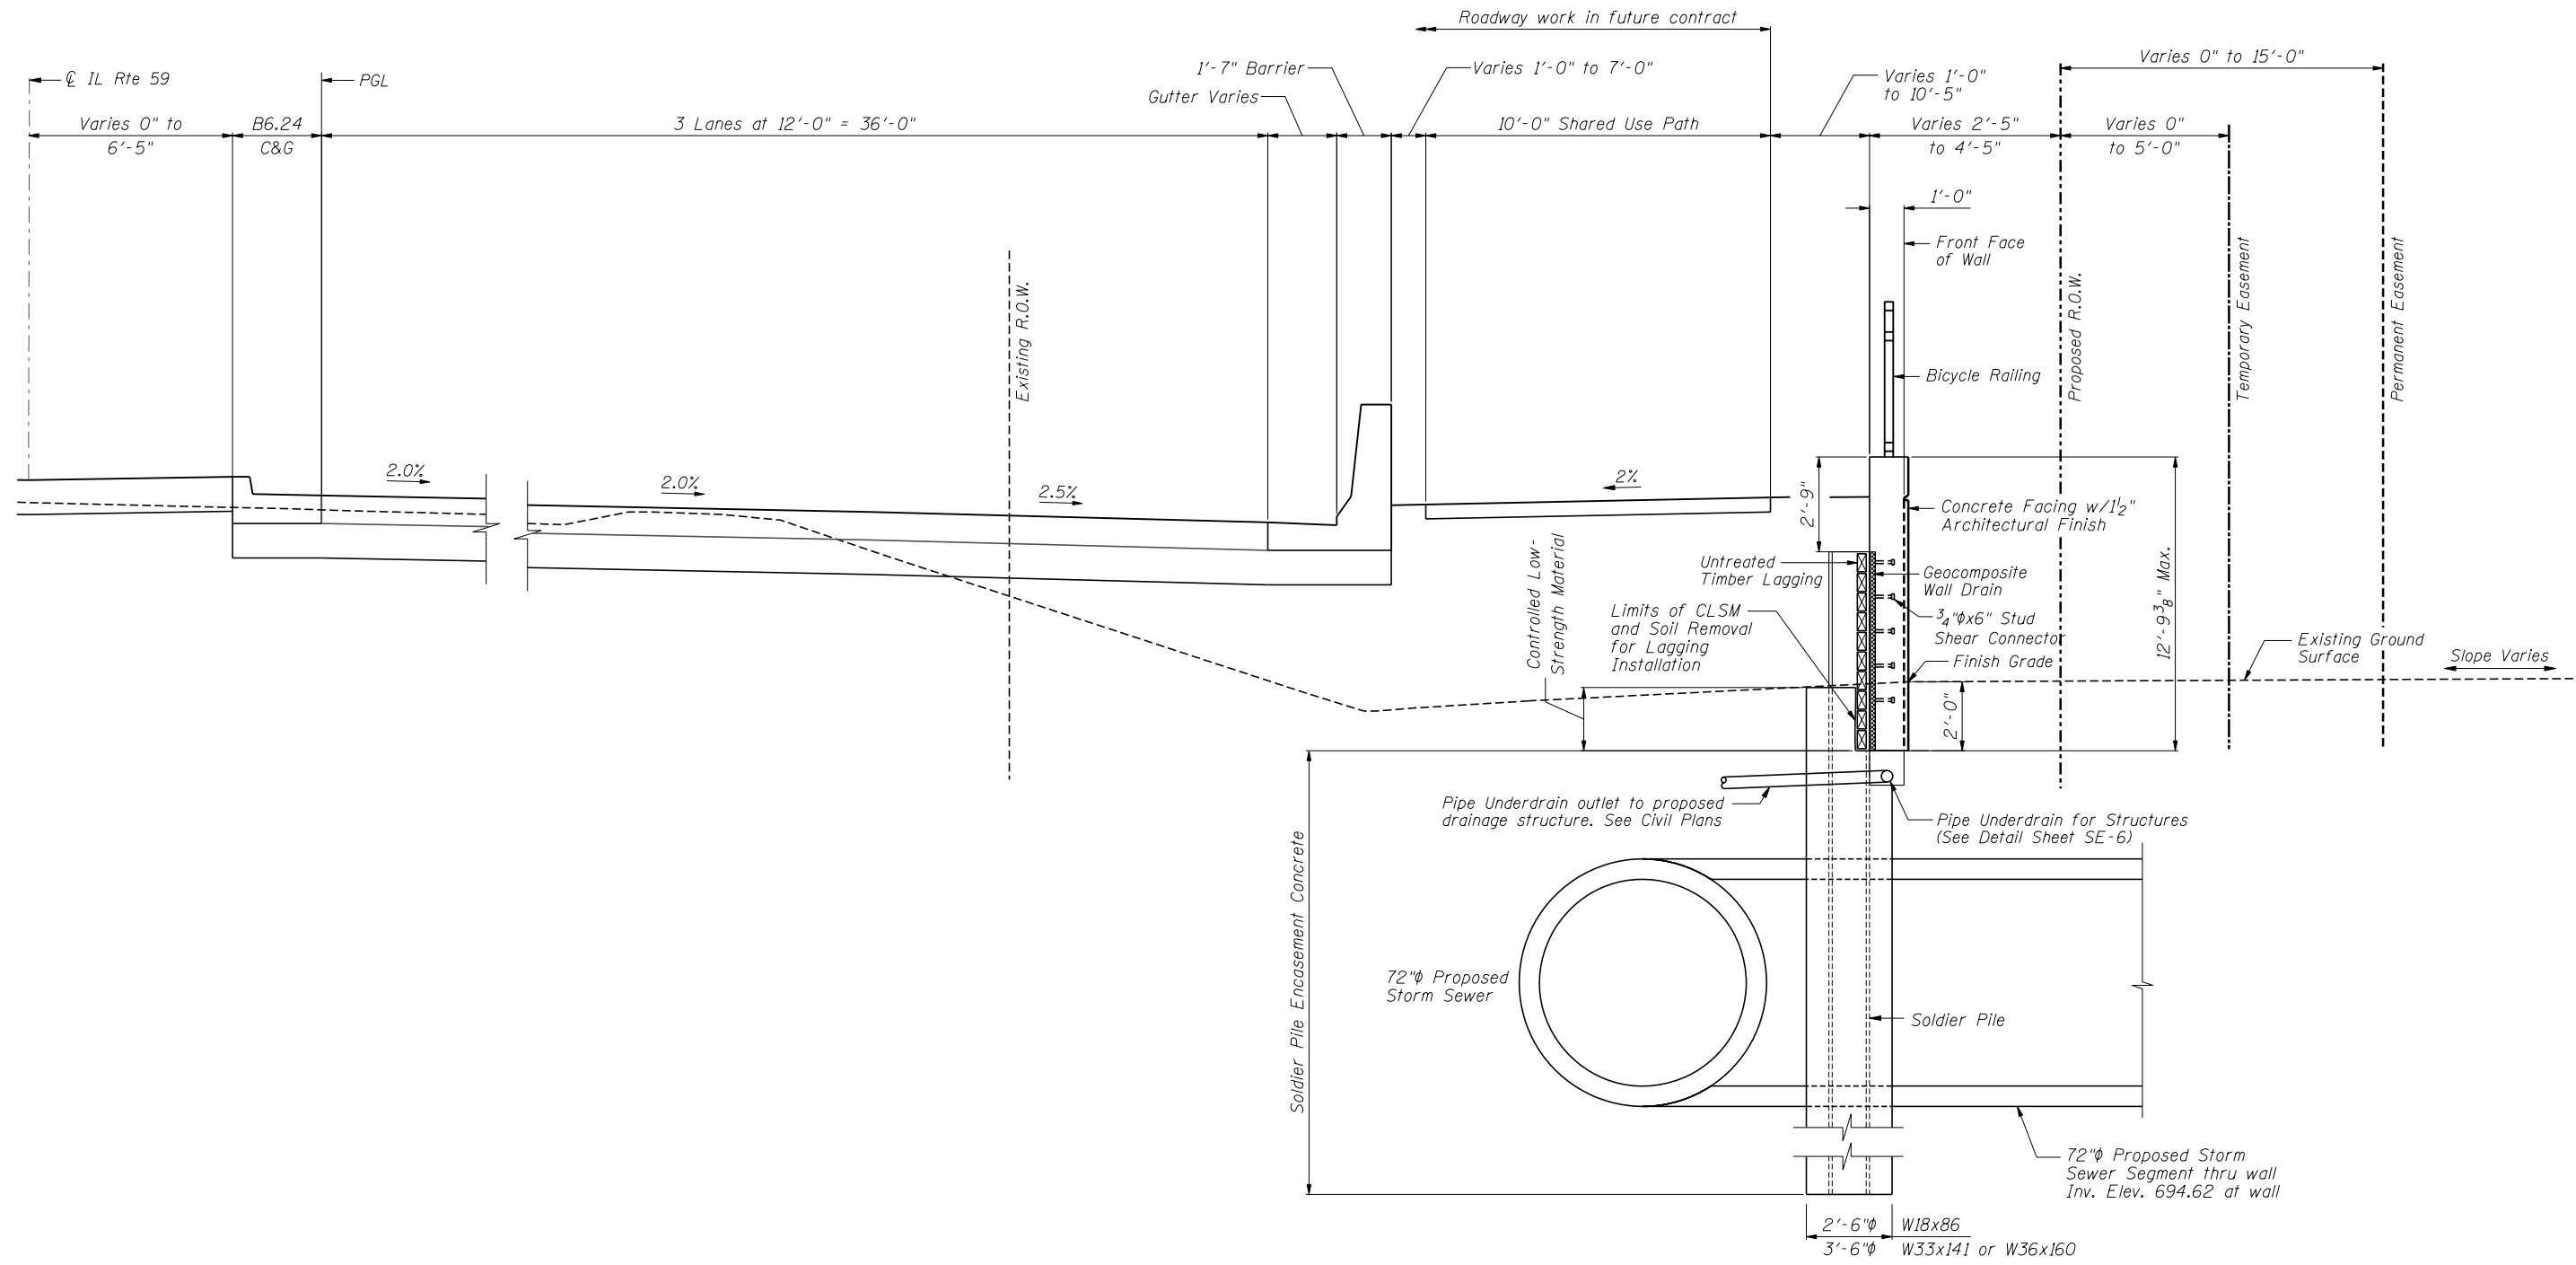


TYPICAL WALL SECTION
 Sta. 4017+22.00 to Sta. 4023+28.14
 (Looking North)

TYPICAL SECTION
 SN 022-W052


FILE NAME = ...EGP42-W052-005-TopSec.dgn

USER NAME = SAW	DESIGNED - LAS	REVISED -
PLOT SCALE = 5.00' / IN.	CHECKED - DAZ	REVISED -
PLOT DATE = 5/4/2012	DRAWN - SAW	REVISED -
	CHECKED - LAS	REVISED -

F.A.P. RTE.	SECTION	COUNTY	TOTAL SHEETS	SHEET NO.
338	2011-036-1	DUPAGE	234	115
CONTRACT NO. 60P42				

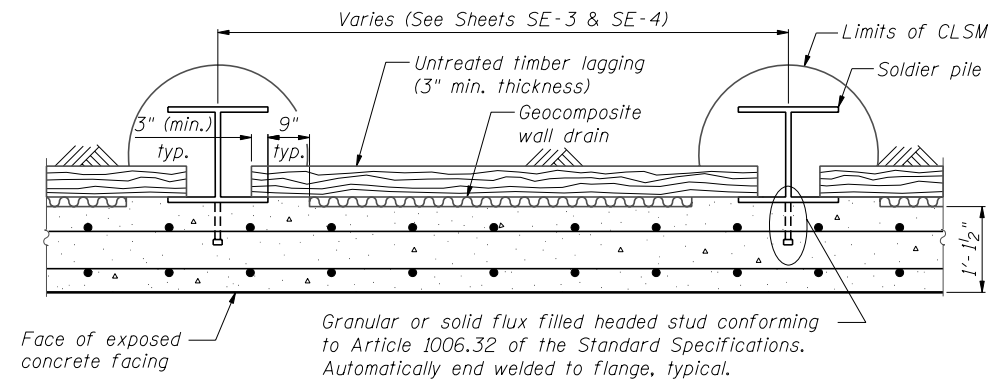

SECTION THRU DRILLED SOLDIER PILE WALL

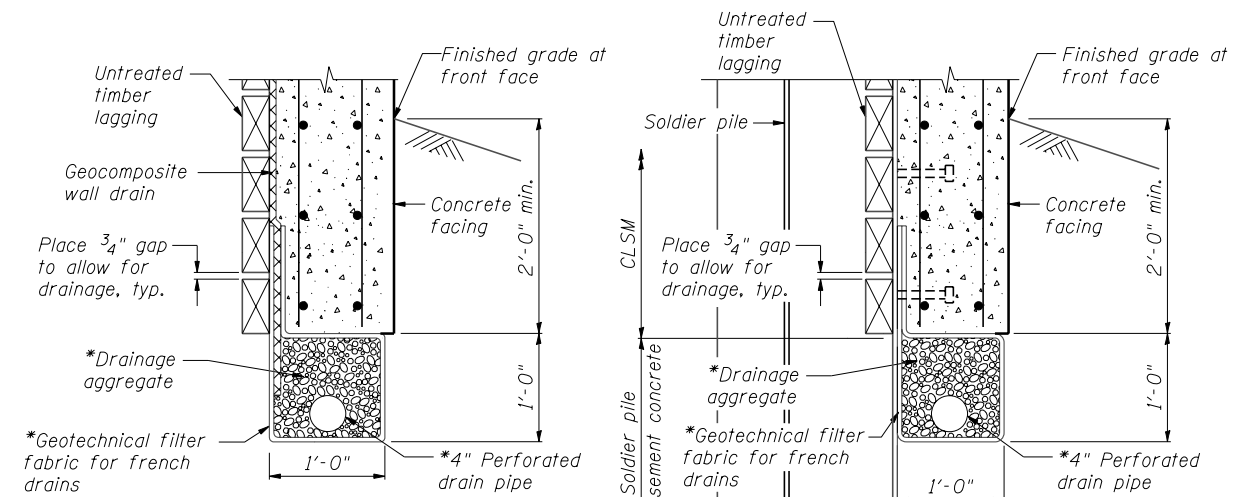


BETWEEN SOLDIER PILES

AT SOLDIER PILES


PIPE UNDERDRAIN DETAIL

*Included in the cost of "Pipe Underdrains for Structures, 4"


For pipe underdrain outlets, see Civil Plans.

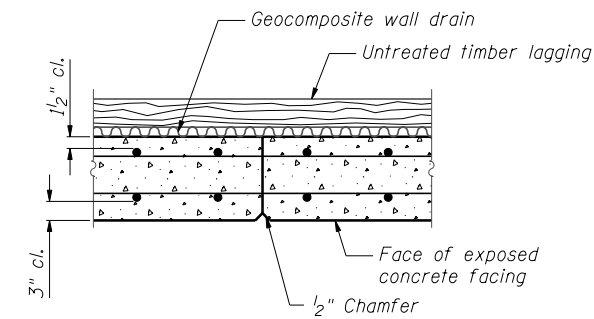

CONSTRUCTION JOINT DETAIL

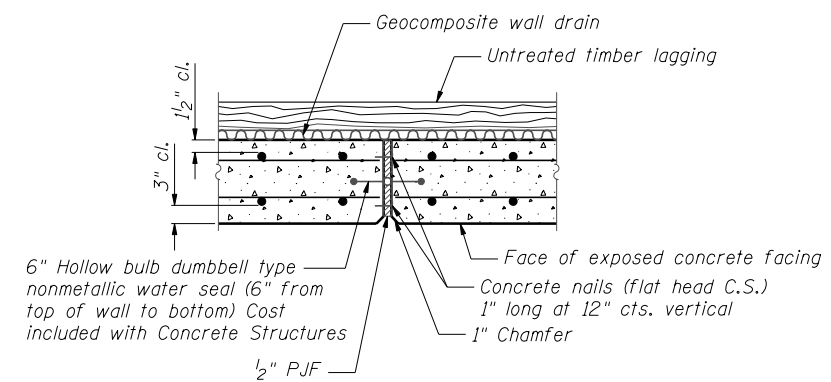

EXPANSION JOINT DETAIL

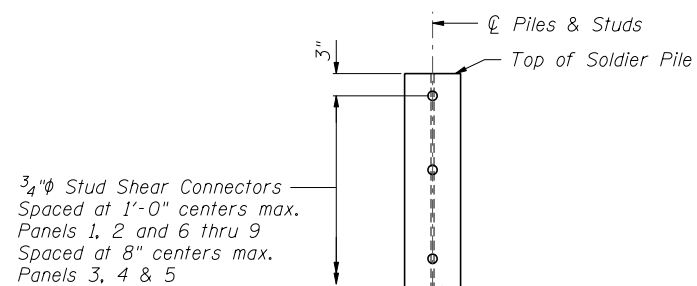

DETAIL OF SHEAR STUD PLACEMENT

3/4" ϕ Stud Shear Connectors
Spaced at 1'-0" centers max.
Panels 1, 2 and 6 thru 9
Spaced at 8" centers max.
Panels 3, 4 & 5

DETAILS
SN 022-W052



Zroka Engineering, P.C.
4216 North Hermitage
Chicago, IL 60613

USER NAME = SAW	DESIGNED - LAS	REVISED -
	CHECKED - DAZ	REVISED -
PLOT SCALE = 5.00' / IN.	DRAWN - SAW	REVISED -
PLOT DATE = 5/4/2012	CHECKED - LAS	REVISED -

STATE OF ILLINOIS
DEPARTMENT OF TRANSPORTATION


DETAILS
STA. 4017+22.00 TO STA. 4023+28.14 SN 022-W052

SHEET NO. SE-6 OF SE-14 SHEETS


F.A.P. RTE.	SECTION	COUNTY	TOTAL SHEETS	SHEET NO.
338	2011-036-1	DUPAGE	234	116
CONTRACT NO. 60P42				

ILLINOIS FED. AID PROJECT

FILE NAME = ...EGP42-W052-006-Details.dgn

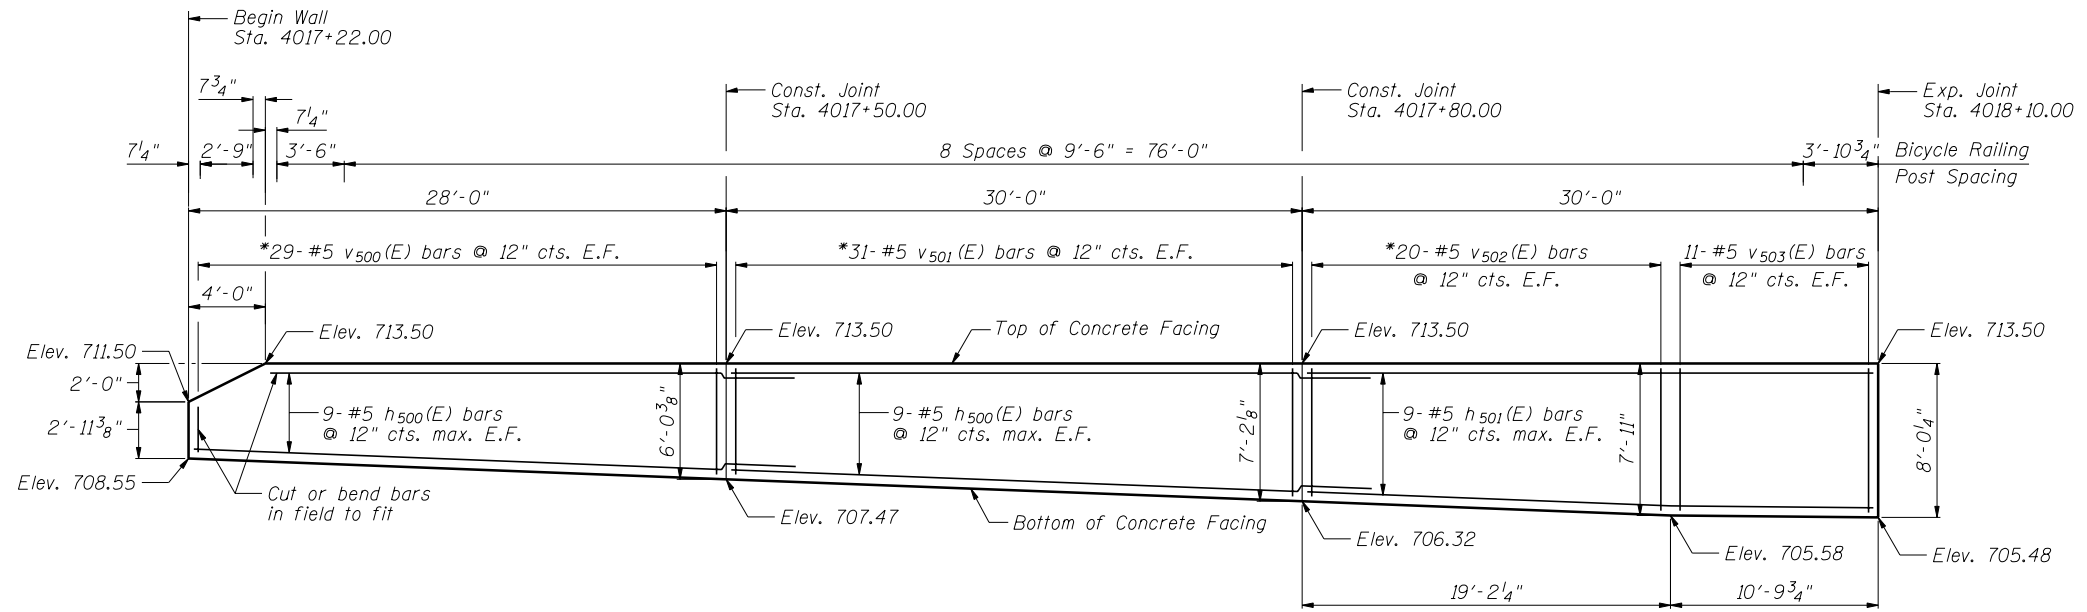

ELEVATION

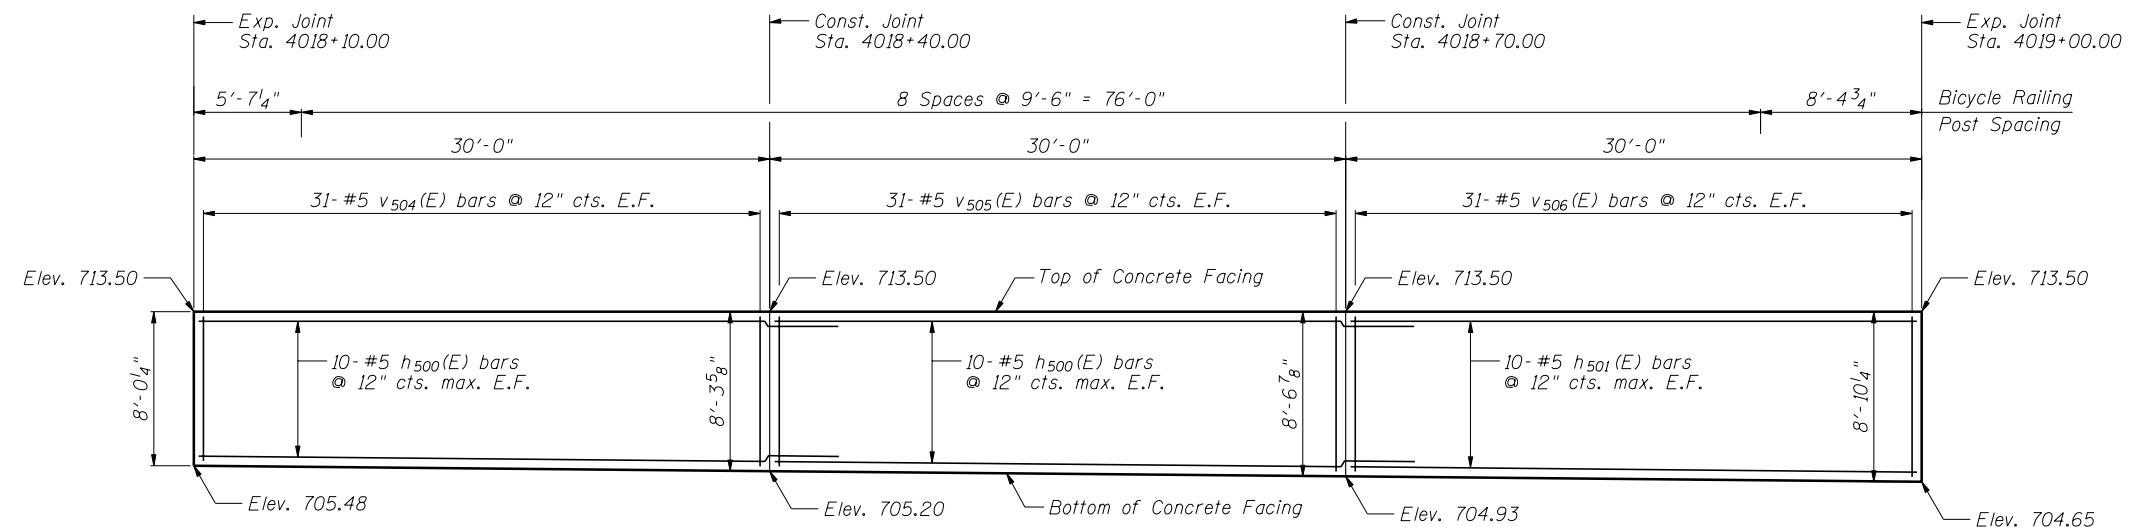

ELEVATION

Notes:

Minimum lap for #5 bar is 3'-8".

Space reinforcement in wall to miss shear studs.

* signifies cut bar. Order per length on Bill of Material. Cut as shown in Cutting Diagram and use half of bars in each face.

See Sheet SE-10 for Concrete Facing Details and Bill of Material.

CONCRETE FACING 1
SN 022-W052



Zroka Engineering, P.C.
4216 North Hermitage
Chicago, IL 60613

USER NAME = SAW	DESIGNED - LAS	REVISED -
	CHECKED - DAZ	REVISED -
PLOT SCALE = 10.0000' / IN.	DRAWN - SAW	REVISED -
PLOT DATE = 5/4/2012	CHECKED - LAS	REVISED -

STATE OF ILLINOIS
DEPARTMENT OF TRANSPORTATION

CONCRETE FACING 1
STA. 4017 + 22.00 TO STA. 4023 + 28.14 SN 022-W052

SHEET NO. SE-7 OF SE-14 SHEETS

F.A.P. RTE.	SECTION	COUNTY	TOTAL SHEETS	SHEET NO.
338	2011-036-1		234	117
CONTRACT NO. 60P42			ILLINOIS FED. AID PROJECT	

FILE NAME = ...60P42-W052-007-ConcreteFacing.dgn



Notes:

Minimum lap for #5 bar is 3'-8". Minimum lap for #6 bar is 4'-5".


Space reinforcement in wall to miss shear studs.

* signifies cut bar. Order per length on Bill of Material. Cut as shown in Cutting Diagram and use half of bars in each face.

See Sheet SE-10 for Concrete Facing Details and Bill of Material.

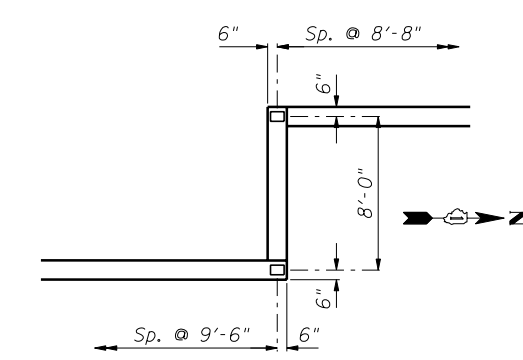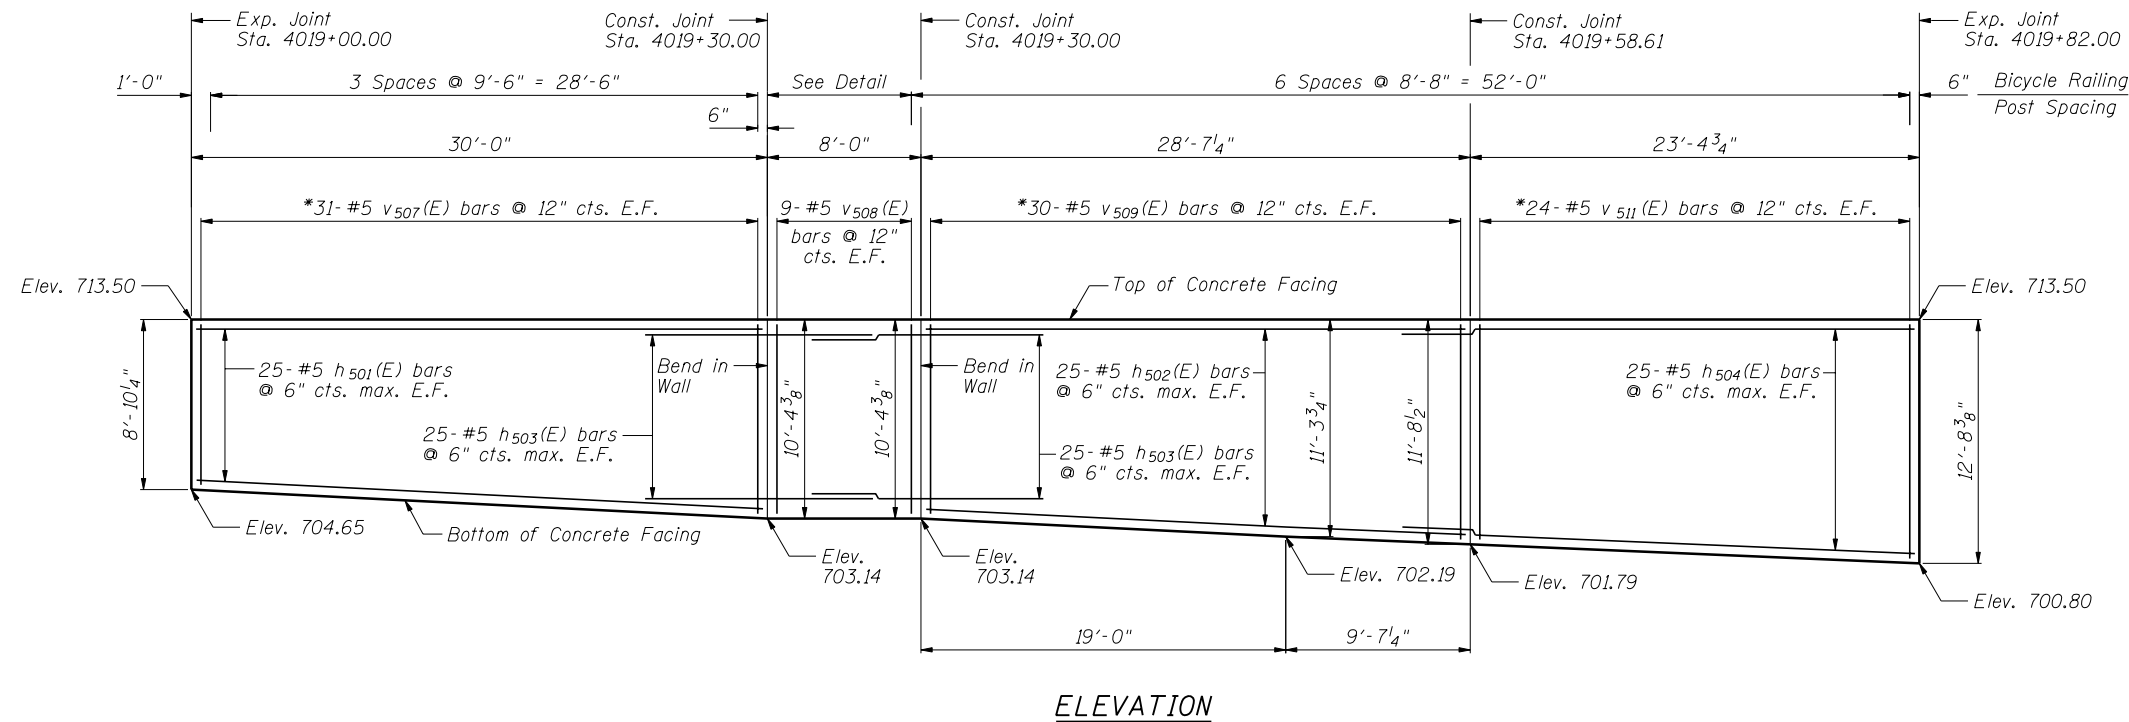

POST SPACING @
CORNER DETAIL

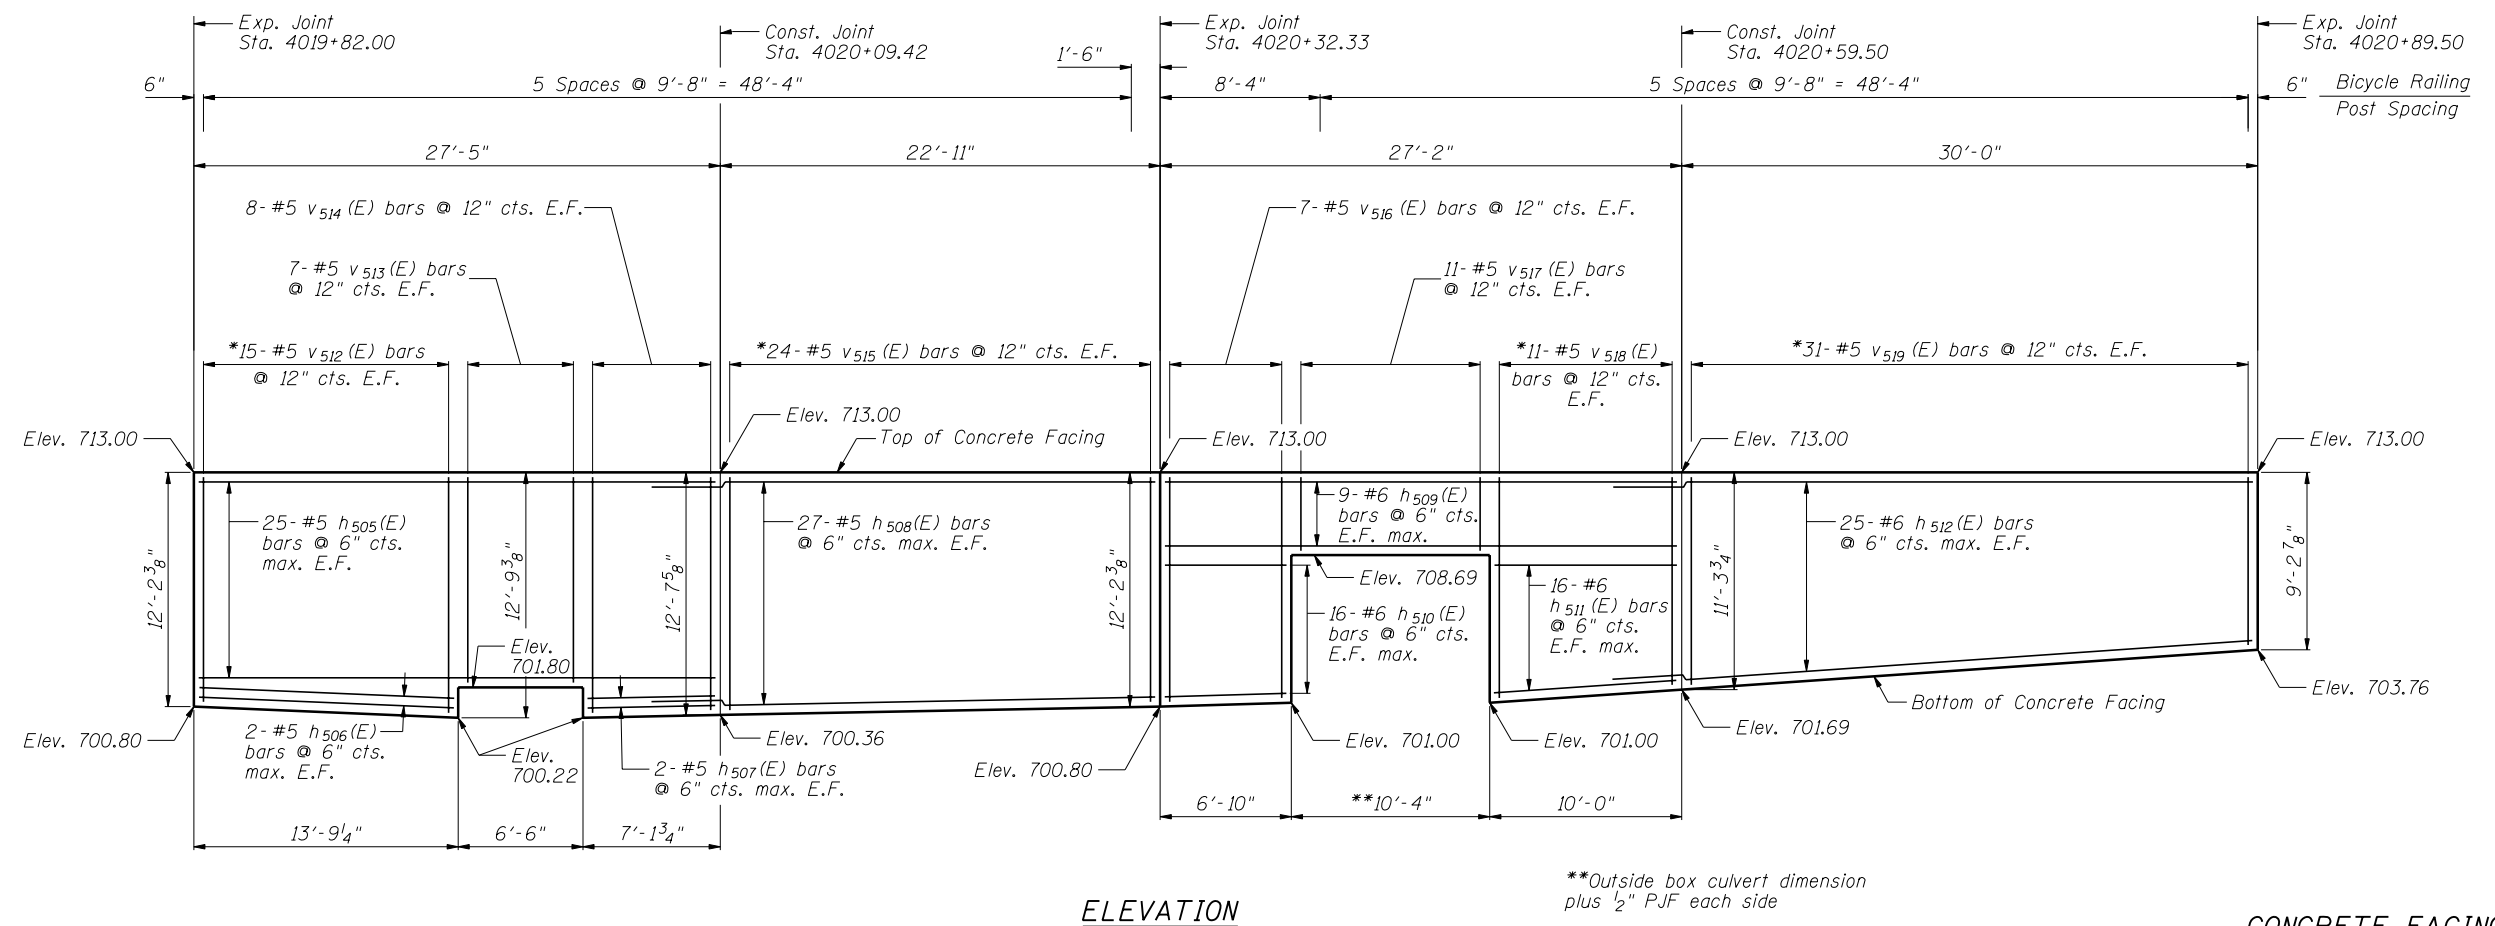

ELEVATION

CONCRETE FACING 2
SN 022-W052

FILE NAME = ...EGP42-W052-008-ConcreteFacing2.dgn



USER NAME = SAW	DESIGNED - LAS	REVISED -
	CHECKED - DAZ	REVISED -
PLOT SCALE = 10.0000' / IN.	DRAWN - SAW	REVISED -
PLOT DATE = 5/4/2012	CHECKED - LAS	REVISED -


STATE OF ILLINOIS
DEPARTMENT OF TRANSPORTATION

CONCRETE FACING 2
STA. 4017+22.00 TO STA. 4023+28.14 SN 022-W052


SHEET NO. SE-8 OF SE-14 SHEETS

F.A.P. RTE.	SECTION	COUNTY	TOTAL SHEETS	SHEET NO.
338	2011-036-1	DUPAGE	234	118
CONTRACT NO. 60P42				

ILLINOIS FED. AID PROJECT

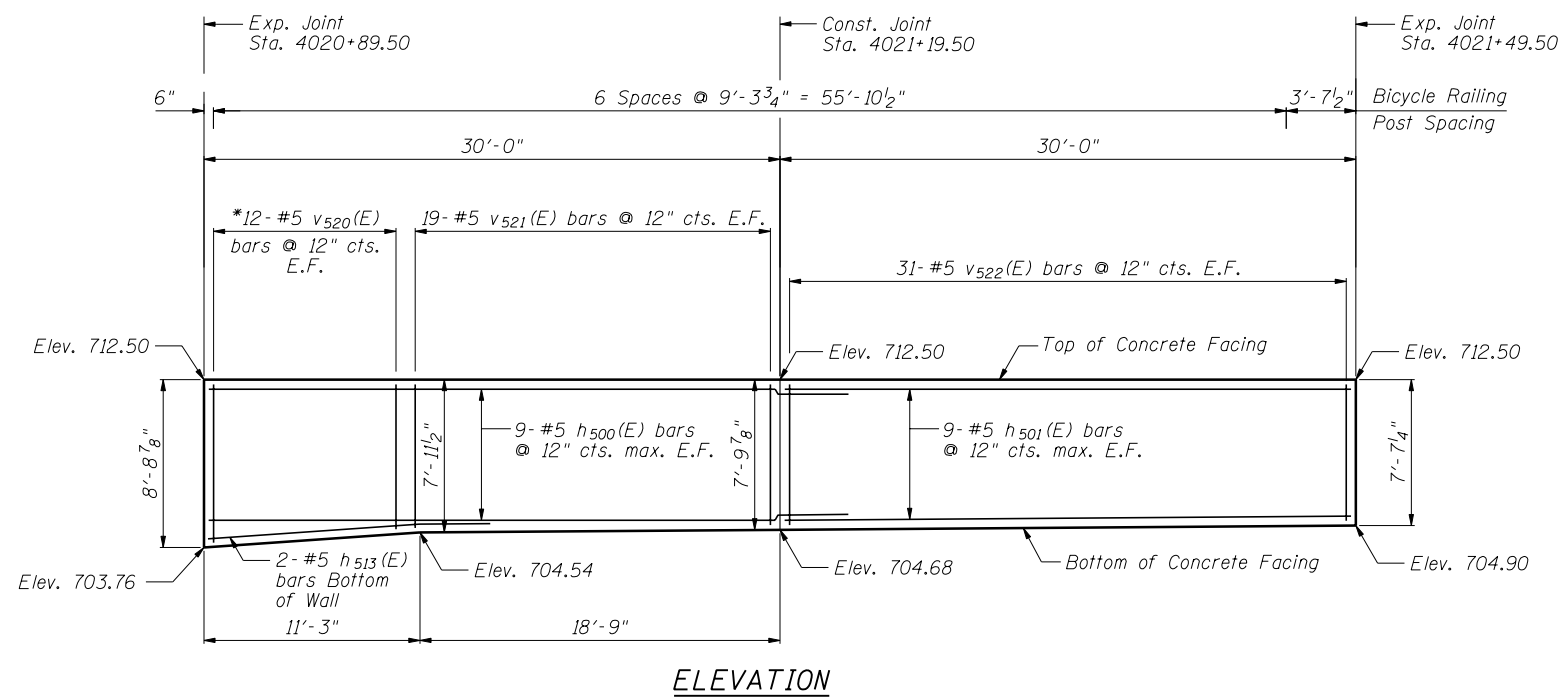

ELEVATION

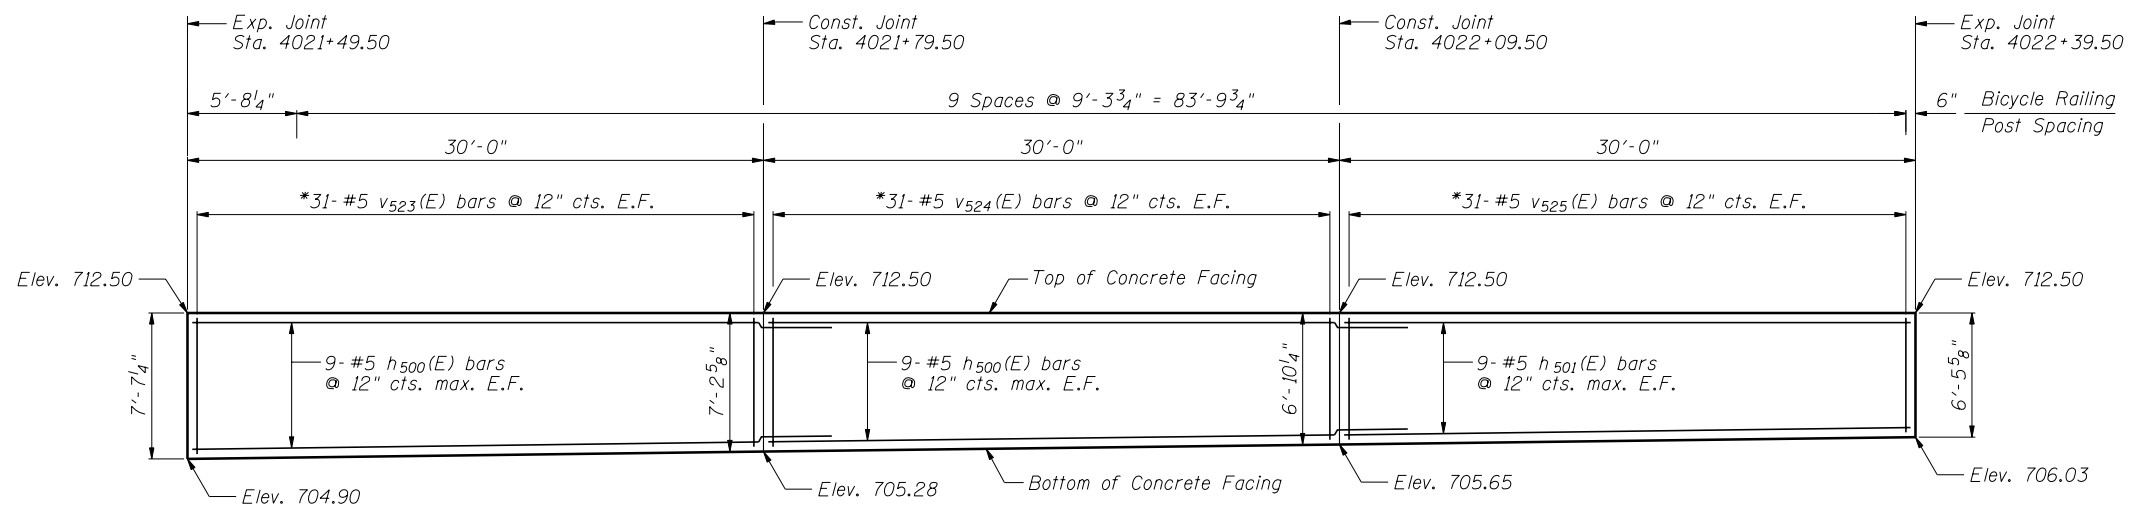

ELEVATION

Notes:
 Minimum lap for #5 bar is 3'-8".
 Space reinforcement in wall to miss shear studs.
 * signifies cut bar. Order per length on Bill of Material. Cut as shown in Cutting Diagram and use half of bars in each face.
 See Sheet SE-10 for Concrete Facing Details and Bill of Material.

CONCRETE FACING 3
 SN 022-W052

FILE NAME = ...60P42-W052-009-ConcreteFacing3.dgn




USER NAME = SAW	DESIGNED - LAS	REVISED -
	CHECKED - DAZ	REVISED -
PLOT SCALE = 10.0000' / IN.	DRAWN - SAW	REVISED -
PLOT DATE = 5/4/2012	CHECKED - LAS	REVISED -


STATE OF ILLINOIS
 DEPARTMENT OF TRANSPORTATION

CONCRETE FACING 3
 STA. 4017 + 22.00 TO STA. 4023 + 28.14 SN 022-W052
 SHEET NO. SE-9 OF SE-14 SHEETS


F.A.P. RTE.	SECTION	COUNTY	TOTAL SHEETS	SHEET NO.
338	2011-036-1		234	119
CONTRACT NO. 60P42				
ILLINOIS FED. AID PROJECT				

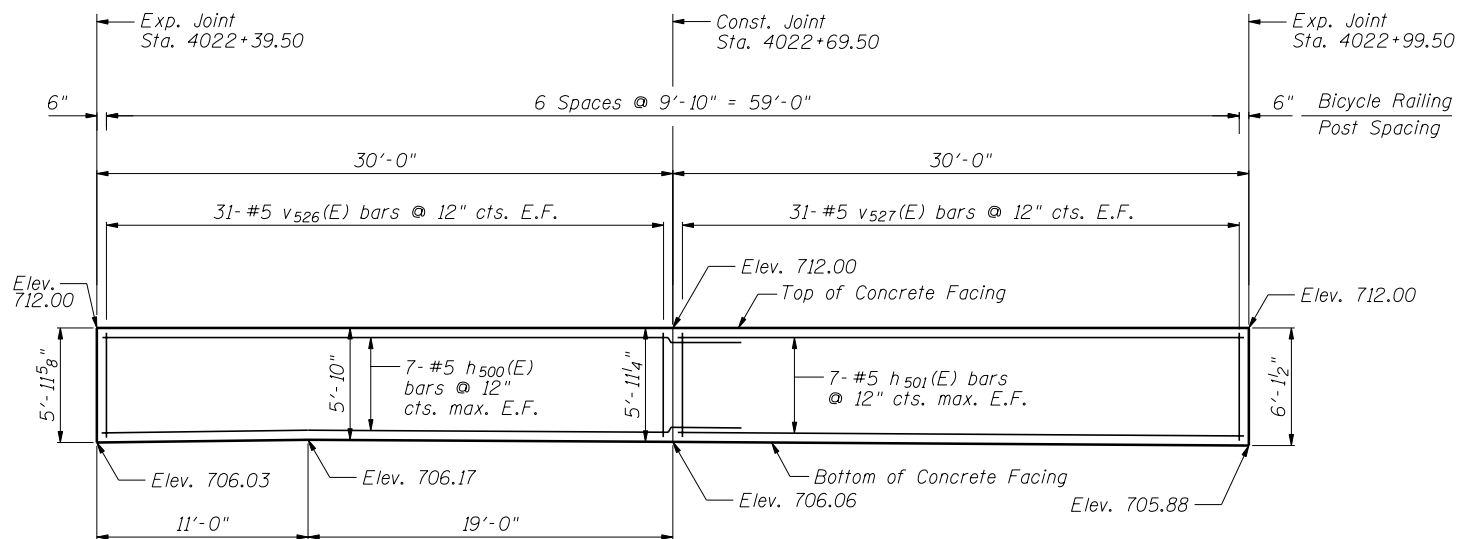


ELEVATION

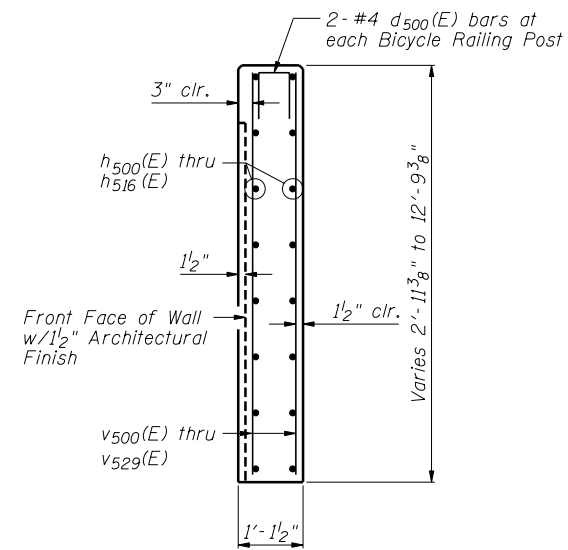

SECTION THRU CONCRETE FACING

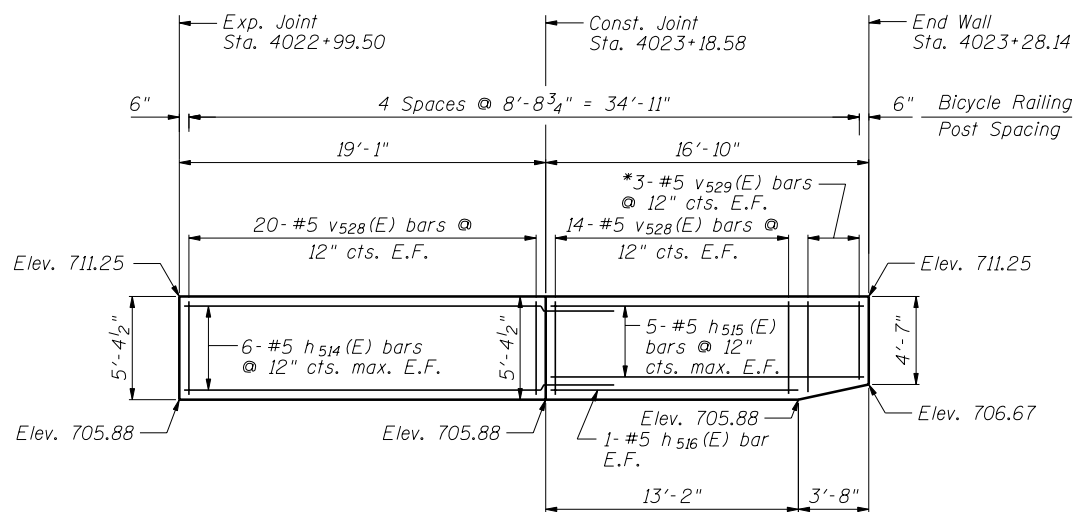

ELEVATION

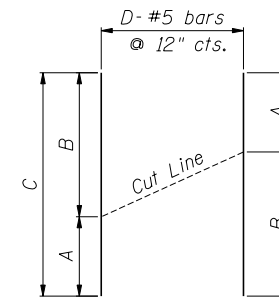


CUTTING DIAGRAM

Bar	A	B	C	D
v500(E)	4'-6"	5'-8"	10'-2"	29
v501(E)	5'-8"	6'-10"	12'-6"	31
v502(E)	6'-10"	7'-7"	14'-5"	20
v507(E)	8'-6"	10'-0"	18'-6"	31
v509(E)	10'-0"	11'-4"	21'-4"	30
v511(E)	11'-4"	12'-4"	23'-8"	24
v512(E)	11'-10"	12'-5"	24'-3"	15
v515(E)	12'-3"	11'-10"	24'-1"	24
v518(E)	11'-8"	11'-0"	22'-8"	11
v519(E)	11'-0"	8'-11"	19'-11"	31
v520(E)	8'-5"	7'-8"	16'-1"	12
v523(E)	7'-3"	6'-10"	14'-1"	31
v524(E)	6'-10"	6'-6"	13'-4"	31
v525(E)	6'-6"	6'-1"	12'-7"	31
v529(E)	5'-1"	4'-3"	9'-4"	3

BILL OF MATERIAL

Bar	No.	Size	Length	Shape
d500(E)	140	#4	2'-0"	□
h500(E)	144	#5	33'-8"	—
h501(E)	138	#5	29'-8"	—
h502(E)	50	#5	28'-3"	—
h503(E)	100	#5	10'-0"	└
h504(E)	50	#5	27'-0"	—
h505(E)	50	#5	27'-1"	—
h506(E)	4	#5	13'-5"	—
h507(E)	4	#5	6'-10"	—
h508(E)	54	#5	26'-7"	—
h509(E)	18	#6	26'-10"	—
h510(E)	32	#6	6'-6"	—
h511(E)	32	#6	9'-8"	—
h512(E)	50	#6	34'-5"	—
h513(E)	2	#5	14'-9"	—
h514(E)	12	#5	22'-9"	—
h515(E)	10	#5	16'-6"	—
h516(E)	2	#5	12'-10"	—
v500(E)	29	#5	10'-2"	—
v501(E)	31	#5	12'-6"	—
v502(E)	20	#5	14'-5"	—
v503(E)	22	#5	7'-7"	—
v504(E)	62	#5	7'-9"	—
v505(E)	62	#5	8'-0"	—
v506(E)	62	#5	8'-4"	—
v507(E)	31	#5	18'-6"	—
v508(E)	18	#5	10'-0"	—
v509(E)	30	#5	21'-4"	—
v511(E)	24	#5	23'-8"	—
v512(E)	15	#5	24'-3"	—
v513(E)	14	#5	10'-11"	—
v514(E)	16	#5	12'-4"	—
v515(E)	24	#5	24'-1"	—
v516(E)	14	#5	11'-9"	—
v517(E)	22	#5	4'-0"	—
v518(E)	11	#5	22'-8"	—
v519(E)	31	#5	19'-11"	—
v520(E)	12	#5	16'-1"	—
v521(E)	38	#5	7'-6"	—
v522(E)	62	#5	7'-4"	—
v523(E)	31	#5	14'-1"	—
v524(E)	31	#5	13'-4"	—
v525(E)	31	#5	12'-7"	—
v526(E)	62	#5	5'-6"	—
v527(E)	62	#5	5'-8"	—
v528(E)	68	#5	5'-1"	—
v529(E)	3	#5	9'-4"	—
Item	Unit	Quantity		
Concrete Structures	Cu. Yd.	214.1		
Reinforcement Bars, Epoxy Coated	Pound	31,720		
Pipe Underdrains for Structures, 4"	Foot	645		
Geocomposite Wall Drain	Sq. Yd.	282		

Notes:
 Minimum lap for #5 bar is 3'-8".
 Space reinforcement in wall to miss shear studs.
 * signifies cut bar. Order per length on Bill of Material. Cut as shown in Cutting Diagram and use half of bars in each face.

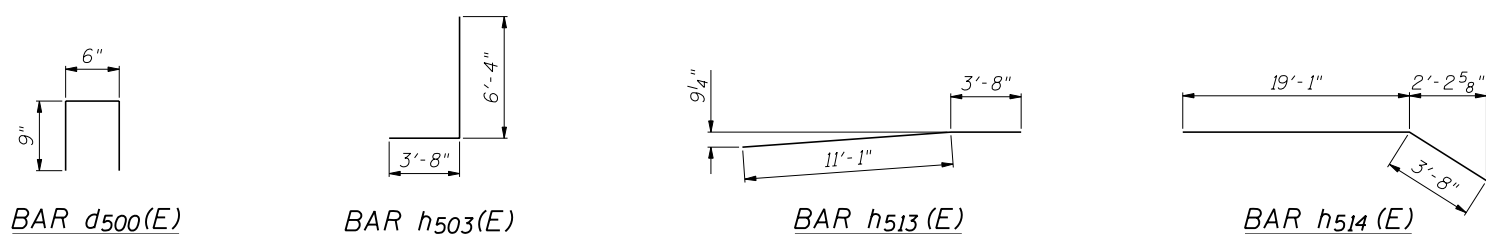

CONCRETE FACING & DETAILS
 SN 022-W052

FILE NAME = ...GP42-W052-010-ConcreteFacing.dgn






USER NAME = SAW	DESIGNED - LAS	REVISED -
	CHECKED - DAZ	REVISED -
PLOT SCALE = 10.0000' / IN.	DRAWN - SAW	REVISED -
PLOT DATE = 5/4/2012	CHECKED - LAS	REVISED -

STATE OF ILLINOIS
 DEPARTMENT OF TRANSPORTATION





CONCRETE FACING & DETAILS
 STA. 4017 +22.00 TO STA. 4023 +28.14 SN 022-W052

F.A.P. RTE.	SECTION	COUNTY	TOTAL SHEETS	SHEET NO.
338	2011-036-1	DUPAGE	234	120
				CONTRACT NO. 60P42
ILLINOIS FED. AID PROJECT				

SHEET NO. SE-10 OF SE-14 SHEETS

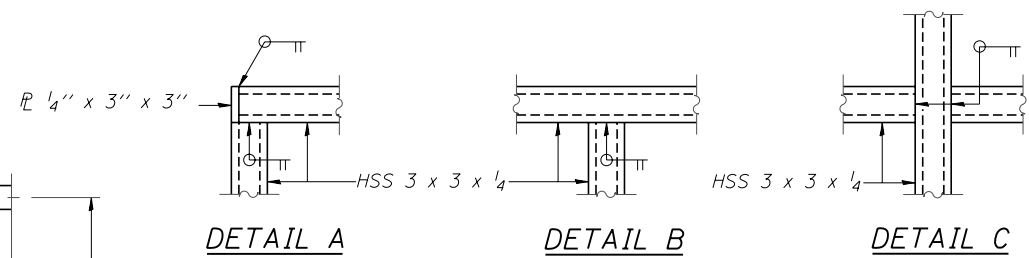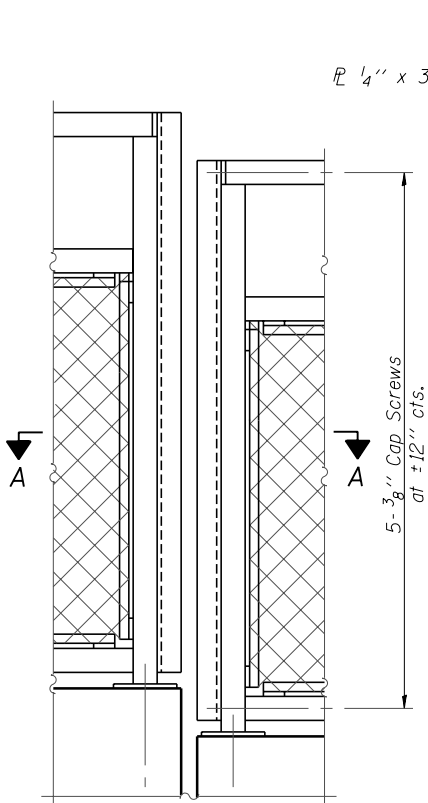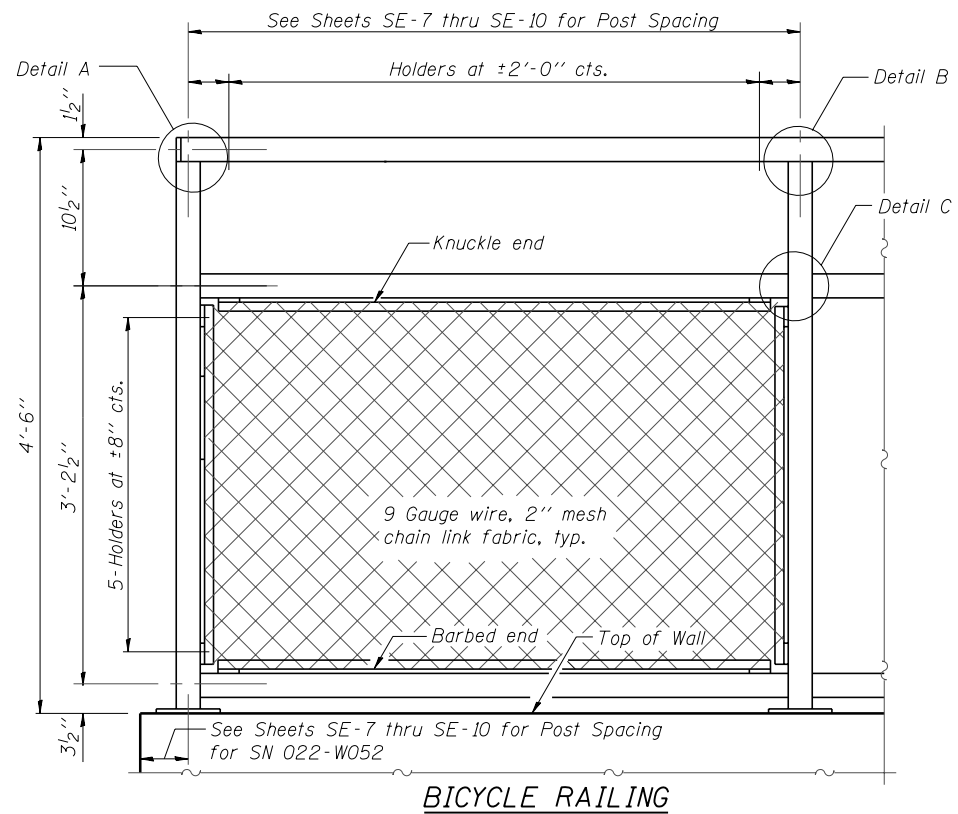

All steel rail elements shall be galvanized according to Article 509.05 of the Standard Specifications.

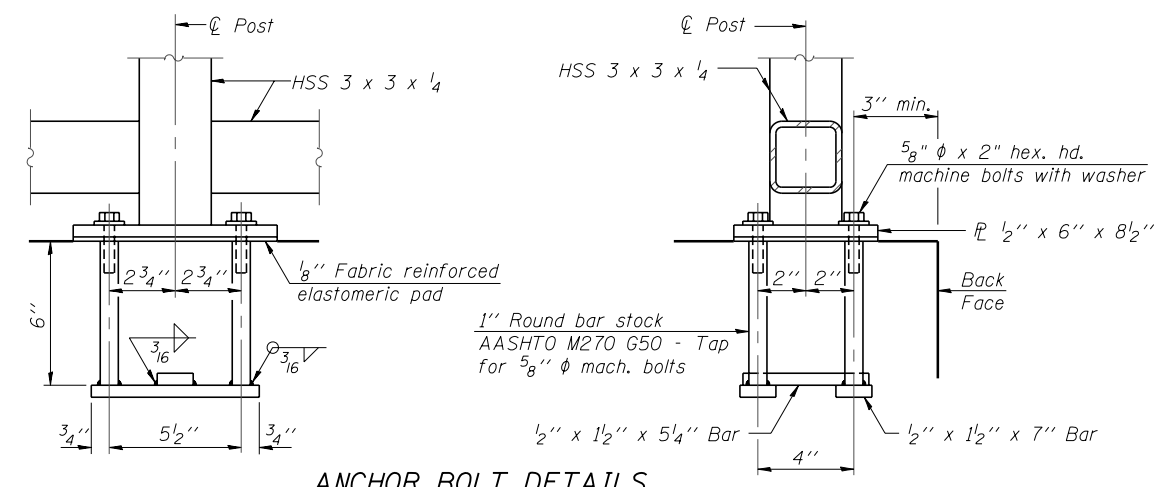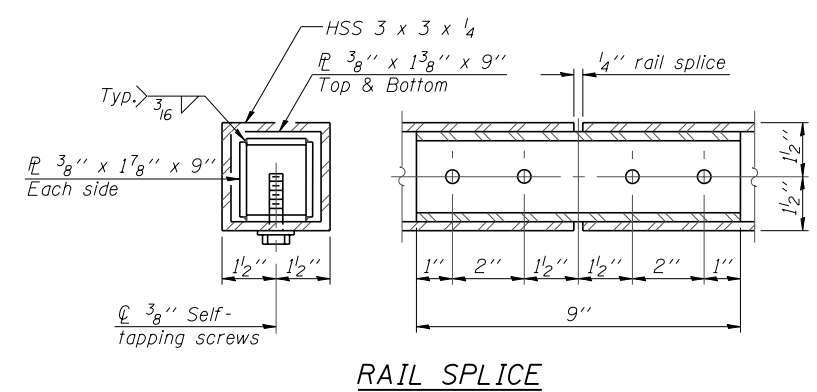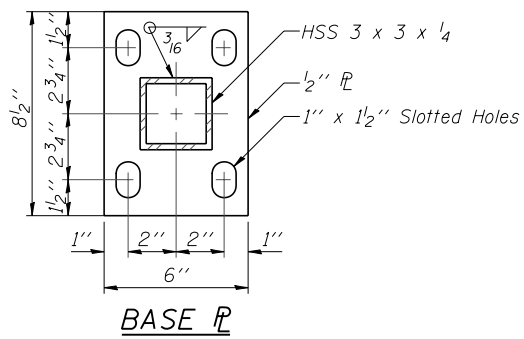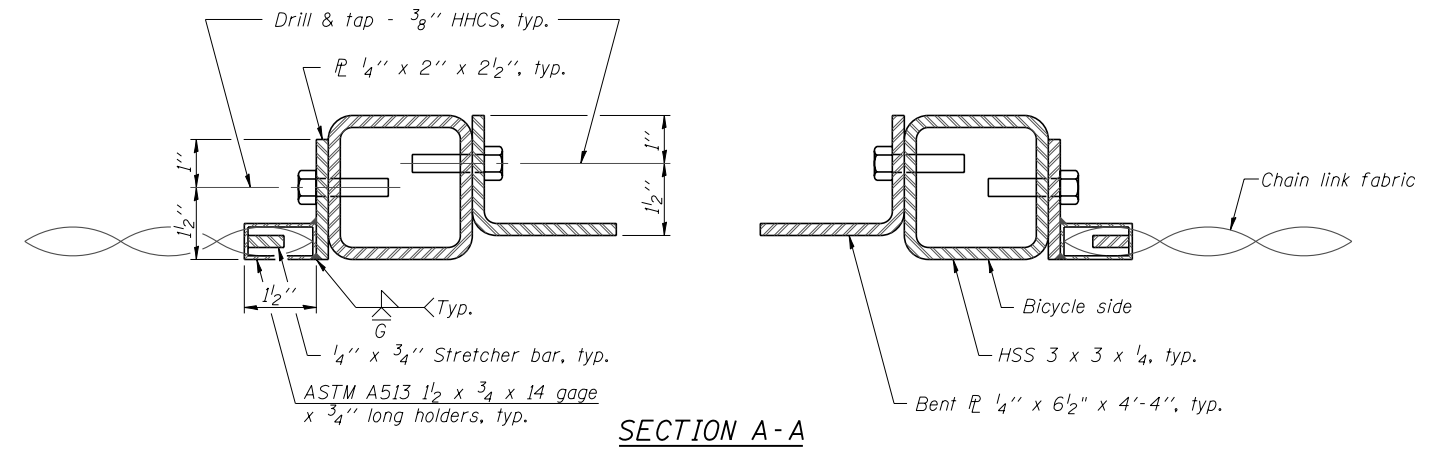

In lieu of the cast-in-place anchor device shown, the Contractor has the option of drilling and setting 5/8" φ anchor rods according to Article 509.06 of the Standard Specifications. Embedment shall be according to the manufacturer's specifications.

BILL OF MATERIAL

Item	Unit	Quantity
Bicycle Railing	Foot	622

BICYCLE RAILING SN 022-W052

FILE NAME = ...60P42-W052-011-BicycleRail.dgn

ZROKA engineering
 Zroka Engineering, P.C.
 4216 North Hermitage
 Chicago, IL 60613


USER NAME = SAW	DESIGNED - LAS	REVISED -
PLOT SCALE = 0.1667' / IN.	CHECKED - DAZ	REVISED -
PLOT DATE = 5/4/2012	DRAWN - SAW	REVISED -
	CHECKED - LAS	REVISED -

STATE OF ILLINOIS DEPARTMENT OF TRANSPORTATION


BICYCLE RAILING
STA. 4017+22.00 TO STA. 4023+28.14 SN 022-W052

SHEET NO. SE-11 OF SE-14 SHEETS


F.A.P. RTE.	SECTION	COUNTY	TOTAL SHEETS	SHEET NO.
338	2011-036-1	DUPAGE	234	121
				CONTRACT NO. 60P42
ILLINOIS FED. AID PROJECT				

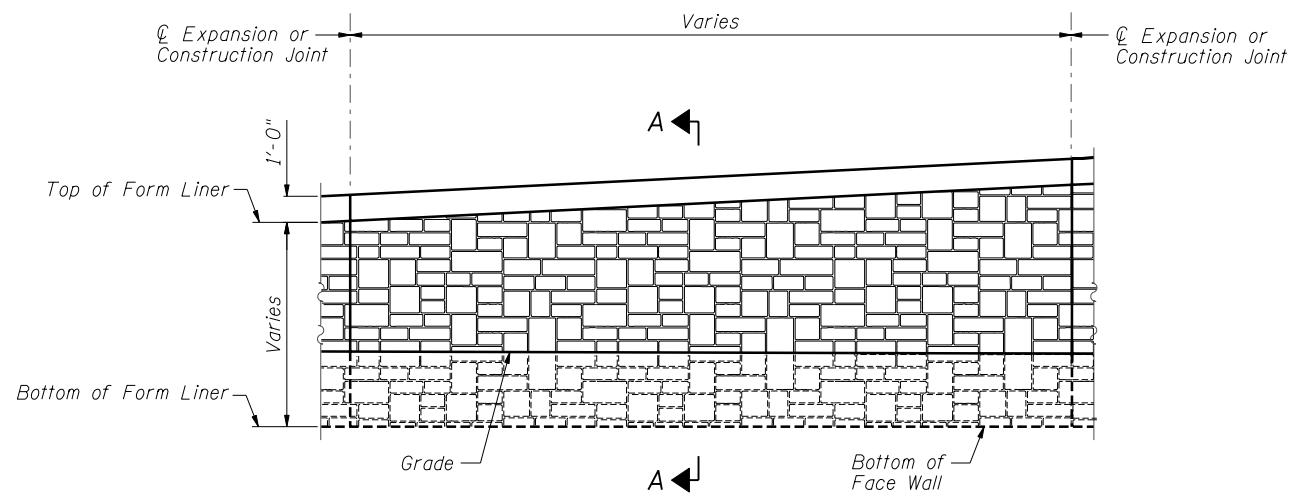



ELEVATION - FORM LINER

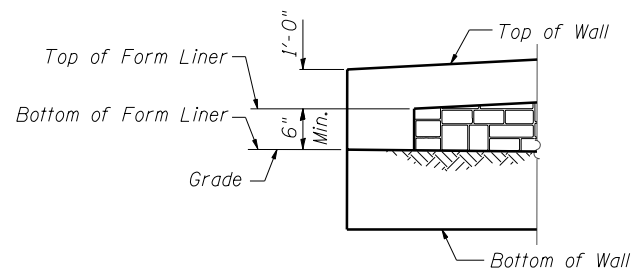

END FORM LINER FINISH

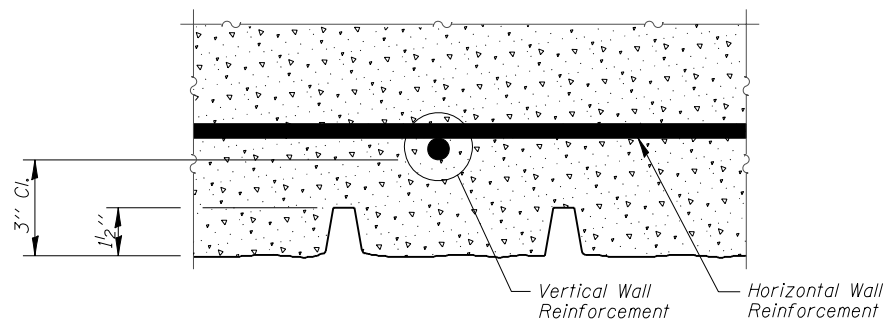

PLAN - FORM LINER

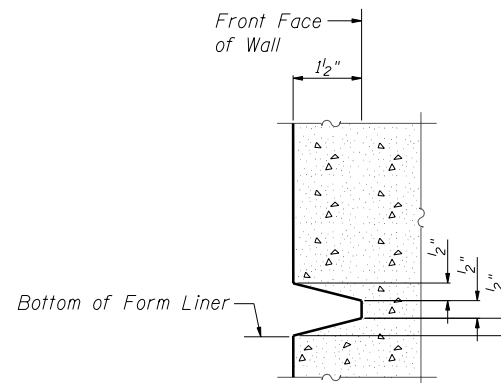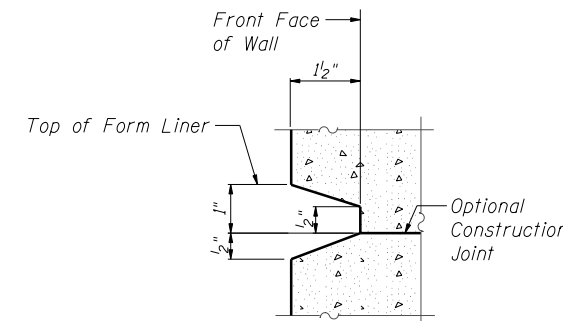

SECTION A-A

FORM LINER ELEVATION TABLE

Station	Form Liner Top Elevation	Form Liner Bottom Elevation
4017+22.00	710.50	708.55
4017+26.00	712.50	708.40
4017+50.00	712.50	707.47
4017+80.00	712.50	706.32
4017+99.19	712.50	705.58
4018+10.00	712.50	705.48
4018+40.00	712.50	705.20
4018+70.00	712.50	704.93
4019+00.00	712.50	704.65
4019+30.00	712.50	703.14
4019+30.00	712.50	703.14
4019+49.00	712.50	702.19
4019+58.60	712.50	701.79
4019+82.00	712.50	700.80
4019+82.00	712.00	700.80
4019+95.77	712.00	700.22
4019+95.77	712.00	701.80
4020+02.27	712.00	701.80
4020+02.27	712.00	700.22
4020+09.42	712.00	700.36
4020+32.33	712.00	700.80
4020+39.16	712.00	701.00
4020+39.16	712.00	708.69
4020+49.50	712.00	708.69
4020+49.50	712.00	701.00
4020+59.50	712.00	701.69
4020+89.50	712.00	703.76
4020+89.50	711.50	703.76
4021+00.75	711.50	704.54
4021+19.50	711.50	704.68
4021+49.50	711.50	704.90
4021+79.50	711.50	705.28
4022+09.50	711.50	705.65
4022+39.50	711.50	706.03
4022+39.50	711.00	706.03
4022+50.50	711.00	706.17
4022+69.50	711.00	706.06
4022+99.50	711.00	705.88
4022+99.50	710.25	705.88
4023+18.58	710.25	705.88
4023+26.06	710.25	705.88
4023+28.14	710.25	706.67

**ARCHITECTURAL FINISH DETAILS
SN 022-W052**

FILE NAME = ...EGP42-W052-012-ArchFinsh.dgn



USER NAME = SAW	DESIGNED - LAS	REVISED -
CHECKED - DAZ	REVISIONS -	
PLOT SCALE = 0.1667' / IN.	DRAWN - SAW	REVISED -
PLOT DATE = 5/4/2012	CHECKED - LAS	REVISED -

**STATE OF ILLINOIS
DEPARTMENT OF TRANSPORTATION**

**ARCHITECTURAL FINISH DETAILS
STA. 4017+22.00 TO STA. 4023+28.14 SN 022-W052**

SHEET NO. SE-12 OF SE-14 SHEETS

F.A.P. RTE.	SECTION	COUNTY	TOTAL SHEETS	SHEET NO.
338	2011-036-1	DUPAGE	234	122
CONTRACT NO. 60P42				
ILLINOIS FED. AID PROJECT				

BORING LOG RW-43

Geo Services, Inc. SOIL BORING LOG	
Geotechnical, Environmental & Civil Engineering 805 Amherst Court, Suite 204 Naperville, Illinois 60565 (630) 355-3838				PAGE 1 of 1				DATE 3/14/2011	
ROUTE II. Route 59 (FAP 338)				DESCRIPTION Illinois Route 59-Aurora Avenue/New York Street To Ferry Road				LOGGED BY RJ	
SECTION (112 & 113) WRS-5				LOCATION SEC. 3, 9-10, 15-16, 21-22 TWP. 38N, RNG. 9E, Naperville Township				GSI JOB No. 09173	
COUNTY DuPage				DRILLING METHOD Hollow Stem Auger				HAMMER TYPE CME Automatic	
STRUCT. NO. 022-W052				Surface Water Elev. n/a				D B U M	
Station: 4017+20 to 4023+30				Stream Bed Elev. n/a				E L O C S	
BORING NO. RW-43				Groundwater Elevation:				D B U M	
Station: 4019+20 IL RTE-59				First Encounter 682.4				E L O C S	
Offset: 59.0' Right				Upon Completion 694.4				H S Qu T	
Ground Surface Elev. 703.4				After Hrs.				(ft) (f/6") (tsf) (%)	
<table border="1"> <tr> <td>TOPSOIL-black</td> <td>702.4</td> <td>AS</td> <td>-</td> <td>41</td> <td></td> <td></td> <td></td> <td></td> <td></td> <td></td> <td></td> </tr> <tr> <td></td> <td></td> <td>2</td> <td></td> <td>87</td> <td></td> <td></td> <td></td> <td></td> <td></td> <td></td> <td>110</td> </tr> <tr> <td>SILTY CLAY-dark brown & gray-stiff (A-6) Wet</td> <td></td> <td>3</td> <td></td> <td></td> <td></td> <td></td> <td></td> <td></td> <td></td> <td></td> <td></td> </tr> <tr> <td></td> <td></td> <td>4</td> <td>1.9B</td> <td>24</td> <td></td> <td></td> <td></td> <td></td> <td></td> <td></td> <td></td> </tr> <tr> <td></td> <td>689.4</td> <td>3</td> <td></td> <td>112</td> <td></td> <td></td> <td></td> <td></td> <td></td> <td></td> <td></td> </tr> <tr> <td></td> <td></td> <td>4</td> <td></td> <td></td> <td></td> <td></td> <td></td> <td></td> <td></td> <td></td> <td></td> </tr> <tr> <td></td> <td></td> <td>5</td> <td>3.7B</td> <td>16</td> <td></td> <td></td> <td></td> <td></td> <td></td> <td></td> <td></td> </tr> <tr> <td>CLAY-brown & gray-very stiff to hard (A-6)</td> <td></td> <td>6</td> <td></td> <td></td> <td></td> <td></td> <td></td> <td></td> <td></td> <td></td> <td></td> </tr> <tr> <td></td> <td></td> <td>7</td> <td></td> <td></td> <td></td> <td></td> <td></td> <td></td> <td></td> <td></td> <td></td> </tr> <tr> <td></td> <td></td> <td>8</td> <td></td> <td></td> <td></td> <td></td> <td></td> <td></td> <td></td> <td></td> <td></td> </tr> <tr> <td></td> <td></td> <td>9</td> <td></td> <td></td> <td></td> <td></td> <td></td> <td></td> <td></td> <td></td> <td></td> </tr> <tr> <td></td> <td></td> <td>10</td> <td>6.25B</td> <td>16</td> <td></td> <td></td> <td></td> <td></td> <td></td> <td></td> <td></td> </tr> <tr> <td></td> <td>694.4</td> <td>11</td> <td></td> <td>116</td> <td></td> <td></td> <td></td> <td></td> <td></td> <td></td> <td></td> </tr> <tr> <td></td> <td></td> <td>12</td> <td></td> <td></td> <td></td> <td></td> <td></td> <td></td> <td></td> <td></td> <td></td> </tr> <tr> <td></td> <td></td> <td>13</td> <td></td> <td></td> <td></td> <td></td> <td></td> <td></td> <td></td> <td></td> <td></td> </tr> <tr> <td></td> <td></td> <td>14</td> <td></td> <td></td> <td></td> <td></td> <td></td> <td></td> <td></td> <td></td> <td></td> </tr> <tr> <td></td> <td></td> <td>15</td> <td>4.2B</td> <td>17</td> <td></td> <td></td> <td></td> <td></td> <td></td> <td></td> <td></td> </tr> <tr> <td></td> <td></td> <td>36</td> <td></td> <td></td> <td></td> <td></td> <td></td> <td></td> <td></td> <td></td> <td></td> </tr> <tr> <td></td> <td></td> <td>37</td> <td></td> <td></td> <td></td> <td></td> <td></td> <td></td> <td></td> <td></td> <td></td> </tr> <tr> <td></td> <td></td> <td>38</td> <td></td> <td></td> <td></td> <td></td> <td></td> <td></td> <td></td> <td></td> <td></td> </tr> <tr> <td></td> <td></td> <td>39</td> <td></td> <td></td> <td></td> <td></td> <td></td> <td></td> <td></td> <td></td> <td></td> </tr> <tr> <td></td> <td></td> <td>40</td> <td></td> <td></td> <td></td> <td></td> <td></td> <td></td> <td></td> <td></td> <td></td> </tr> </table>												TOPSOIL-black	702.4	AS	-	41										2		87							110	SILTY CLAY-dark brown & gray-stiff (A-6) Wet		3												4	1.9B	24									689.4	3		112										4												5	3.7B	16								CLAY-brown & gray-very stiff to hard (A-6)		6												7												8												9												10	6.25B	16									694.4	11		116										12												13												14												15	4.2B	17										16												17												18												
TOPSOIL-black	702.4	AS	-	41	
		2		87							110	
SILTY CLAY-dark brown & gray-stiff (A-6) Wet		3	
		4	1.9B	24	
	689.4	3		112	
		4	
		5	3.7B	16	
CLAY-brown & gray-very stiff to hard (A-6)		6	
		7	
		8	
		9	
		10	6.25B	16	
	694.4	11		116	
		12	
		13	
		14	
		15	4.2B	17	
		16	
		17	
The Unconfined Compressive Strength (UCS) Failure Mode is indicated by (B-Bulge, S-Shear, P-Penetrometer). ST-Shelby Tube Sample VS-Vane Shear Test
The SPT (N value) is the sum of the last two blow values in each sampling zone (AASHTO T206) The Unit Dry Weight (pcf) is noted in Italics above moist (%)
NR-No Recovery

BORING LOG RW-44

Geo Services, Inc. SOIL BORING LOG	
Geotechnical, Environmental & Civil Engineering 805 Amherst Court, Suite 204 Naperville, Illinois 60565 (630) 355-3838				PAGE 1 of 1				DATE 3/15/2011	
ROUTE II. Route 59 (FAP 338)				DESCRIPTION Illinois Route 59-Aurora Avenue/New York Street To Ferry Road				LOGGED BY RJ	
SECTION (112 & 113) WRS-5				LOCATION SEC. 3, 9-10, 15-16, 21-22 TWP. 38N, RNG. 9E, Naperville Township				GSI JOB No. 09173	
COUNTY DuPage				DRILLING METHOD Hollow Stem Auger				HAMMER TYPE CME Automatic	
STRUCT. NO. 022-W052				Surface Water Elev. n/a				D B U M	
Station: 4017+20 to 4023+30				Stream Bed Elev. n/a				E L O C S	
BORING NO. RW-44				Groundwater Elevation:				D B U M	
Station: 4019+78 IL RTE-59				First Encounter 677.2				E L O C S	
Offset: 59.5' Right				Upon Completion 692.7				H S Qu T	
Ground Surface Elev. 702.7				After Hrs.				(ft) (f/6") (tsf) (%)	
<table border="1"> <tr> <td>TOPSOIL-black</td> <td>701.7</td> <td>AS</td> <td>-</td> <td>33</td> <td></td> <td></td> <td></td> <td></td> <td></td> <td></td> <td></td> </tr> <tr> <td></td> <td></td> <td>5</td> <td></td> <td>98</td> <td></td> <td></td> <td></td> <td></td> <td></td> <td></td> <td>108</td> </tr> <tr> <td>SILTY CLAY-black-very stiff (A-6)</td> <td></td> <td>6</td> <td></td> <td></td> <td></td> <td></td> <td></td> <td></td> <td></td> <td></td> <td></td> </tr> <tr> <td></td> <td></td> <td>8</td> <td>3.2B</td> <td>24</td> <td></td> <td></td> <td></td> <td></td> <td></td> <td></td> <td></td> </tr> <tr> <td></td> <td>698.7</td> <td>2</td> <td></td> <td></td> <td></td> <td></td> <td></td> <td></td> <td></td> <td></td> <td></td> </tr> <tr> <td></td> <td></td> <td>3</td> <td></td> <td></td> <td></td> <td></td> <td></td> <td></td> <td></td> <td></td> <td></td> </tr> <tr> <td></td> <td></td> <td>4</td> <td></td> <td></td> <td></td> <td></td> <td></td> <td></td> <td></td> <td></td> <td></td> </tr> <tr> <td></td> <td></td> <td>5</td> <td></td> <td></td> <td></td> <td></td> <td></td> <td></td> <td></td> <td></td> <td></td> </tr> <tr> <td></td> <td></td> <td>6</td> <td></td> <td></td> <td></td> <td></td> <td></td> <td></td> <td></td> <td></td> <td></td> </tr> <tr> <td></td> <td></td> <td>7</td> <td></td> <td></td> <td></td> <td></td> <td></td> <tr> <td></td> <td></td> <td>38</td> <td></td> <td></td> <td></td> <td></td> <td></td> <td></td> <td></td> <td></td> <td></td> </tr> <tr> <td></td> <td></td> <td>39</td> <td></td> <td></td> <td></td> <td></td> <td></td> <td></td> <td></td> <td></td> <td></td> </tr> <tr> <td></td> <td></td> <td>40</td> <td></td> <td></td> <td></td> <td></td> <td></td> <td></td> <td></td> <td></td> <td></td> </tr> </table>												TOPSOIL-black	701.7	AS	-	33										5		98							108	SILTY CLAY-black-very stiff (A-6)		6												8	3.2B	24									698.7	2												3												4												
TOPSOIL-black	701.7	AS	-	33	
		5		98							108	
SILTY CLAY-black-very stiff (A-6)		6	
		8	3.2B	24	
	698.7	2	
		3	
		4	
The Unconfined Compressive Strength (UCS) Failure Mode is indicated by (B-Bulge, S-Shear, P-Penetrometer). ST-Shelby Tube Sample VS-Vane Shear Test
The SPT (N value) is the sum of the last two blow values in each sampling zone (AASHTO T206) The Unit Dry Weight (pcf) is noted in Italics above moist (%)
NR-No Recovery

BORING LOGS 1
SN 022-W052

FILE NAME = ...EGP42-W052-013-Bor-mg-log.dgn


	USER NAME = SAW PLOT SCALE = 2.00' / IN. PLOT DATE = 5/4/2012	DESIGNED - LAS CHECKED - DAZ DRAWN - SAW CHECKED - LAS	REVISED - REVISED - REVISED - REVISED -	STATE OF ILLINOIS DEPARTMENT OF TRANSPORTATION	BORING LOGS 1 STA. 4017+22.00 TO STA. 4023+28.14 SN 022-W052	F.A.P. RTE. 338 SECTION 2011-036-1 COUNTY DUPAGE TOTAL SHEETS 234 SHEET NO. 123 CONTRACT NO. 60P42
	SHEET NO. SE-13 OF SE-14 SHEETS					ILLINOIS FED. AID PROJECT

BORING LOG RW-45

 Geo Services, Inc. Geotechnical, Environmental & Civil Engineering 805 Amherst Court, Suite 204 Naperville, Illinois 60565 (630) 355-3838		SOIL BORING LOG		PAGE 1 of 1 DATE 3/15/2011 LOGGED BY RJ GSI JOB No. 09173	
ROUTE <u>IL Route 59 (FAP 338)</u> DESCRIPTION <u>Illinois Route 59-Aurora Avenue/New York Street To Ferry Road</u>		SECTION <u>(112 & 113) WRS-5</u> LOCATION <u>SEC. 3, 9-10, 15-16, 21-22 TWP. 38N, RNG. 9E, Naperville Township</u>			
COUNTY <u>DuPage</u> DRILLING METHOD <u>Hollow Stem Auger</u> HAMMER TYPE <u>CME Automatic</u>		STRUCT. NO. <u>022-W052</u> Station: <u>4017+20 to 4023+30</u>			
BORING NO. RW-45 Station: <u>4020+36 IL RTE-59</u> Offset: <u>69.5' Right</u> Ground Surface Elev. <u>708.0</u>		Surface Water Elev. <u>n/a</u> Stream Bed Elev. <u>n/a</u> Groundwater Elevation: First Encounter <u>681.0</u> ▼ Upon Completion <u>693.0</u> ▼ After _____ Hrs. _____ ▼		DEPT H S Qu T BLOW COUNT U.C.S. (tsf) M.O.I.S.T. (%)	
CLAY LOAM-dark brown & gray-very stiff (A-6) Fill 704.5		CLAY-gray-stiff to hard (A-6)		DEPT H S Qu T BLOW COUNT U.C.S. (tsf) M.O.I.S.T. (%)	
SILTY CLAY-dark gray to black-very stiff (A-6) Wet 702.0		SILTY CLAY-brown & gray-medium stiff to stiff (A-6) Wet		DEPT H S Qu T BLOW COUNT U.C.S. (tsf) M.O.I.S.T. (%)	
Clayey SAND-gray-medium dense (A-2) 697.0		CLAY-gray-stiff (A-6)		DEPT H S Qu T BLOW COUNT U.C.S. (tsf) M.O.I.S.T. (%)	
CLAY-gray-stiff to hard (A-6) End Of Boring @ -35.0' Hollow Stem Augers CME Automatic Hammer		CLAY-gray-stiff (A-6)		DEPT H S Qu T BLOW COUNT U.C.S. (tsf) M.O.I.S.T. (%)	

The Unconfined Compressive Strength (UCS) Failure Mode is indicated by (B-Bulge, S-Shear, P-Penetrometer). ST-Shelby Tube Sample VS-Vane Shear Test
 The SPT (N value) is the sum of the last two blow values in each sampling zone (AASHTO T206) The Unit Dry Weight (pcf) is noted in Italics above moist (%)
 NR-No Recovery

BORING LOG RW-46

 Geo Services, Inc. Geotechnical, Environmental & Civil Engineering 805 Amherst Court, Suite 204 Naperville, Illinois 60565 (630) 355-3838		SOIL BORING LOG		PAGE 1 of 1 DATE 3/15/2011 LOGGED BY RJ GSI JOB No. 09173	
ROUTE <u>IL Route 59 (FAP 338)</u> DESCRIPTION <u>Illinois Route 59-Aurora Avenue/New York Street To Ferry Road</u>		SECTION <u>(112 & 113) WRS-5</u> LOCATION <u>SEC. 3, 9-10, 15-16, 21-22 TWP. 38N, RNG. 9E, Naperville Township</u>			
COUNTY <u>DuPage</u> DRILLING METHOD <u>Hollow Stem Auger</u> HAMMER TYPE <u>CME Automatic</u>		STRUCT. NO. <u>022-W052</u> Station: <u>4017+20 to 4023+30</u>			
BORING NO. RW-46 Station: <u>4020+91 IL RTE-59</u> Offset: <u>68.5' Right</u> Ground Surface Elev. <u>705.3</u>		Surface Water Elev. <u>n/a</u> Stream Bed Elev. <u>n/a</u> Groundwater Elevation: First Encounter <u>693.3</u> ▼ Upon Completion <u>695.3</u> ▼ After _____ Hrs. _____ ▼		DEPT H S Qu T BLOW COUNT U.C.S. (tsf) M.O.I.S.T. (%)	
CLAY LOAM-dark brown, gray & black-medium stiff to stiff (A-6) Fill 699.3		CLAY-gray-stiff to very stiff (A-6)		DEPT H S Qu T BLOW COUNT U.C.S. (tsf) M.O.I.S.T. (%)	
SILTY CLAY-dark brown & gray-soft to medium stiff (A-6) Wet 693.8		SILTY SAND & GRAVEL-gray-loose (A-1)		DEPT H S Qu T BLOW COUNT U.C.S. (tsf) M.O.I.S.T. (%)	
CLAY-gray-stiff (A-6) 692.8		CLAY-gray-stiff (A-6)		DEPT H S Qu T BLOW COUNT U.C.S. (tsf) M.O.I.S.T. (%)	
End Of Boring @ -35.0' Hollow Stem Augers CME Automatic Hammer		CLAY-gray-stiff to very stiff (A-6)		DEPT H S Qu T BLOW COUNT U.C.S. (tsf) M.O.I.S.T. (%)	

The Unconfined Compressive Strength (UCS) Failure Mode is indicated by (B-Bulge, S-Shear, P-Penetrometer). ST-Shelby Tube Sample VS-Vane Shear Test
 The SPT (N value) is the sum of the last two blow values in each sampling zone (AASHTO T206) The Unit Dry Weight (pcf) is noted in Italics above moist (%)
 NR-No Recovery

FILE NAME = ...EGP42-W052-014-Bor-mg-Log2.dgn



USER NAME = SAW	DESIGNED - LAS	REVISED -
CHECKED - DAZ	REVISIONS -	
PLOT SCALE = 2.00' / IN.	DRAWN - SAW	REVISED -
PLOT DATE = 5/4/2012	CHECKED - LAS	REVISED -

**STATE OF ILLINOIS
DEPARTMENT OF TRANSPORTATION**

**BORING LOGS 2
STA. 4017+22.00 TO STA. 4023+28.14 SN 022-W052**

F.A.P. RTE. 338	SECTION 2011-036-1	COUNTY DUPAGE	TOTAL SHEETS 234	SHEET NO. 124
CONTRACT NO. 60P42				
ILLINOIS FED. AID PROJECT				

*BORING LOGS 2
SN 022-W052*

SHEET NO. SE-14 OF SE-14 SHEETS

REMOVING MANHOLES

4020+63.2, 55.0 RT
4021+37.0, 55.0 RT

MANHOLES TO BE RECONSTRUCTED

4019+54, 41.9 RT
4019+68, 49.7 RT
4021+09, 41.4 RT
4021+62, 46.8 RT

STORM SEWER REMOVAL - 72"




STA 4020+52.0 TO 4020+62.0 - 16'
STA 4020+65.7 TO 4021+34.5 - 69'
STA 4021+36.0 TO 4021+36.0 - 19'

REMOVING CATCH BASIN TO MAINTAIN FLOW

4019+99, 57.0 RT

PLAN	SURVEYED	DATE
	PLOTTED	BY
	GRADES CHECKED	
	STRUCTURE NOTED	
	FILE NAME	
	NO.	

PROFILE	SURVEYED	DATE
	PLOTTED	BY
	GRADES CHECKED	
	STRUCTURE NOTED	
	FILE NAME	
	NO.	

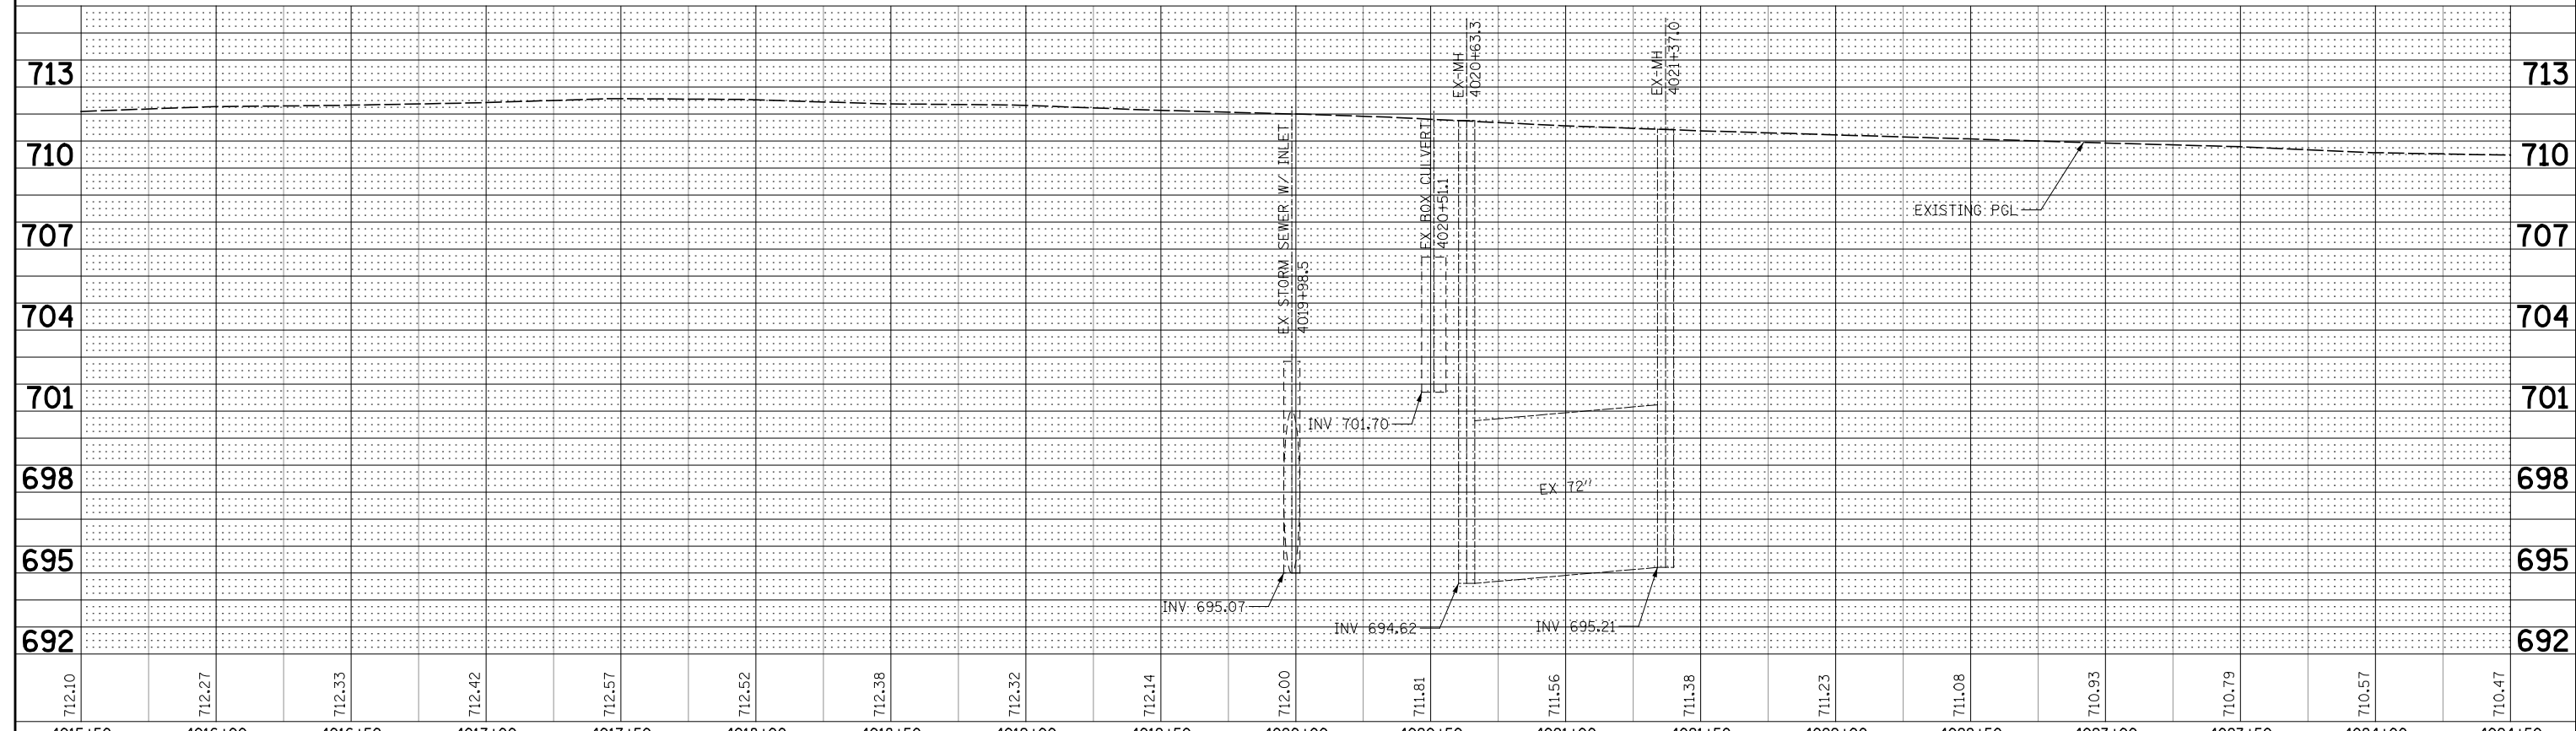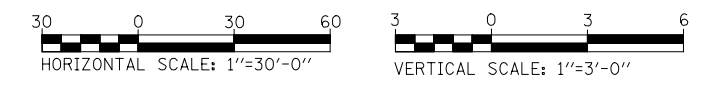
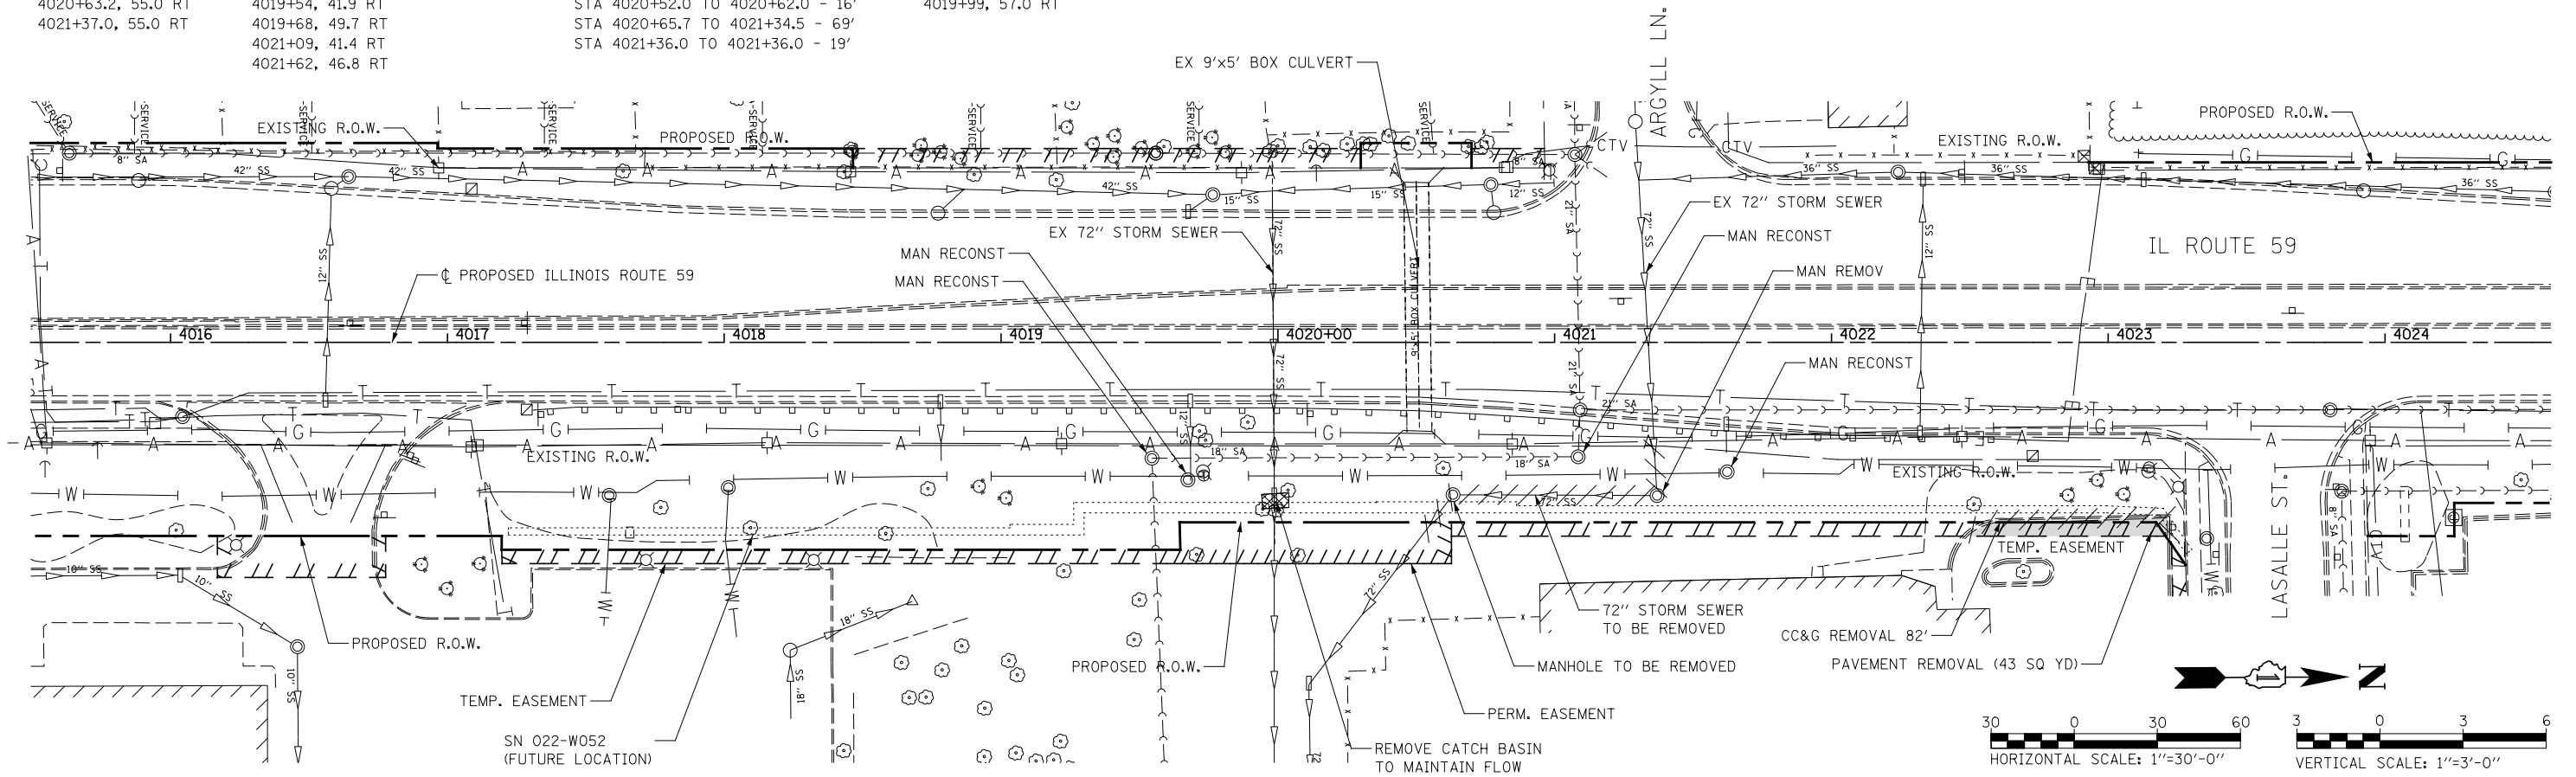


FILE NAME =	USER NAME = *USER*	DESIGNED NAV	REVISED	STATE OF ILLINOIS DEPARTMENT OF TRANSPORTATION	DRAINAGE REMOVAL PLAN / PROFILE - SN 022-W052	F.A.P. RTE.	SECTION	COUNTY	TOTAL SHEETS	SHEET NO.	
FILE#		DRAWN KES	REVISED			338	2011-036-1	DUPAGE	234	125	
		CHECKED PJO	REVISED			CONTRACT NO. 60P42					
		DATE 05-11-12	REVISED			SCALE: AS SHOWN SHEET NO. 1 OF 1 SHEETS STA. 4015+50 TO STA. 4024+50					


- 400 STA 4020+64.2, 51.9 RT
MANHOLE TYPE A 10' DIA.
TYPE 1 FRAME, CLOSED LID
RIM EL 712.28
INV EL 694.62 (N) 72"
INV EL 694.62 (SE) 72"
- 401 STA 4021+51.8, 51.8 RT
MANHOLE TYPE A 10' DIA.
TYPE 1 FRAME, CLOSED LID
RIM EL 711.56
INV EL 694.68 (W) 72"
INV EL 694.68 (S) 72"
- 402 STA 4020+09.6, 75.0 RT
CATCH BASIN TYPE A. 4' DIA.
TYPE 8 GRATE
RIM EL 702.32
INV EL 697.12 (N) 24"
INV EL 697.12 (S) 24"
- 403 STA 4020+18.6, 75.0 RT
CATCH BASIN TYPE A. 4' DIA.
TYPE 8 GRATE
RIM EL 702.32
INV EL 697.15 (S) 24"
- 400 20' - 72" SS CL A TY 1 @ -0.13%
- 401 66' - 72" SS CL A TY 1 @ 0.10%
- 401A 13' - 72" SS CL A TY 1 @ 0.00%
- 402 6' - 24" SS CL A TY 1 @ 0.50%
- 403 6' - 24" SS CL A TY 1 @ 0.50%
- 404 6 - 30" P CUL CL C TY 2 @ 0.00%

PRECAST BOX CULVERT SCHEDULE (ASTM C 1577)					
STATION	SIZE (SPAN X HEIGHT)	SKEW	DESIGN FILL (FT.)		PGE BACK FILL REQUIRED
			MINIMUM	MAXIMUM	
4020+44.3	9' X 5'	0°	2.4	3.8	YES

DATE	
BY	
SURVEYED	
PLANNED	
NOTED	
CHECKED	
FILED	
NO.	

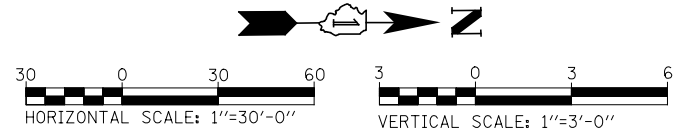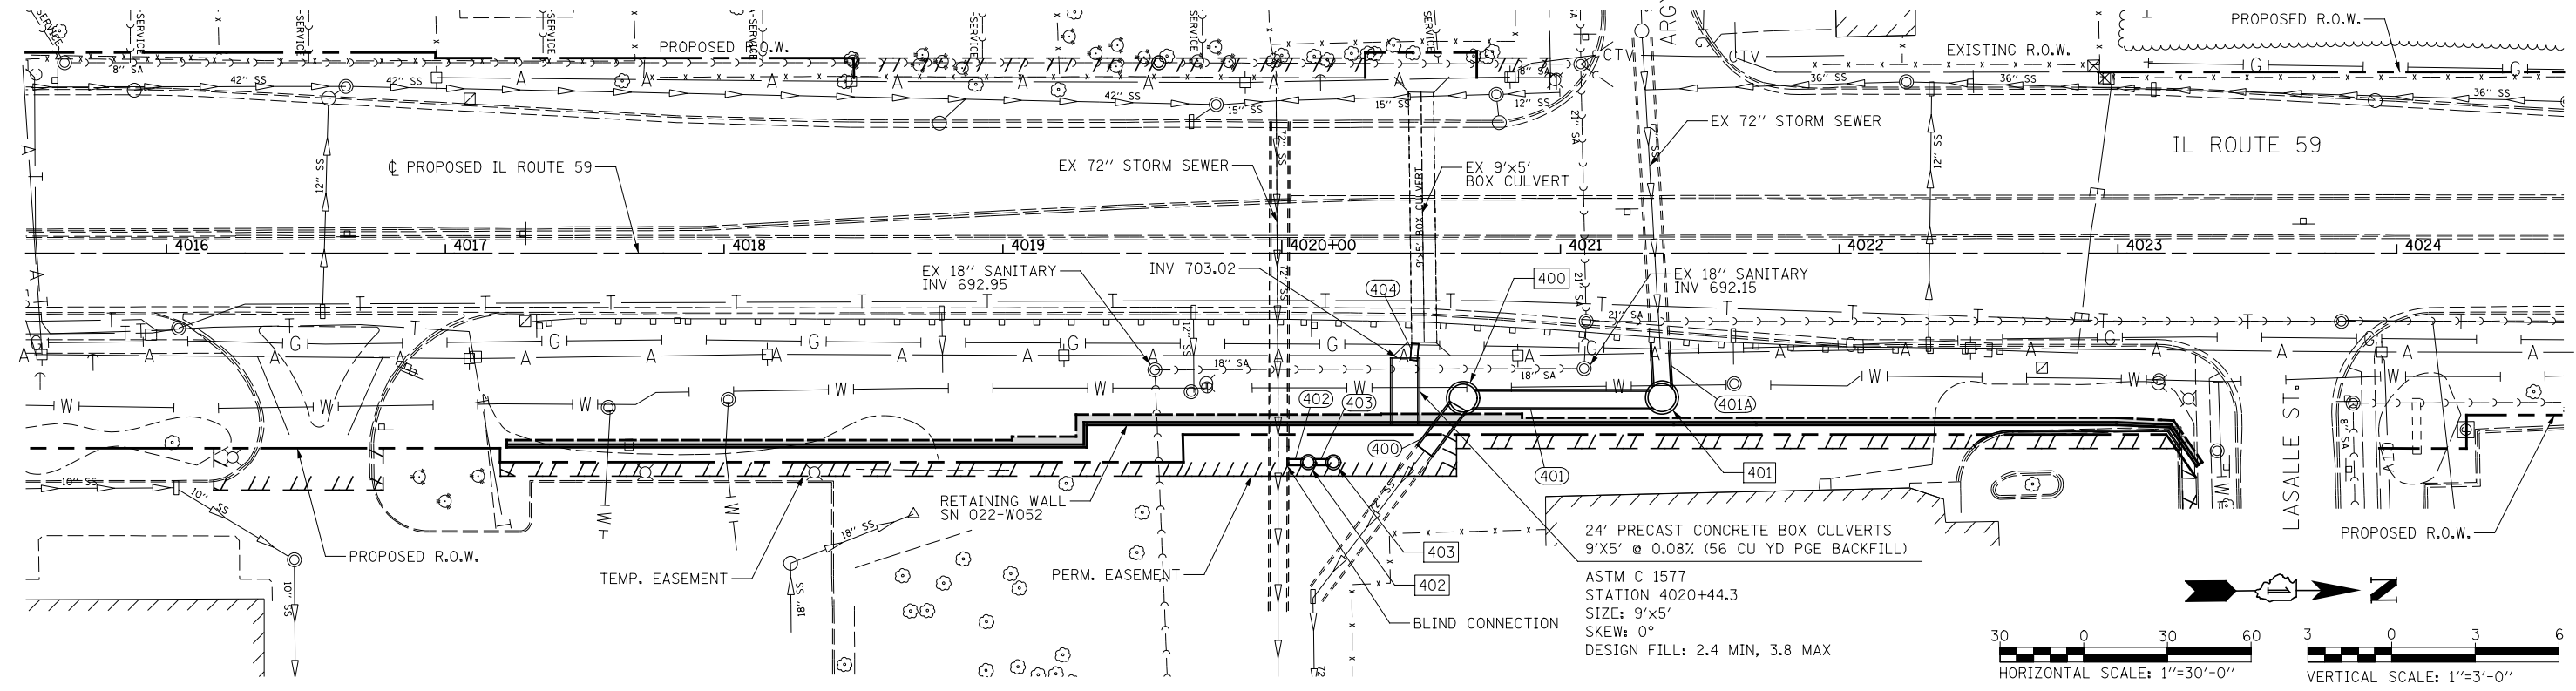

DATE	
BY	
SURVEYED	
PLANNED	
NOTED	
CHECKED	
FILED	
NO.	

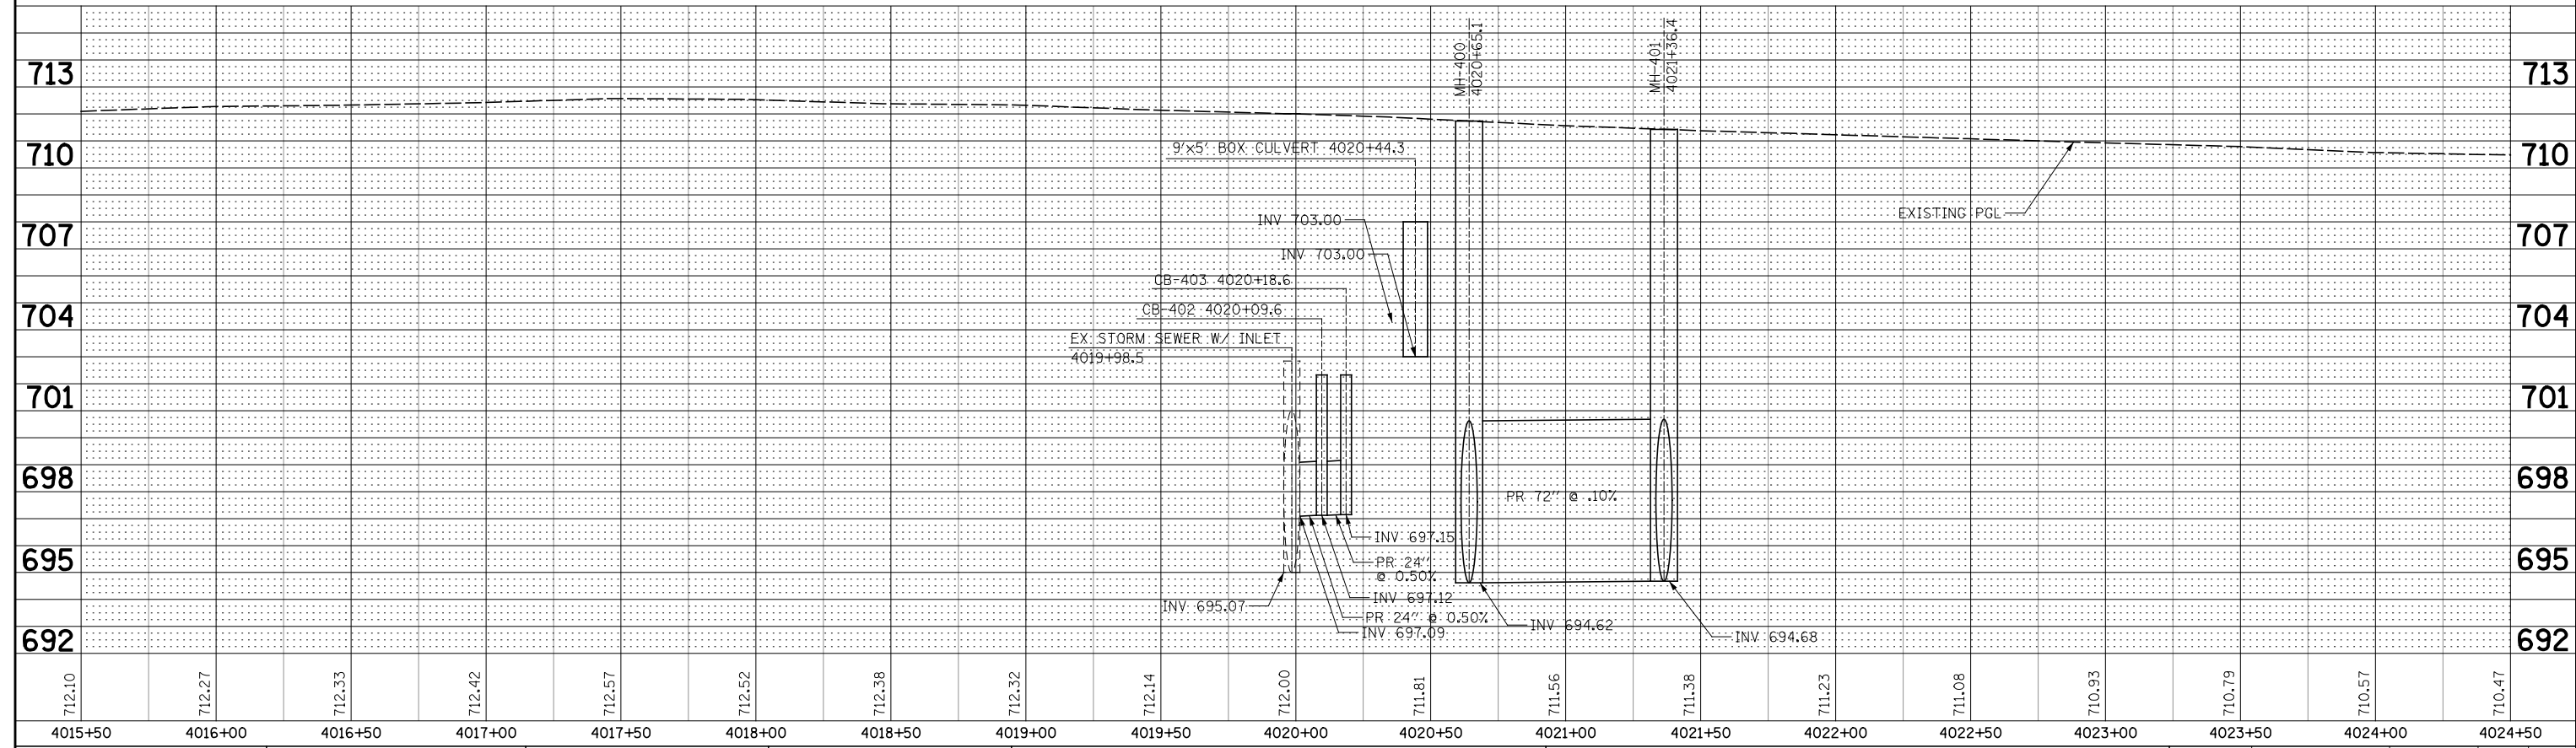

FILE NAME =	USER NAME = *USER*	DESIGNED NAV	REVISED	F.A.P. RTE. 338	SECTION 2011-036-1	COUNTY DUPAGE	TOTAL SHEETS 234	SHEET NO. 126
FILEL	PLOT SCALE = *SCALE*	DRAWN KES	REVISED	CONTRACT NO. 60P42				
	PLOT DATE = *DATE*	CHECKED PJO	REVISED	ILLINOIS FED. AID PROJECT				
		DATE 05-11-12	REVISED					


**STATE OF ILLINOIS
DEPARTMENT OF TRANSPORTATION**

DRAINAGE PLAN / PROFILE - SN 022-W052

SCALE: AS SHOWN SHEET NO. 2 OF 1 SHEETS STA. 4015+50 TO STA. 4024+50


ORIGINAL SURVEY NO.	SURVEYED PLOTTED AREAS CHECKED	BY	DATE
FINAL SURVEY NO.	SURVEYED PLOTTED AREAS CHECKED	BY	DATE

ORIGINAL SURVEY NO.	SURVEYED PLOTTED AREAS CHECKED	BY	DATE
FINAL SURVEY NO.	SURVEYED PLOTTED AREAS CHECKED	BY	DATE

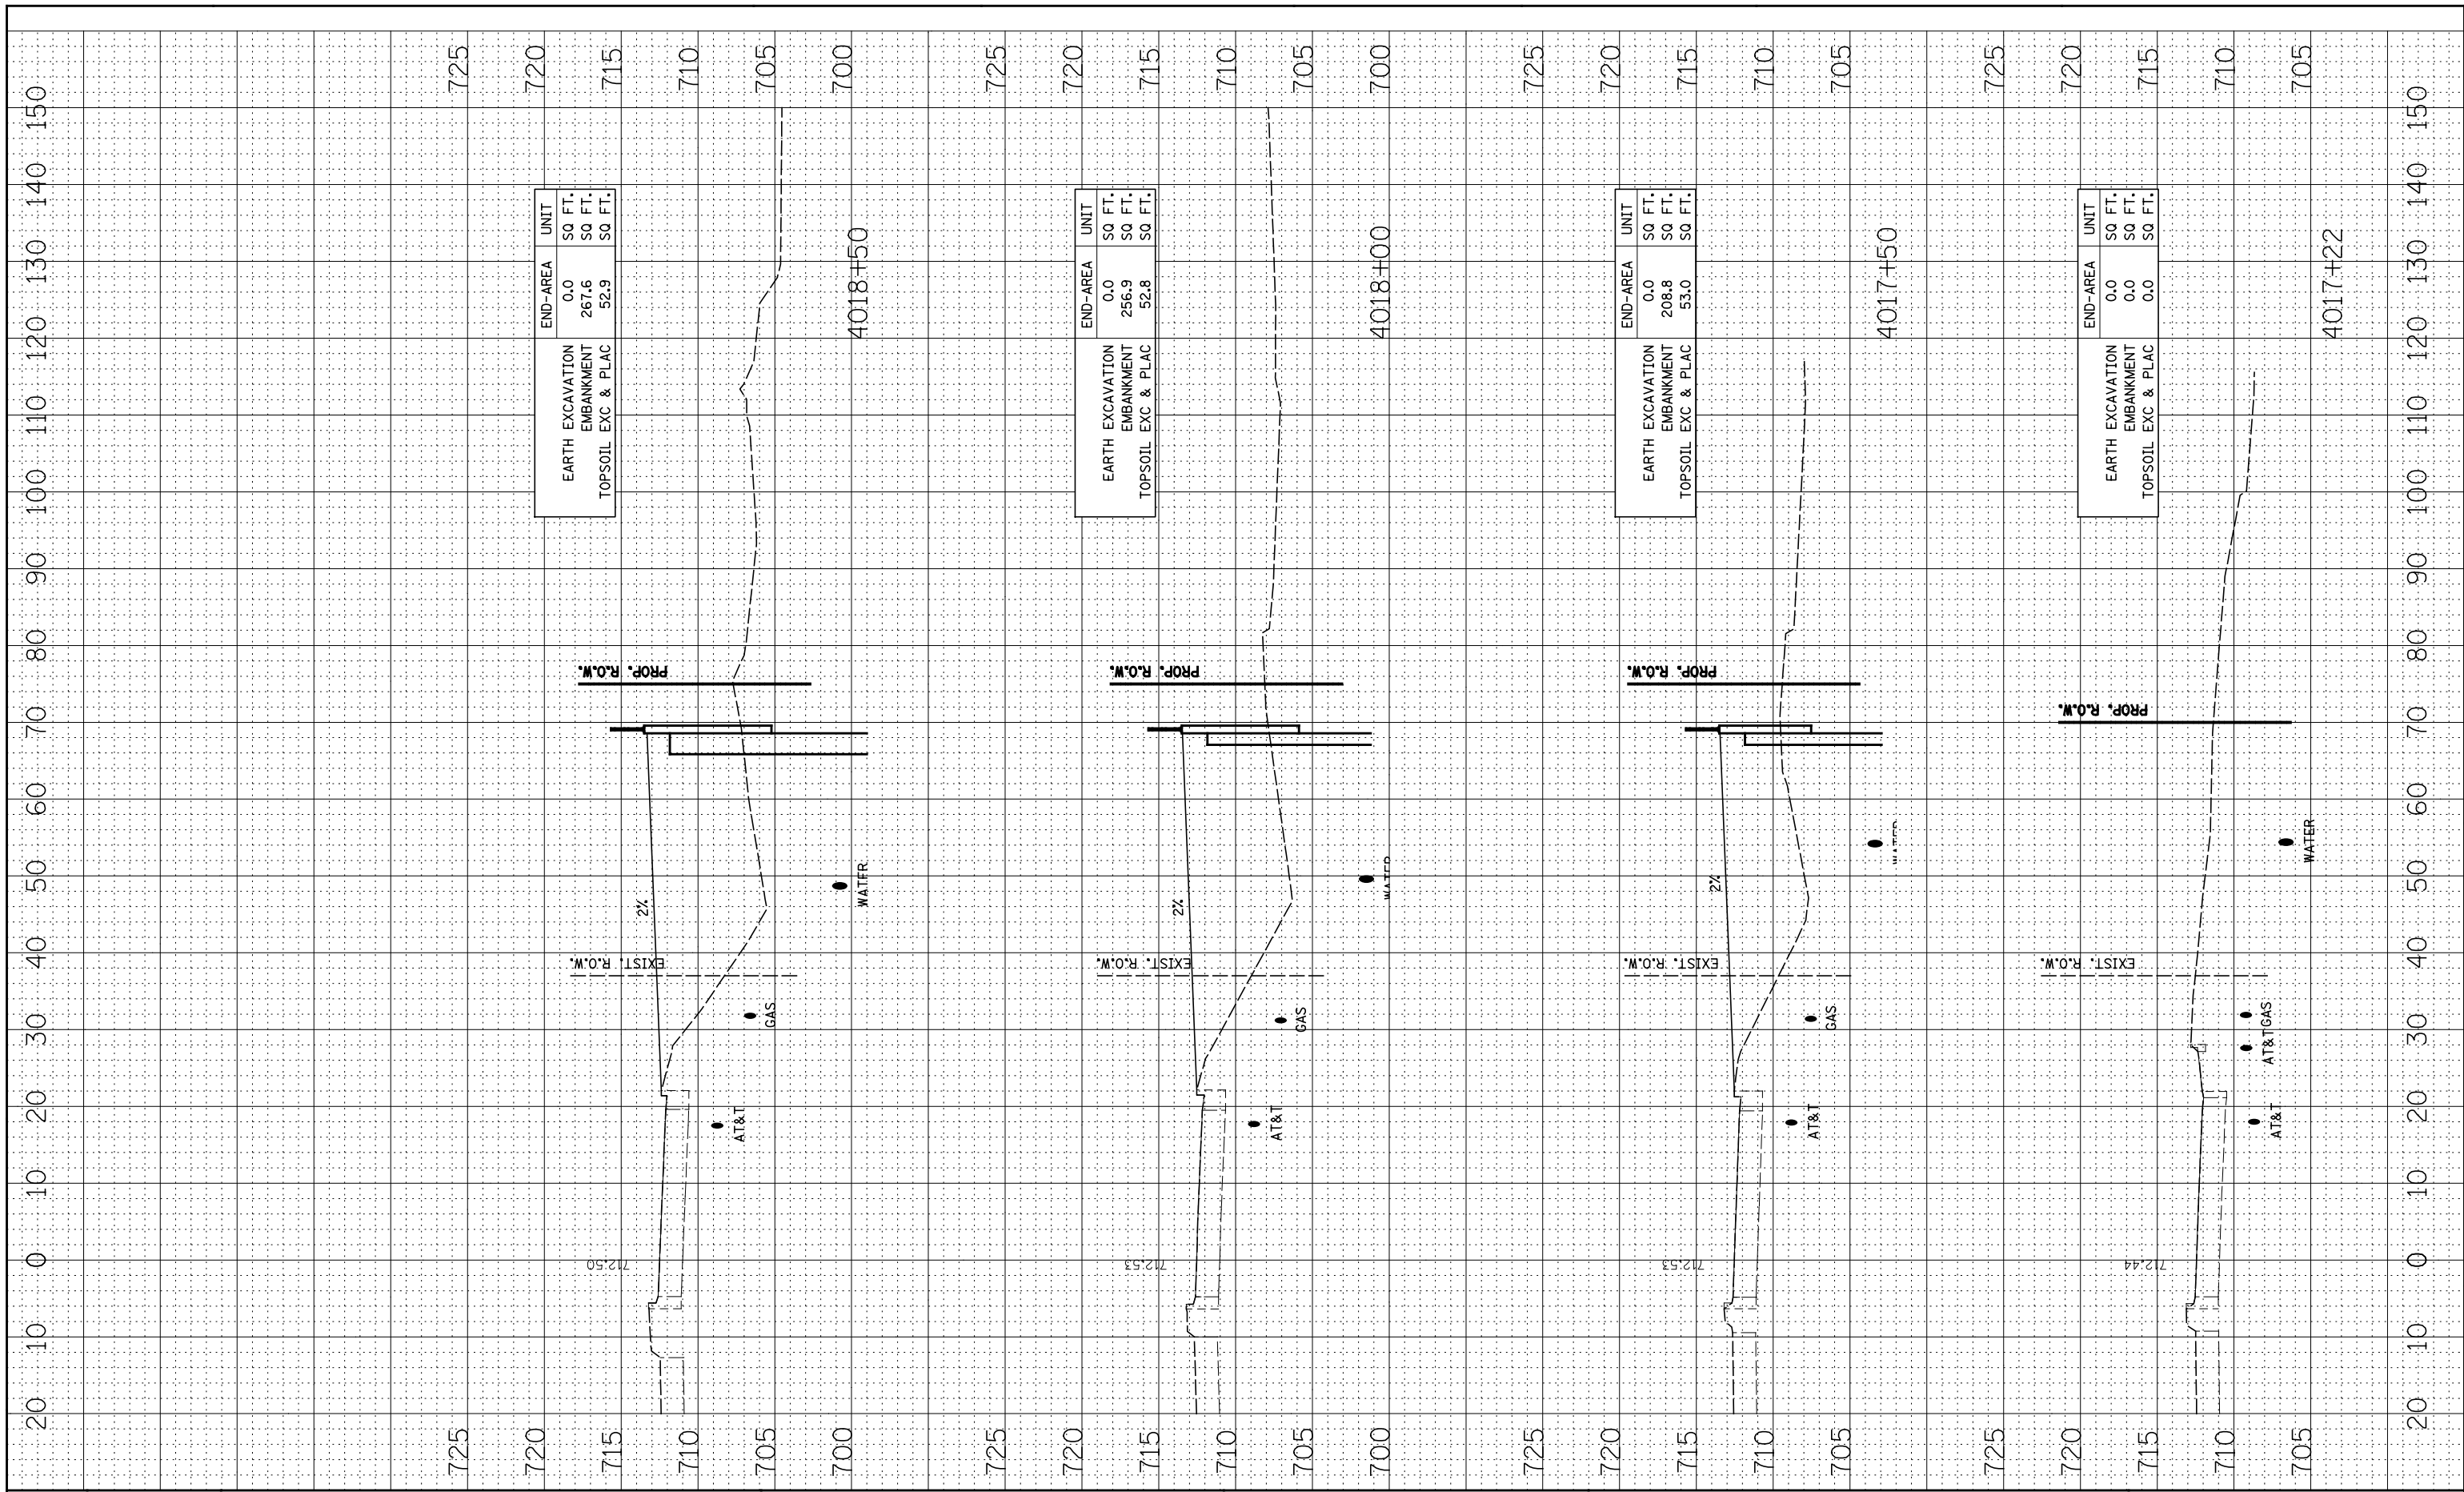

BY _____ DATE _____
 SURVEYED _____
 PLOTTED _____
 ORIGINAL SURVEY NO. _____
 NOTE BOOK _____
 AREAS CHECKED _____

BY _____ DATE _____
 SURVEYED _____
 PLOTTED _____
 ORIGINAL SURVEY NO. _____
 NOTE BOOK _____
 AREAS CHECKED _____

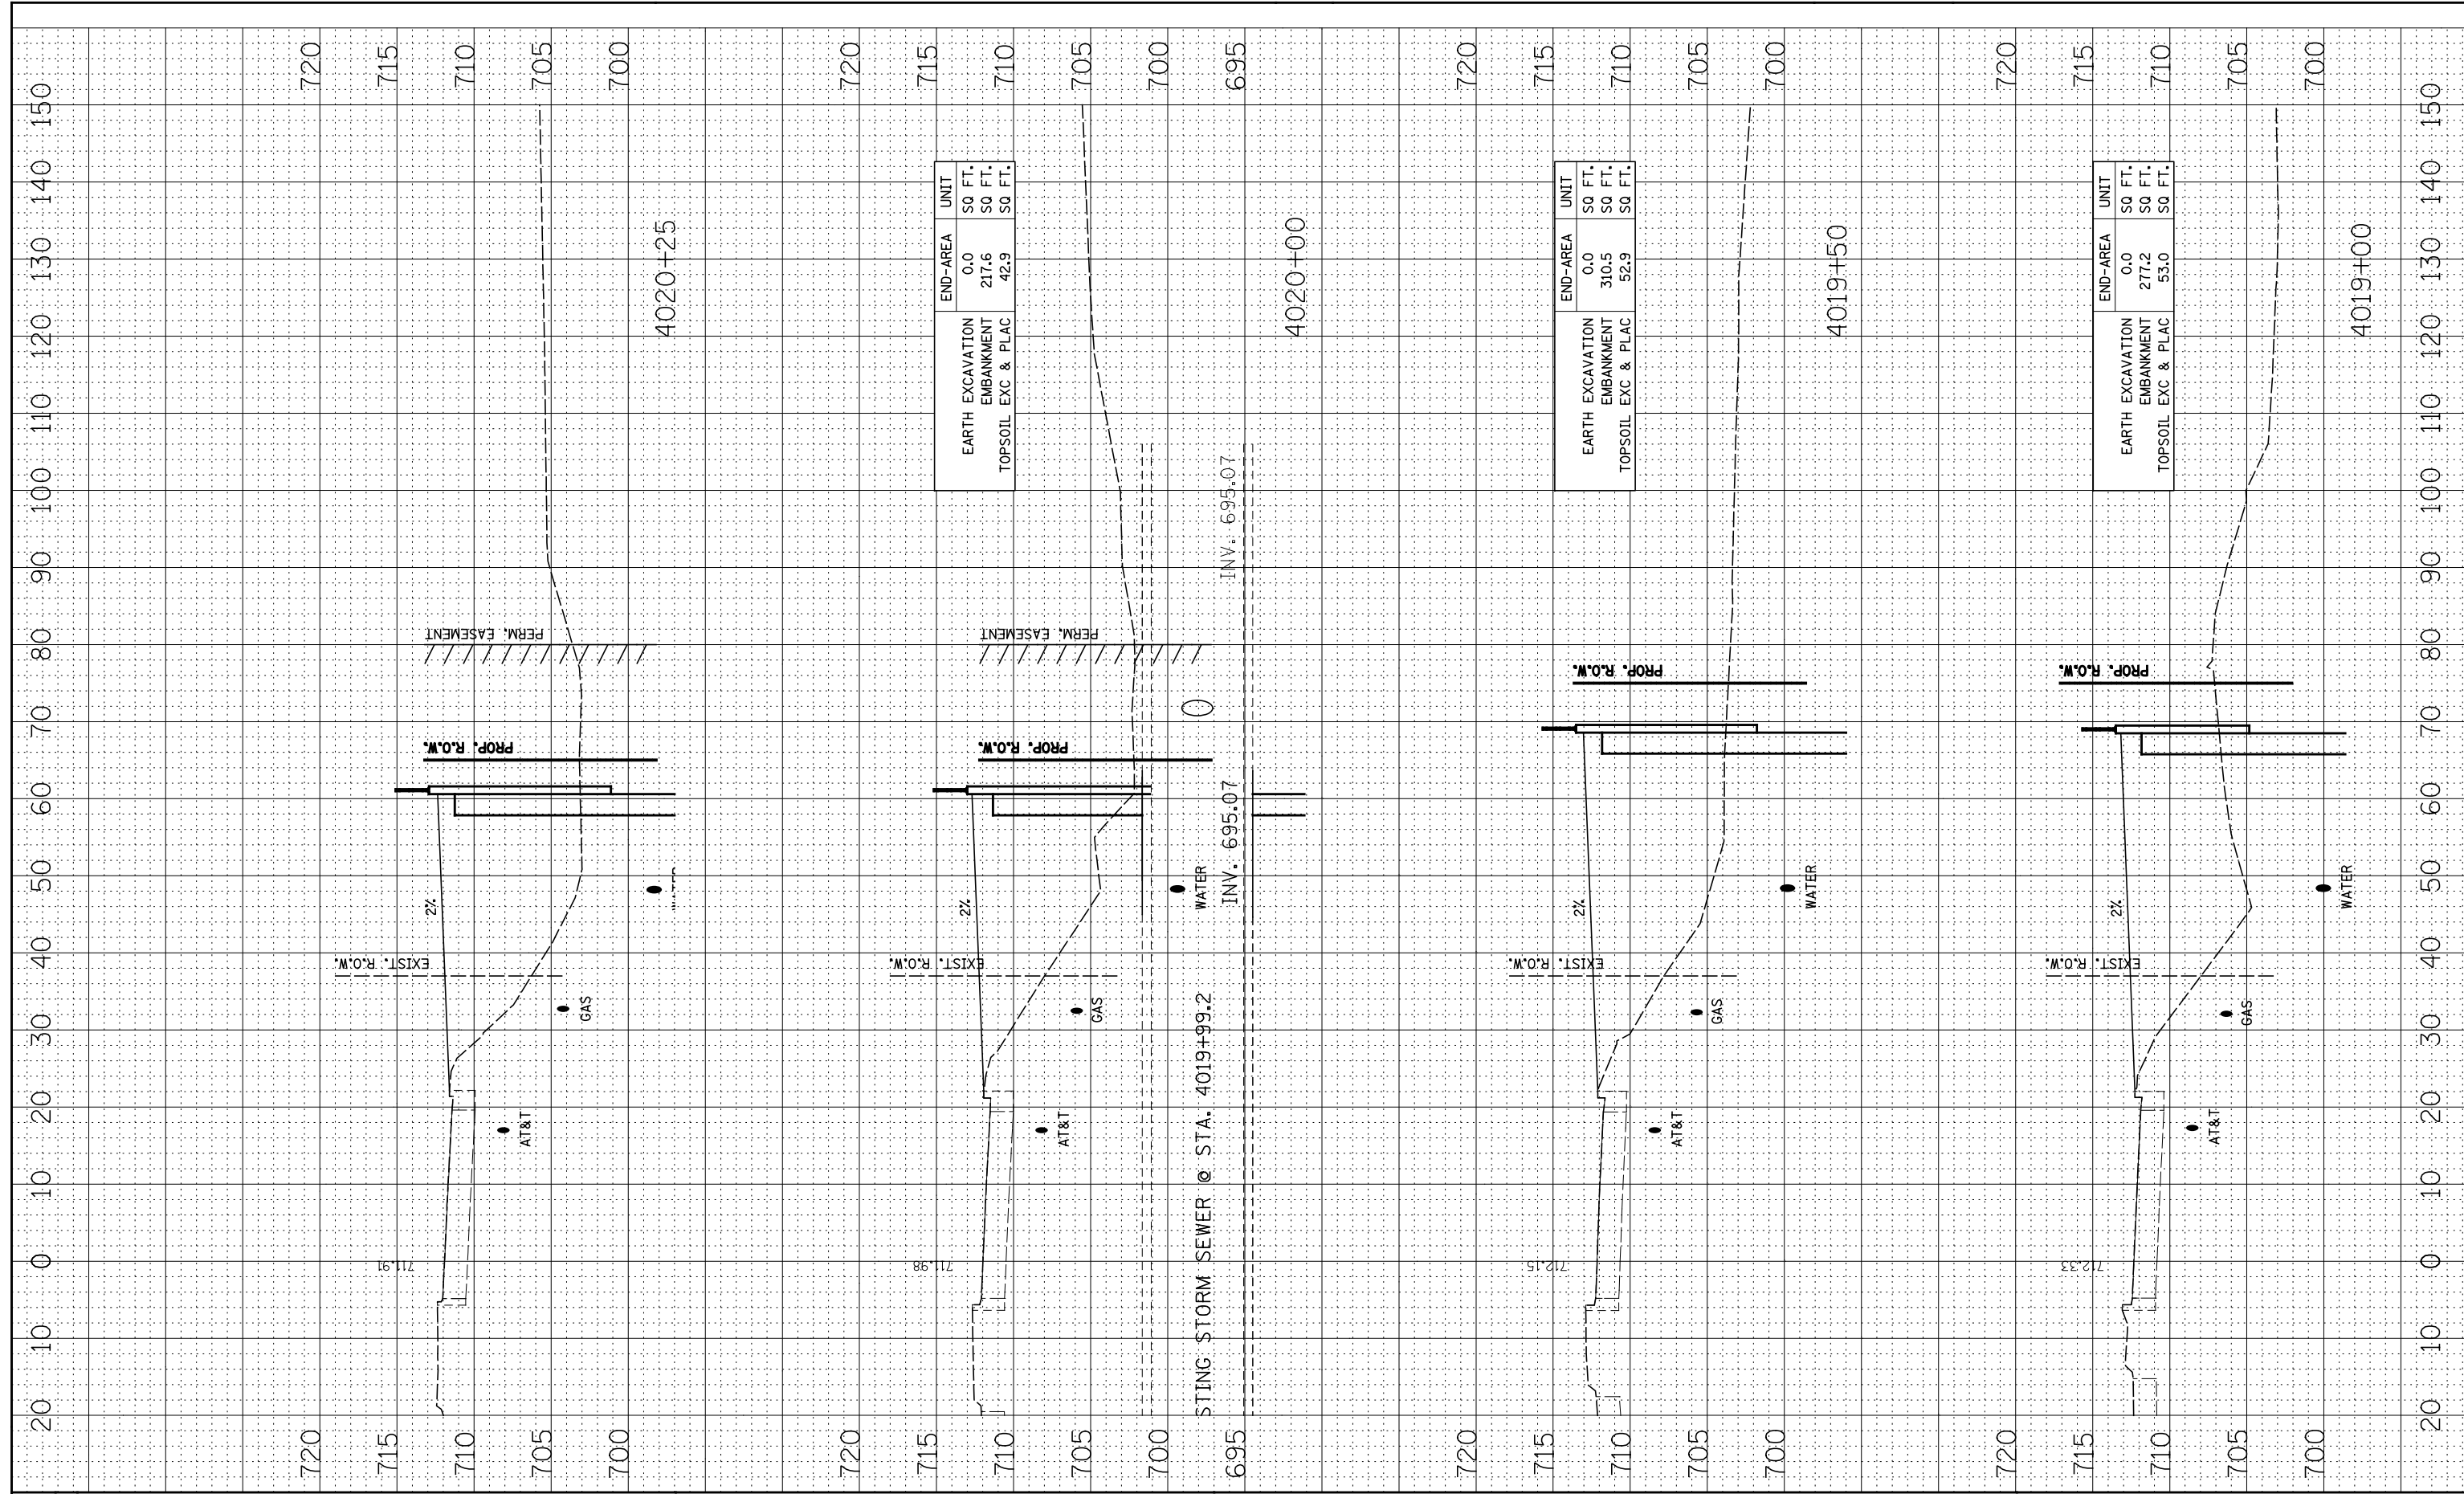

FILE NAME = _____
 *FILE# _____

USER NAME = *USER*
 DESIGNED - NAV
 DRAWN - KES
 CHECKED - PJO
 DATE - 05-11-12

REVISED -
 REVISED -
 REVISED -
 REVISED -


**STATE OF ILLINOIS
 DEPARTMENT OF TRANSPORTATION**

**SN 022-W052
 CROSS-SECTIONS**

SCALE: SHEET NO. 2 OF 4 SHEETS STA. 4019+00 TO STA. 4020+25

F.A.P. RTE.	SECTION	COUNTY	TOTAL SHEETS	SHEET NO.
338	2011-036-I	DUPAGE	234	128
CONTRACT NO. 60P42			ILLINOIS FED. AID PROJECT	

ORIGINAL SURVEY NO.	SURVEYED PLOTTED AREAS CHECKED	BY	DATE
FINAL SURVEY NO.	SURVEYED PLOTTED AREAS CHECKED	BY	DATE

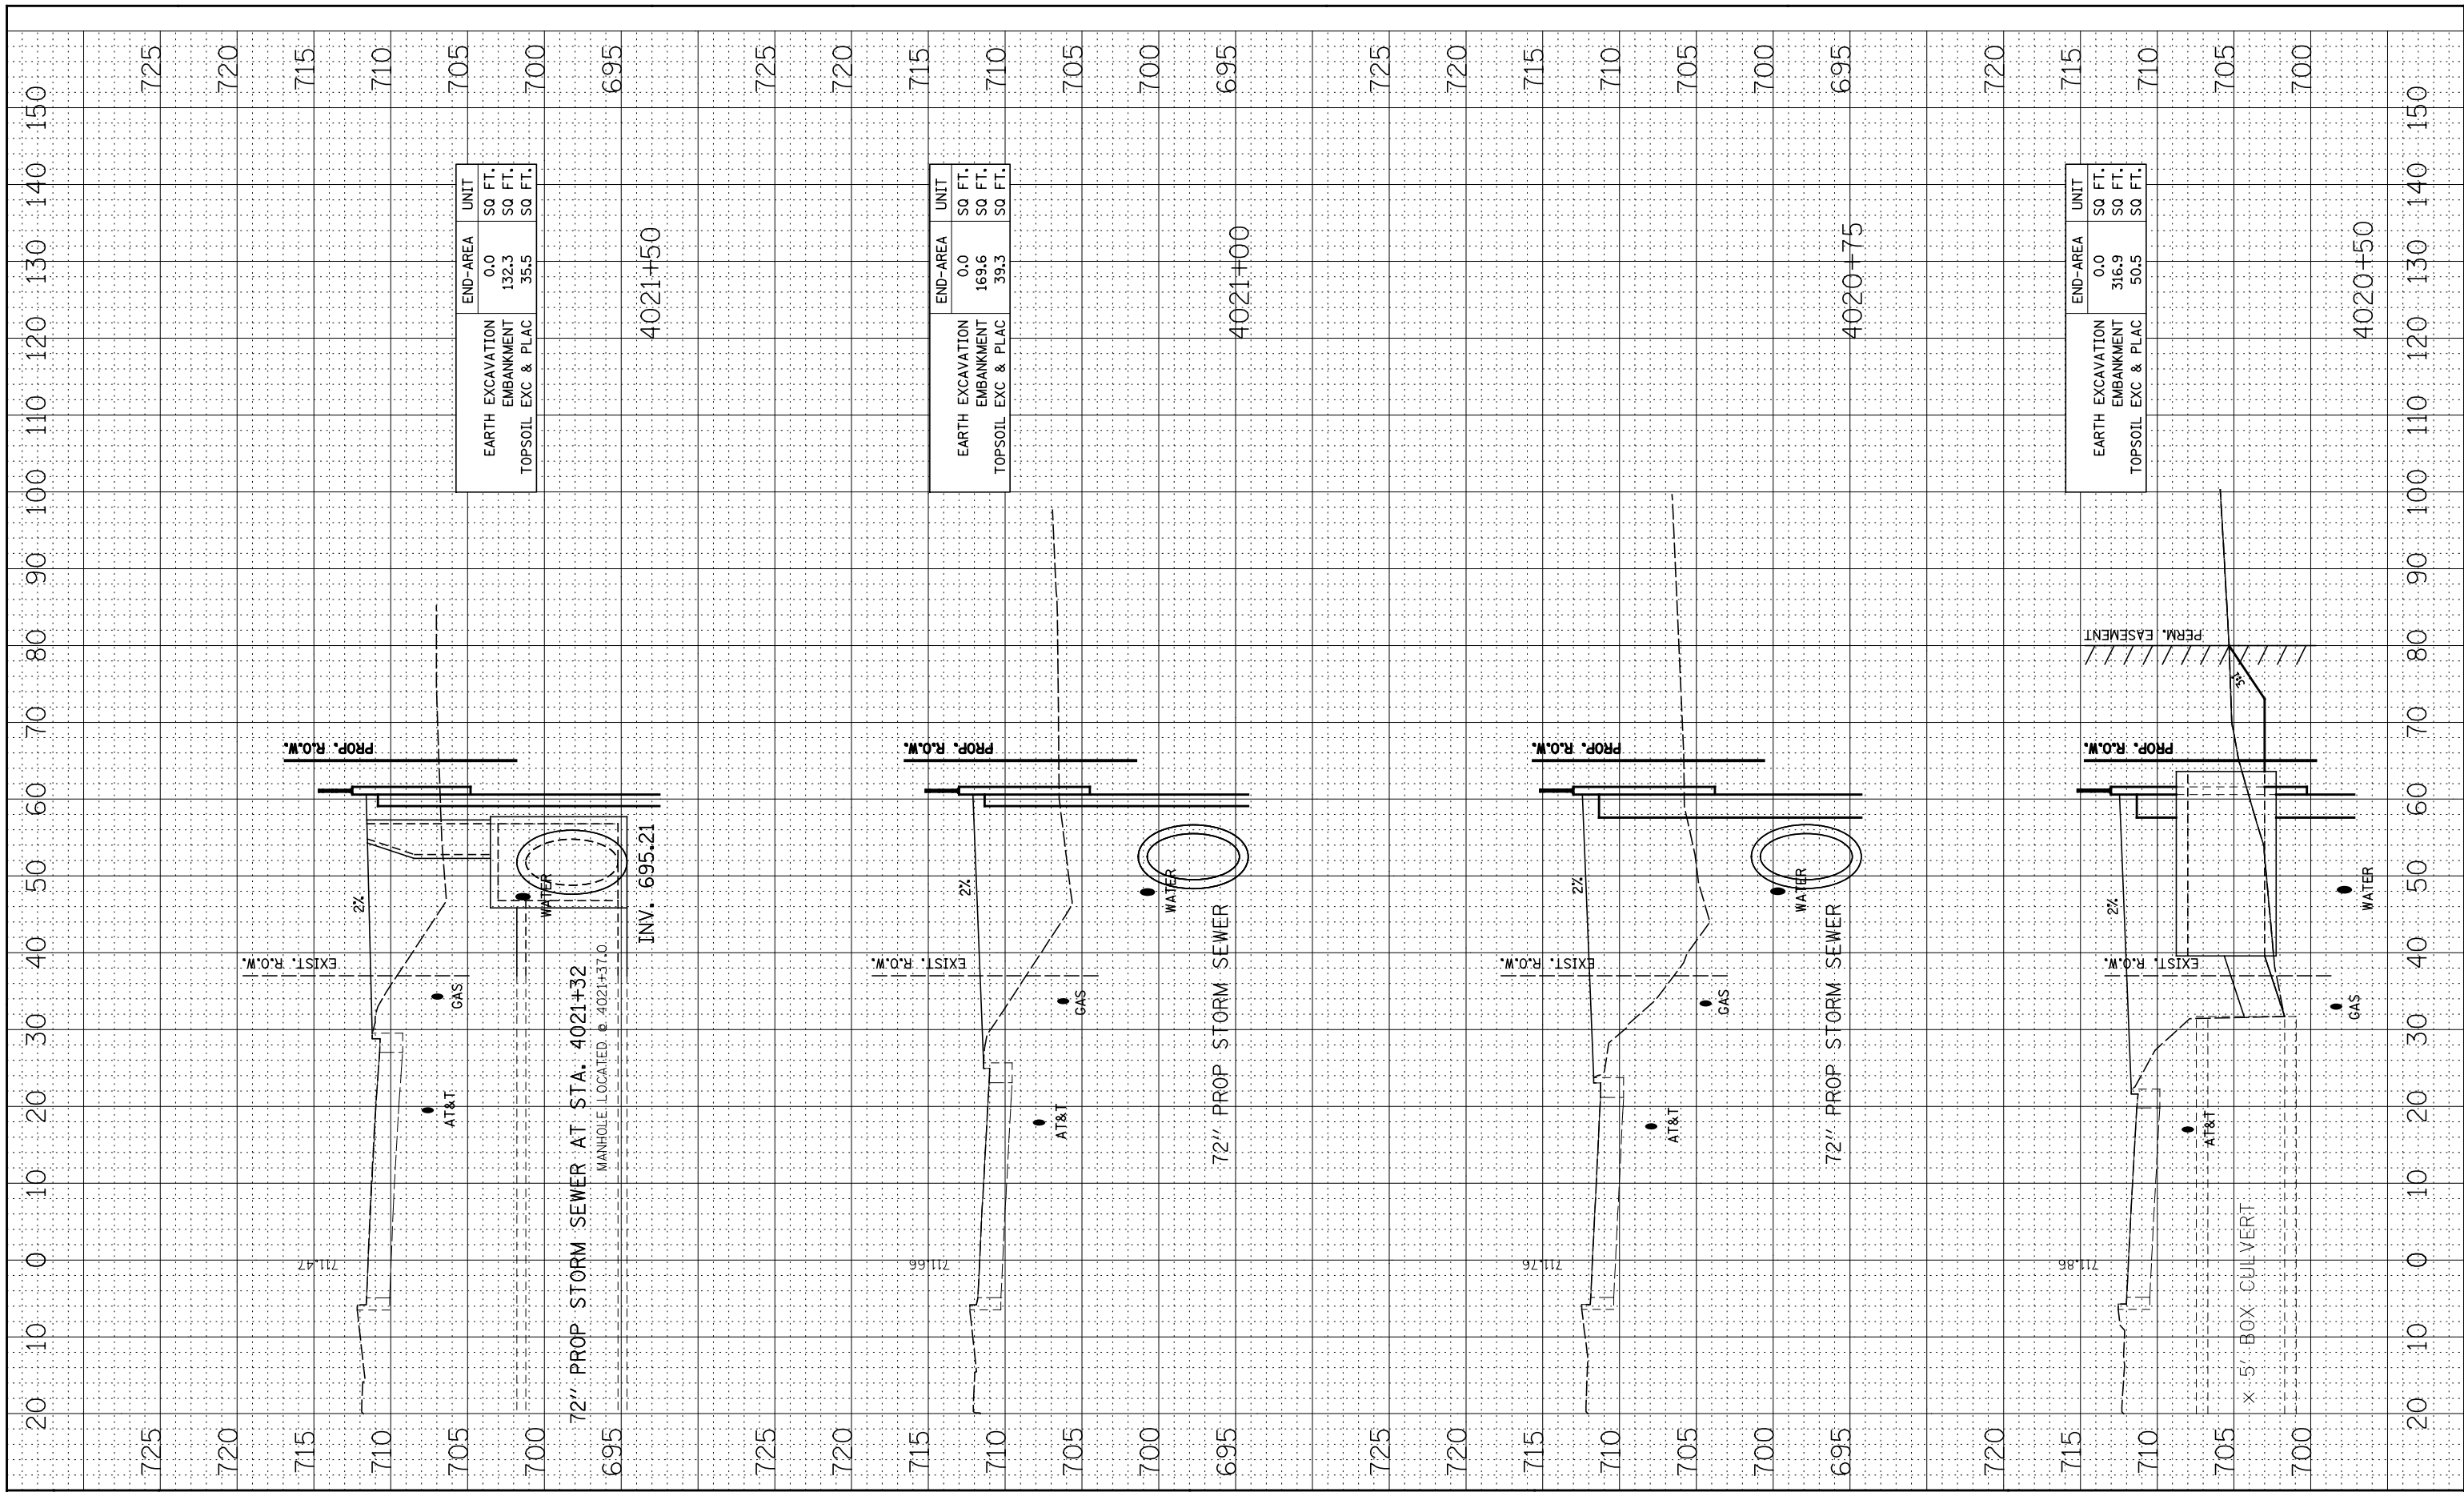


END-AREA	UNIT
EARTH EXCAVATION	SQ FT.
EMBANKMENT	SQ FT.
TOPSOIL EXC & PLAC	SQ FT.
0.0	
132.3	
35.5	

END-AREA	UNIT
EARTH EXCAVATION	SQ FT.
EMBANKMENT	SQ FT.
TOPSOIL EXC & PLAC	SQ FT.
0.0	
169.6	
39.3	

END-AREA	UNIT
EARTH EXCAVATION	SQ FT.
EMBANKMENT	SQ FT.
TOPSOIL EXC & PLAC	SQ FT.
0.0	
316.9	
50.5	

ORIGINAL SURVEY	SURVEYED	BY	DATE
NOTE BOOK	PLOTTED		
AREAS CHECKED	TEMPLATE		
	AREAS CHECKED		

FINAL SURVEY	SURVEYED	BY	DATE
NOTE BOOK	PLOTTED		
AREAS CHECKED	TEMPLATE		
	AREAS CHECKED		

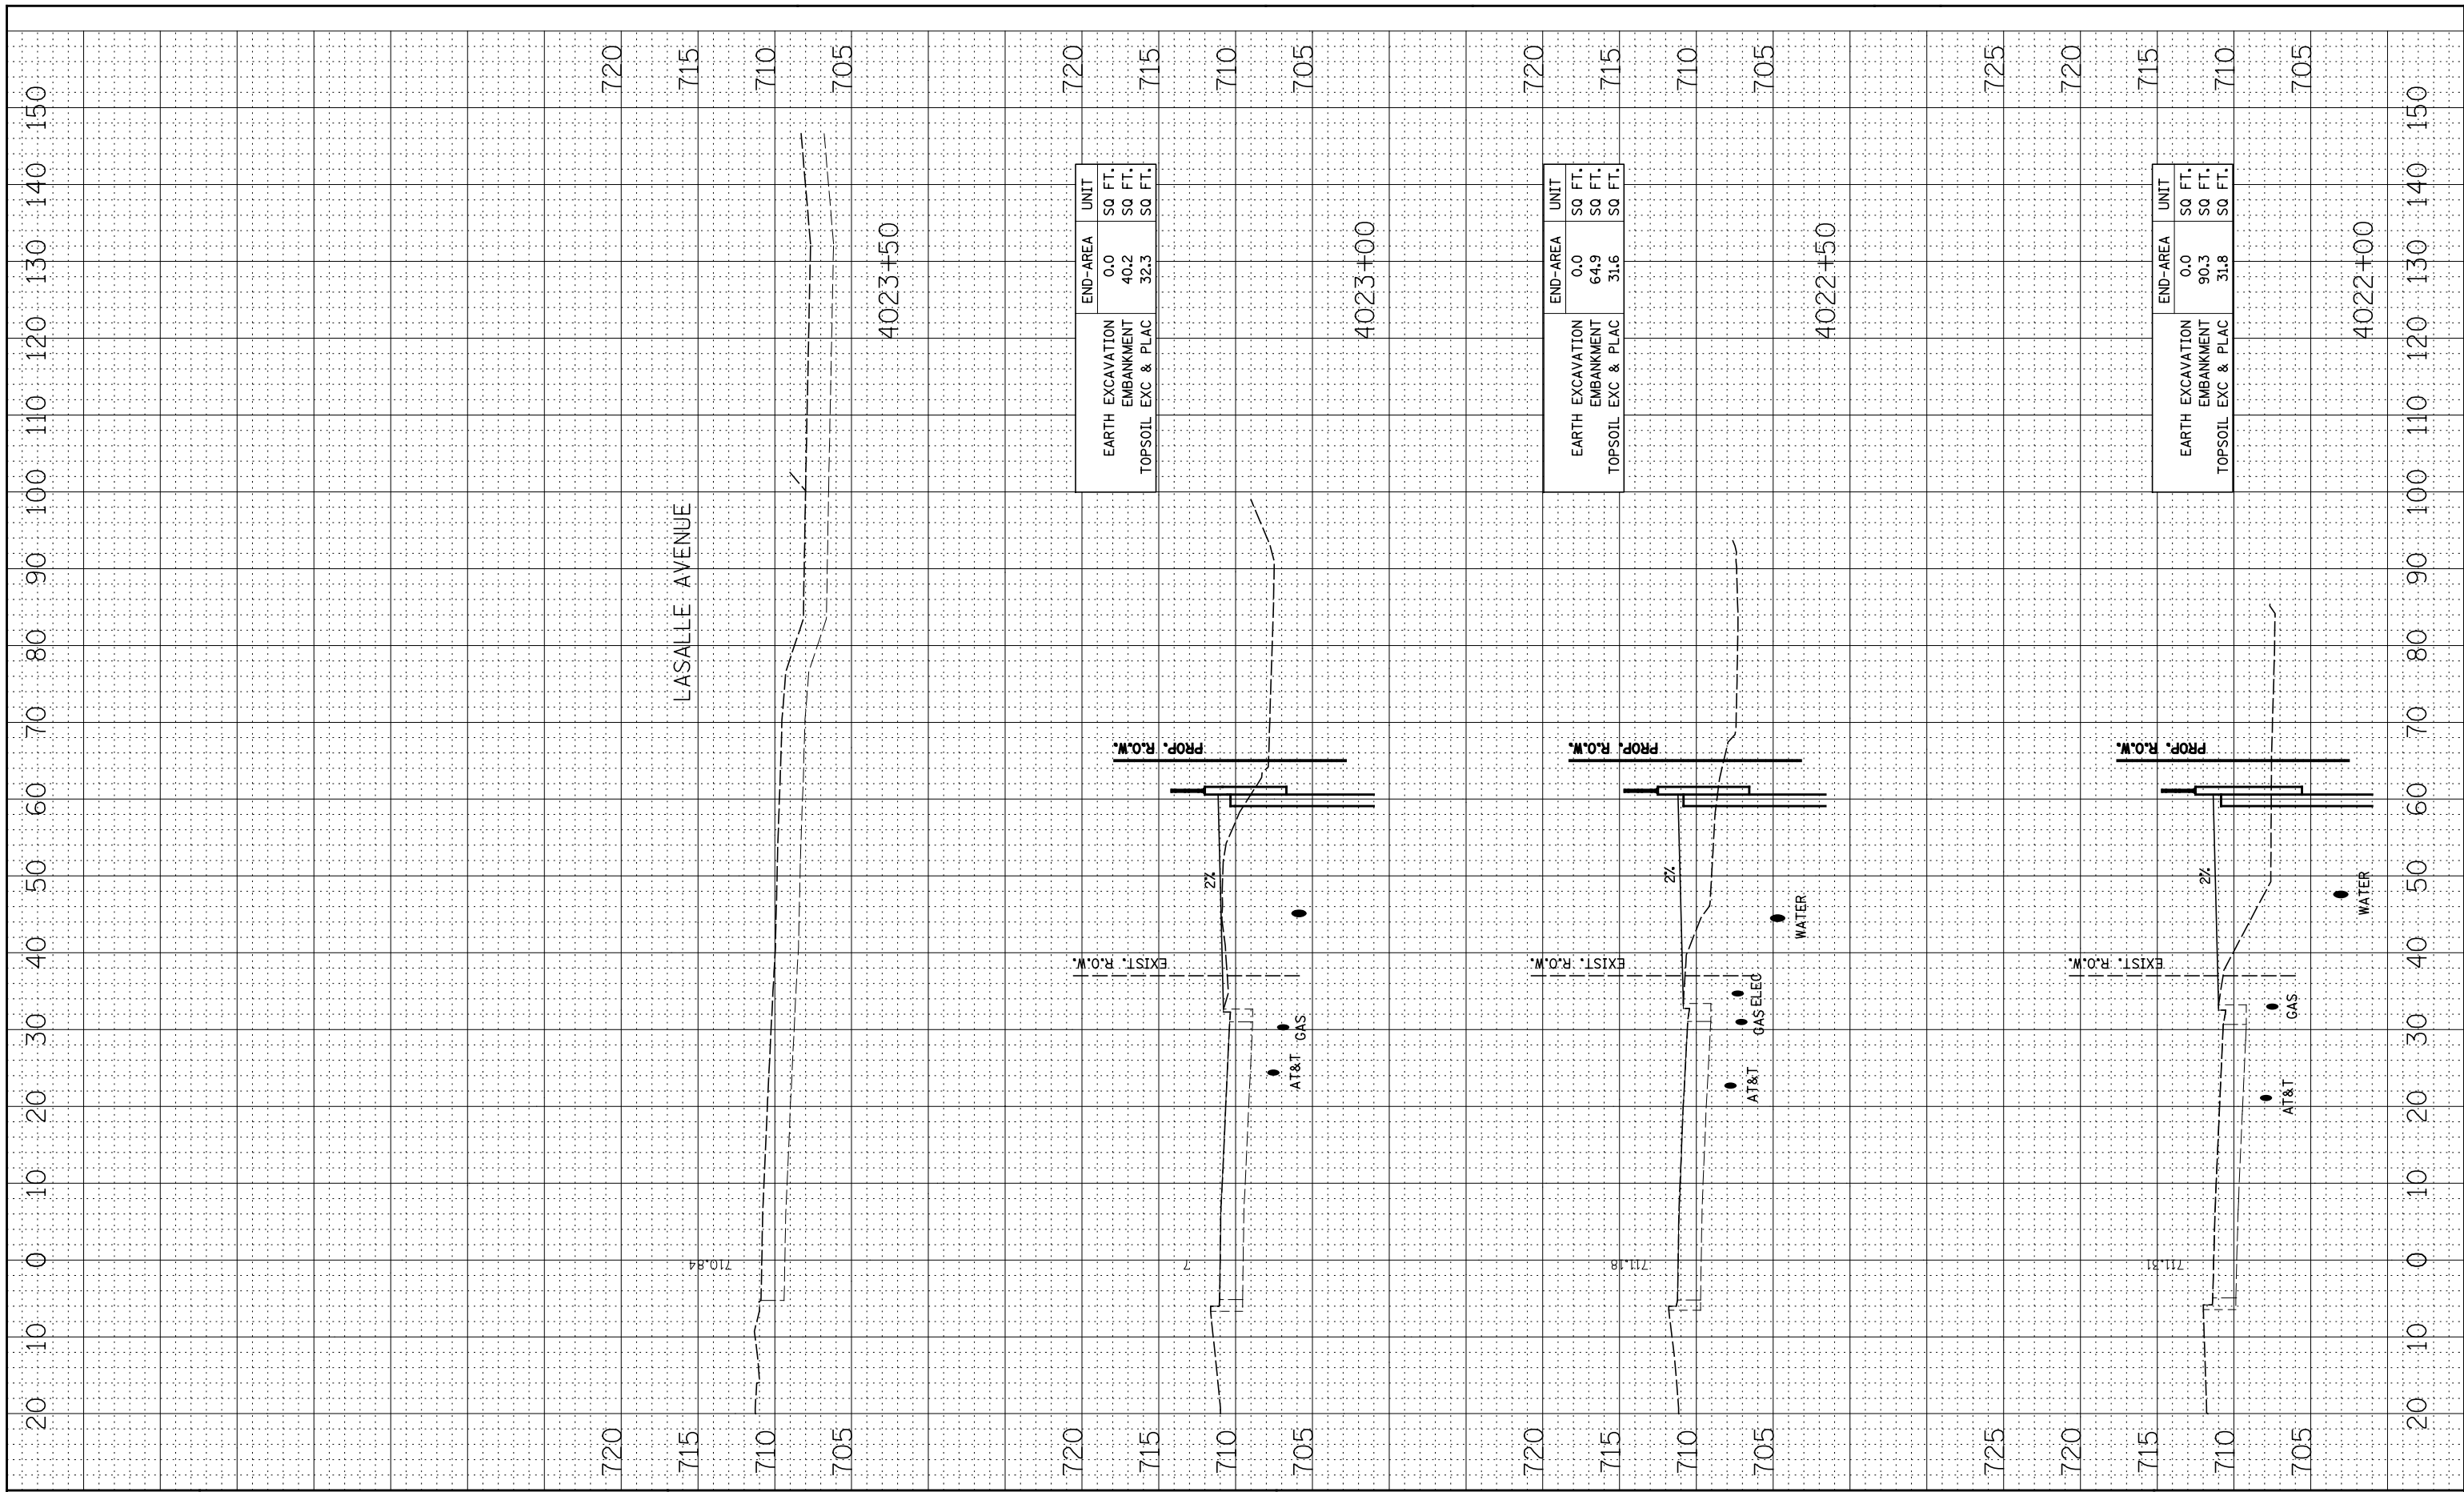

END-AREA	UNIT
EARTH EXCAVATION	SQ FT.
EMBANKMENT	SQ FT.
TOPSOIL EXC & PLAC	SQ FT.

END-AREA	UNIT
EARTH EXCAVATION	SQ FT.
EMBANKMENT	SQ FT.
TOPSOIL EXC & PLAC	SQ FT.

END-AREA	UNIT
EARTH EXCAVATION	SQ FT.
EMBANKMENT	SQ FT.
TOPSOIL EXC & PLAC	SQ FT.

FILE NAME =	USER NAME = #USER#	DESIGNED - NAV	REVISED -
#FILE#		DRAWN - KES	REVISED -
	PLOT SCALE = #SCALE#	CHECKED - PJO	REVISED -
	PLOT DATE = #DATE#	DATE - 05-11-12	REVISED -


**STATE OF ILLINOIS
DEPARTMENT OF TRANSPORTATION**

**SN 022-W052
CROSS-SECTIONS**

SCALE: SHEET NO. 4 OF 4 SHEETS STA. 4022+00 TO STA. 4023+50

F.A.P. RTE.	SECTION	COUNTY	TOTAL SHEETS	SHEET NO.
338	2011-036-I	DUPAGE	234	130
CONTRACT NO. 60P42				
FED. ROAD DIST. NO. ILLINOIS FED. AID PROJECT				





LEGEND

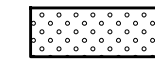

TOPSOIL EXCAVATION AND PLACEMENT
SEEDING, CLASS 2A
MULCH METHOD 2



SURFACE COURSE, MIX "D", N50, 2" OVER
HOT-MIX ASPHALT BASE COURSE, 4"

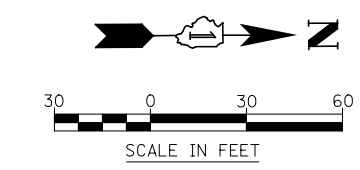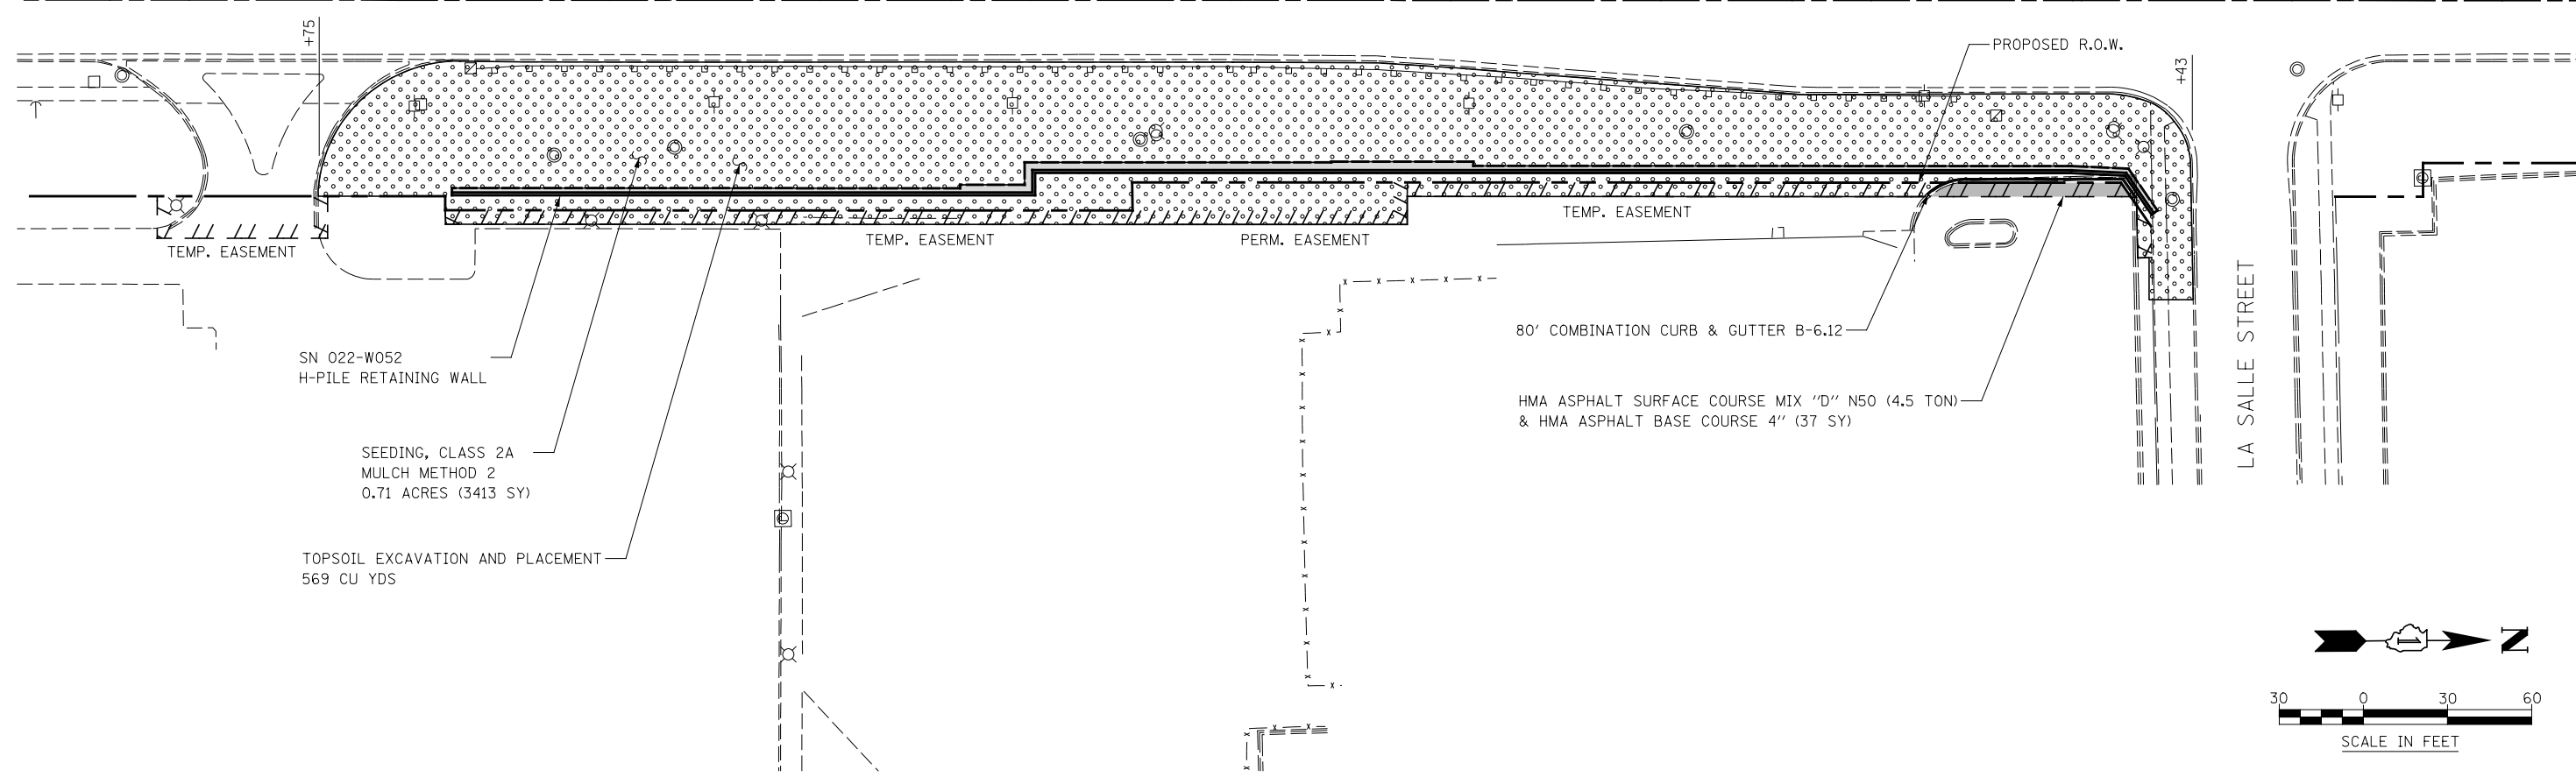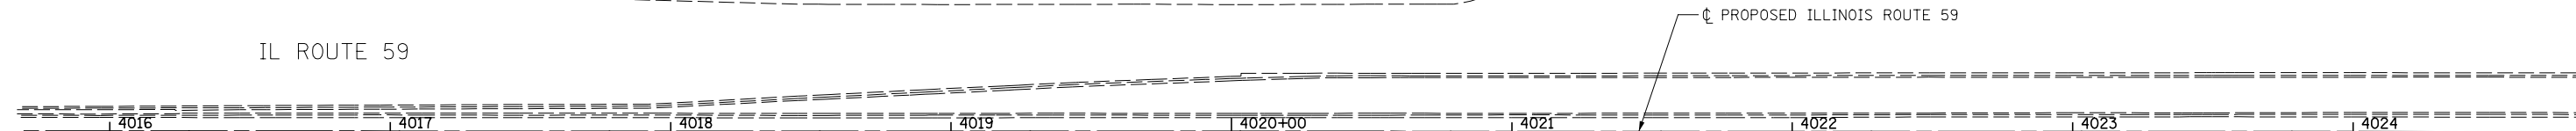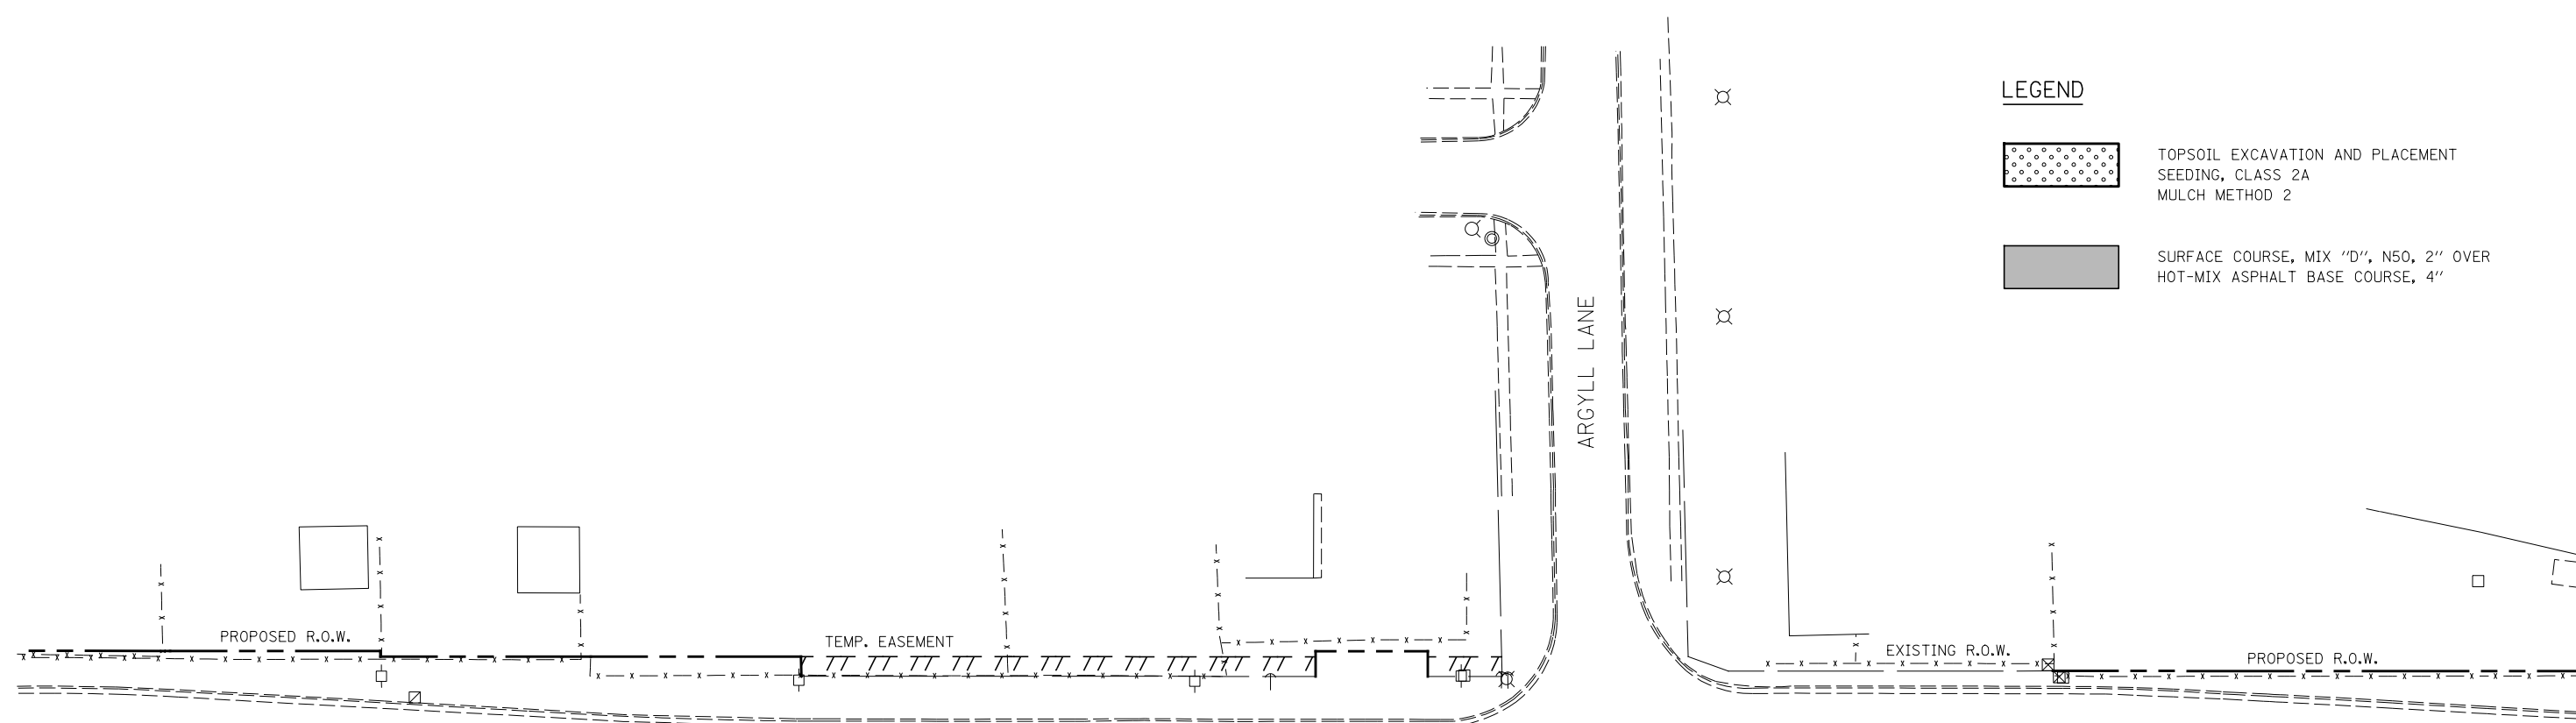

FILE NAME =	USER NAME = \$USER\$	DESIGNED <i>NAV</i>	REVISED
\$FILE\$		DRAWN <i>KES</i>	REVISED
	PLOT SCALE = \$SCALE\$	CHECKED <i>PJO</i>	REVISED
	PLOT DATE = \$DATE\$	DATE <i>05-11-12</i>	REVISED



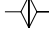

**STATE OF ILLINOIS
DEPARTMENT OF TRANSPORTATION**



SN 022-W052 - RESTORATION PLAN

SCALE: AS SHOWN SHEET NO. 1 OF 1 SHEETS STA. TO STA.

F.A.P. RTE.	SECTION	COUNTY	TOTAL SHEETS	SHEET NO.
338	2011-036-I	DUPAGE	234	131
CONTRACT NO. 60P42				
ILLINOIS FED. AID PROJECT				


LEGEND

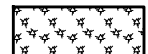-  TEMPORARY EROSION CONTROL SEEDING MULCH METHOD 2
-  INLET FILTERS
-  TEMPORARY DITCH CHECK
-  PERIMETER EROSION BARRIER

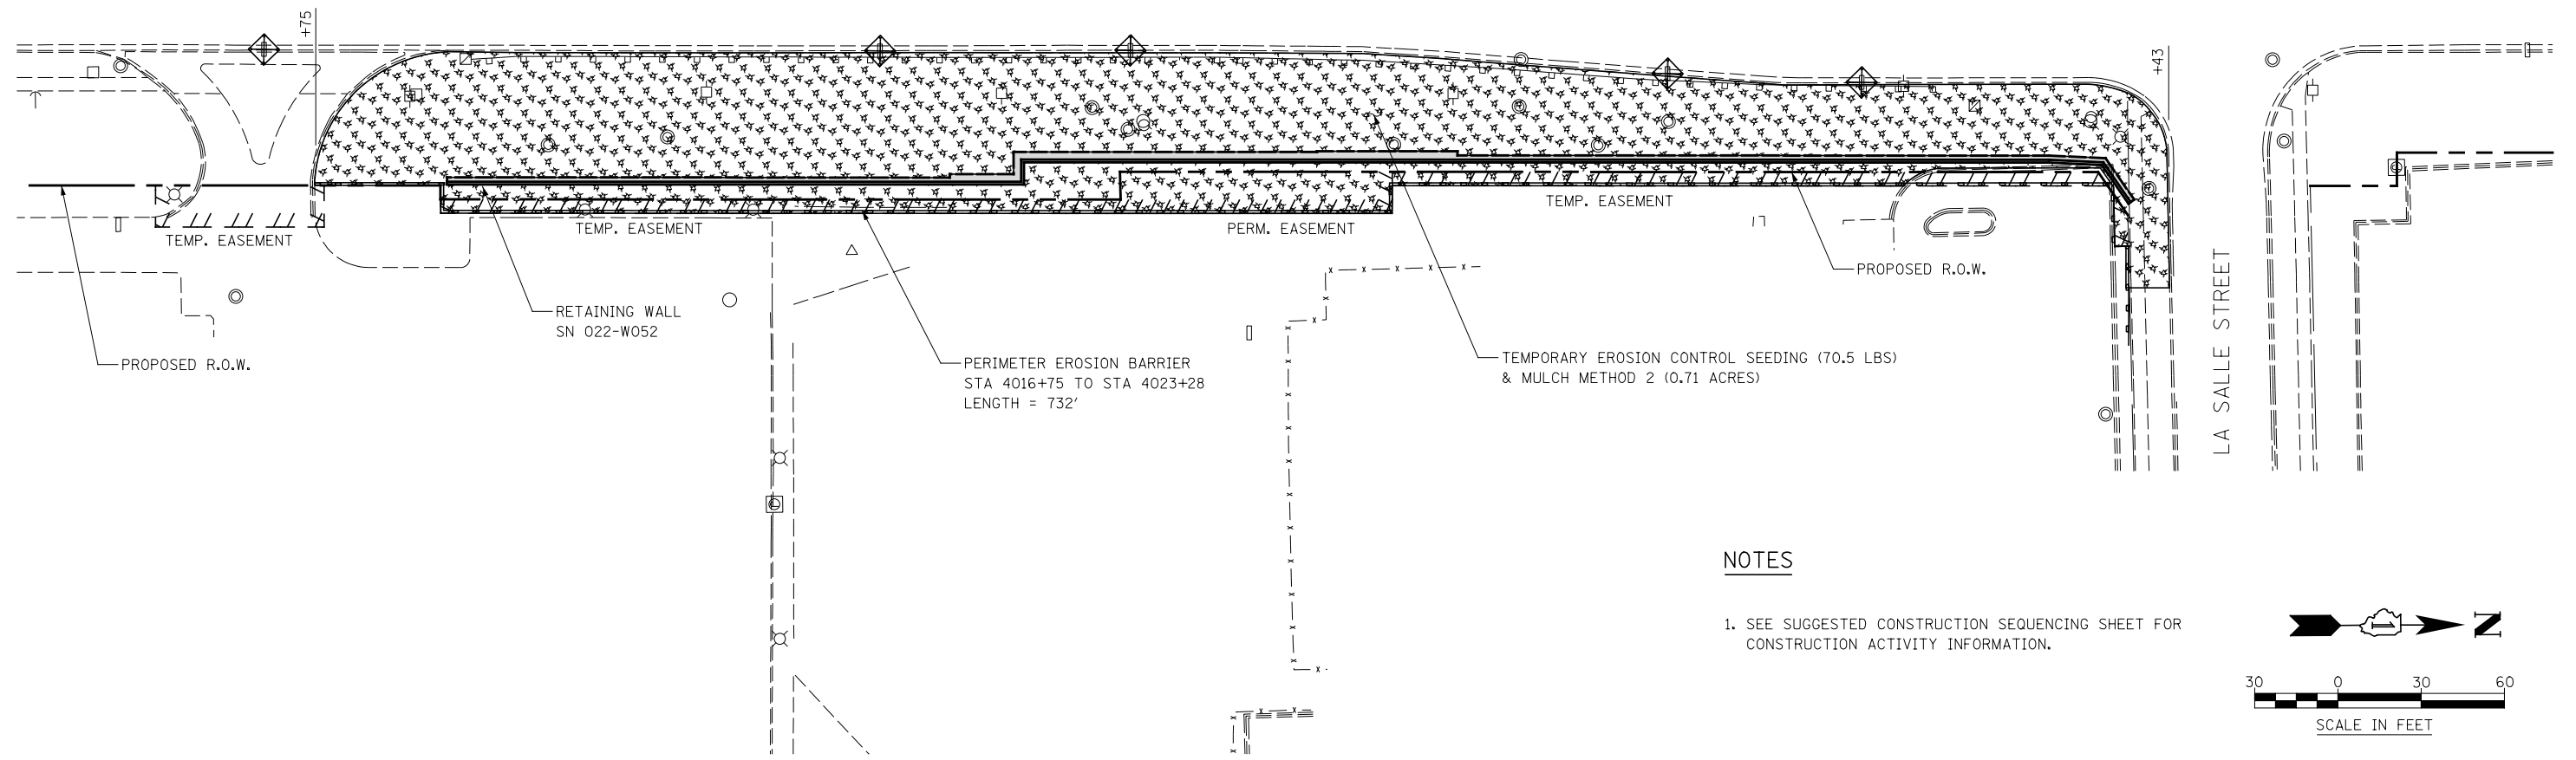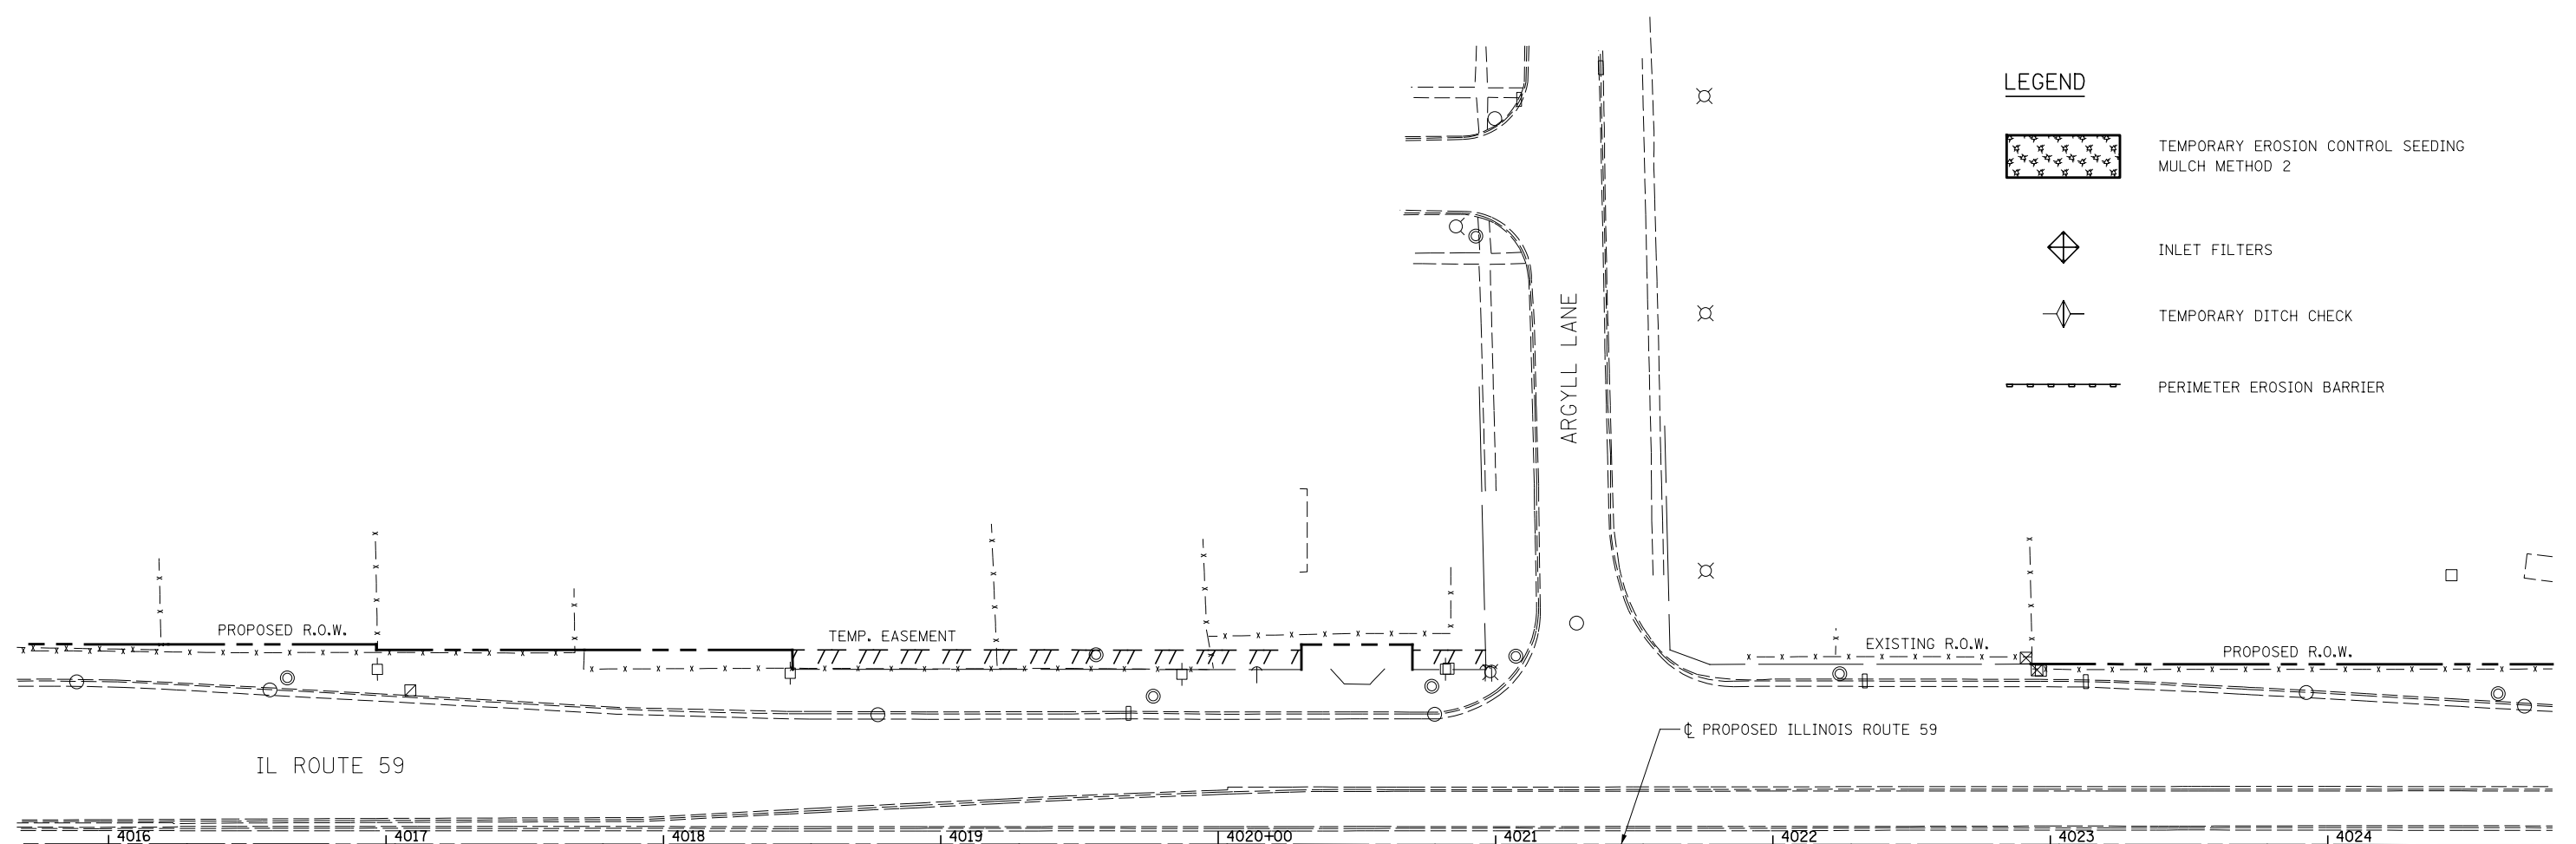

NOTES

- SEE SUGGESTED CONSTRUCTION SEQUENCING SHEET FOR CONSTRUCTION ACTIVITY INFORMATION.

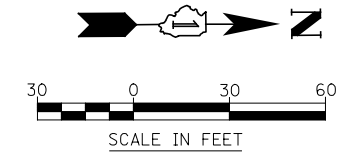

FILE NAME =	USER NAME = \$USER\$	DESIGNED NAV	REVISED	STATE OF ILLINOIS DEPARTMENT OF TRANSPORTATION	SN 022-W052 - EROSION CONTROL PLAN			F.A.P. RTE.	SECTION	COUNTY	TOTAL SHEETS	SHEET NO.
\$FILEL\$		DRAWN KES	REVISED					338	2011-036-I	DUPAGE	234	132
		CHECKED PJO	REVISED		CONTRACT NO. 60P42							
		DATE 05-11-12	REVISED		SCALE: AS SHOWN	SHEET NO. 1 OF 1 SHEETS	STA.	TO STA.	ILLINOIS FED. AID PROJECT			

**PROPOSED ELECTRIC CONSTRUCTION
ALONG RT 59 (DUPAGE COUNTY)
BETWEEN AURORA AV. AND FERRY RD.
IN THE CITY OF NAPERVILLE, STATE OF ILLINOIS**

F.A.P. RTE.	SECTION	COUNTY	TOTAL SHEETS	SHEET NO.
338/IL 59	2011-035-1	DUPAGE		
			CONTRACT 60P42	
FED.ROAD.DIST.NO.	ILLINOIS	FED. AID PROJECT		

SPECIAL NOTES

- 1) ALL UTILITIES MAY NOT BE SHOWN. CALL J.U.L.I.E. AT 1-800-892-0123 FOR FIELD LOCATIONS OF UNDERGROUND UTILITY LINES PRIOR TO ANY DIGGING OR CONSTRUCTION.
- 2) THE BRUSH AND TREES SMALLER THAN 6 INCHES IN DIAMETER LOCATED IN ROAD RIGHT OF WAY AND THAT IS PRESENT ALONG MOST OF THE PROPOSED ROUTE ARE TO BE TRIMMED OR REMOVED BY THE CONTRACTOR FOR CLEARANCE TO THE PROPOSED UNDERGROUND OR OVERHEAD ELECTRIC WIRES OR EQUIPMENT AS REQUIRED AND IS UNDER THE DIRECTION OF THE CITY OF NAPERVILLE (ELECTRIC) AND PER PERMIT. ALL TREE WORK IS TO BE PERFORMED BY LANDSCAPE CONTRACTOR PROVIDED BY THE CONTRACTOR. THIS WORK IS INCIDENTAL TO THE CONTRACT.
- 3) THE LOCATIONS OF UNDERGROUND UTILITIES AS SHOWN HEREON ARE BASED ON ABOVE GROUND STRUCTURES, J.U.L.I.E. PAINT MARKS, AND RECORD DRAWINGS. LOCATIONS OF UNDERGROUND UTILITIES/ STRUCTURES MAY VARY FROM LOCATIONS SHOWN HEREON. ADDITIONAL BURIED UTILITIES/STRUCTURES MAY BE ENCOUNTERED. NO EXCAVATIONS WERE MADE DURING THE SURVEY OF THIS WORK TO LOCATE BURIED UTILITIES/STRUCTURES. BEFORE EXCAVATIONS ARE BEGUN, THE FOLLOWING OFFICES SHOULD BE CONTACTED FOR VERIFICATION OF UTILITY TYPE AND FOR FIELD LOCATIONS: TELEPHONE, GAS, ELECTRIC, WATER, SEWER AND CABLE T.V. ALL LOCATED OR POSSIBLE UNDER GROUND FACILITIES SHALL BE EXPOSED ON ALL SIDES BY EXCAVATING TO THE KNOWN OR UNKNOWN UNDER GROUND FACILITY PRIOR TO DIGGING FOUNDATIONS, TRENCHES, HANDHOLES, MANHOLES AND VAULT ETC.
- 4) EXISTING ELECTRICAL FACILITIES SHALL BE DE-ENERGIZED PRIOR TO THE CONTRACTOR AND HIS SUBCONTRACTOR'S WORKERS COMMENCING WORK. THE CONTRACTOR IS TO CONTACT THE DEPARTMENT OF PUBLIC UTILITIES, ELECTRICAL DIVISION TO DE-ENERGIZED ALL NEARBY ELECTRICAL CIRCUITS AND FACILITIES. HOWEVER, IF CONDITIONS EXIST THAT REQUIRE THE CIRCUIT TO REMAIN ENERGIZED, THE CONTRACTOR SHALL PROCEED TO WORK WITH CONDUCTORS/CABLE, PER OSHA AND NESC REGULATIONS. THE CONTRACTOR SHALL COORDINATE THE PLANNED WORK SCHEDULE, CONSTRUCTION SEQUENCE, AND ANY OUTAGE REQUEST WITH THE DPU-E ELECTRICAL CONTRO AND THE ENGINEER.
- 5) CONTRACTOR SHALL EXERCISE EXTREME CAUTION WHILE WORKING IN, ON OR NEAR ELECTRICAL FACILITIES. HE AND ALL HIS SUBCONTRACTOR'S WORKERS SHALL FOLLOW APPROPRIATE OSHA LOCK-OUT/TAG-OUT PROCEDURES, CONFINED SPACE ENTRY, CPR AND CLEARANCE REQUIREMENTS FROM ENERGIZED EQUIPMENT.
- 6) CONNECTION TO EXISTING ELECTRICAL, FACILITIES SHALL BE ACCOMPLISHED ONLY BY CONTRACTOR'S EMPLOYEES AND HIS SUBCONTRACTOR'S EMPLOYEES THAT ARE TRAINED TO WORK ON HIGH VOLTAGE FACILITIES (138KV AND 34.5KV FACILITIES OR LOWER), IN ACCORDANCE WITH OSHA REGULATIONS, 29 CFR. A MINIMUM OF TWO SUCH QUALIFIED PERSONNEL SHALL BE PRESENT WHILE WORKING ON OR NEAR THESE FACILITIES.
- 7) THE CONTRACTOR SHALL ARRANGE FOR INSPECTION OF HIS AND HIS SUBCONTRACTOR'S WORK, BY DPU-E PERSONAL PRIOR TO STARTING AND UPON COMPLETION.
- 8) THE CONTRACTOR SHALL INSTALL ALL WORK (UNLESS OTHERWISE SPECIFIED) AT EACH LOCATION TO THE FINAL ELEVATIONS AND INTENDED PURPOSE. THE CONTRACTOR'S SURVEYOR TO OBTAIN THE ELEVATION AND PROVIDE THIS ELEVATION MARK TO THE CONTRACTOR WITH A FIELD STAKE AND ELEVATION WRITTEN ON IT. IN ADDITION, ELEVATION MARKS FOR ALL PROPOSED ELECTRICAL FACILITIES SHALL BE DETERMINED. THIS WORK IS CONSIDERED INCIDENTAL TO THE CONTRACT. THE SURVEYOR SHALL PERFORM ALL LAYOUT WORK, OFFSET STAKES, PROFILE WORK, VOLUMES, CALCULATIONS, FOUNDATION WORK, AS BUILT WORK, SLOPE, GRADE, BENCHMARK WORK, ELEVATION AND DIMENSIONS PER G.P.S. ALL WORK IS TO BE DOCUMENTED AND PROVIDED TO THE CITY.
- 9) ALL WORK SHALL MEET OSHA REGULATIONS OF LATEST ISSUE.
- 10) THE CONTRACTOR SHALL REMOVE ONLY THOSE TREES, BUSHES, FLOWERS, AND SHRUBS SO DESIGNATED ON THE PLANS OR AS DIRECTED BY THE ENGINEER, OR THOSE WHICH DIRECTLY INTERFERE WITH THE SAFETY OR QUALITY OF CONSTRUCTION PRACTICES. THE CONTRACTOR SHALL NOTIFY THE ENGINEER A MINIMUM OF TWO (2) DAYS IN ADVANCE OF REMOVAL OF TREES WHICH AFFECT SAFETY. THE CONTRACTOR SHALL EXERCISE EXTREME CARE WHEN WORKING NEAR EXISTING TREES AND SHRUBS TO AVOID DAMAGING THOSE NOT SCHEDULED FOR REMOVAL. THE CONTRACTOR SHALL PROTECT ALL OTHER TREES, BUSHES AND LANDSCAPING FEATURES. TREES REMOVED OR DAMAGED BY THE CONTRACTOR WHICH HAVE NOT BEEN DESIGNATED FOR REMOVAL, SHALL BE REPLACED BY THE CONTRACTOR AT NO COST TO THE CITY. TREES TO HAVE BRANCHES OR ROOTS PRUNED SHALL BE DONE IN A NEAT AND CLEAN MANNER (i.e., WITH A SAW OR SHEARS) AND NOT TORN OR BROKEN WITH CONSTRUCTION EQUIPMENT.

GENERAL NOTES

- 1) CONTRACTOR SHALL RESTRICT HIS OPERATIONS TO EASEMENTS AND ROAD RIGHT-OF-WAY AS SHOWN ON THE DRAWINGS.
- 2) PRIOR TO THE START OF CONSTRUCTION, THE CONTRACTOR SHALL ARRANGE TO HAVE ALL UNDERGROUND UTILITIES INCLUDING WATER, GAS, ELECTRIC, STORM SEWER, SANITARY SEWER, SPRINKLER SYSTEM, TRAFFIC CONTROL SIGNALS, TELEPHONE AND CABLE TV LOCATED AND SUITABLY MARKED. SHOULD A UTILITY BE IN CONFLICT WITH THE PROPOSED CONSTRUCTION, THE ENGINEER SHALL BE NOTIFIED AT ONCE. IF UTILITIES INTERFERE WITH THE CONSTRUCTION ALIGNMENT, THEY SHALL BE PROTECTED AT NO ADDITIONAL EXPENSE TO THE OWNER AND WITHOUT CLAIM BY THE CONTRACTOR FOR DELAYS DUE TO UTILITY LINES ENCOUNTERED. THE CITY OF NAPERVILLE SHALL BE NOTIFIED 96 HOURS IN ADVANCE OF WATERMAIN, SANITARY, AND ELECTRIC CROSSINGS.
- 3) INFORMATION ON THE PLANS REGARDING UNDERGROUND UTILITIES IS TAKEN FROM THE BEST AVAILABLE RECORDS, BUT IS NOT REPRESENTED AS BEING ENTIRELY CORRECT OR COMPLETE. THE CONTRACTOR SHALL NOTIFY OPERATING AGENCY IN ADVANCE OF CROSSING OVER OR UNDER ANY UTILITIES SHOWN ON THE PLANS. THE CONTRACTOR SHALL NOTIFY OPERATING AGENCY AND ENGINEER IMMEDIATELY UPON DISCOVERY OF ANY UTILITY NOT SHOWN ON THE PLANS. ANY UTILITIES DAMAGED BY THE CONTRACTOR'S OPERATIONS SHALL BE REPAIRED AT THE CONTRACTOR'S EXPENSE.
- 4) MSDS SHEETS ARE REQUIRED ON THE JOB SITE FOR ALL MATERIALS USED.
- 5) THE CONTRACTOR SHALL UNDER NO CIRCUMSTANCES DISTURB OR REMOVE A TREE UNLESS SPECIFICALLY DIRECTED TO DO SO ON THE PLANS OR BY THE ENGINEER. CONTRACTOR SHALL NOTE PROTECTION OF ALL TREES, SHRUBS ETC., ALONG THE LINE OF CONSTRUCTION IS REQUIRED. WRITTEN PERMISSION FROM THE OWNER IS REQUIRED PRIOR TO ANY TREE OR SHRUB REMOVAL.
- 6) THE CONTRACTOR SHALL PROTECT ALL PROPERTY PINS AND SURVEY MONUMENTS AND SHALL RESTORE ANY WHICH ARE DISTURBED BY HIS OPERATIONS AT NO ADDITIONAL COST TO THE CONTRACT.
- 7) ALL FIELD TILE, CULVERTS, GRATES, DRAIN PIPE, ENCOUNTERED DURING CONSTRUCTION OPERATIONS AND DAMAGED SHALL BE REPAIRED WITH NEW MATERIALS PER THE SPECIFICATIONS. A RECORD OF THE LOCATION OF ALL FIELD TILE, CULVERTS OR DRAIN PIPE ENCOUNTERED SHALL BE KEPT BY THE CONTRACTOR AND TURNED OVER TO THE ENGINEER UPON COMPLETION OF THE PROJECT. ALL FIELD REPAIRS SHALL BE AT CONTRACTOR'S EXPENSE.
- 8) ANY PAVEMENT OR PAVEMENT STRIPING DAMAGED OR REMOVED DURING CONSTRUCTION OPERATIONS, OTHER THAN THE AREAS SHOWN ON DRAWING 56270 SHEETS 1 THRU 73, SHALL BE REPLACED IN KIND BY THE CONTRACTOR AT NO COST TO THE CITY.
- 9) ALL EXISTING UTILITY FACILITIES SHALL BE KEPT IN SERVICE DURING CONSTRUCTION EXCEPT WHERE PERMISSION IS GRANTED OTHERWISE BY THE OWNER. ALL VALVE BOXES AND VALVE VAULTS, ELECTRIC MANHOLES, SWITCH GEARS OR TRANSFORMERS SHALL REMAIN ACCESSIBLE TO THE RESPECTIVE UTILITY COMPANY.
- 10) THE CONTRACTOR SHALL TAKE THE NECESSARY PRECAUTIONS TO PROTECT EXISTING FENCE, POSTS, AND GATES DURING CONSTRUCTION. ALL WORK AND MATERIAL NECESSARY TO REPLACE EXISTING FENCE, POSTS, AND GATES DAMAGED BECAUSE OF NONCOMPLIANCE WILL BE AT CONTRACTOR'S OWN EXPENSE, AND NO EXTRA COMPENSATION WILL BE ALLOWED. ALL REPLACEMENT MATERIALS ARE TO BE NEW.
- 11) ALL EXISTING TRAFFIC SIGNS, ELECTRIC UNDERGROUND CABLES, DUCTS, FENCES, GUARDRAILS, STREET LIGHTS, STREET SIGNS, ETC., WHICH INTERFERE WITH CONSTRUCTION OPERATIONS AND NOT NOTED FOR REMOVAL OR DISPOSAL SHALL BE MAINTAINED BY THE CONTRACTOR OR TEMPORARILY RELOCATED. THIS IS CONSIDERED INCIDENTAL TO THE CONTRACT AND NO ADDITIONAL COMPENSATION SHALL BE ALLOWED. DAMAGE TO THESE ITEMS SHALL BE REPAIRED BY THE CONTRACTOR AT HIS OWN EXPENSE. IN ADDITION, ALL MAILBOXES THAT INTERFERE WITH CONSTRUCTION SHALL BE SIMILARLY RELOCATED AT NO ADDITIONAL COST. CONTRACTOR SHALL PROVIDE TEMPORARY TRAFFIC, REGULATORY, AND SAFETY SIGNAGE THAT IS DISTURBED BY CONSTRUCTION ACTIVITIES. SUCH COST SHALL BE CONSIDERED INCIDENTAL TO THE COST OF TRAFFIC CONTROL.

THE COST OF A SUFFICIENT NUMBER OF FLAGGERS AND ELECTRONIC MESSAGE BOARDS TO DIRECT TRAFFIC IS INCLUDED AND IS PART OF TRAFFIC CONTROL PAY ITEM.
- 12) THE CONTRACTOR SHALL MAINTAIN ACCESS TO ALL BUSINESS, THE CONSTRUCTION SITE, RESIDENCES, AGRICULTURE AREAS, AND ALL OTHER SITES NECESSARY FOR THE MAINTENANCE OF COMMERCE AND SAFETY AT ALL TIMES. THE CONTRACTOR MAY PLACE TEMPORARY PLATES OR OTHER SUCH DEVICES IN A SAFE AND ACCESSIBLE MANOR TO TEMPORARILY MAINTAIN ACCESS. IN NO CASE MAY MORE THAN ONE POINT OF ACCESS TO ANY RESIDENCE, BUSINESS OR SITE BE UNDER CONSTRUCTION SIMULTANEOUSLY. SHOULD A PROPERTY HAVE ONLY ONE POINT OF ACCESS, THE CONTRACTOR SHALL STAGE HIS WORK SO AS TO ONLY OBSTRUCT ONE HALF OF THIS ENTRANCE AT ANY TIME AND SHALL MAINTAIN ACCESS TO HIS PROPERTY AT ALL TIME. COSTS FOR MAINTAINING ACCESS SHALL BE CONSIDERED INCIDENTAL TO THE CONTRACT (SEE NOTE 28).
- 13) CONTRACTOR SHALL PLACE AND MAINTAIN TEMPORARY 2" TO 6" HMA PATCHES ACROSS ALL PAVEMENT REPAIR AREAS PRIOR TO THE INSTALLATION OF THE FINAL PAVEMENT REPAIRS. COSTS SHALL BE INCIDENTAL TO THE ASSOCIATED PAY ITEMS. PLATES MAY BE PLACED IN LIEU OF HMA PATCHES AT THE DISCRETION OF THE FIELD ENGINEER. PLATES ARE TO BE RAMPED AND PINNED IN PLACE TO PREVENT MOVEMENT AND CAPABLE OF SUPPORTING HS-20 LOADING. COUNTER SINKING OF PLATES IS REQUIRED.
- 14) THE CONTRACTOR SHALL REMOVE AND REPLACE ALL SIGNS OF ALL TYPES, SIZES, AND OWNERSHIP NECESSARY TO COMPLETE INDICATED WORK. COST OF THIS WORK SHALL BE INCIDENTAL TO THE WORK AND CONTRACT.
- 15) THE CONTRACTOR SHALL BRACE ALL STREET LIGHT POLES, DPU-E POLES, CABLE TV OR COMED POLES WITHIN THE VICINITY OF THE INDICATED WORK. COST OF THIS WORK SHALL BE INCIDENTAL TO THE WORK AND CONTRACT. ANY DELAY DUE TO OBTAINING PERMISSION OR A PERMIT FROM THE OWNER OF THE FACILITY TO SUPPORT OR RELOCATE OF ANY EXISTING FACILITY IS AT THE CONTRACTOR'S EXPENSE.
- 16) THE CONTRACTOR SHALL CONTACT THE CITY OF NAPERVILLE'S TRANSPORTATION ENGINEERING AND DEVELOPMENT BUSINESS GROUP 48 HOURS PRIOR TO PERFORMING WORK IN OR AROUND THE WORK AREA WHERE DETECTOR LOOPS OR TRAFFIC SIGNALS HAVE THE POSSIBILITY OF BEING ENCOUNTERED AND/OR DAMAGED. THE CONTRACTOR SHALL CONTACT THE DUPAGE COUNTY DEPARTMENT OF TRANSPORTATION WITH THE SAME INFORMATION.

CONTINUED ON PAGE 2

PROJECT TITLE					ROUTE 59 ROAD IMPROVEMENTS				
PROJECT DESCRIPTION					GENERAL NOTES				
ENGINEER		DRAFTING DATE		MAP #		SCALE			
BCC		5-11-12		4211,4212,4223		N.T.S.			
GIS DESIGN BY	DRAFTED BY	REVISIONS DATE		AT&T JOINT AGREEMENT #		PROJECT #			
DL	PSM			N/A		EU-12			
CHECKED BY		APPROVED BY		CAD FILE		SHEET #			
				0060648001GN1.DWG		1 OF 63			
Naperville					Department of Public Utilities Electric Division				
					WORK REQUEST # 60468				

PROPOSED ELECTRIC CONSTRUCTION
ALONG RT 59 (DUPAGE COUNTY)
BETWEEN AURORA RD. AND
FERRY RD. AT THE DUPAGE RIVER
IN THE CITY OF NAPERVILLE, STATE OF ILLINOIS

F.A.P. RTE.	SECTION	COUNTY	TOTAL SHEETS	SHEET NO.
338/IL 59	2011-035-1	DUPAGE		
			CONTRACT 60P42	
FED.ROAD.DIST.NO.	ILLINOIS	FED. AID PROJECT		

GENERAL NOTES (CONTINUED)

- 17) THE CONTRACTOR SHALL PROVIDE TIME DURING CONSTRUCTION OPERATIONS FOR THE LANDSCAPER TO REMOVE, PRESERVE, AND REINSTALL ANY BUSH OR SHRUB. EVERGREENS, BUSHES, SHRUBS, VINES, AND SEEDINGS SHALL BE DUG UP WITH CARE, AVOIDING INJURY TO THE PLANTS OR LOSS OR DAMAGE OF THE ROOTS. IMMEDIATELY AFTER DIGGING, ROOTS SHALL BE PROTECTED AGAINST DRYING OUT AND FREEZING BY WRAPPING ROOT SYSTEM IN BURLAP, REMOVED VEGETATION SHALL BE PLACED IN TEMPORARY STORAGE EITHER ON SITE OR AT OTHER APPROVED LOCATIONS. IF LANDSCAPER IS UNABLE TO REUSE EXISTING VEGETATION, HE SHALL REPLACE WITH SAME SIZE AND SPECIES AT HIS OWN EXPENSE. COST OF THIS WORK SHALL NOT BE PAID FOR SEPARATELY BUT SHALL BE CONSIDERED INCIDENTAL TO THE LANDSCAPING CONTRACT AND IS PART OF THE RESTORATION (PAY ITEM).
- 18) DURING CONSTRUCTION OPERATIONS, THE CONTRACTOR IS NOT ALLOWED TO PERMANENTLY STOCK PILE MATERIAL ON SITE. CONTRACTOR SHALL SUPPLY LIGHTED BARRICADES AROUND ALL STOCKPILES AND IS RESPONSIBLE FOR THE SECURITY OF ALL THE MATERIALS STORED OFF SITE.
- 19) ALL RESTORATION IS DIRECTED BY THE CITY OR COUNTY PERMIT WHICH THE CONTRACTOR IS REQUIRED TO OBTAIN PRIOR TO STARTING WORK. ALL REQUESTS REQUIRED BY THE CITY SHALL BE HONORED AND COMPLETED BY THE LANDSCAPER AT NO EXPENSE TO THE CITY. THE LANDSCAPE CONTRACTOR SHALL PERFORM ALL RESTORATION PER CITY OF NAPERVILLE SPECIFICATIONS. THE CONTRACTOR SHALL PERFORM ALL WORK TO THE MOST RESTRICTIVE REQUIREMENT OF THE GOVERNING BODIES. THIS IS PART OF THE RESTORATION PRICE (PAY ITEM). SEE 56270-1000, TRANSMISSION LINE LANDSCAPING OVERHEAD AND UNDER GROUND FOR PROJECT GENERAL REQUIREMENTS.
- 20) ALL IDENTIFIED OR SUSPECTED UNDERGROUND FACILITIES OR OBSTRUCTIONS SHALL BE LOCATED BY HAND DIGGING TO A DEPTH OF 8 FEET, WIDTH OF 4 FEET AND LENGTH OF 5 FEET AND IDENTIFIED BY NAME AND SIZE. THIS IS PART OF THE CONDUIT AND OR MANHOLE (PAY ITEMS).
- 21) WHEN REPAIRING, REPLACING, OR INSTALLING ITEMS, THE ITEMS SUPPLIED BY THE CONTRACTOR SHALL BE NEW AND NOT USED.

- 22) THE COST TO LOCATE SUPPORT, MOVE AND PROTECT THE UTILITIES (SHOWN ON THE DRAWINGS) SHALL NOT BE PAID FOR SEPARATELY BUT SHALL BE CONSIDERED INCIDENTAL TO WORK.
- 23) ALL MATERIALS REMOVED DURING THE CONSTRUCTION OF THE PROJECT AND DESIGNATED ON THE PLANS OR BY THE CITY AS SALVAGED MATERIALS SHALL BE REMOVED, CLEANED, AND STACKED AT THE DESIGNATED CITY OF NAPERVILLE SITE. ALL UNUSED MATERIALS SHALL BE THE PROPERTY OF THE CITY.
- 24) ALL MATERIALS REMOVED BY THE CONTRACTOR, SUCH AS POLES, CONDUIT, HANDHOLES, MANHOLES, RISERS, EXCAVATED MATERIALS, WIRE, STEEL POLES, FOUNDATIONS, ANCHORS, GUYS, CROSS ARMS, INSULATOR GROUND WIRES, CONDUCTORS, AND HARDWARE AND DESIGNATED ON THE PLAN FOR REMOVAL SHALL BE REMOVED TO AN APPROPRIATE DUMP SITE FOR WASTE. DUMP TICKETS RECEIVED AND RETURNED TO THE CITY. ALL AREAS LEFT DAMAGED BY THE REMOVAL SHALL BE REPAIRED, REPLACED OR INSTALLED TO FINISHED GRADE. THIS PART OF THE WORK IS COVERED IN THE COST OF RESTORATION.
- 25) THE CITY OF NAPERVILLE DOES NOT GUARANTEE A SEQUENCE OF WORK OR AVAILABILITY OF THE WORK AREA OR QUANTITY OF WORK.
- 26) ALL WORK WILL OCCUR DURING ALL 4 SEASONS OF THE YEAR. THEREFORE, THERE SHALL BE NO COMPENSATION PAID BY THE CITY FOR SNOW, ICE, RAIN, WIND, OR HOT OR COLD WEATHER. IT IS ASSUMED THE CONTRACTOR HAS INCLUDED THESE ITEMS IN THE PRICING.
- 27) THIS WORK SHALL BE PREFORMED IN ACCORDANCE WITH SECTION 202 OF THE IDOT STANDARDS SPECIFICATIONS EXCEPT AS HEREIN. THE CONTRACTOR IS ADVISED THAT JOINTED, FISSURED ROCK, LARGE BOULDERS (12 INCHES OR LARGER) AND VERY TOUGH STRATIFIED ROCK/SHALE MAY EXISTS FROM 1'-0" TO 10'-0" BELOW GRADE AND SOLID ROCK MAY EXISTS FROM 10'-0" TO 20'-0" BELOW GRADE AND REQUIRES ADDITIONAL WORK AND IS INCLUDED IN THE COST OF INSTALLING THE DUCT BANK WORK OR HAND HOLE WORK, MANHOLE WORK, VAULT WORK OR RISER WORK. THE CONTRACTOR WILL EXCAVATE IN ROCK ACCORDING TO SECTION 502 OF THE STANDARD SPECIFICATIONS FOR ROCK EXCAVATION FOR STRUCTURES. THE BOTTOM OF THE TRENCH SHALL BE LINED WITH 2 INCHES OF FA-2 MATERIALS OR CA-6 MATERIALS TO FORM A BEDDING FOR THE DUCT PACKAGE AND IS INCIDENTAL TO THE COST.

SEE SPECIFICATION C30-1950 FOR HDD ROCK DEFINITION AND METHOD OF PAYMENT, IS COVERED BY SECTION 109.04 STANDARDS SPECIFICATIONS THIS PRICE SHALL BE FULL COMPESATION FOR FURNISHING ALL MATERIALS; FOR ALL PREPARATION, EXCAVATION AND DISPOSAL OF ROCK, AND FOR ALL LABOR, EQUIPMENT, TOOLS AND INCIDENTALS NECESSARY TO COMPLETE THE ITEM. DUMP TICKETS ARE REQUIRED.

- 28) THE CONTRACTOR SHALL COORDINATE AND PERFORM ALL WORK OR AS MUCH AS POSSIBLE USING TRAFFIC CONTROL AND LANE CLOSURES AS REQUIRED FOR THE BRIDGE WORK. ALL ELECTRICAL WORK REQUIRING A LANE CLOSURE OR TRAFFIC CONTROL SHALL ONLY BE ACCEPTED IF THE BRIDGE WORK IS NOT INVOLVED. THE CONTRACTOR TO INCLUDE THESE COSTS UNDER THE TRAFFIC CONTROL (PAY ITEM).

29) THE CONTRACTOR SHALL, DURING THE PROGRESS OF THE JOB, NOTE ANY AND ALL CHANGES OR DEVIATIONS FROM THE ORIGINAL DRAWING. THE CONTRACTOR SHALL PROVIDE THE ENGINEER WITH A COPY OF ALL RECORDED DIMENSIONS AND ELEVATIONS. ALL MANHOLES, HAND HOLES VAULTS OR RISERS, BENDS AND FITTINGS, SHALL BE TIED TO A MINIMUM OF TWO PERMANENT VISIBLE POINTS (I.E. PROPERTY IRONS AND BUILDINGS). DEVIATIONS FROM CHANGES IN GRADE SHALL ALSO BE NOTED ON THE RECORD DRAWINGS.

- 30) WATER MAIN VALVES, INCLUDING TAP VALVES, ADJACENT TO AN EXISTING WATER MAIN, AND EXISTING WATER MAIN VALVES SHALL ONLY BE OPERATED BY THE CITY OF NAPERVILLE, DEPARTMENT OF PUBLIC UTILITIES CEE/CM DIVISION PERSONNEL WITH 48-HOURS NOTICE (MONDAY-FRIDAY) 630-420-4122.

- 31) THE CONTRACTOR PERFORMING THE ELECTRICAL WORK FOR THE CITY OF NAPERVILLE SHALL BE A QUALIFIED ELECTRICAL CONTRACTOR WITH NO LESS THAN SEVEN YEARS EXPERIENCE IN THE ELECTRICAL POWER DISTRIBUTION FIELD (34KV AND BELOW ELECTRICAL WORK).

THE CONTRACTOR SHALL PROVIDE AT LEAST FOUR REFERENCES. EACH REFERENCES MUST INCLUDE THE FOLLOWING:
A) CONTRACT NAME AND PHONE NUMBER.
B) SCOPE OF WORK.
C) CONTRACT DOLLAR AMOUNT FOR ELECTRICAL DUCT, MANHOLE AND SWITCH GEAR INSTALLATION WORK COMPLETED FOR EACH REFERENCE.


- 32) CONTRACTOR IS ADVISED THE AREA HAS PRESENTLY INSTALLED A 138kv SINGLE CIRCUIT STEEL POLE LINE THAT SHALL REMAIN ENERGIZED DURING THE ENTIRE PROJECT. CONTRACTOR SHALL OBSERVE ALL OSHA SAFETY REQUIREMENTS IN THE WORK AREA.

UTILITY CONTACTS:

CITY OF NAPERVILLE:

NDPU-	WATER AND WASTEWATER MR. PAT EYRE (630) 420-4122
NDPU-	ELECTRIC MRS. LUCY HYNES (630) 305-5375
NDPW-	PUBLIC WORKS MR. DAN VORREN (630) 548-2981
TED-	TRANSPORTATION, ENGINEERING & DEVELOPMENT BUSINESS GROUP MR. BILL NOVAK (630) 420-6704
<u>OTHER UTILITIES:</u>	
SBC AMERITECH AT&T-	MR. GREG LAWERENCE (630) 462-5846 MS. DONNA SZPYTEK (630) 941-4223
COMCAST-	MR. BOB SCHULTER (630) 600-6347
COMMONWEALTH EDISION-	MR. JOE STACHO OR TOM MUNAR (630) 424-5704
NICOR GAS-	MS. CONSTANCE LANE (630) 983-8676 X3830
WIDE OPEN WEST-	MR. TOM JEBENS (630) 536-3153 MR. JIM PIRTANO (630) 669-2707
DUPAGE COUNTY PERMIT ADMINISTRATOR-	MR. ROBERT KOLAR 421 N. COUNTY FARM RD. WHEATON, IL 60187 (630) 407-6900

PROJECT TITLE				ROUTE 59 ROAD IMPROVEMENTS			
PROJECT DESCRIPTION				GENERAL NOTES			
ENGINEER	DRAFTING DATE	MAP #	SCALE				
BCC	5-11-12	4211,4212,4223	N.T.S.				
GIS DESIGN BY	DRAFTED BY	REVISIONS DATE	AT&T JOINT AGREEMENT #	PROJECT #			
DL	PSM		N/A	EU-12			
CHECKED BY	APPROVED BY	CAD FILE	SHEET #				
		0060648001GN2.DWG	2 OF 63				
Naperville		Department of Public Utilities Electric Division		WORK REQUEST #		60468	

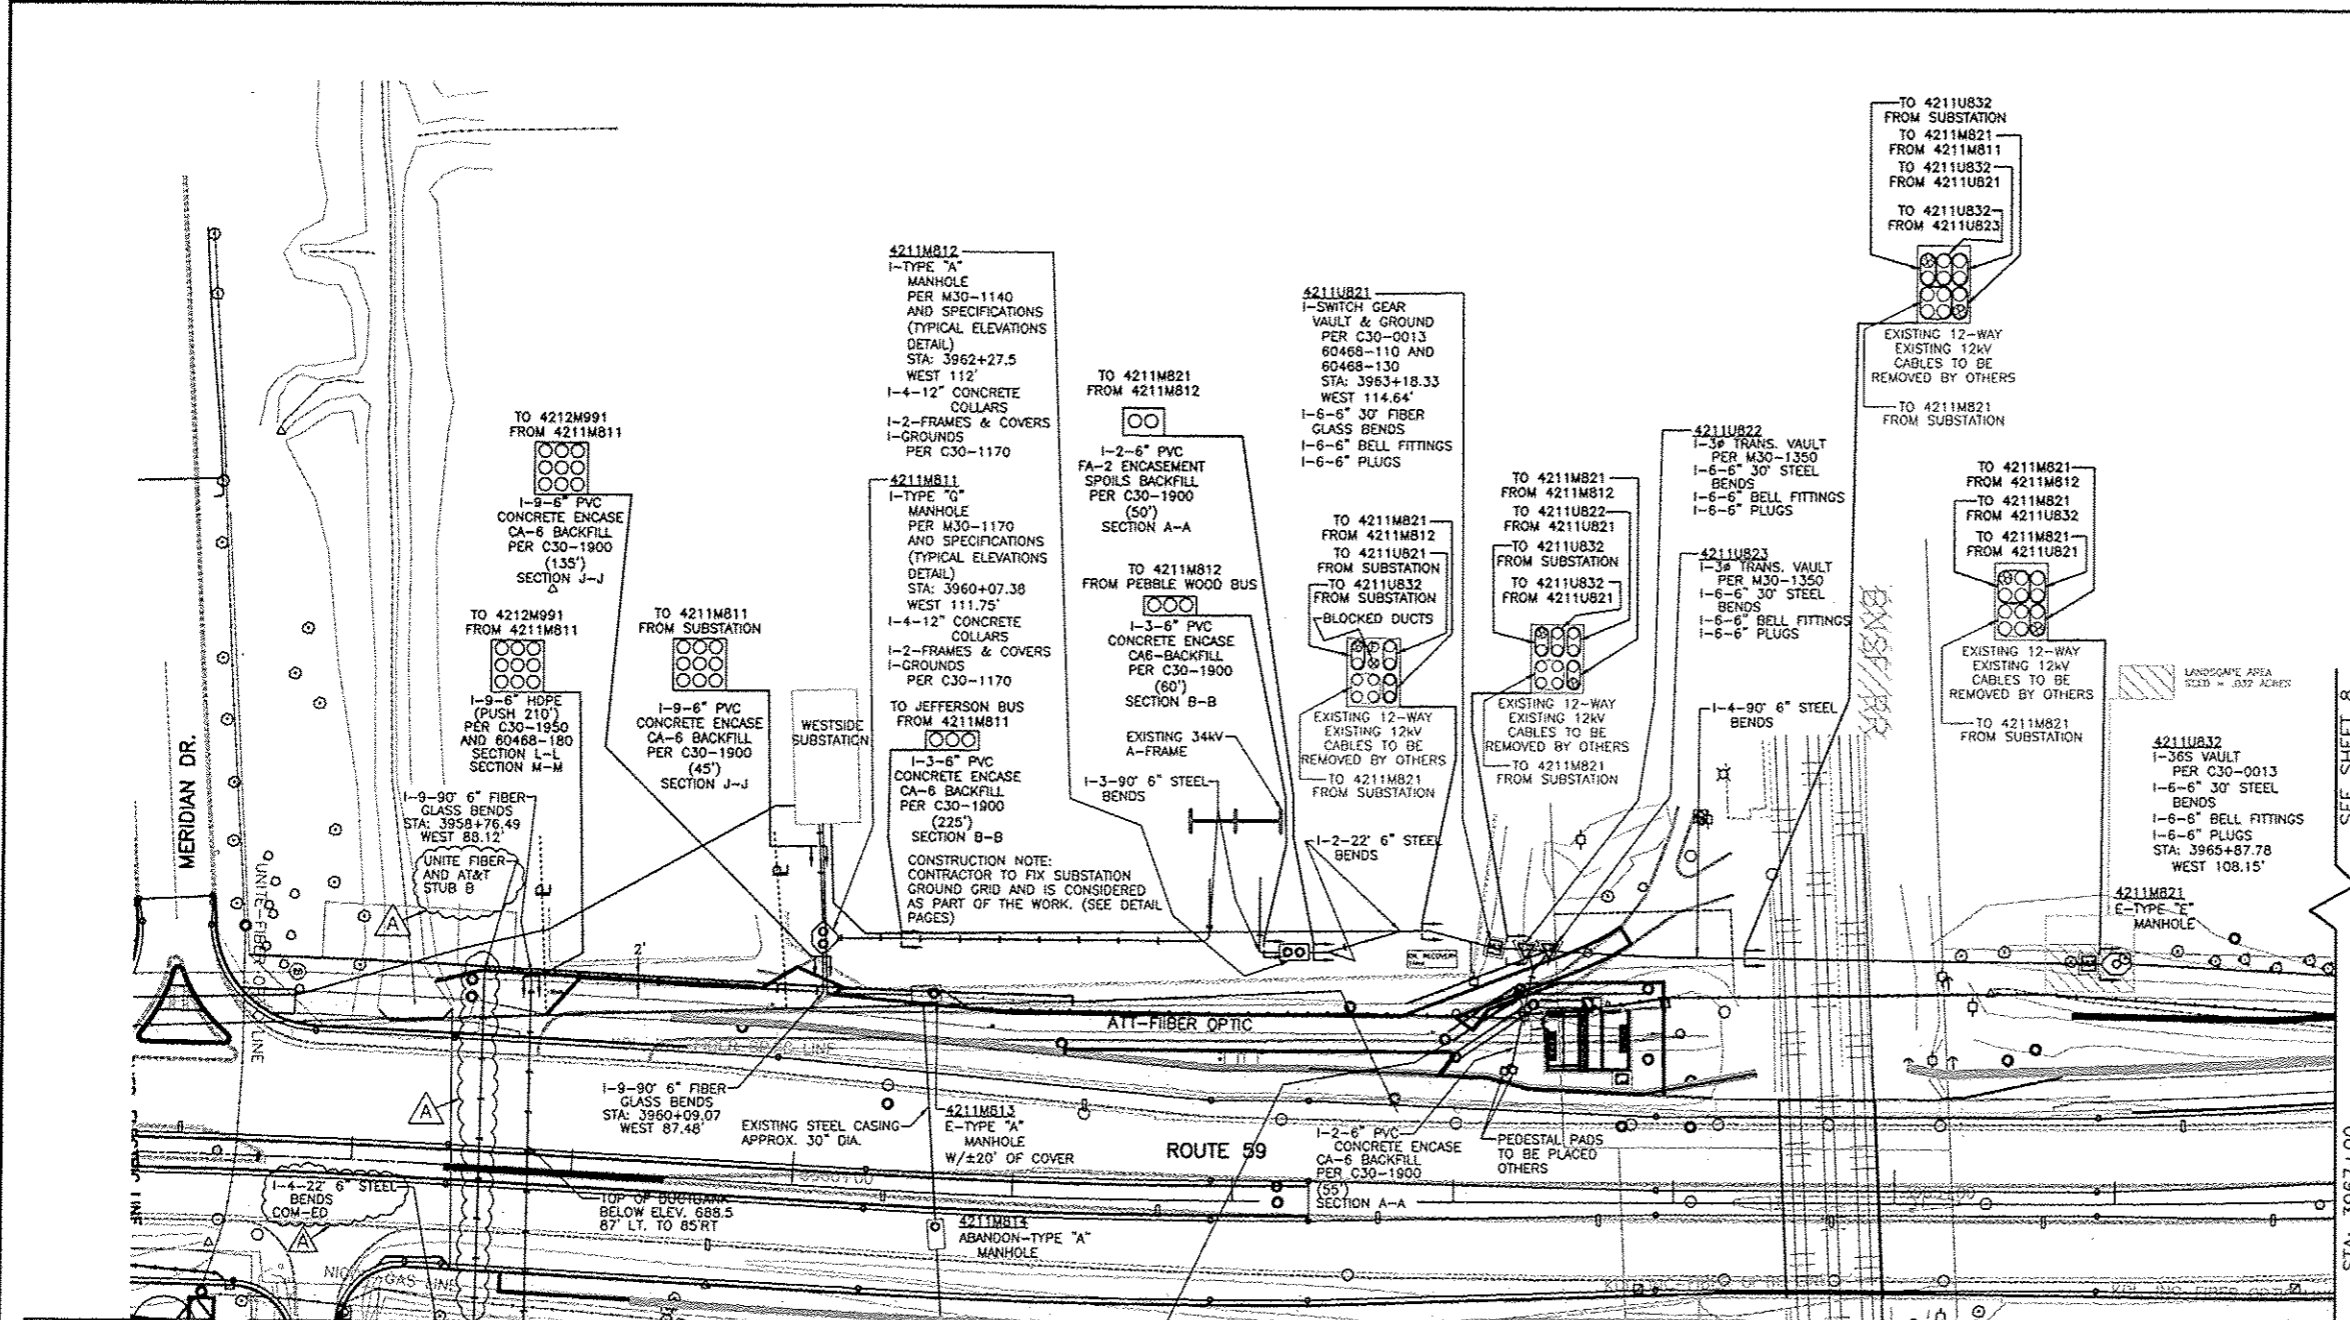


LEGEND

- EXISTING UNDERGROUND**
- E-SW. VAULT
 - E-SW. MOD.
 - E-TRANSFORMER
 - E-TYPE "A" MANHOLE
 - E-TYPE "C" MANHOLE
 - E-TYPE "D" MANHOLE
 - E-TYPE "E" MANHOLE
 - E-CONDUIT
- OVERHEAD**
- E-DISTRIBUTION/TRANSMISSION POLE
- INSTALL UNDERGROUND**
- I-SW. VAULT
 - I-TRANSFORMER VAULT
 - I-TYPE "A" MANHOLE
 - I-TYPE "E" DOUBLE OPENING MANHOLE
 - I-TYPE "G" DOUBLE OPENING MANHOLE
 - I-TYPE "G" SINGLE OPENING MANHOLE
 - I-CONDUIT
- ABANDON UNDERGROUND**
- A-CONDUIT

CONSTRUCTION NOTE:
CONTRACTOR IS TO BE AWARE
OF 36" AND 30" PROPOSED STORM
SEWERS. PRIOR TO CROSSING WITH
2-6" CONDUITS.

CALL JULIE 48 HRS. PRIOR TO CONSTRUCTION
1 - 800 - 892 - 0123 OR CALL 811


- NOTES:
1. THE PROJECT ENGINEER FOR THIS JOB IS BRIAN CHAMBERLAIN AT (630)420-8453.
 2. THE PROJECT COORDINATOR FOR THIS PROJECT IS PAUL MICHALOWSKI AT (630)305-5227.
 3. CONTRACTOR IS RESPONSIBLE FOR MANHOLE PHOTOS TAKEN OF ALL CLEARLY MARKED CABLE AND ALL WALLS OF MANHOLES. PHOTOS WILL BE GIVEN TO THE GIS GROUP WITH THE AS-BUILTS.

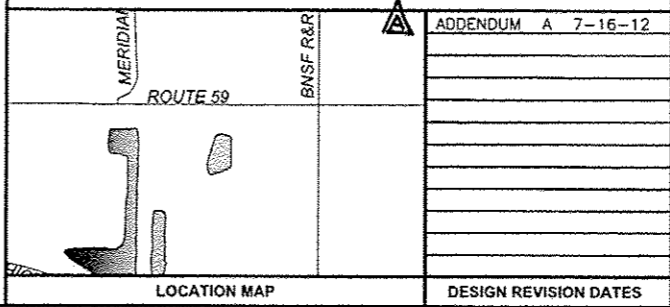

ADDENDUM A 7-16-12			
NO.	DESCRIPTION	DATE	BY


PROJECT TITLE ROUTE 59 ROAD IMPROVEMENTS			
PROJECT DESCRIPTION TO RELOCATE AND INSTALL NEW DUCTBANK AND 34KV FEEDERS			
ENGINEER BCC	DRAWING DATE 5-11-12	APP # 4211,4212,4223	SCALE 1 = 40
DESIGN BY DL	DESIGNED BY PSM	DATE OF AGREEMENT N/A	PROJECT # EU-12
DESIGNED BY	APPROVED BY	CAD FILE 0060468001C3.DWG	SHEET # 3 OF 63
Naperville Department of Public Utilities Electric Division			WORK REQUEST # 60468

F.A. RTE. 338/IL 59	SECTION 2011-050-1	COUNTY DUPAGE	TOTAL SHEETS 0	SHEET NO. 3
STA. _____ TO STA. _____		FED. ROAD DIST. NO. ILLINOIS CONTRACT 60P42		

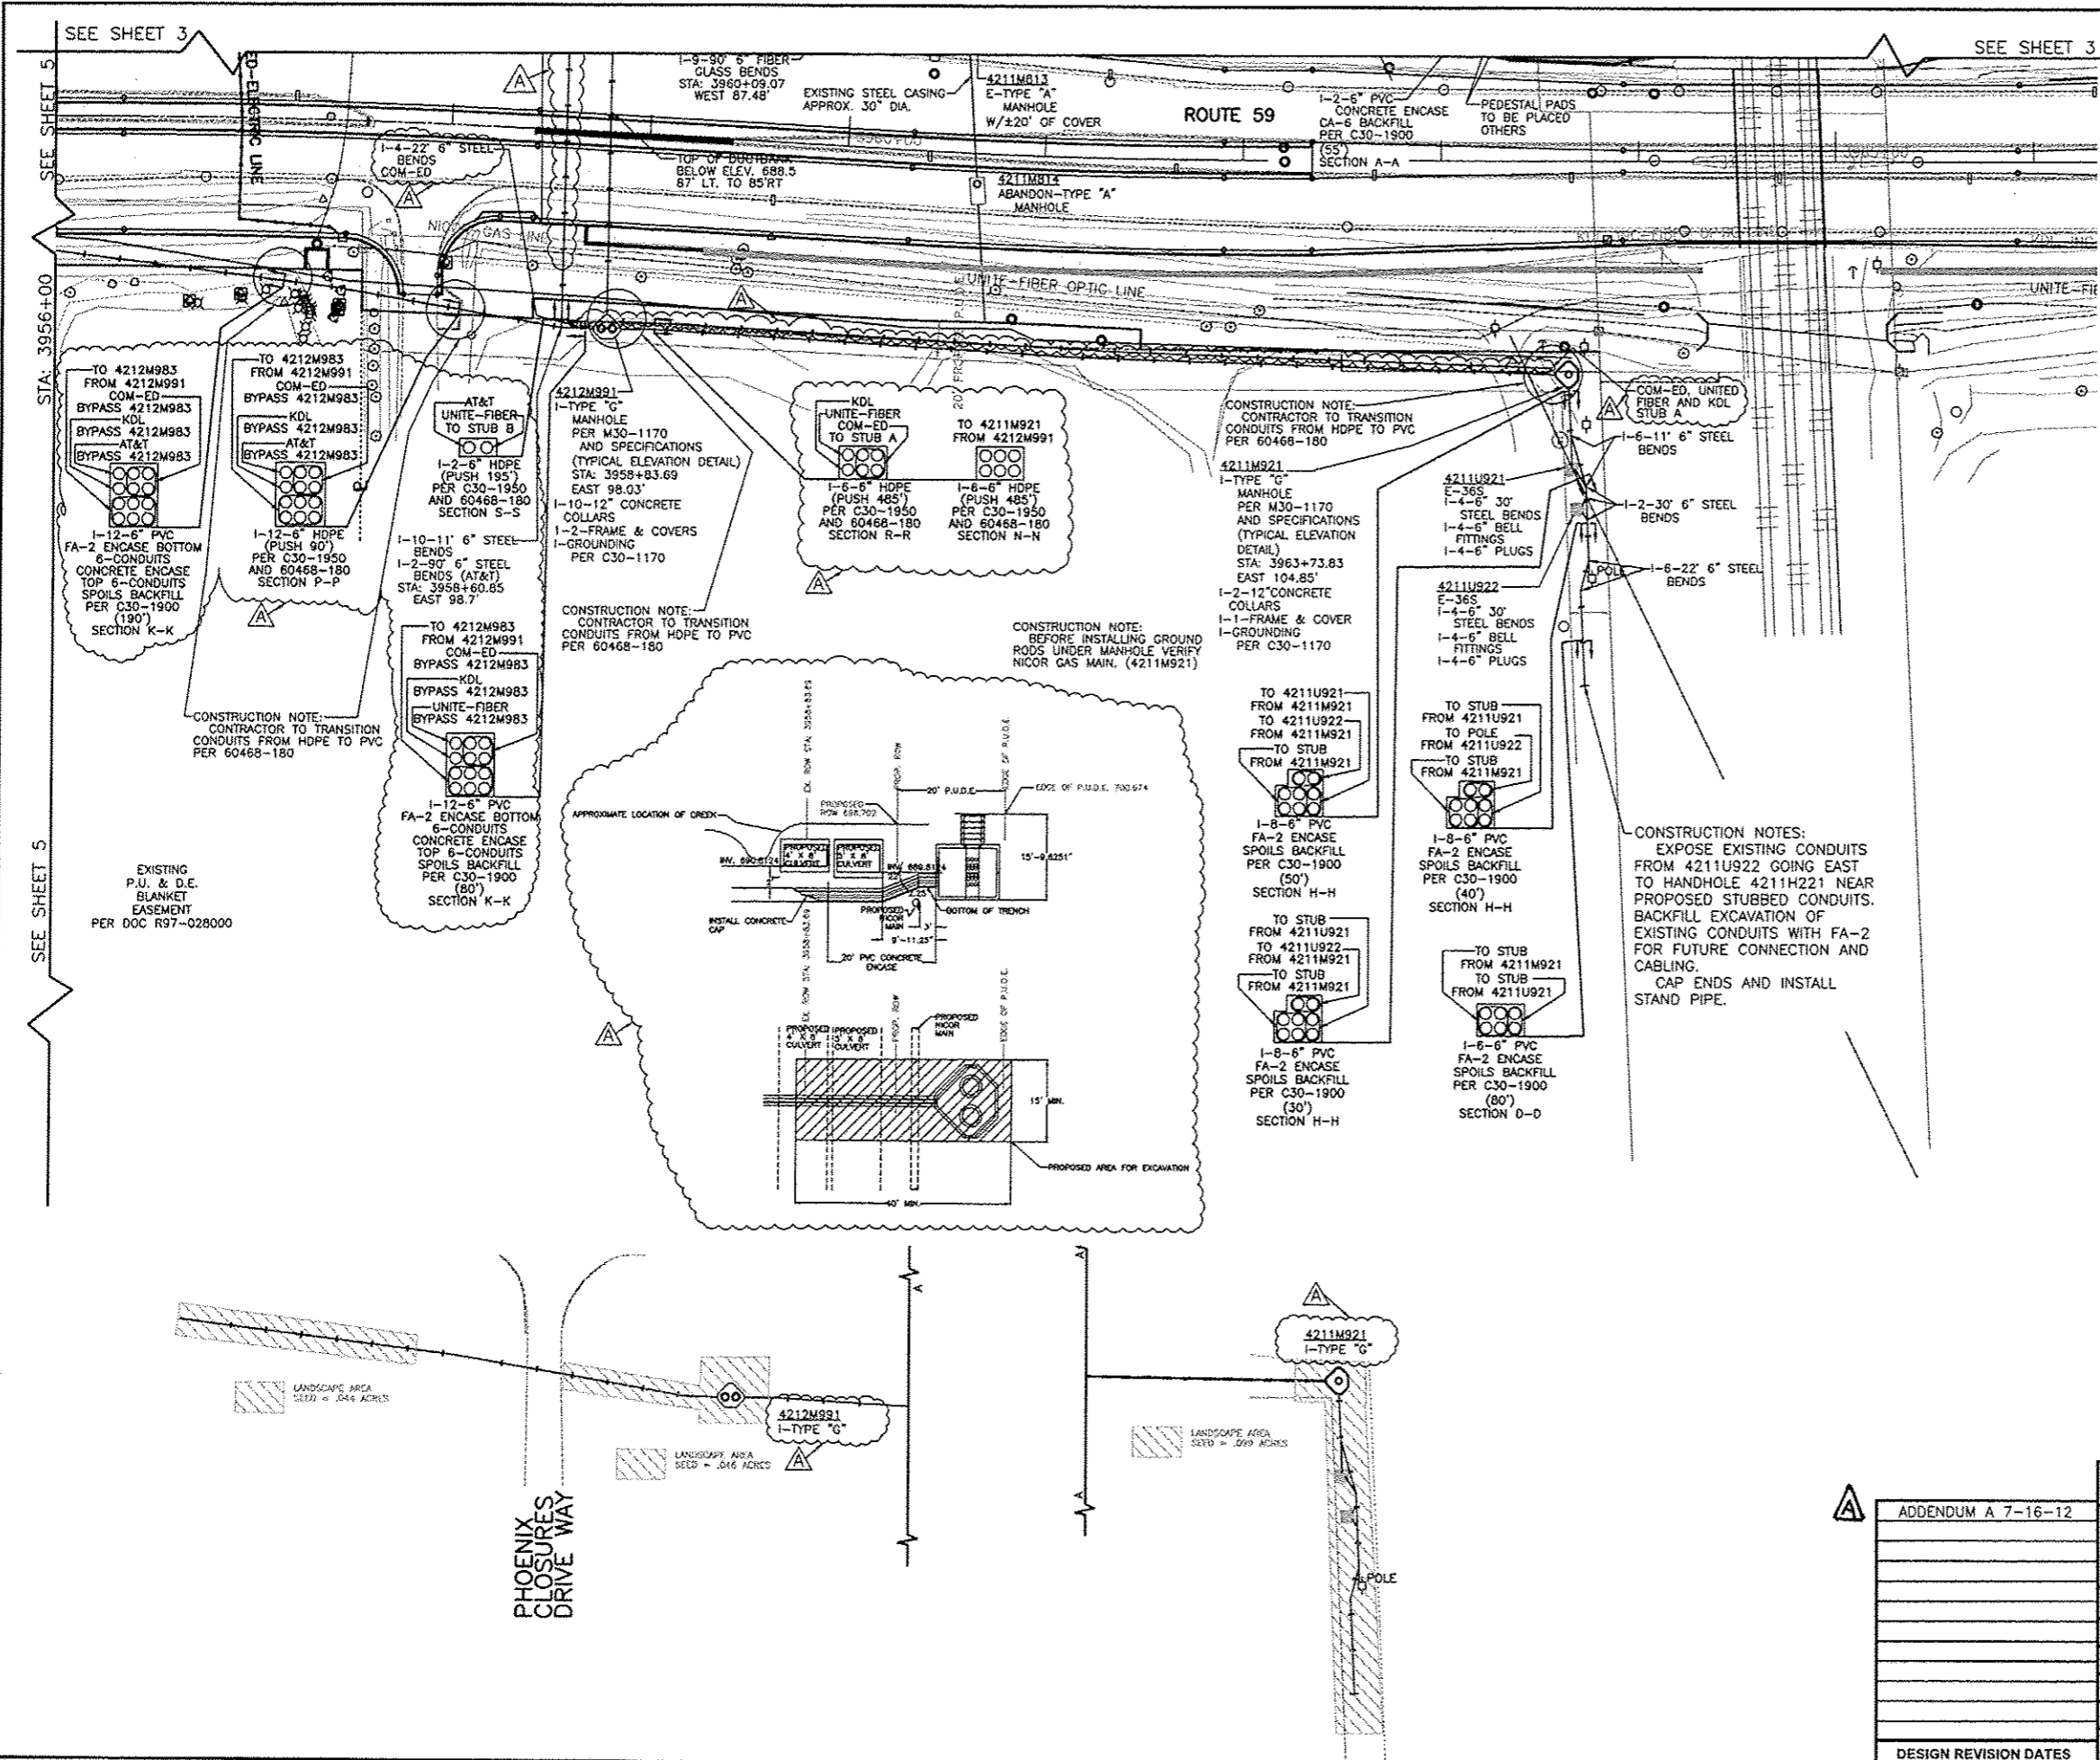

LEGEND

- EXISTING UNDERGROUND**
- E-SW. VAULT
 - E-SW. MOD.
 - E-TRANSFORMER
 - E-TYPE "A" MANHOLE
 - E-TYPE "C" MANHOLE
 - E-TYPE "C" DOUBLE OPENING MANHOLE
 - E-TYPE "D" MANHOLE
 - E-TYPE "E" MANHOLE
 - E-CONDUIT
- OVERHEAD**
- E-DISTRIBUTION/TRANSMISSION POLE
- INSTALL UNDERGROUND**
- I-SW. VAULT
 - I-TRANSFORMER VAULT
 - I-TYPE "A" MANHOLE
 - I-TYPE "E" DOUBLE OPENING MANHOLE
 - I-TYPE "G" DOUBLE OPENING MANHOLE
 - I-TYPE "G" SINGLE OPENING MANHOLE
 - I-CONDUIT
- ABANDON UNDERGROUND**
- A-CONDUIT

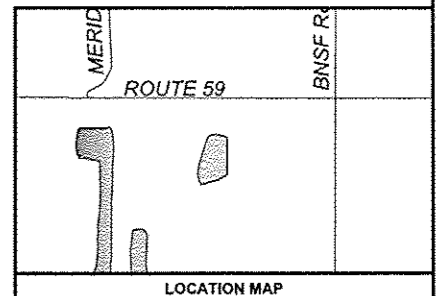

CALL JULIE 48 HRS. PRIOR TO CONSTRUCTION
1-800-892-0123 OR CALL 811

ADDENDUM A 7-16-12




DESIGNED BY	DATE	BY	DATE
DL	5-11-12	PSM	5-11-12

NOTES:
 1. THE PROJECT ENGINEER FOR THIS JOB IS BRIAN CHAMBERLAIN AT (830)420-8853.
 2. THE PROJECT COORDINATOR FOR THIS PROJECT IS PAUL MICHALOWSKI AT (830)305-5227.
 3. CONTRACTOR IS RESPONSIBLE FOR MANHOLE PHOTOS TAKEN OF ALL CLEARLY MARKED CABLE AND ALL WALLS OF MANHOLES. PHOTOS WILL BE GIVEN TO THE GIS GROUP WITH THE AS-BUILTS.

PROJECT TITLE ROUTE 59 ROAD IMPROVEMENTS			
PROJECT DESCRIPTION TO RELOCATE AND INSTALL NEW DUCTBANK AND 34KV FEEDERS			
OWNER	DRAWING DATE	DATE	SCALE
BCC	5-11-12	4211,4212,4223	1 = 40
DESIGNED BY	CHECKED BY	DATE	PROJECT #
DL	PSM	N/A	EU-12
CHECKED BY	DATE	DATE	SHEET #
			4 OF 63
Naperville Department of Public Utilities Electric Division			WORK NUMBER # 60468



F.A. RTE. 338/IL 59	SECTION 2011-050	COUNTY DUPAGE	TOTAL SHEETS 0	SHEET NO. 3
STA.		TO STA.		
FED. ROAD DIST. NO.		ILLINOIS CONTRACT 60P42		

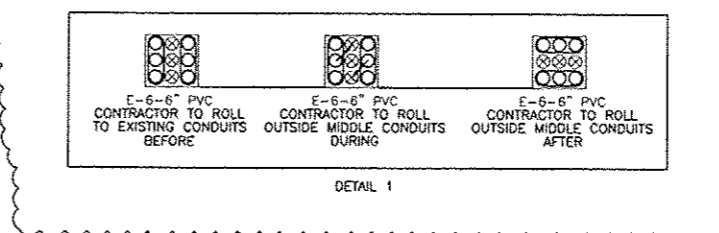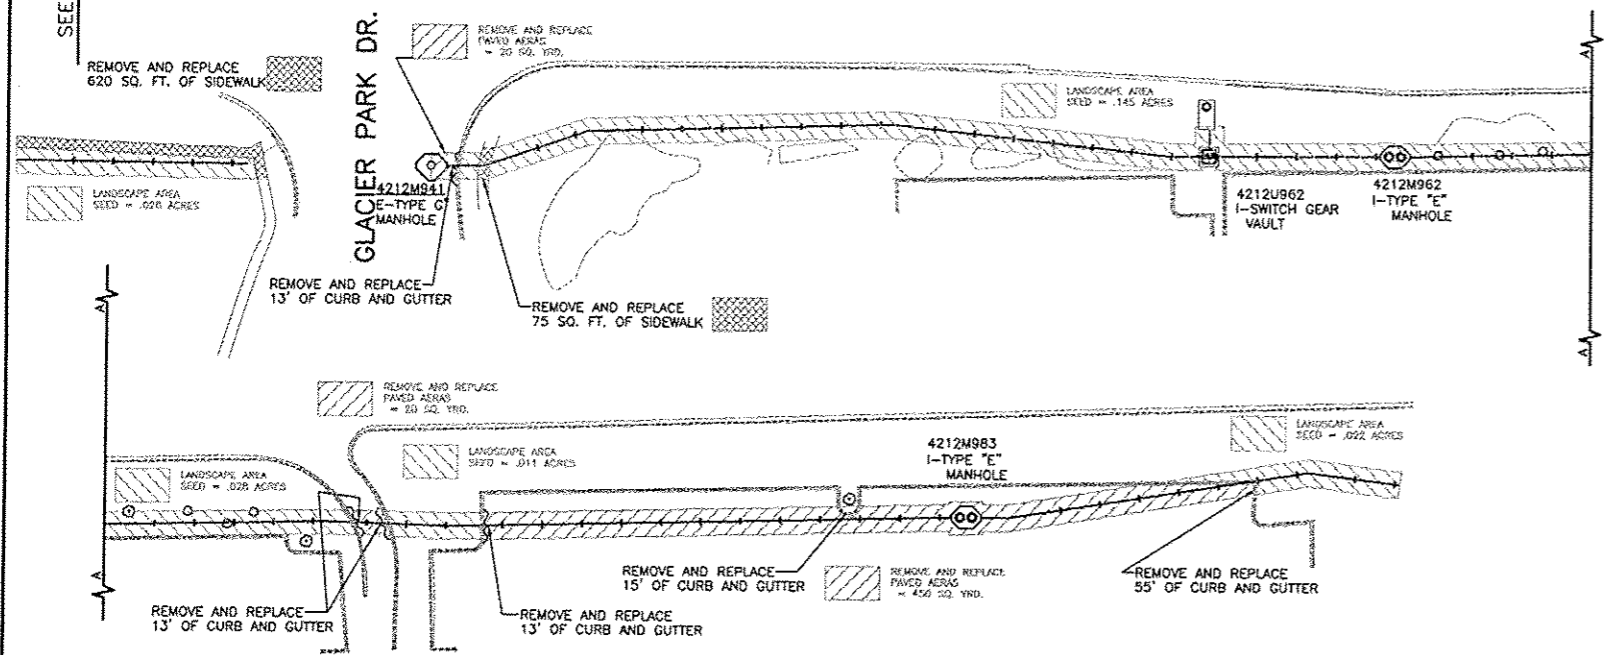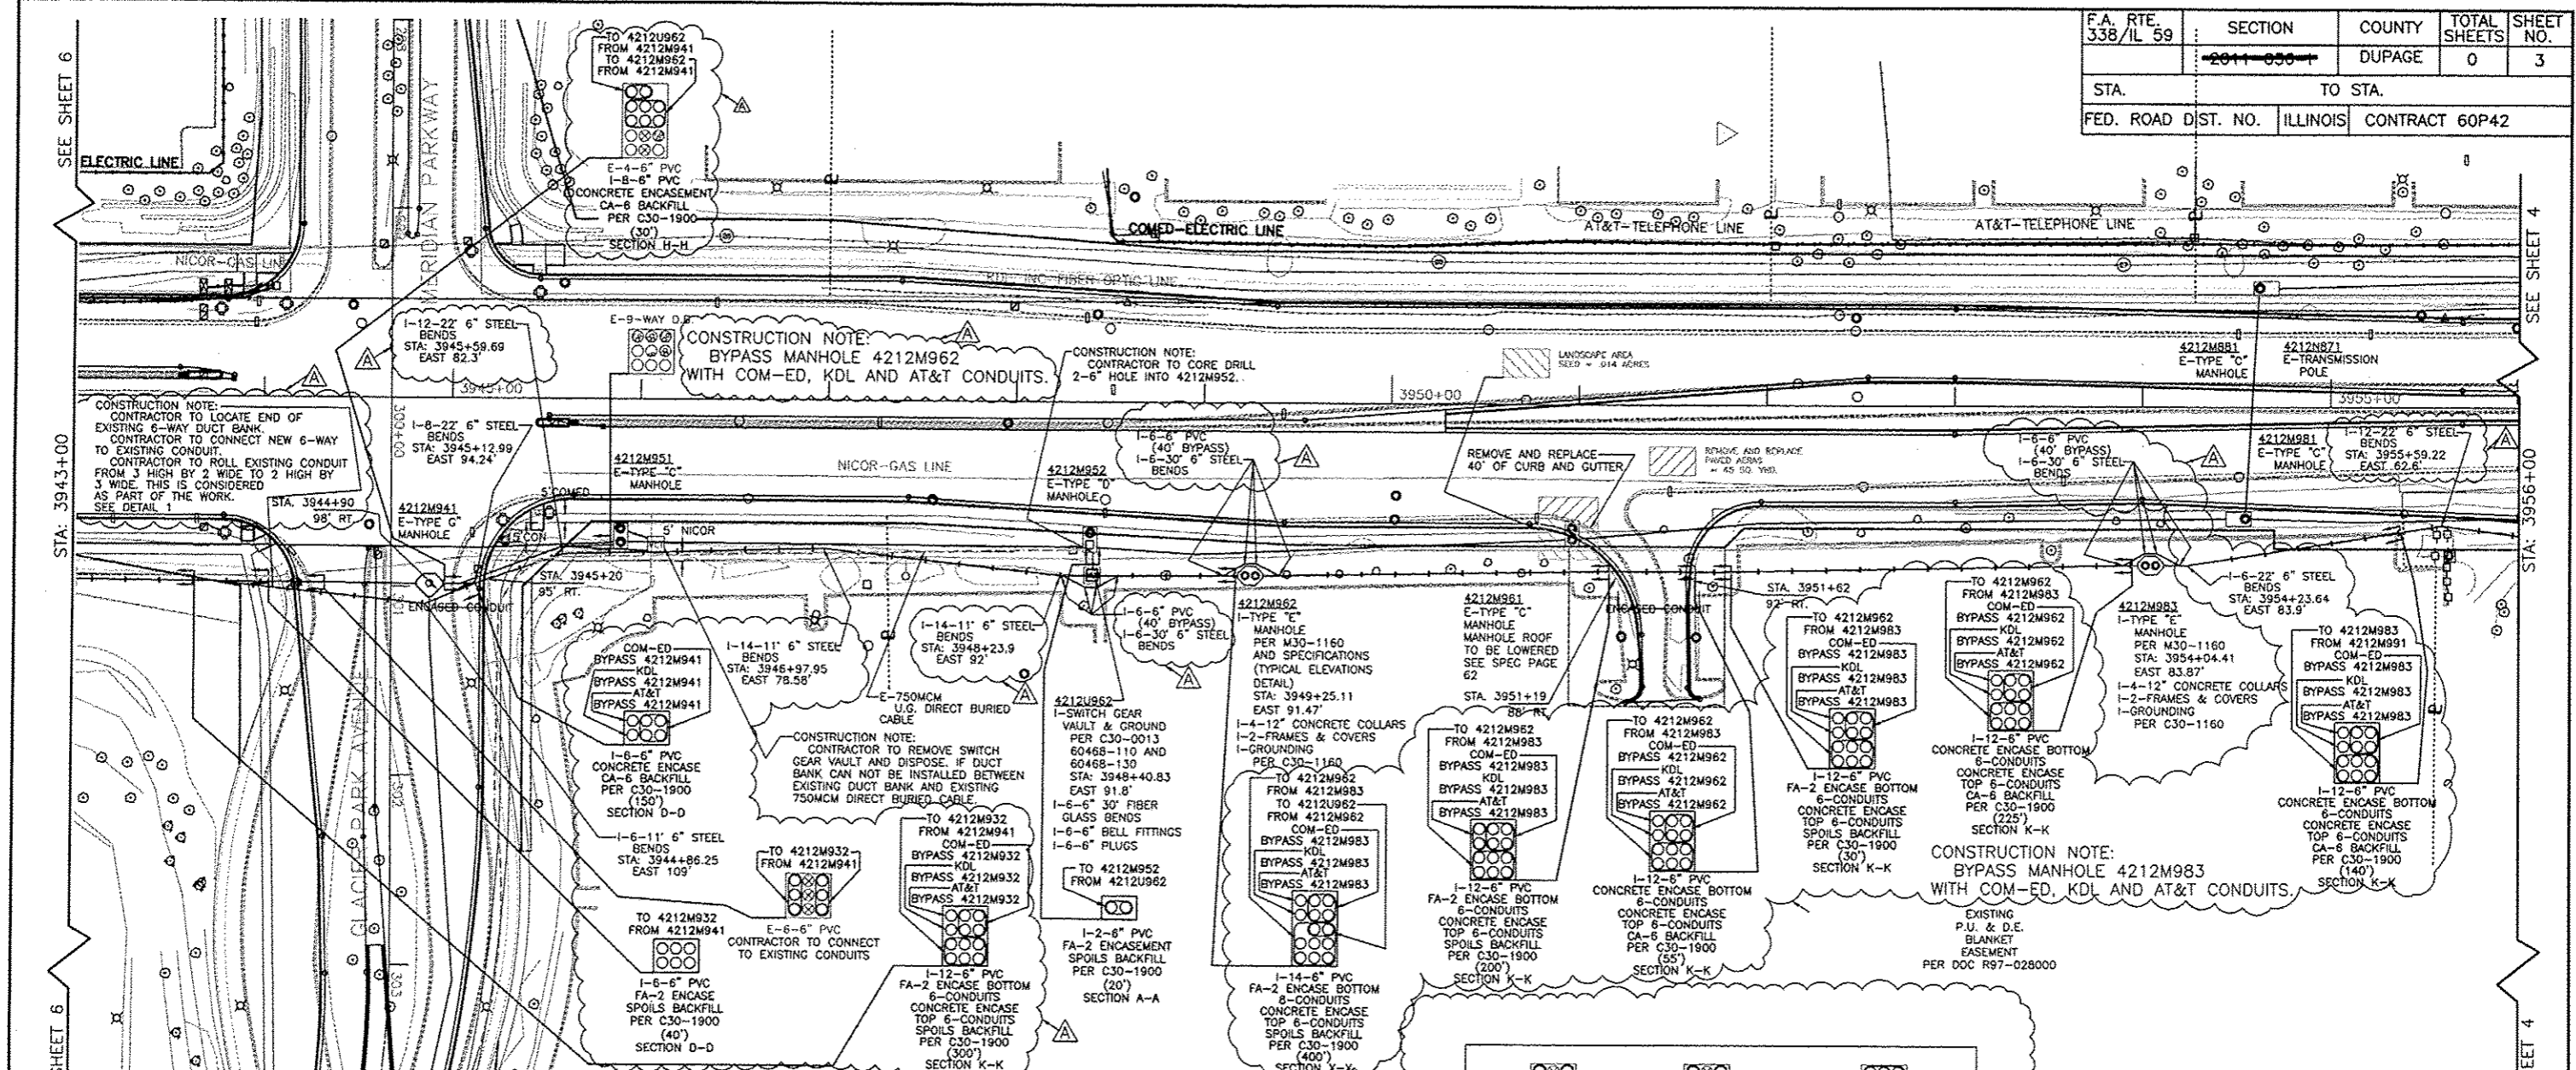

LEGEND

EXISTING	INSTALL

CALL JULIE 48 HRS. PRIOR TO CONSTRUCTION
1-800-892-0123 OR CALL 811

NOTES:
1. THE PROJECT ENGINEER FOR THIS JOB IS BRIAN CHAMBERLAIN AT (830)430-8853.
2. THE PROJECT COORDINATOR FOR THIS PROJECT IS PAUL MICHALOWSKI AT (830)305-5227.
3. CONTRACTOR IS RESPONSIBLE FOR MANHOLE PHOTOS TAKEN OF ALL CLEARLY MARKED CABLE AND ALL WALLS OF MANHOLES. PHOTOS WILL BE GIVEN TO THE GIS GROUP WITH THE AS-BUILTS.

ADDENDUM A 7-16-12

ROUTE 59

LOCATION MAP

DESIGN REVISION DATES

PROJECT TITLE
ROUTE 59 ROAD IMPROVEMENTS

PROJECT DESCRIPTION
TO RELOCATE AND INSTALL NEW DUCTBANK AND 34KV FEEDERS

DRAWN BY BCC	DRAWING DATE 5-11-12	APP # 4211,4212,4223	SCALE 1 = 40
DESIGNED BY DL	DESIGNED DATE N/A	APP # N/A	PROJECT # EU-12
CHECKED BY PSM	CHECKED DATE N/A	APP # N/A	SHEET # 5 OF 63

Naperville Department of Public Utilities
Electric Division

60468


PROJECT TITLE ROUTE 59 ROAD IMPROVEMENTS			
PROJECT DESCRIPTION TO RELOCATE AND INSTALL NEW DUCTBANK AND 34KV FEEDERS			
DRAWN BY BCC	DRAWING DATE 5-11-12	APP # 4211,4212,4223	SCALE 1 = 40
DESIGNED BY DL	DESIGNED DATE N/A	APP # N/A	PROJECT # EU-12
CHECKED BY PSM	CHECKED DATE N/A	APP # N/A	SHEET # 5 OF 63

Naperville Department of Public Utilities
Electric Division

60468

F.A. RTE. 338/IL 59	SECTION 2011-036	COUNTY DUPAGE	TOTAL SHEETS 0	SHEET NO. 3
------------------------	--------------------------------	------------------	-------------------	----------------

STA.	TO STA.
FED. ROAD DIST. NO.	ILLINOIS CONTRACT 60P42

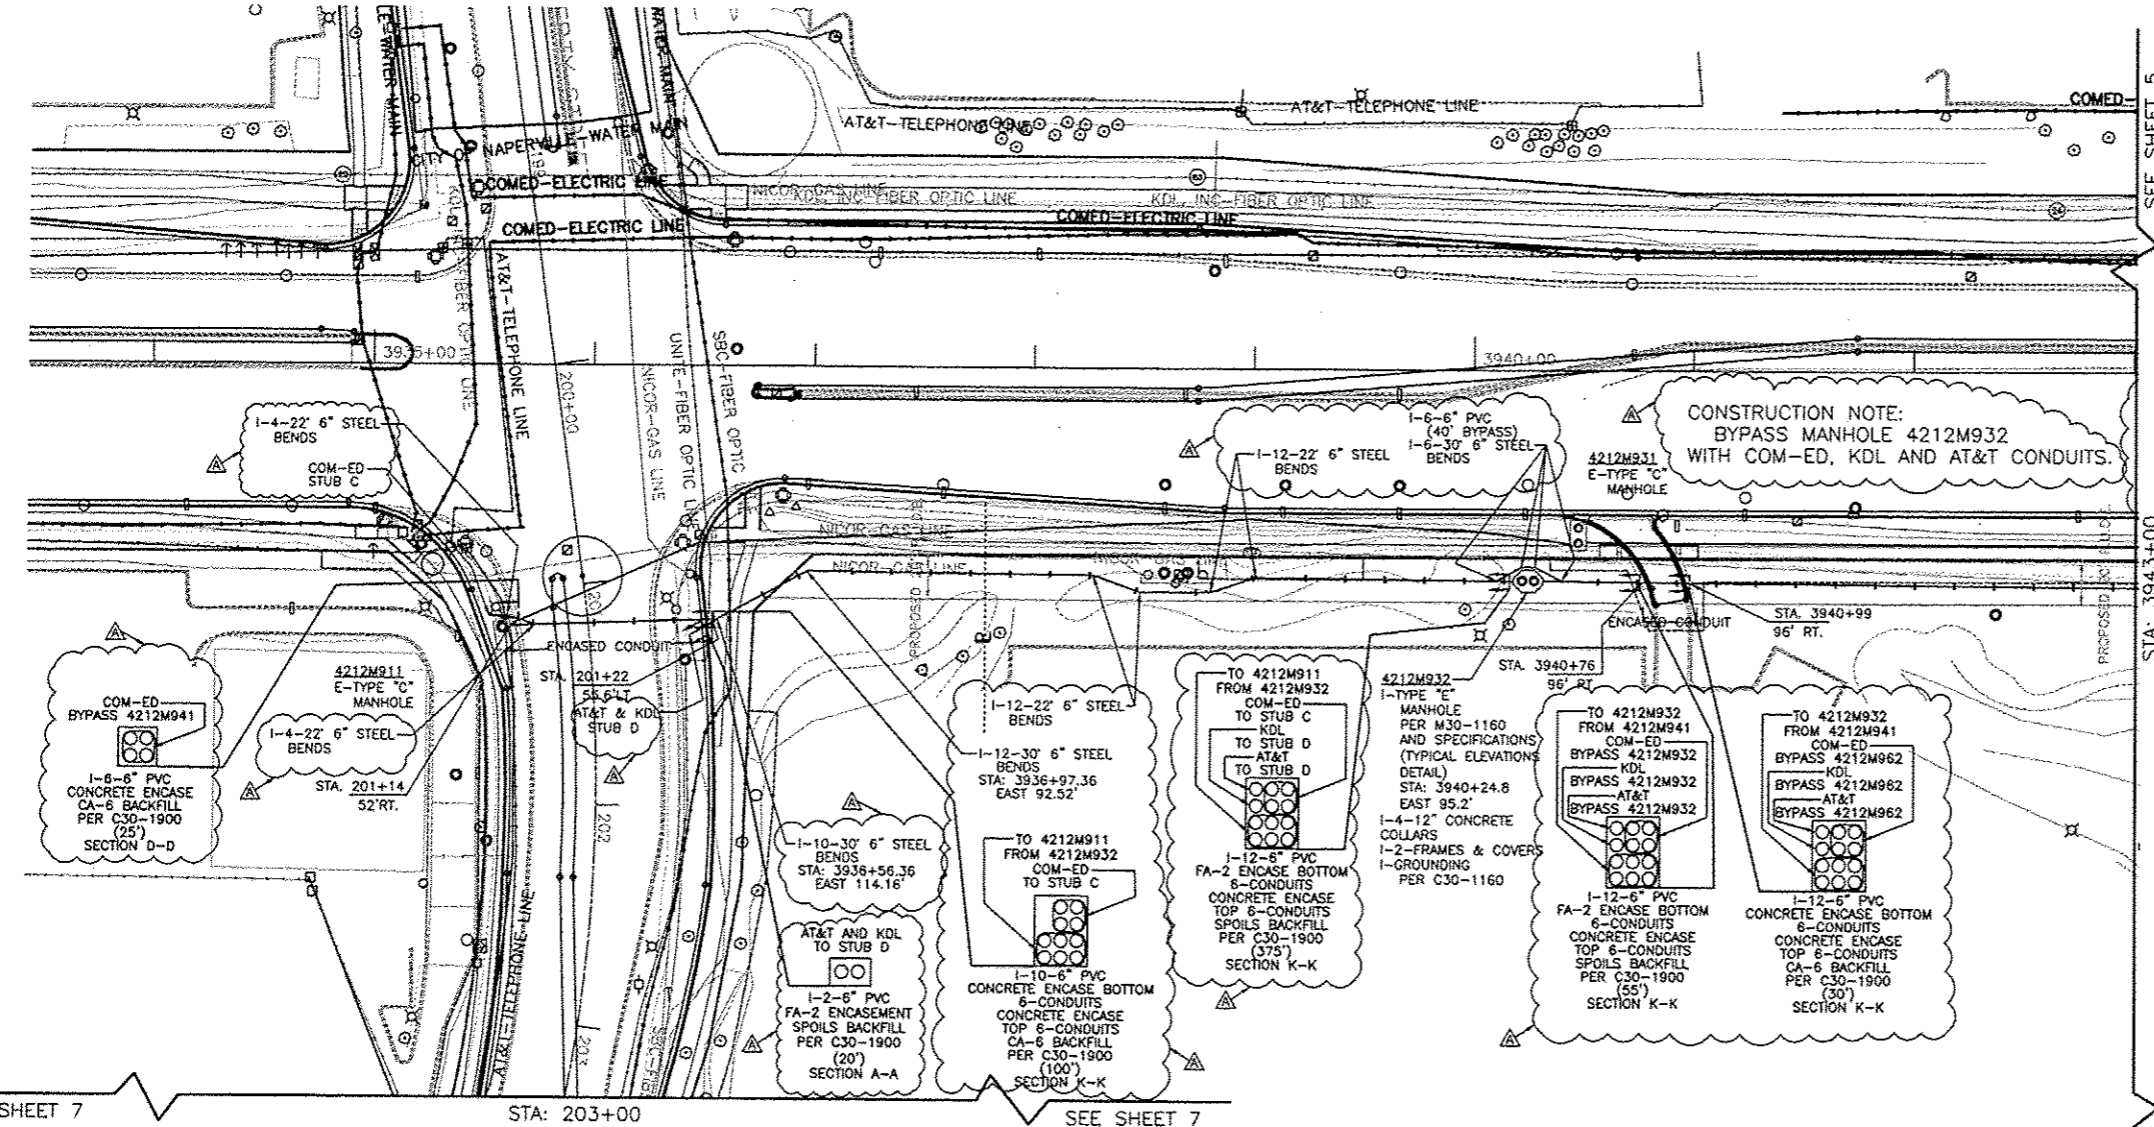

LEGEND

- EXISTING UNDERGROUND**
- E-SW VAULT
 - E-SW MOD.
 - E-TRANSFORMER
 - E-TYPE "A" MANHOLE
 - E-TYPE "C" MANHOLE
 - E-TYPE "C" DOUBLE OPENING MANHOLE
 - E-TYPE "D" MANHOLE
 - E-TYPE "E" MANHOLE
 - E-CONDUIT
- OVERHEAD**
- E-DISTRIBUTION/TRANSMISSION POLE
- INSTALL UNDERGROUND**
- I-SW VAULT
 - I-TRANSFORMER VAULT
 - I-TYPE "A" MANHOLE
 - I-TYPE "E" DOUBLE OPENING MANHOLE
 - I-TYPE "G" DOUBLE OPENING MANHOLE
 - I-TYPE "G" SINGLE OPENING MANHOLE
 - I-CONDUIT
- ABANDON UNDERGROUND**
- A-CONDUIT

SEE SHEET 7


STA: 203+00

SEE SHEET 7

SEE SHEET 5

STA: 3940+00

SEE SHEET 5

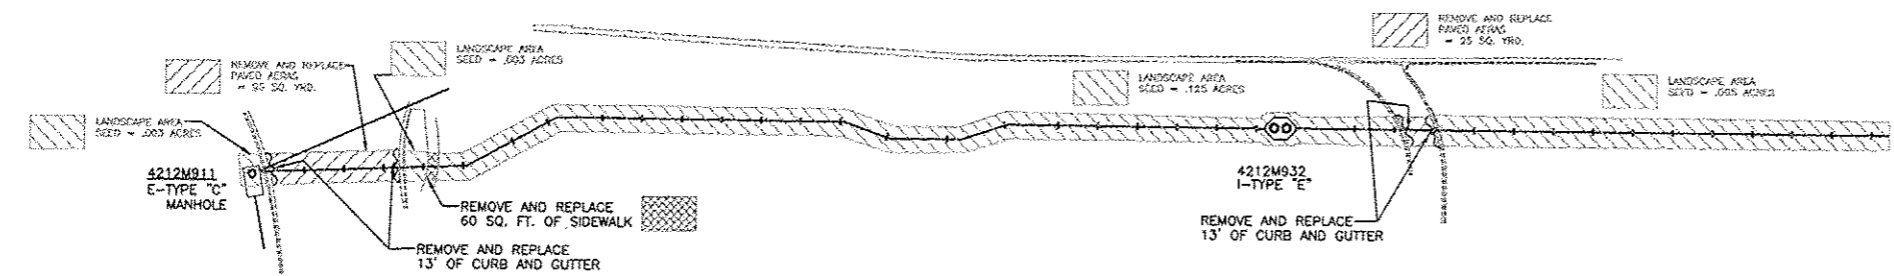


CALL **JULIE** 48 HRS. PRIOR TO CONSTRUCTION
1-800-892-0123 OR CALL 811

- NOTES:
- THE PROJECT ENGINEER FOR THIS JOB IS BRIAN CHAMBERLAIN AT (630)420-6853.
 - THE PROJECT COORDINATOR FOR THIS PROJECT IS PAUL MICHALOWSKI AT (630)305-5227.
 - CONTRACTOR IS RESPONSIBLE FOR MANHOLE PHOTOS TAKEN OF ALL CLEARLY MARKED CABLE AND ALL WALLS OF MANHOLES. PHOTOS WILL BE GIVEN TO THE GIS GROUP WITH THE AS-BUILTS.

	ADDENDUM A 7-16-12
	DESIGN REVISION DATES

PROJECT TITLE ROUTE 59 ROAD IMPROVEMENTS	
PROJECT DESCRIPTION TO RELOCATE AND INSTALL NEW DUCTBANK AND 34KV FEEDERS	
OWNER BCC	ISSUE DATE 5-11-12
DESIGNED BY DL	DATE OF APPROVAL N/A
CHECKED BY PSM	DATE OF APPROVAL N/A
PROJECT # EU-12	SCALE 1 = 40
DATE OF FILE 0580648001C6.DWG	SHEET # 6 OF 63
Naperville Department of Public Utilities Electric Division	
WORK REQUEST # 60468	

F.A. RTE. 338/IL 59	SECTION -2011-036-	COUNTY DUPAGE	TOTAL SHEETS 0	SHEET NO. 3
STA.		TO STA.		
FED. ROAD DIST. NO.	ILLINOIS	CONTRACT 60P42		

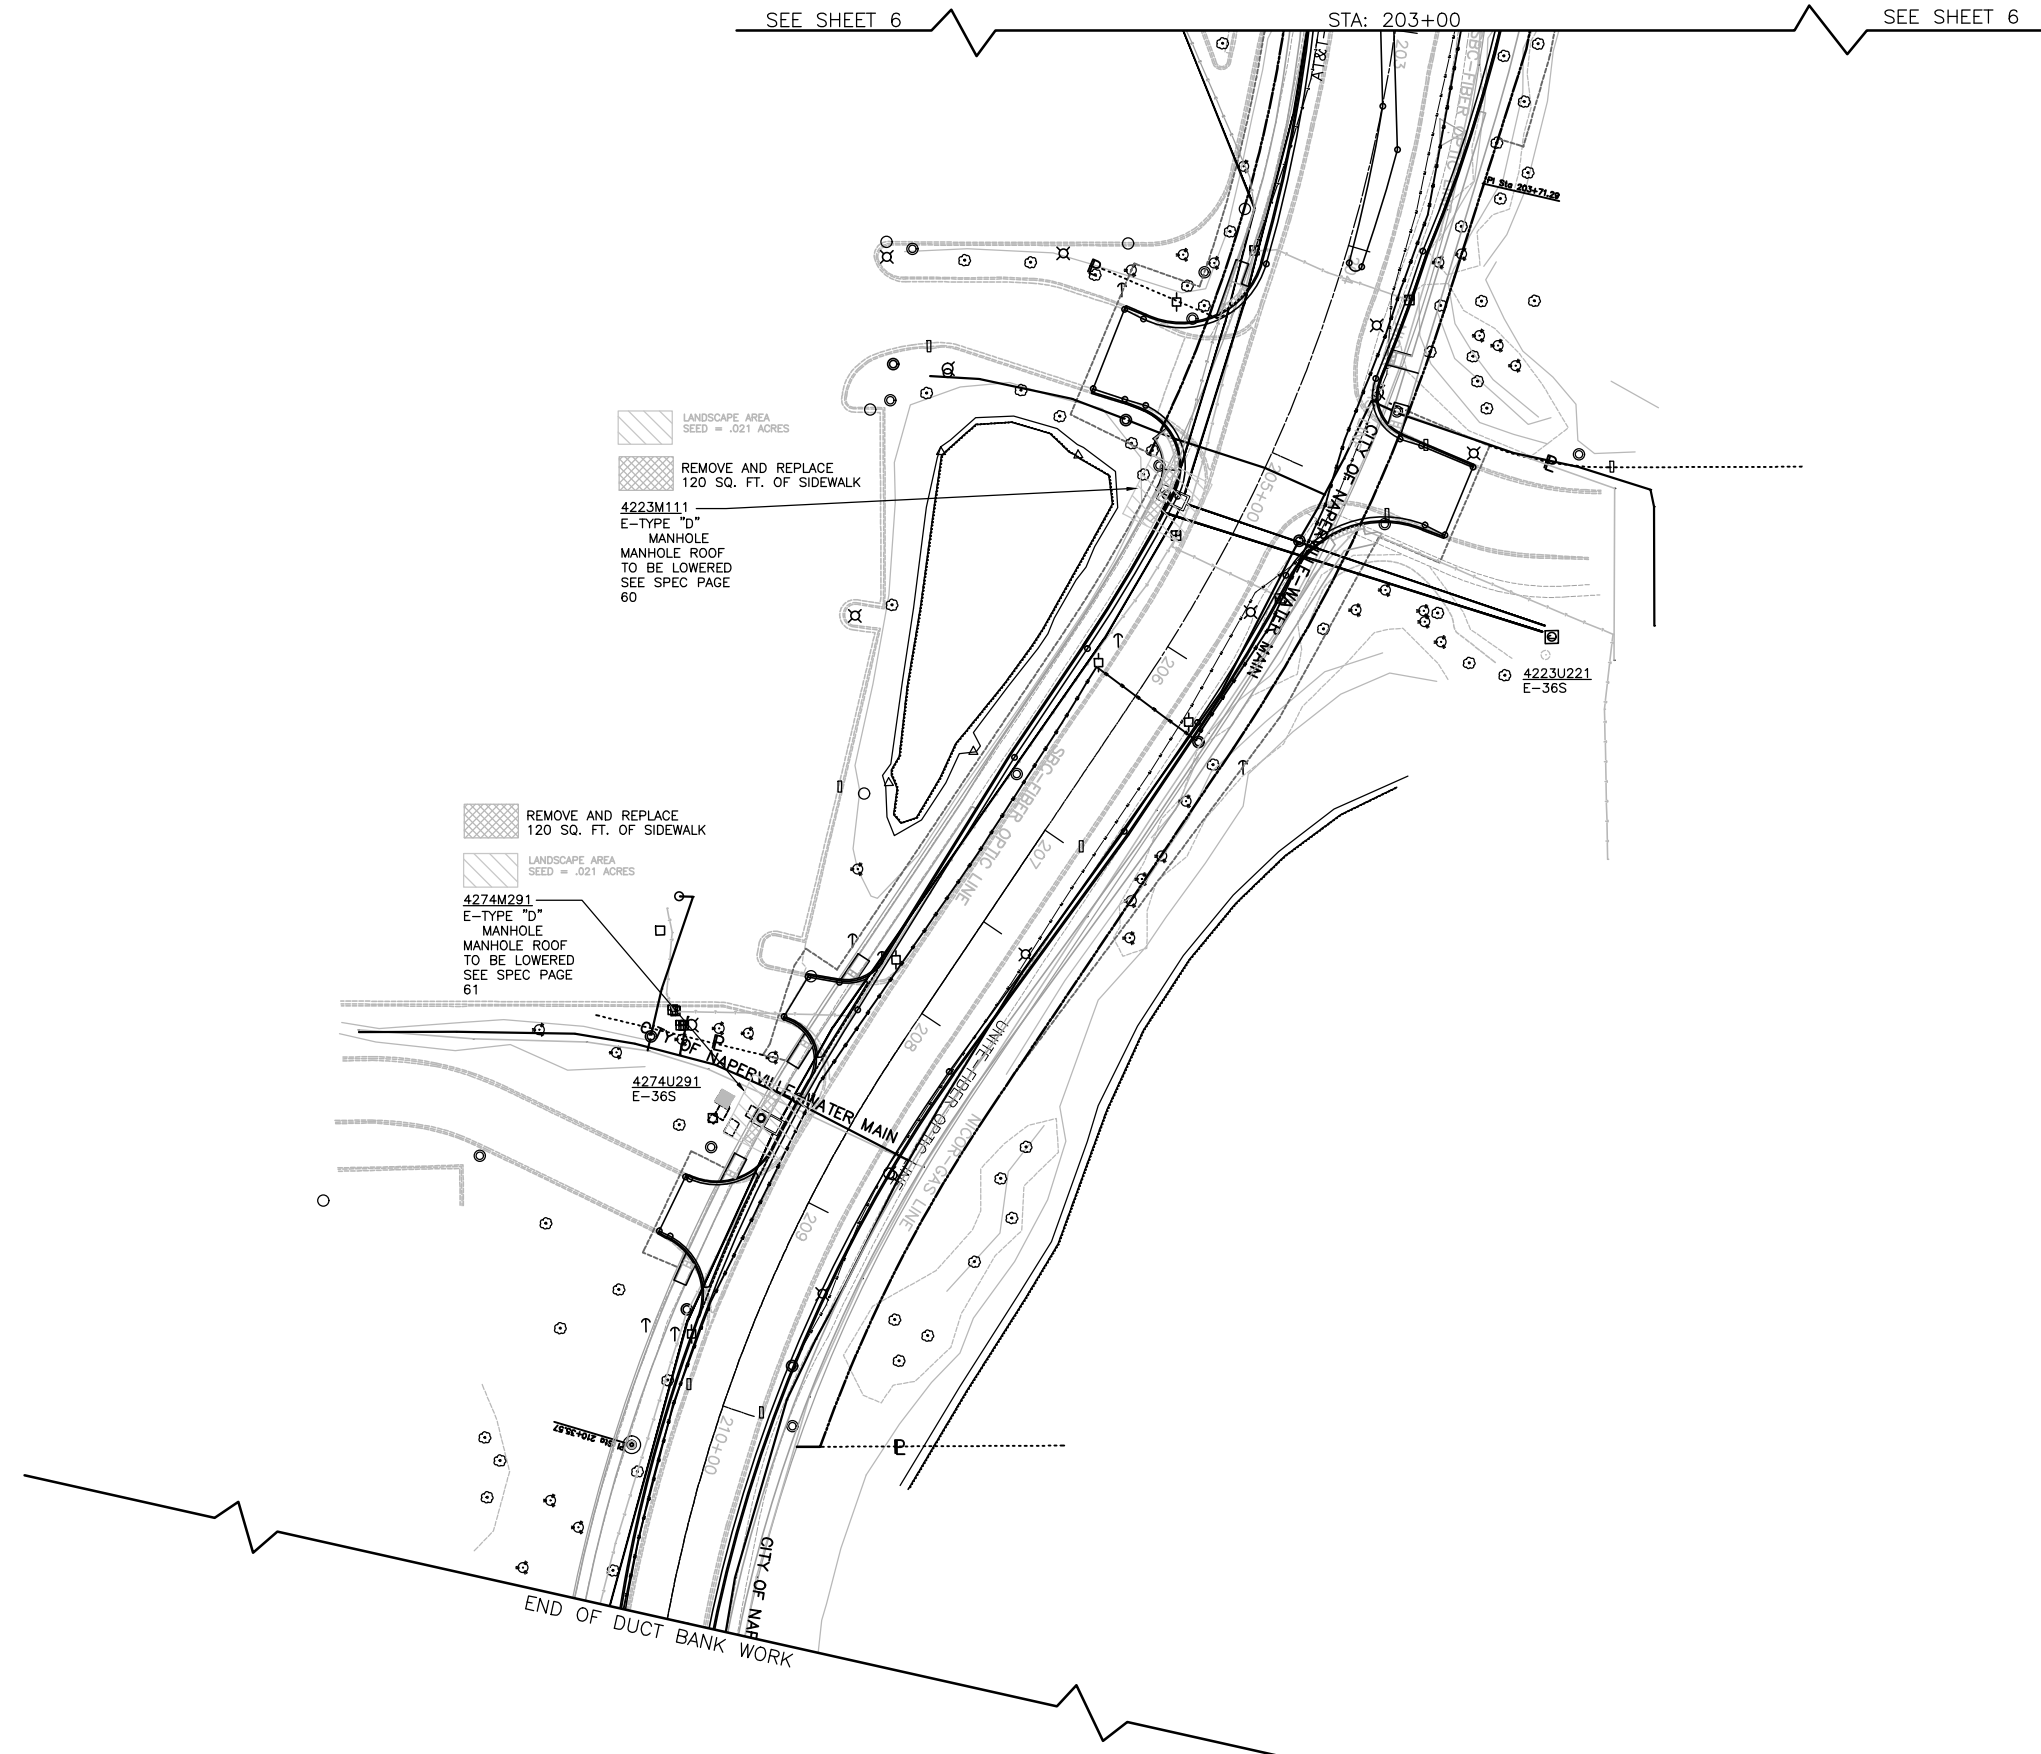

LEGEND

EXISTING UNDERGROUND	
▽	E-SW. VAULT
■	E-SW. MOD.
▲	E-TRANSFORMER
○	E-TYPE "A" MANHOLE
○	E-TYPE "C" MANHOLE
○	E-TYPE "C" DOUBLE OPENING MANHOLE
○	E-TYPE "D" MANHOLE
○	E-TYPE "E" MANHOLE
—	E-CONDUIT
OVERHEAD	
●	E-DISTRIBUTION/TRANSMISSION POLE
INSTALL UNDERGROUND	
▽	I-SW. VAULT
▲	I-TRANSFORMER VAULT
○	I-TYPE "A" MANHOLE
○	I-TYPE "E" DOUBLE OPENING MANHOLE
○	I-TYPE "G" DOUBLE OPENING MANHOLE
○	I-TYPE "G" SINGLE OPENING MANHOLE
—	I-CONDUIT
ABANDON UNDERGROUND	
- - -	A-CONDUIT

LANDSCAPE AREA
SEED = .021 ACRES

REMOVE AND REPLACE
120 SQ. FT. OF SIDEWALK

4223M111
E-TYPE "D"
MANHOLE
MANHOLE ROOF
TO BE LOWERED
SEE SPEC PAGE
60

REMOVE AND REPLACE
120 SQ. FT. OF SIDEWALK


LANDSCAPE AREA
SEED = .021 ACRES

4274M291
E-TYPE "D"
MANHOLE
MANHOLE ROOF
TO BE LOWERED
SEE SPEC PAGE
61


4274U291
E-36S

CALL JULIE 48 HRS. PRIOR TO CONSTRUCTION
1 - 800 - 892 - 0123 OR CALL 811


- NOTES:**
1. THE PROJECT ENGINEER FOR THIS JOB IS BRIAN CHAMBERLAIN AT (630)420-8853.
 2. THE PROJECT COORDINATOR FOR THIS PROJECT IS PAUL MICHALOWSKI AT (630)305-5227.
 3. CONTRACTOR IS RESPONSIBLE FOR MANHOLE PHOTOS TAKEN OF ALL CLEARLY MARKED CABLE AND ALL WALLS OF MANHOLES. PHOTOS WILL BE GIVEN TO THE GIS GROUP WITH THE AS-BUILTS.

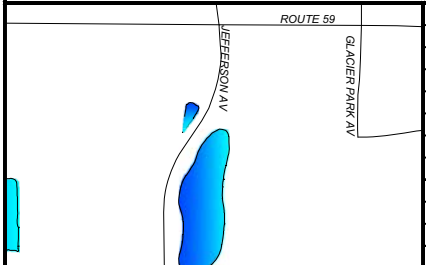

DESIGN REVISION DATES

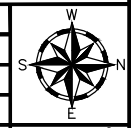PROJECT TITLE ROUTE 59 ROAD IMPROVEMENTS					
PROJECT DESCRIPTION TO RELOCATE AND INSTALL NEW DUCTBANK AND 34KV FEEDERS					
ENGINEER BCC	DRAFTING DATE 5-11-12	MAP # 4211,4212,4223	SCALE 1 = 40	NORTH	
DESIGN BY DL	DRAWN BY PSM	REVISIONS DATE N/A	TASK JOB AGREEMENT # N/A	PROJECT # EU-12	
CHECKED BY	APPROVED BY	CAD FILE 0060648001C7.DWG	SHEET # 7 OF 63	WORK REQUEST # 60468	

F.A. RTE. 338/IL 59	SECTION -2011 036 +	COUNTY DUPAGE	TOTAL SHEETS -0-	SHEET NO. -3-
STA.		TO STA.		
FED. ROAD DIST. NO.	ILLINOIS	CONTRACT 60P42		

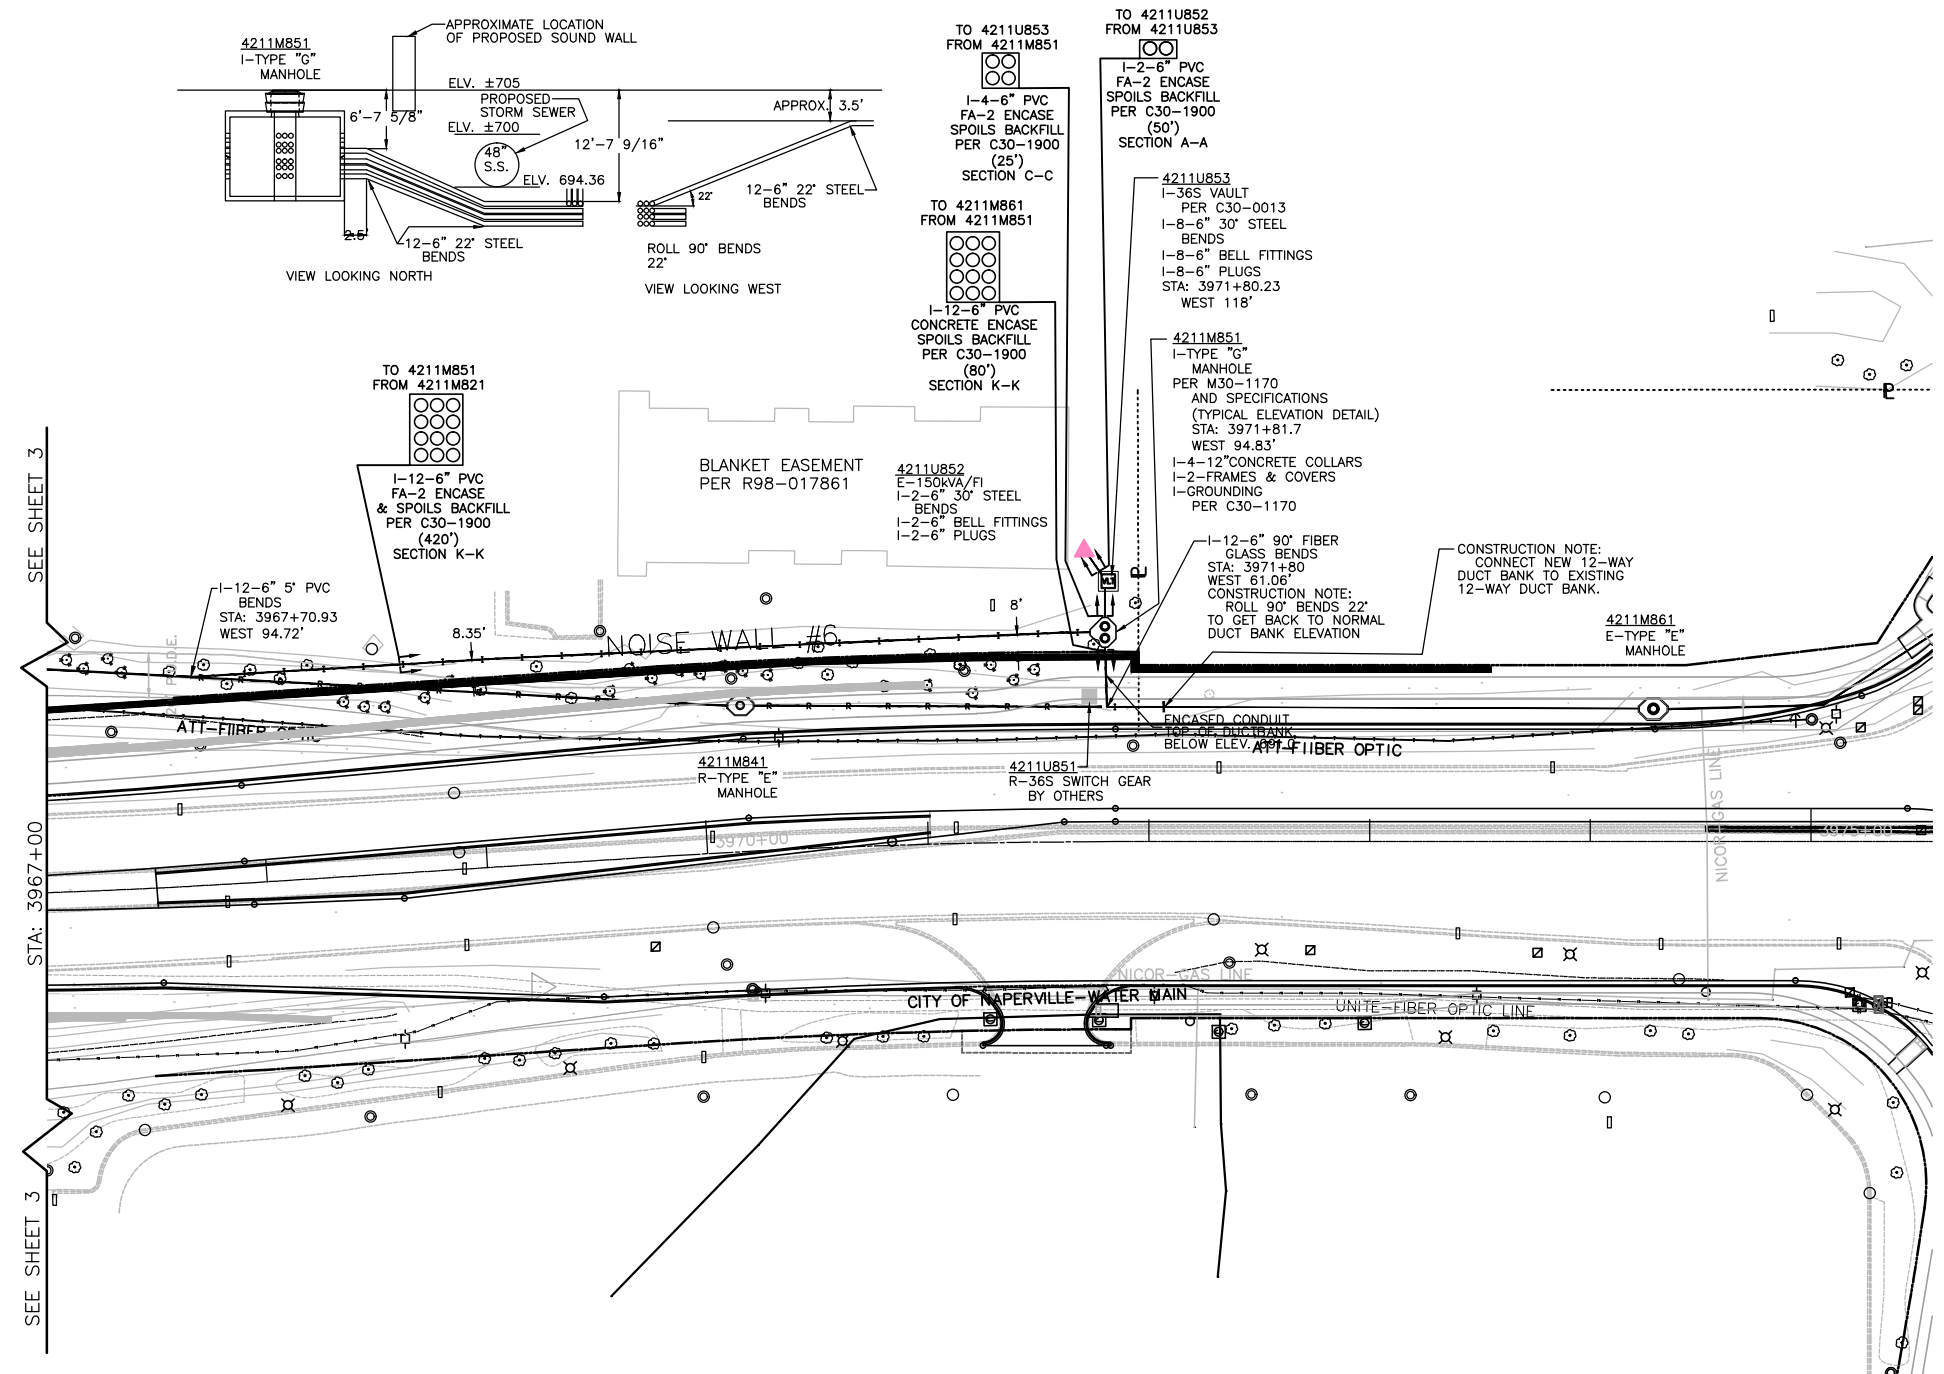


LEGEND

- EXISTING UNDERGROUND**
- ◻ E-SW. VAULT
 - ◻ E-SW. MOD.
 - ◻ E-TRANSFORMER
 - E-TYPE "A" MANHOLE
 - ◻ E-TYPE "C" MANHOLE
 - ◻ E-TYPE "D" DOUBLE OPENING MANHOLE
 - ◻ E-TYPE "E" MANHOLE
 - E-TYPE "E" MANHOLE
 - E-CONDUIT
- OVERHEAD**
- E-DISTRIBUTION/TRANSMISSION POLE
- INSTALL UNDERGROUND**
- ◻ I-SW. VAULT
 - ◻ I-TRANSFORMER VAULT
 - ◻ I-TYPE "A" MANHOLE
 - ◻ I-TYPE "E" DOUBLE OPENING MANHOLE
 - ◻ I-TYPE "G" DOUBLE OPENING MANHOLE
 - ◻ I-TYPE "G" SINGLE OPENING MANHOLE
 - I-CONDUIT
- ABANDON UNDERGROUND**
- A-CONDUIT

CALL **JULIE** 48 HRS. PRIOR TO CONSTRUCTION
1 - 800 - 892 - 0123 OR CALL 811


- NOTES:**
1. THE PROJECT ENGINEER FOR THIS JOB IS BRIAN CHAMBERLAIN AT (630)420-8853.
 2. THE PROJECT COORDINATOR FOR THIS PROJECT IS PAUL MICHALOWSKI AT (630)305-5227.
 3. CONTRACTOR IS RESPONSIBLE FOR MANHOLE PHOTOS TAKEN AT ALL CLEARLY MARKED CABLE AND ALL WALLS OF MANHOLES. PHOTOS WILL BE GIVEN TO THE GIS GROUP WITH THE AS-BUILTS.

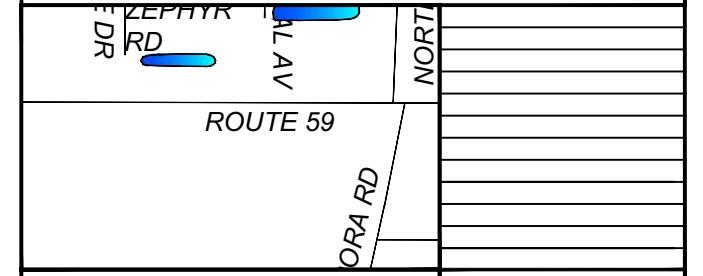

PROJECT TITLE ROUTE 59 ROAD IMPROVEMENTS			
PROJECT DESCRIPTION TO RELOCATE AND INSTALL NEW DUCTBANK AND 34KV FEEDERS			
ENGINEER BCC	DRAFTING DATE 5-11-12	MAP # 4211,4212,4223	SCALE 1 = 40
GIS DESIGN BY DL	DRAWN BY PSM	AT&T JOINT AGREEMENT # N/A	PROJECT # EU-12
CHECKED BY	APPROVED BY	CAD FILE 0060648001C8.DWG	SHEET # 8 OF 63
Naperville Department of Public Utilities Electric Division			WORK REQUEST # 60468

F.A. RTE. 338/IL 59	SECTION -2011-036-1-	COUNTY DUPAGE	TOTAL SHEETS 0	SHEET NO. 3
STA.		TO STA.		
FED. ROAD DIST. NO.	ILLINOIS	CONTRACT 60P42		

CONSTRUCTION NOTE:
CABLES TO TERMINATED AT
BUS BY OTHERS. DO NOT LET
CABLES HANG OVER CONDUIT.
TIE CABLES UP TO BUS.

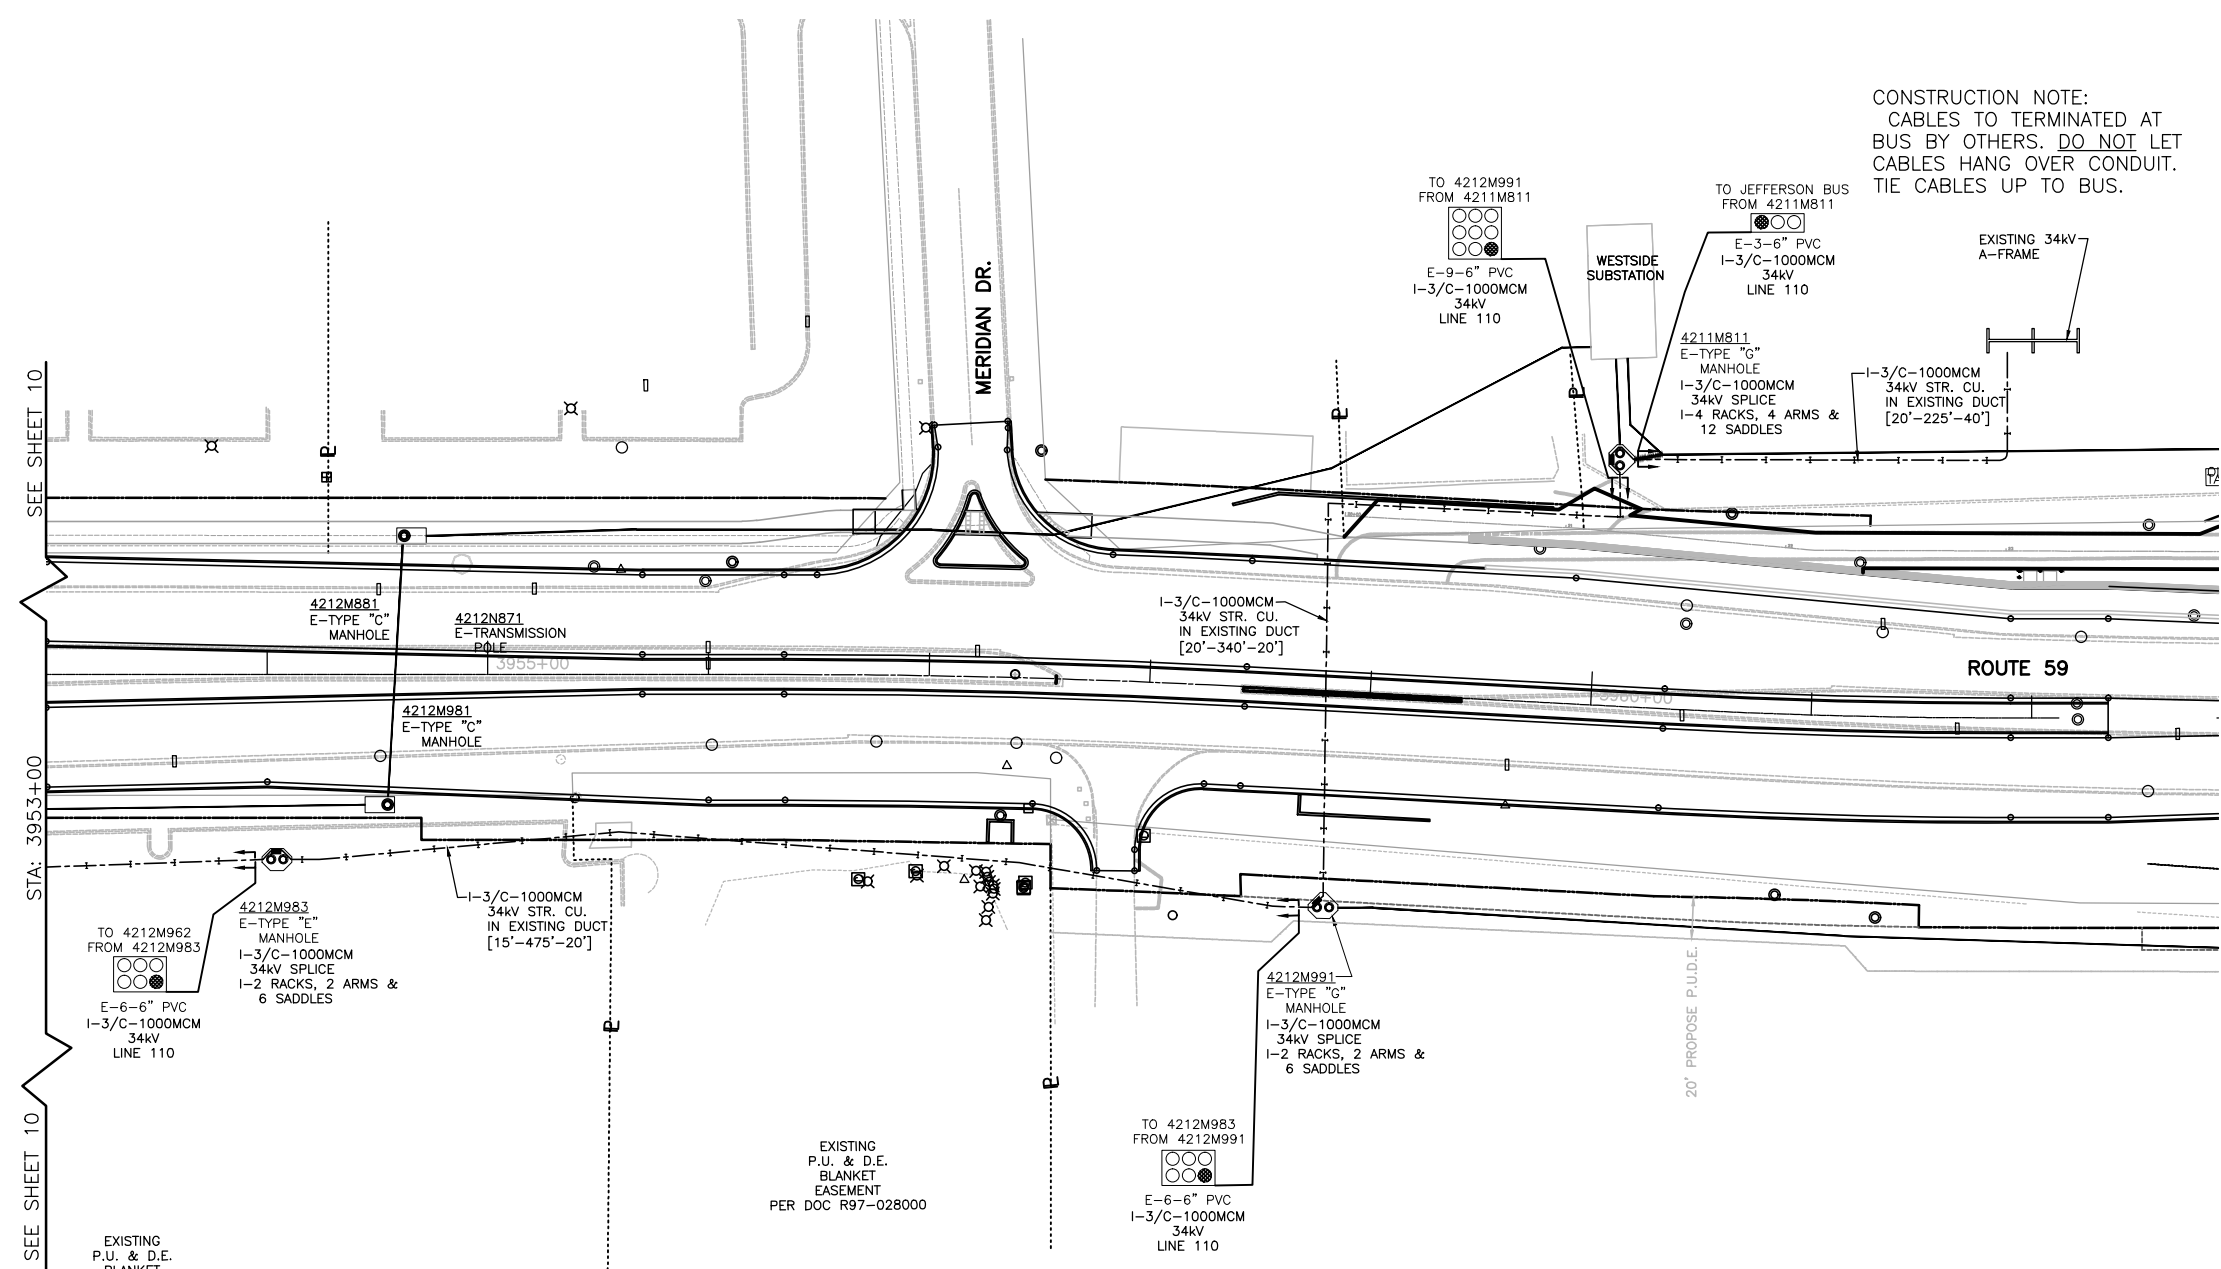

LEGEND

- EXISTING UNDERGROUND**
- E-SW. VAULT
 - E-SW. MOD.
 - ▲ E-TRANSFORMER
 - E-TYPE "A" MANHOLE
 - E-TYPE "C" MANHOLE
 - E-TYPE "C" DOUBLE OPENING MANHOLE
 - E-TYPE "D" MANHOLE
 - E-TYPE "E" MANHOLE
 - E-CONDUIT
 - E-TYPE "E" DOUBLE OPENING MANHOLE
 - E-TYPE "G" DOUBLE OPENING MANHOLE
- E-DISTRIBUTION/TRANSMISSION POLE
- INSTALL UNDERGROUND**
- E-3/C-1000MCM 34KV STR. CU. W/JKT.
 - 1-3/C-1000MCM 34KV STR. CU. W/JKT.
 - 1-SPLICE PER MFR. OR SPECS. PER C30-0460

SEE SHEET 10

STA: 3953+00


SEE SHEET 10

EXISTING P.U. & D.E. BLANKET EASEMENT PER DOC R97-028000

EXISTING P.U. & D.E. BLANKET EASEMENT PER DOC R97-028000


CALL JULIE 48 HRS. PRIOR TO CONSTRUCTION
1 - 800 - 892 - 0123 OR CALL 811

- NOTES:**
1. THE PROJECT ENGINEER FOR THIS JOB IS BRIAN CHAMBERLAIN AT (630)420-6653.
 2. THE PROJECT COORDINATOR FOR THIS PROJECT IS PAUL MICHALOWSKI AT (630)305-5227.
 3. CONTRACTOR IS RESPONSIBLE FOR MANHOLE PHOTOS TAKEN OF ALL CLEARLY MARKED CABLE AND ALL WALLS OF MANHOLES. PHOTOS WILL BE GIVEN TO THE GIS GROUP WITH THE AS-BUILTS.

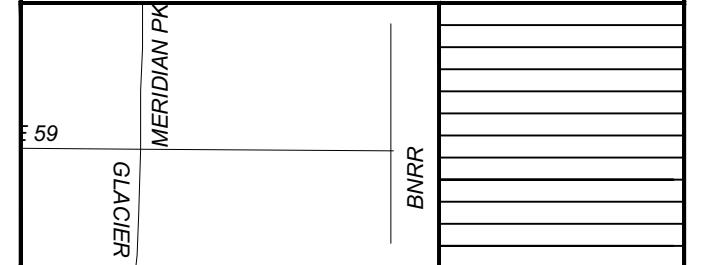

PROJECT TITLE ROUTE 59 ROAD IMPROVEMENTS		DESIGN REVISION DATES	
PROJECT DESCRIPTION TO RELOCATE AND INSTALL NEW DUCTBANK AND 34KV FEEDERS			
ENGINEER BCC	DRAFTING DATE 5-11-12	MAP # 4211,4212,4223	SCALE 1 = 40
DESIGN BY DL	REVISIONS DATE	FILED JOB AGREEMENT # N/A	PROJECT # EU-12
CHECKED BY PSM	APPROVED BY	CAD FILE 0060648001C9.DWG	SHEET # 9 OF 63
Naperville Department of Public Utilities Electric Division			WORK REQUEST # 60468

F.A. RTE. 338/IL 59	SECTION 2011-036	COUNTY DUPAGE	TOTAL SHEETS 0	SHEET NO. 3
STA.		TO STA.		
FED. ROAD DIST. NO.		ILLINOIS CONTRACT 60P42		

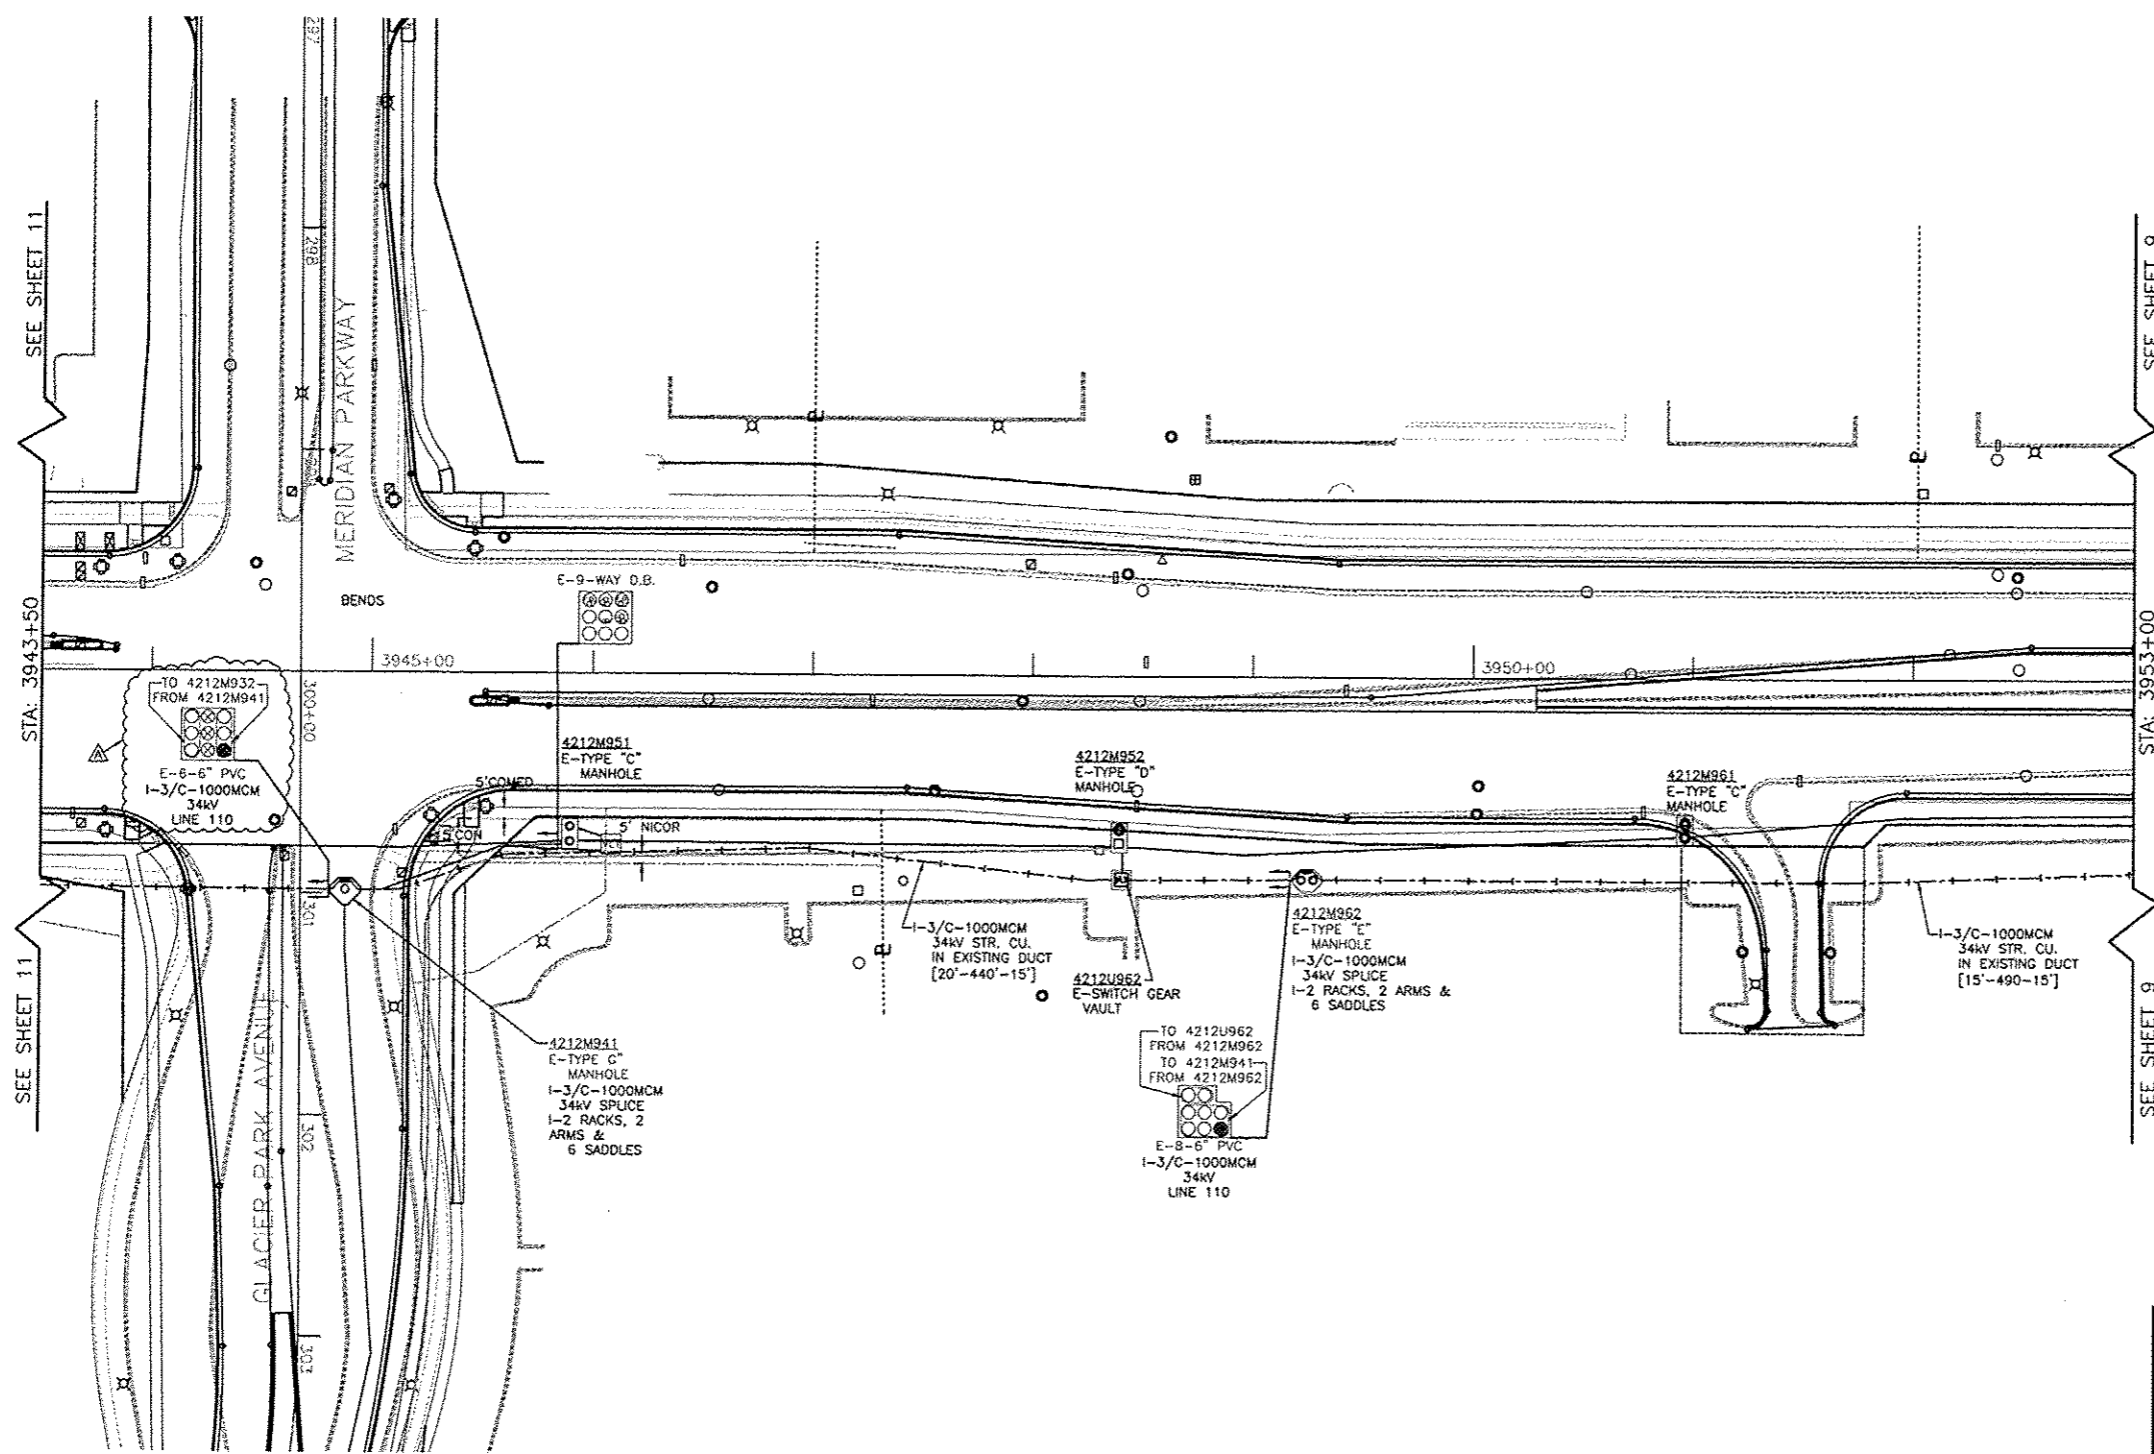

LEGEND

- EXISTING UNDERGROUND**
- E-SW. VAULT
 - E-SW. MOD.
 - E-TRANSFORMER
 - E-TYPE "A" MANHOLE
 - E-TYPE "C" MANHOLE
 - E-TYPE "C" DOUBLE OPENING MANHOLE
 - E-TYPE "D" MANHOLE
 - E-TYPE "E" MANHOLE
 - E-CONDUIT
 - E-TYPE "E" DOUBLE OPENING MANHOLE
 - E-TYPE "G" DOUBLE OPENING MANHOLE
- OVERHEAD**
- E-DISTRIBUTION/TRANSMISSION POLE
 - E-3/C-1000MCM 34KV STR. CU. W/JKT.
- INSTALL UNDERGROUND**
- I-3/C-1000MCM 34KV STR. CU. W/JKT.
 - I-SPLICE PER MFR. OR SPECS. PER C30-0460

CALL JULIE 48 HRS. PRIOR TO CONSTRUCTION
1-800-892-0123 OR CALL 811

NOTES:

- THE PROJECT ENGINEER FOR THIS JOB IS BRIAN CHAMBERLAIN AT (630)420-6653.
- THE PROJECT COORDINATOR FOR THIS PROJECT IS PAUL LICHALOWSKI AT (630)300-8227.
- CONTRACTOR IS RESPONSIBLE FOR MANHOLE PHOTOS TAKEN OF ALL CLEARLY MARKED CABLE AND ALL WALLS OF MANHOLES. PHOTOS WILL BE GIVEN TO THE GIS GROUP WITH THE AS-BUILTS.

TE 59	MERIDIAN Pk	GLACIER Pk	ADDENDUM A 7-16-12

PROJECT TITLE: **ROUTE 59 ROAD IMPROVEMENTS**


PROJECT DESCRIPTION: **TO RELOCATE AND INSTALL NEW DUCTBANK AND 34KV FEEDERS.**

ENGINEER: BCC	DRAWING DATE: 5-11-12	REV #	4211,4212,4223	SCALE: 1 = 40
DESIGNED BY: DL	DESIGNED BY: PSM	REVISIONS DATE	N/A	PROJECT # EU-12
CHECKED BY:	APPROVED BY:	DWG FILE	0060648001C10.DWG	SHEET # 10 OF 63

Naperville Department of Public Utilities
Electric Division

60468

F.A. RTE. 338/IL 59	SECTION 204-036	COUNTY DUPAGE	TOTAL SHEETS 0	SHEET NO. 3
STA.		TO STA.		
FED. ROAD DIST. NO.	ILLINOIS	CONTRACT 60P42		

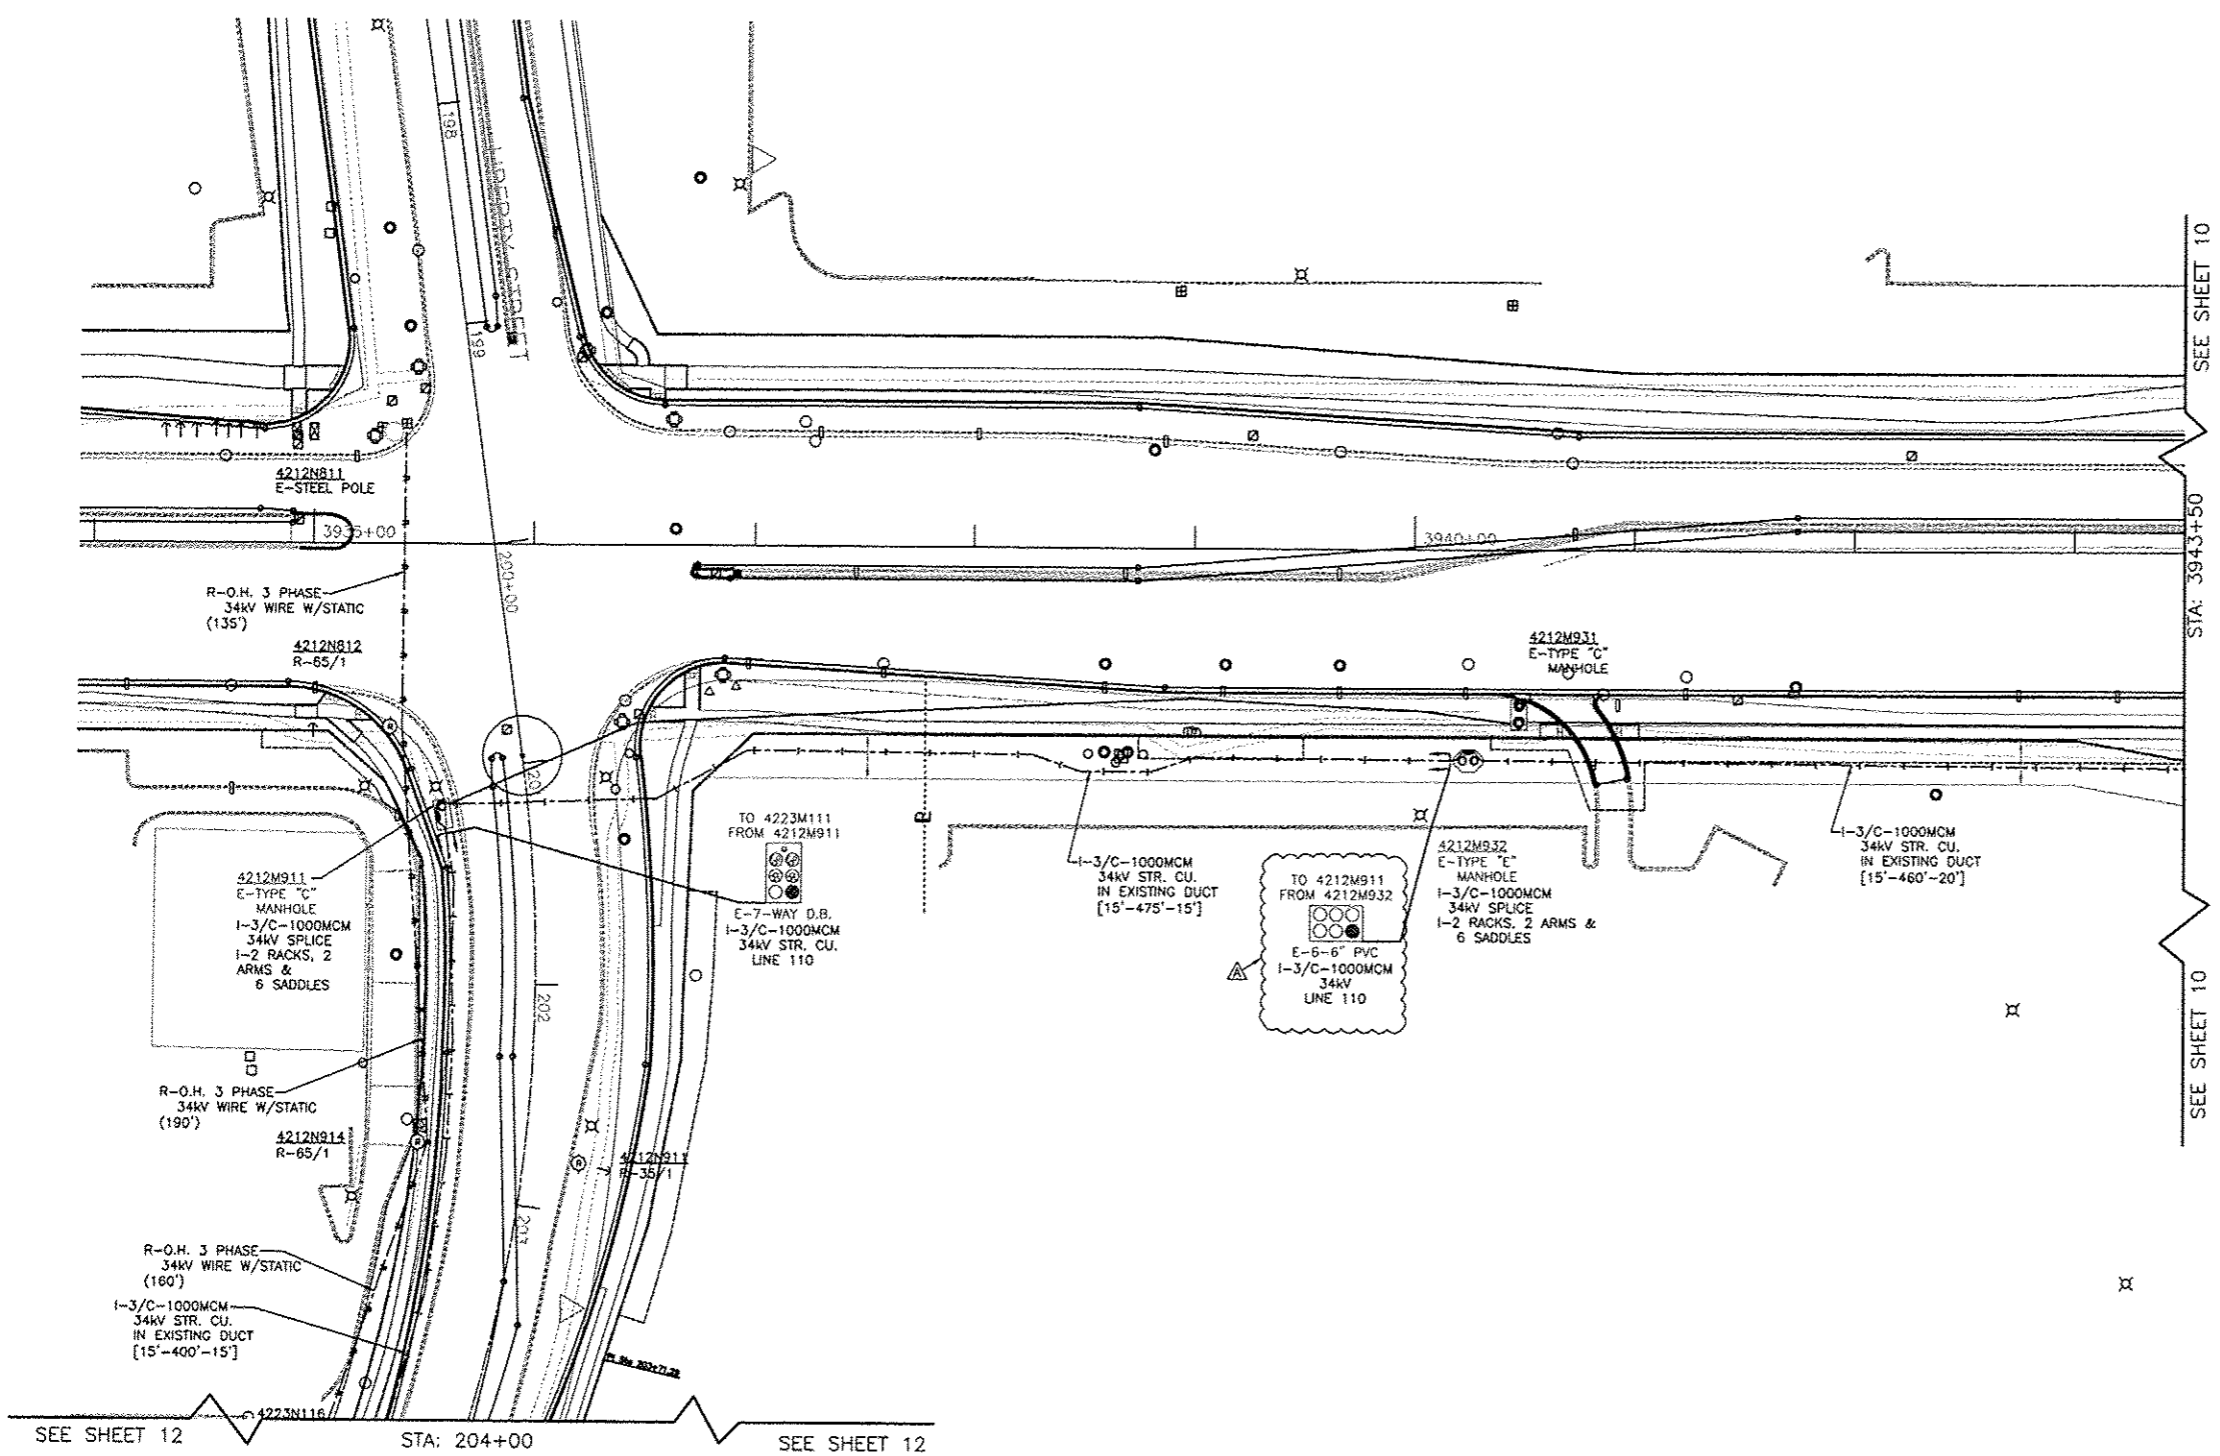

LEGEND

- EXISTING UNDERGROUND**
- E-SW. VAULT
 - E-SW. MOD.
 - E-TRANSFORMER
 - E-TYPE "A" MANHOLE
 - E-TYPE "C" MANHOLE
 - E-TYPE "C" DOUBLE OPENING MANHOLE
 - E-TYPE "D" MANHOLE
 - E-TYPE "E" MANHOLE
 - E-CONDUIT
 - E-TYPE "E" DOUBLE OPENING MANHOLE
 - E-TYPE "C" DOUBLE OPENING MANHOLE
- OVERHEAD**
- E-DISTRIBUTION/TRANSMISSION POLE
 - E-3/C-1000MCM 34KV STR. CU. W/JKT.
- INSTALL UNDERGROUND**
- I-3/C-1000MCM 34KV STR. CU. W/JKT.
 - I-SPLICE PER MFR. OR SPECS. PER C30-0460
- REMOVE OVERHEAD**
- R-DISTRIBUTION/TRANSMISSION POLE 65/1 THRU 65/3 POLES
 - R-3/C-1000MCM 34KV STR. CU. W/JKT.
 - R-O.H. 3 PHASE 34KV WIRE W/STATIC

CALL JULIE 48 HRS. PRIOR TO CONSTRUCTION
1 - 800 - 892 - 0123 OR CALL 811

NOTES:

- THE PROJECT ENGINEER FOR THIS JOB IS BRIAN CHAMBERLAIN AT (630)420-8853.
- THE PROJECT COORDINATOR FOR THIS PROJECT IS PAUL WACHLOWSKI AT (630)305-8227.
- CONTRACTOR IS RESPONSIBLE FOR MANHOLE PHOTOS TAKEN OF ALL CLEARLY MARKED CABLE AND ALL WALLS OF MANHOLES. PHOTOS WILL BE GIVEN TO THE GSE GROUP WITH THE AS-BUILTS.

	ADDENDUM A 7-16-12
	DESIGN REVISION DATES
PROJECT TITLE ROUTE 59 ROAD IMPROVEMENTS	
PROJECT DESCRIPTION TO RELOCATE AND INSTALL NEW DUCTBANK AND 34kV FEEDERS	
DESIGNER BCC	DATE 5-11-12
DESIGN NO. 4211, 4212, 4223	SCALE 1 = 40
DATE DESIGNED BY DL	DATE CHECKED BY PSM
DATE DESIGNED BY N/A	DATE CHECKED BY EU-12
CHECKED BY 0060648001C11.DWG	DATE 11 OF 63

Naperville Department of Public Utilities Electric Division

60468

F.A. RTE. 338/IL 59	SECTION -2011-036-1-	COUNTY DUPAGE	TOTAL SHEETS 0	SHEET NO. 3
STA.		TO STA.		
FED. ROAD DIST. NO.	ILLINOIS	CONTRACT 60P42		

LEGEND

EXISTING UNDERGROUND

- ⊖ E-SW. VAULT
- E-SW. MOD.
- ▲ E-TRANSFORMER
- E-TYPE "A" MANHOLE
- E-TYPE "C" MANHOLE
- ⊙ E-TYPE "C" DOUBLE OPENING MANHOLE
- ⊖ E-TYPE "D" MANHOLE
- ⊙ E-TYPE "E" MANHOLE
- E-CONDUIT
- ⊙ E-TYPE "E" DOUBLE OPENING MANHOLE
- ⊙ E-TYPE "G" DOUBLE OPENING MANHOLE

OVERHEAD


- E-DISTRIBUTION/TRANSMISSION POLE
- E-3/C-1000MCM 34kV STR. CU. W/JKT.

INSTALL UNDERGROUND

- I-3/C-1000MCM 34kV STR. CU. W/JKT.
- I-SPLICE PER MFR. OR SPECS. PER C30-0460

REMOVE OVERHEAD

- ⊙ R-DISTRIBUTION/TRANSMISSION POLE 65/1 THRU 65/3 POLES
- R-3/C-1000MCM 34kV STR. CU. W/JKT.
- R-O.H. 3 PHASE 34kV WIRE W/STATIC

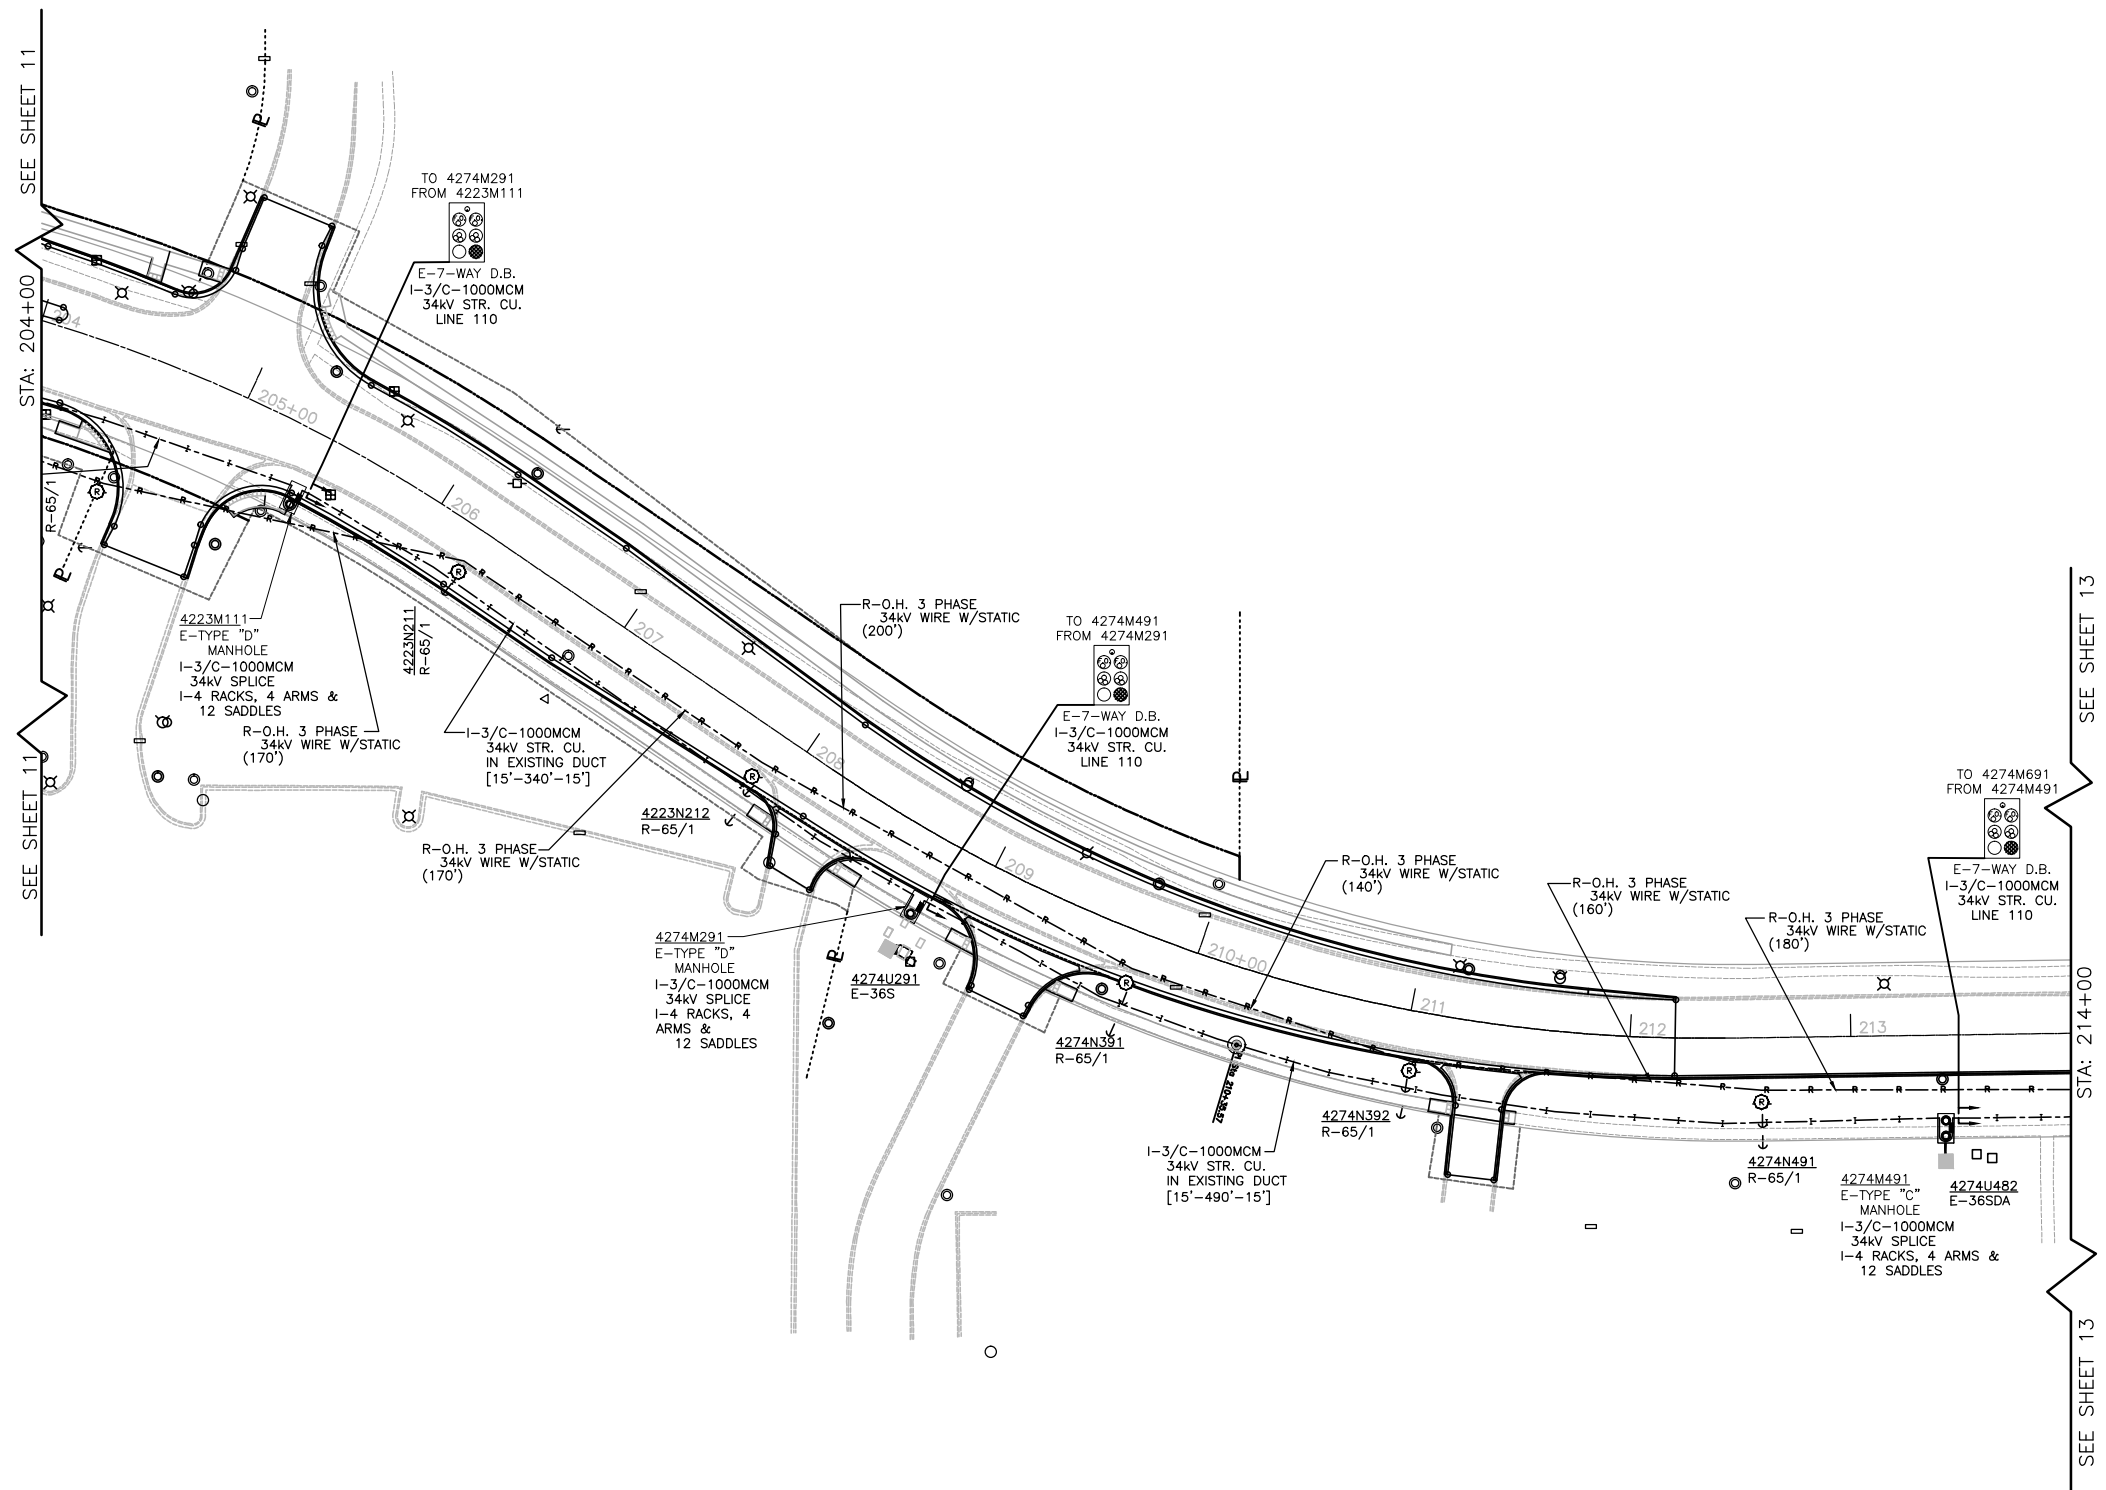


CALL JULIE 48 HRS. PRIOR TO CONSTRUCTION
1 - 800 - 892 - 0123 OR CALL 811

NOTES:
1. THE PROJECT ENGINEER FOR THIS JOB IS BRIAN CHAMBERLAIN AT (630)420-6853.
2. THE PROJECT COORDINATOR FOR THIS PROJECT IS PAUL MICHALOWSKI AT (630)305-8227.
3. CONTRACTOR IS RESPONSIBLE FOR MANHOLE PHOTOS TAKEN OF ALL CLEARLY MARKED CABLE AND ALL WALLS OF MANHOLES. PHOTOS WILL BE GIVEN TO THE GIS GROUP WITH THE AS-BUILTS.

LOCATION MAP		DESIGN REVISION DATES	
PROJECT TITLE ROUTE 59 ROAD IMPROVEMENTS			
PROJECT DESCRIPTION TO RELOCATE AND INSTALL NEW DUCTBANK AND 34KV FEEDERS			
ENGINEER BCC	DRAFTING DATE 5-11-12	MAP # 4211,4212,4223	SCALE 1 = 40
DESIGN BY DI	REVISIONS DATE PSM	FILE #/AGREEMENT # N/A	PROJECT # EU-12
CHECKED BY	APPROVED BY	DWG FILE 0060648001C12.DWG	SHEET # 12 OF 63
Naperville Department of Public Utilities Electric Division			WORK REQUEST # 60468

F.A. RTE. 338/IL 59	SECTION -2011-036-1-	COUNTY DUPAGE	TOTAL SHEETS 0	SHEET NO. 3
STA.		TO STA.		
FED. ROAD DIST. NO.	ILLINOIS	CONTRACT 60P42		

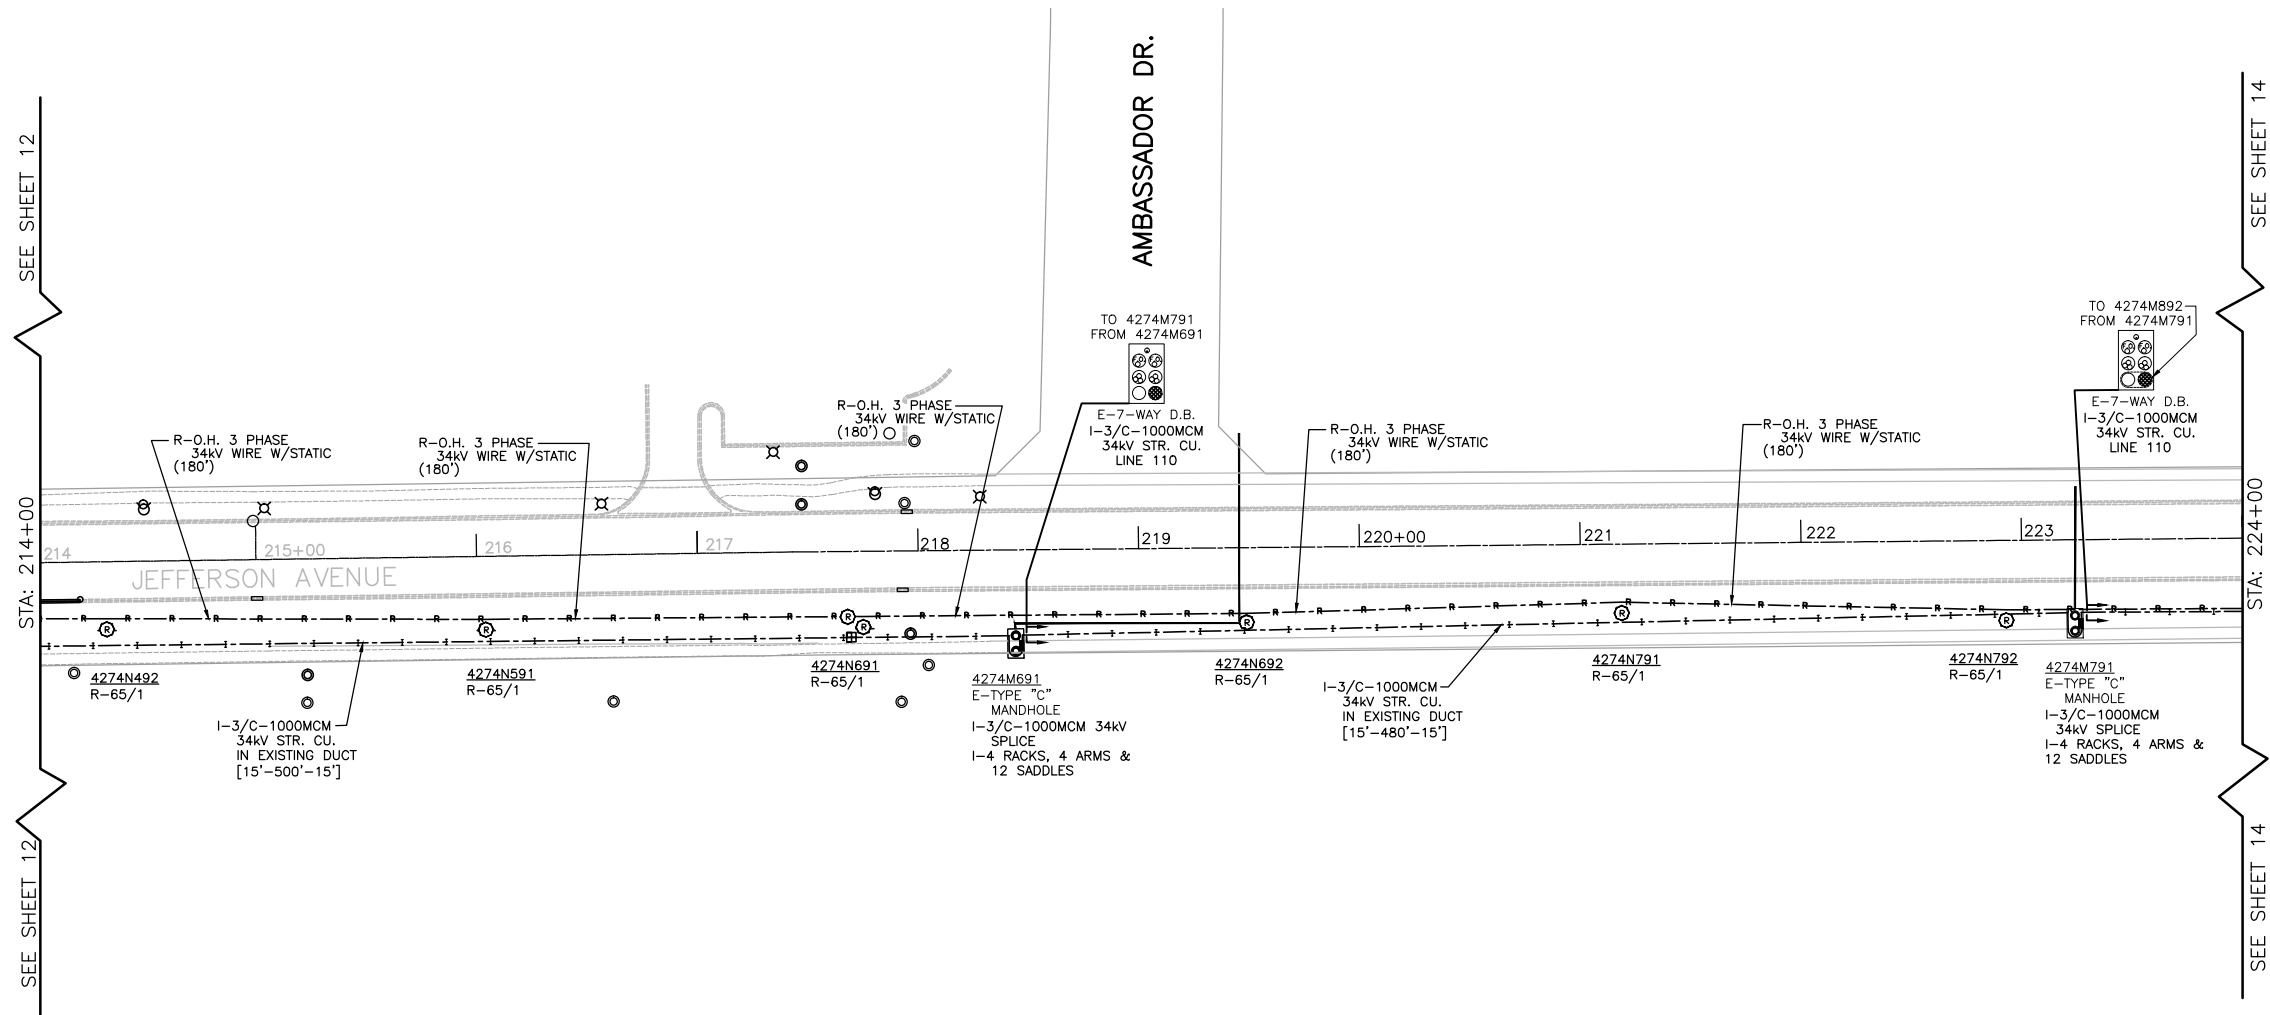


LEGEND

- EXISTING UNDERGROUND**
- E-SW. VAULT
 - E-SW. MOD.
 - E-TRANSFORMER
 - E-TYPE "A" MANHOLE
 - E-TYPE "C" MANHOLE
 - E-TYPE "C" DOUBLE OPENING MANHOLE
 - E-TYPE "D" MANHOLE
 - E-TYPE "E" MANHOLE
 - E-CONDUIT
 - E-TYPE "E" DOUBLE OPENING MANHOLE
 - E-TYPE "G" DOUBLE OPENING MANHOLE
- OVERHEAD**
- E-DISTRIBUTION/TRANSMISSION POLE
 - E-3/C-1000MCM 34KV STR. CU. W/JKT.
- INSTALL UNDERGROUND**
- I-3/C-1000MCM 34KV STR. CU. W/JKT.
 - I-SPLICE PER MFR. OR SPECS. PER C30-0460
- REMOVE OVERHEAD**
- R-DISTRIBUTION/TRANSMISSION POLE 65/1 THRU 65/3 POLES
 - R-3/C-1000MCM 34KV STR. CU. W/JKT.
 - R-O.H. 3 PHASE 34KV WIRE W/STATIC


CALL JULIE 48 HRS. PRIOR TO CONSTRUCTION
1 - 800 - 892 - 0123 OR CALL 811

- NOTES:**
1. THE PROJECT ENGINEER FOR THIS JOB IS BRIAN CHAMBERLAIN AT (630)420-6853.
 2. THE PROJECT COORDINATOR FOR THIS PROJECT IS PAUL MICHALOWSKI AT (630)305-5227.
 3. CONTRACTOR IS RESPONSIBLE FOR MANHOLE PHOTOS TAKEN OF ALL CLEARLY MARKED CABLE AND ALL WALLS OF MANHOLES. PHOTOS WILL BE GIVEN TO THE GIS GROUP WITH THE AS-BUILTS.

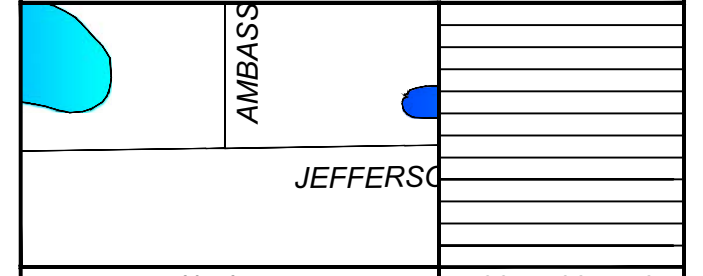

PROJECT TITLE ROUTE 59 ROAD IMPROVEMENTS		DESIGN REVISION DATES	
PROJECT DESCRIPTION TO RELOCATE AND INSTALL NEW DUCTBANK AND 34KV FEEDERS			
ENGINEER BCC	DRAFTING DATE 5-11-12	MAP # 4211.4212.4223	SCALE 1 = 40
DESIGN BY DL	REVISIONS DATE	PERMIT AGREEMENT # N/A	PROJECT # EU-12
CHECKED BY	APPROVED BY	CAD FILE 0060648001C13.DWG	SHEET # 13 OF 63
Naperville Department of Public Utilities Electric Division			WORK REQUEST # 60468

F.A. RTE. 338/IL 59	SECTION -2011-036-	COUNTY DUPAGE	TOTAL SHEETS 0	SHEET NO. 3
STA.		TO STA.		
FED. ROAD DIST. NO.	ILLINOIS	CONTRACT 60P42		

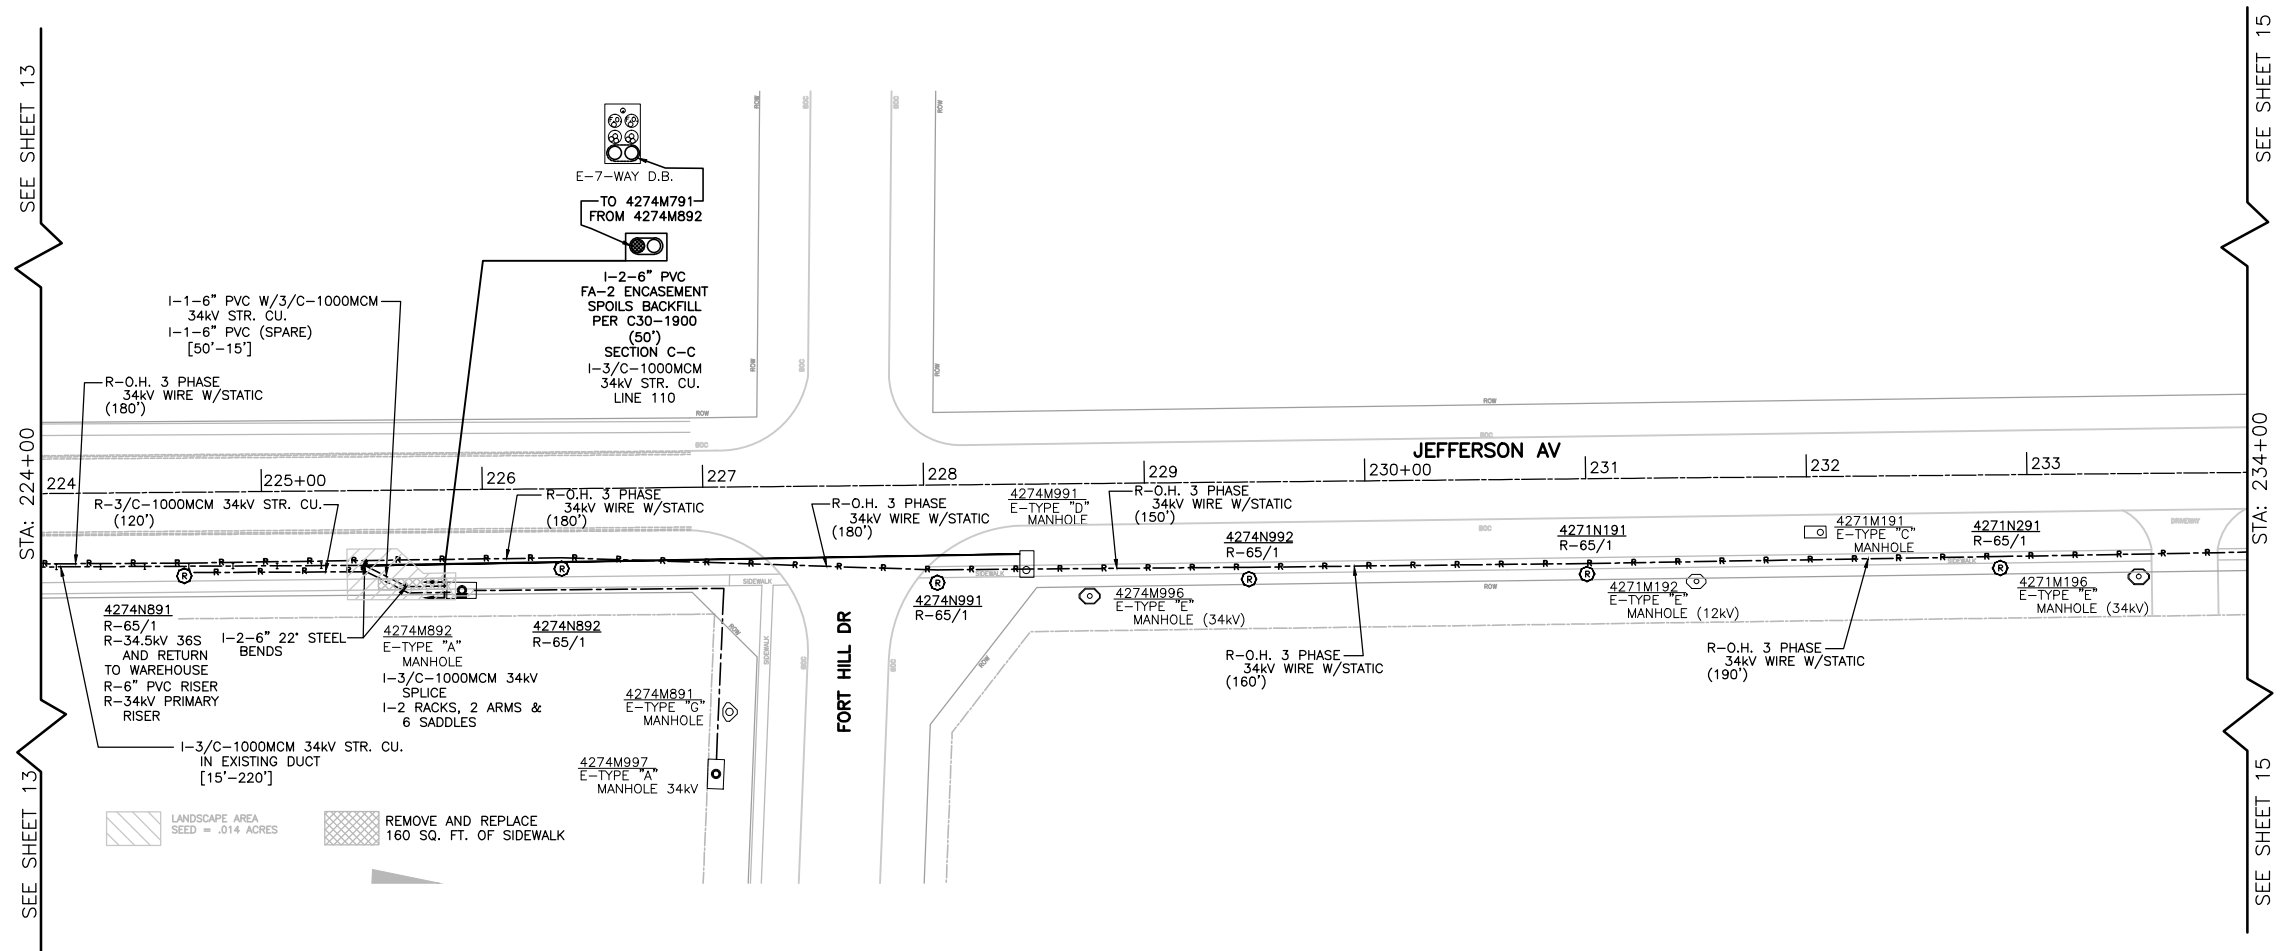


LEGEND

- EXISTING UNDERGROUND**
- MLT E-SW. VAULT
 - E-SW. MOD.
 - ▲ E-TRANSFORMER
 - E-TYPE "A" MANHOLE
 - ⊙ E-TYPE "C" MANHOLE
 - ⊕ E-TYPE "C" DOUBLE OPENING MANHOLE
 - ⊖ E-TYPE "D" MANHOLE
 - ⊗ E-TYPE "E" MANHOLE
 - E-CONDUIT
 - ⊕⊕ E-TYPE "E" DOUBLE OPENING MANHOLE
 - ⊕⊖ E-TYPE "G" DOUBLE OPENING MANHOLE
- OVERHEAD**
- E-DISTRIBUTION/TRANSMISSION POLE
 - E-3/C-1000MCM 34kV STR. CU. W/JKT.
- INSTALL UNDERGROUND**
- I-3/C-1000MCM 34kV STR. CU. W/JKT.
 - I-SPLICE PER MFR. OR SPECS. PER C30-0460
- REMOVE OVERHEAD**
- ⊙ R-DISTRIBUTION/TRANSMISSION POLE 65/1 THRU 65/3 POLES
 - R-3/C-1000MCM 34kV STR. CU. W/JKT.
 - R-O.H. 3 PHASE 34kV WIRE W/STATIC


CALL JULIE 48 HRS. PRIOR TO CONSTRUCTION
1 - 800 - 892 - 0123 OR CALL 811

- NOTES:**
1. THE PROJECT ENGINEER FOR THIS JOB IS BRIAN CHAMBERLAIN AT (630)420-6653.
 2. THE PROJECT COORDINATOR FOR THIS PROJECT IS PAUL MICHALOWSKI AT (630)305-5227.
 3. CONTRACTOR IS RESPONSIBLE FOR MANHOLE PHOTOS TAKEN OF ALL CLEARLY MARKED CABLE AND ALL WALLS OF MANHOLES. PHOTOS WILL BE GIVEN TO THE GIS GROUP WITH THE AS-BUILTS.

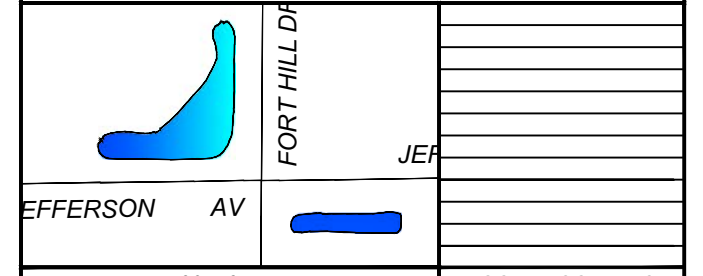

PROJECT TITLE		ROUTE 59 ROAD IMPROVEMENTS	
PROJECT DESCRIPTION		TO RELOCATE AND INSTALL NEW DUCTBANK AND 34KV FEEDERS	
ENGINEER	DRAFTING DATE	MAP #	SCALE
BCC	5-11-12	4211,4212,4223	1 = 40
DESIGN BY	REVISIONS DATE	PERMIT AGREEMENT #	PROJECT #
DL	PSM	N/A	EU-12
CHECKED BY	APPROVED BY	CAD FILE	SHEET #
		0060648001C14.DWG	14 OF 63
Naperville Department of Public Utilities Electric Division			WORK REQUEST #
			60468

F.A. RTE. 338/IL 59	SECTION -2011-036-	COUNTY DUPAGE	TOTAL SHEETS 0	SHEET NO. 3
STA.		TO STA.		
FED. ROAD DIST. NO.	ILLINOIS	CONTRACT 60P42		

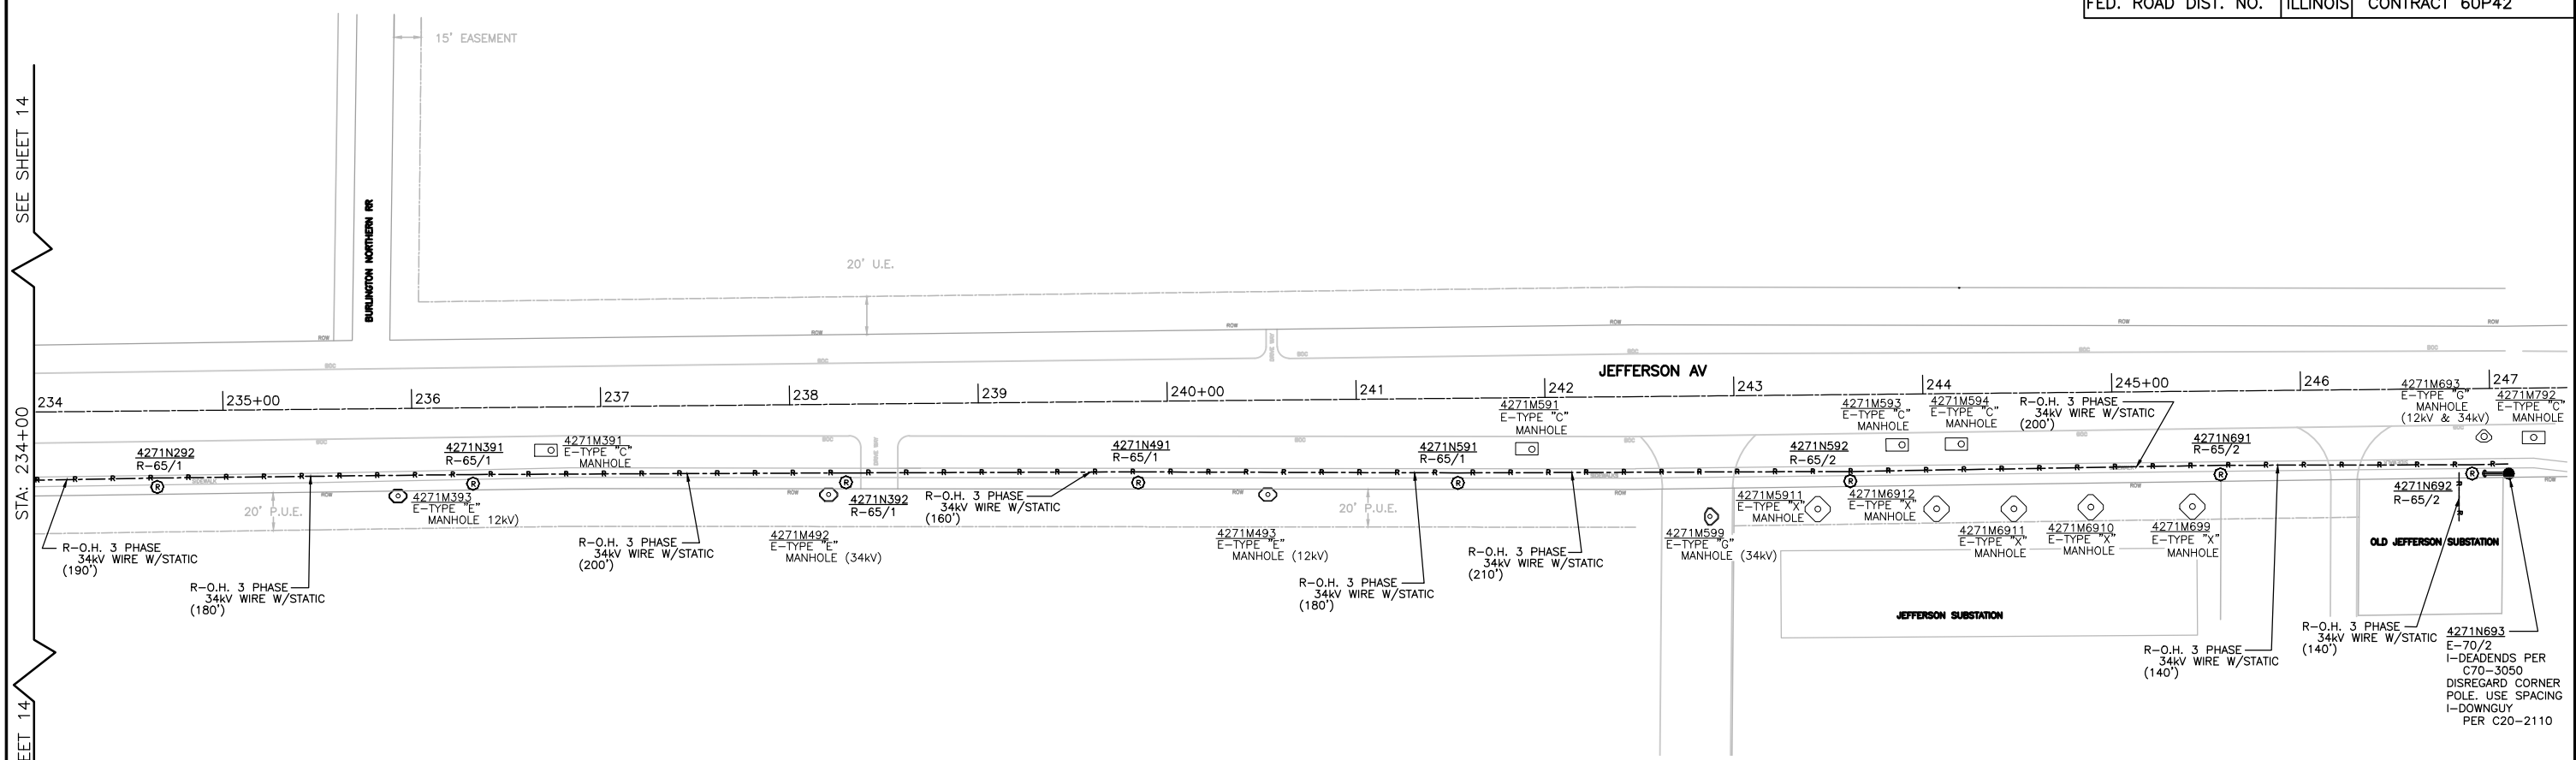


SEE SHEET 14
STA: 234+00
SEE SHEET 14

LEGEND


- EXISTING UNDERGROUND**
- ⬜ VLT E-SW. VAULT
 - ⬜ E-SW. MOD.
 - ▲ E-TRANSFORMER
 - E-TYPE "A" MANHOLE
 - E-TYPE "C" MANHOLE
 - E-TYPE "C" DOUBLE OPENING MANHOLE
 - E-TYPE "D" MANHOLE
 - E-TYPE "E" MANHOLE
 - E-TYPE "E" DOUBLE OPENING MANHOLE
 - E-TYPE "G" DOUBLE OPENING MANHOLE
- OVERHEAD**
- E-DISTRIBUTION/TRANSMISSION POLE
 - E-3/C-1000MCM 34KV STR. CU. W/JKT.
- INSTALL UNDERGROUND**
- I-3/C-1000MCM 34KV STR. CU. W/JKT.
 - I-SPLICE PER MFR. OR SPECS. PER C30-0460
- REMOVE OVERHEAD**
- R-DISTRIBUTION/TRANSMISSION POLE 65/1 THRU 65/3 POLES
 - R-3/C-1000MCM 34KV STR. CU. W/JKT.
 - R-O.H. 3 PHASE 34KV WIRE W/STATIC

CALL JULIE 48 HRS. PRIOR TO CONSTRUCTION
1 - 800 - 892 - 0123 OR CALL 811




- NOTES:**
1. THE PROJECT ENGINEER FOR THIS JOB IS BRIAN CHAMBERLAIN AT (630)420-8853.
 2. THE PROJECT COORDINATOR FOR THIS PROJECT IS PAUL MICHALOWSKI AT (630)305-8227.
 3. CONTRACTOR IS RESPONSIBLE FOR MANHOLE PHOTOS TAKEN OF ALL CLEARLY MARKED CABLE AND ALL WALLS OF MANHOLES. PHOTOS WILL BE GIVEN TO THE GIS GROUP WITH THE AS-BUILTS.

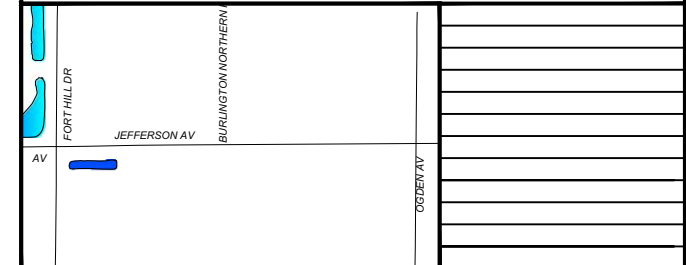

PROJECT TITLE ROUTE 59 ROAD IMPROVEMENTS		DESIGN REVISION DATES	
PROJECT DESCRIPTION TO RELOCATE AND INSTALL NEW DUCTBANK AND 34KV FEEDERS			
ENGINEER BCC	DRAFTING DATE 5-11-12	MAP # 4211,4212,4223	SCALE 1" = 40'
DESIGN BY DL	DRAWN BY PSM	PERMIT AGREEMENT # N/A	PROJECT # EU-12
CHECKED BY	APPROVED BY	DWG FILE 0060648001C15.DWG	SHEET # 15 OF 63
Naperville Department of Public Utilities Electric Division			WORK REQUEST # 60468

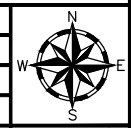

F.A.P. RTE.	SECTION	COUNTY	TOTAL SHEETS	SHEET NO.
338/IL 59	2011-036	DUPAGE		
FED. ROAD DIST. NO.		ILLINOIS	CONTRACT 60P42	
		FED. AID PROJECT		

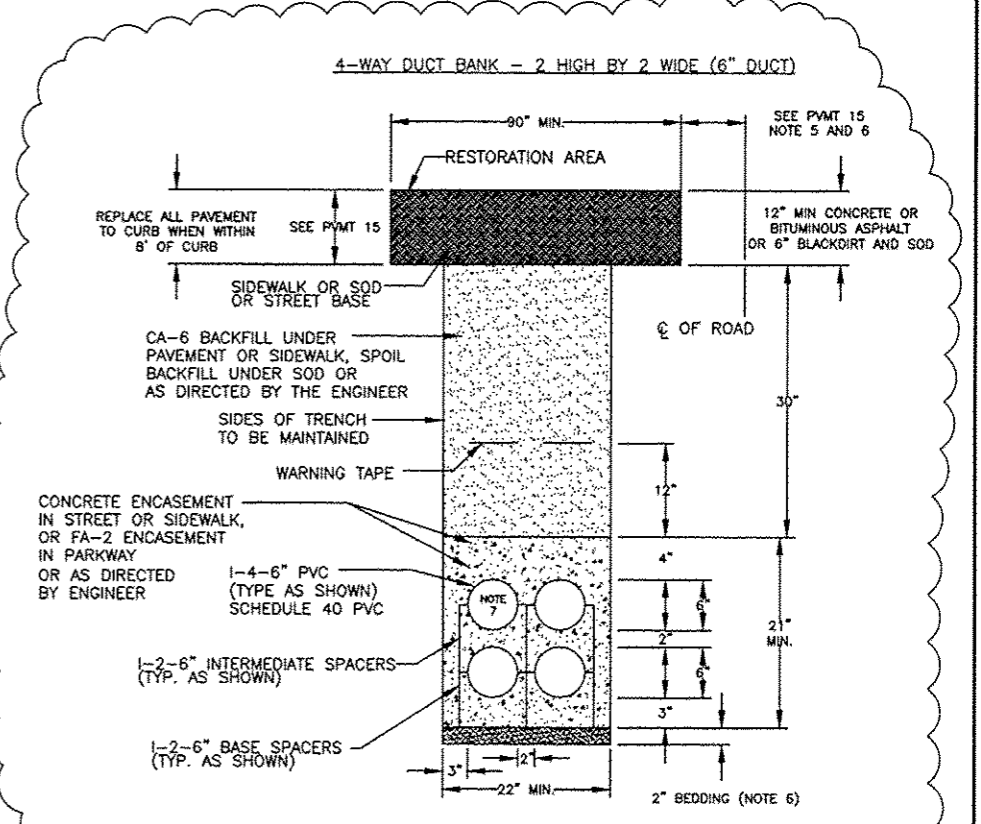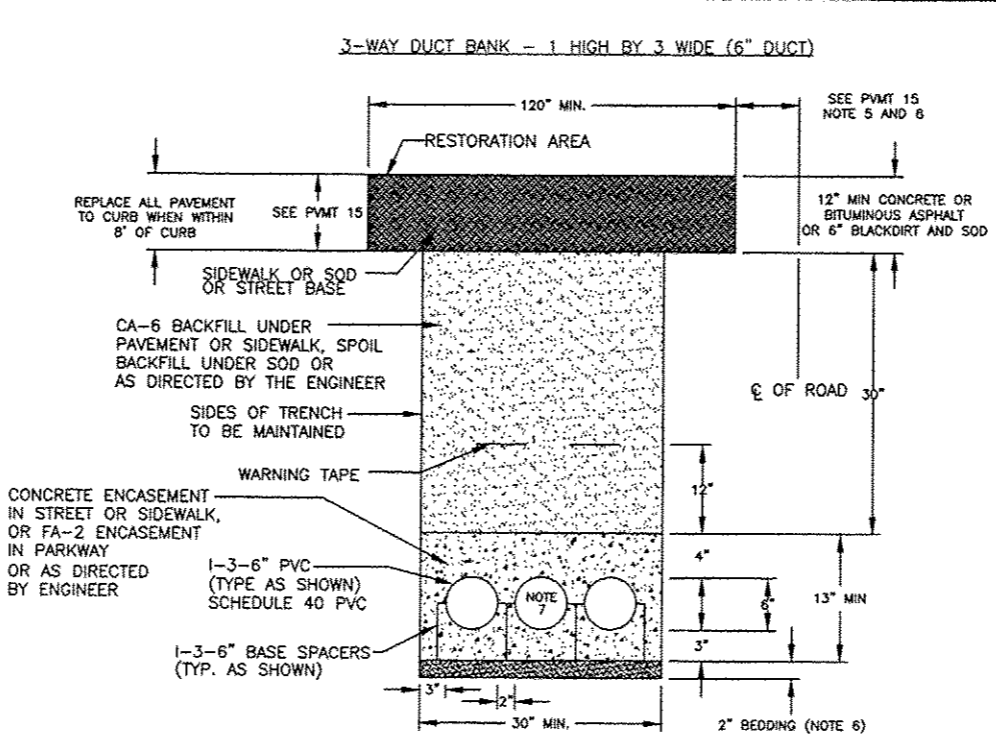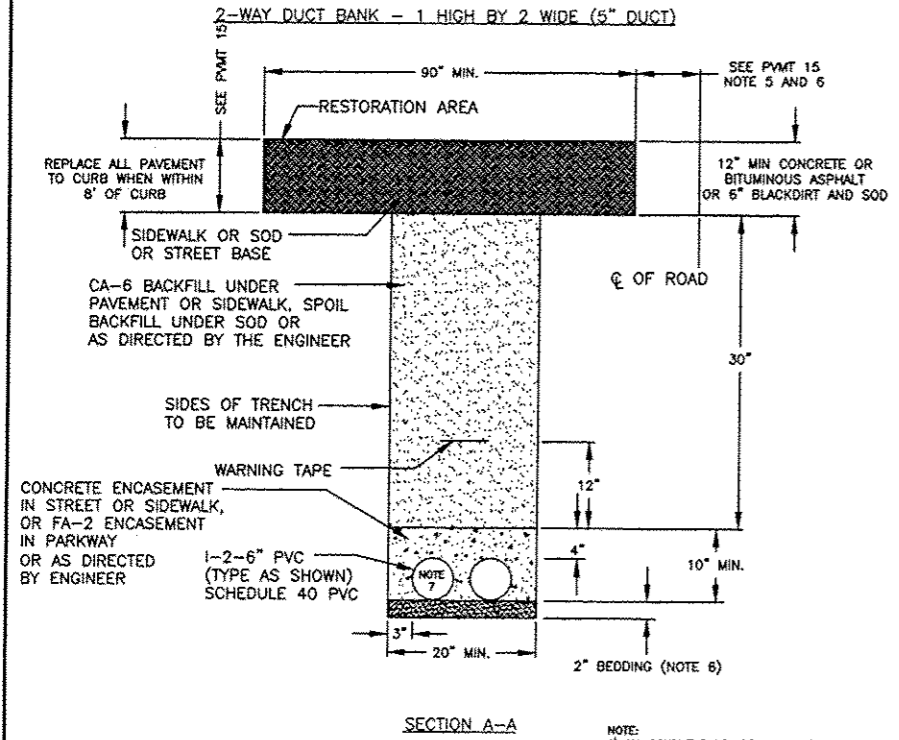

CITY OF NAPERVILLE
DEPARTMENT OF PUBLIC UTILITIES-ELECTRIC
TYPICAL CONDUIT SECTION A-A
ROUTE 59

APPROXIMATE LENGTH = (NONE) CONCRETE ENCASE SPOIL BACKFILL
APPROXIMATE LENGTH = (NONE) CONCRETE ENCASE CA-6 BACKFILL
APPROXIMATE LENGTH = 170 FEET (FA-2 ENCASED) SPOIL BACKFILL
APPROXIMATE LENGTH = (NONE) (FA-2 ENCASED) CA-6 BACKFILL

- NOTE:
- 1) ALL CONDUIT RUNS ARE ASSEMBLED IN FIELD.
 - 2) INSTALL 1/8" DIA. (PULLING) NYLON ROPE IN EACH DUCT.
 - 3) ALL CABLES BY OTHERS.
 - 4) CONDUIT AND SPACERS AND ALL OTHER MATERIALS INCLUDING GLUE, COUPLINGS AND MANHOLE ENTRANCES FURNISHED BY CITY OF NAPERVILLE AND INSTALLED BY CONTRACTOR.
 - 5) INSTALL BEDDING FA-2 OR CA-6.
 - 6) INSTALL MULE TAPE OR #12 COPPER WIRE THIN IN THIS DUCT ONLY.
 - 7) CONTRACTOR TO INSTALL DUCT RUN PER C30-1900.

CITY OF NAPERVILLE
DEPARTMENT OF PUBLIC UTILITIES-ELECTRIC
TYPICAL CONDUIT SECTION B-B
ROUTE 59



APPROXIMATE LENGTH = (NONE) CONCRETE ENCASE SPOIL BACKFILL
APPROXIMATE LENGTH = 285 FEET CONCRETE ENCASE CA-6 BACKFILL
APPROXIMATE LENGTH = (NONE) (FA-2 ENCASED) SPOIL BACKFILL
APPROXIMATE LENGTH = (NONE) (FA-2 ENCASED) CA-6 BACKFILL

- NOTE:
- 1) THE BASE AND INTERMEDIATE 6" SPACERS SHALL BE INSTALLED AT 5' CENTERS.
 - 2) ALL CONDUIT RUNS ARE ASSEMBLED IN FIELD.
 - 3) INSTALL 1/8" DIA. (PULLING) NYLON ROPE IN EACH DUCT.
 - 4) ALL CABLES BY OTHERS.
 - 5) CONDUIT AND SPACERS AND ALL OTHER MATERIALS INCLUDING GLUE, COUPLINGS AND MANHOLE ENTRANCES FURNISHED BY CITY OF NAPERVILLE AND INSTALLED BY CONTRACTOR.
 - 6) INSTALL BEDDING FA-2 OR CA-6.
 - 7) INSTALL MULE TAPE OR #12 COPPER WIRE THIN IN THIS DUCT ONLY.
 - 8) CONTRACTOR TO SUPPLY PLASTIC TIES TO HOLD 3", 5", AND 6" CONDUIT TO 6" SPACERS.
 - 9) CONTRACTOR TO INSTALL DUCT RUN PER C30-1900.

CITY OF NAPERVILLE
DEPARTMENT OF PUBLIC UTILITIES-ELECTRIC
TYPICAL CONDUIT SECTION C-C
ROUTE 59

APPROXIMATE LENGTH = 20 FEET CONCRETE ENCASE SPOIL BACKFILL
APPROXIMATE LENGTH = CONCRETE ENCASE CA-6 BACKFILL
APPROXIMATE LENGTH = 25 FEET (FA-2 ENCASED) SPOIL BACKFILL
APPROXIMATE LENGTH = (NONE) (FA-2 ENCASED) CA-6 BACKFILL

- NOTE:
- 1) THE BASE AND INTERMEDIATE 6" SPACERS SHALL BE INSTALLED AT 5' CENTERS.
 - 2) ALL CONDUIT RUNS ARE ASSEMBLED IN FIELD.
 - 3) INSTALL 1/8" DIA. (PULLING) NYLON ROPE IN EACH DUCT.
 - 4) ALL CABLES BY OTHERS.
 - 5) CONDUIT AND SPACERS AND ALL OTHER MATERIALS INCLUDING GLUE, COUPLINGS AND MANHOLE ENTRANCES FURNISHED BY CITY OF NAPERVILLE AND INSTALLED BY CONTRACTOR.
 - 6) INSTALL BEDDING FA-2 OR CA-6.
 - 7) INSTALL MULE TAPE OR #12 COPPER WIRE THIN IN THIS DUCT ONLY.
 - 8) CONTRACTOR TO SUPPLY PLASTIC TIES TO HOLD 3", 5", AND 6" CONDUIT TO 6" SPACERS.
 - 9) CONTRACTOR TO INSTALL DUCT RUN PER C30-1900.

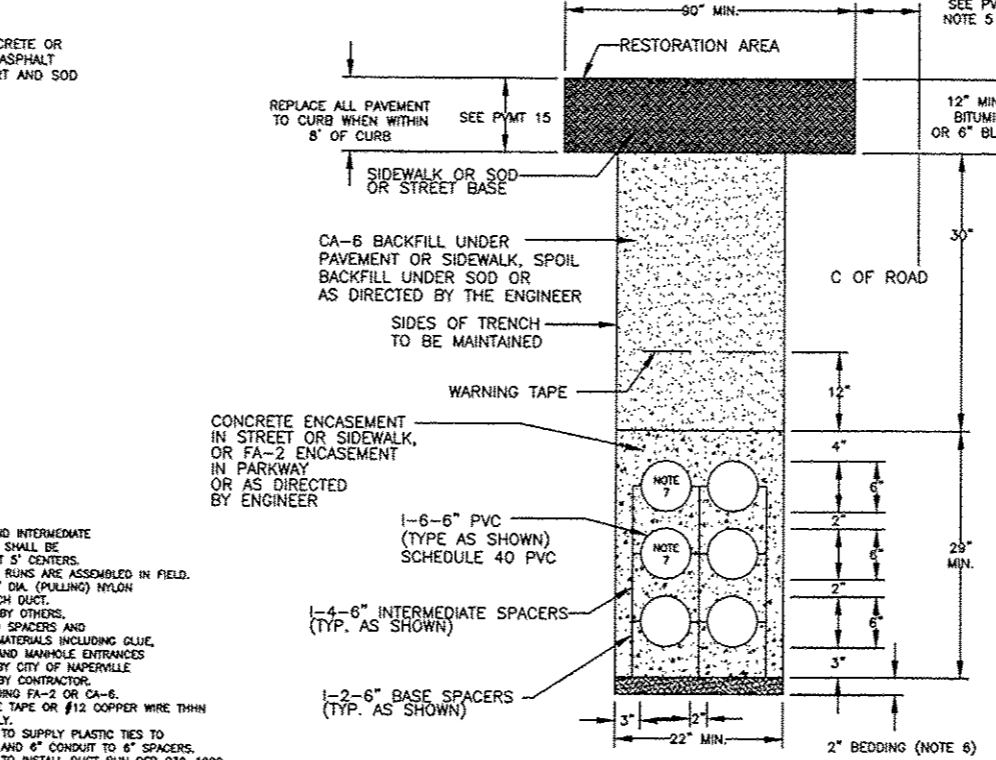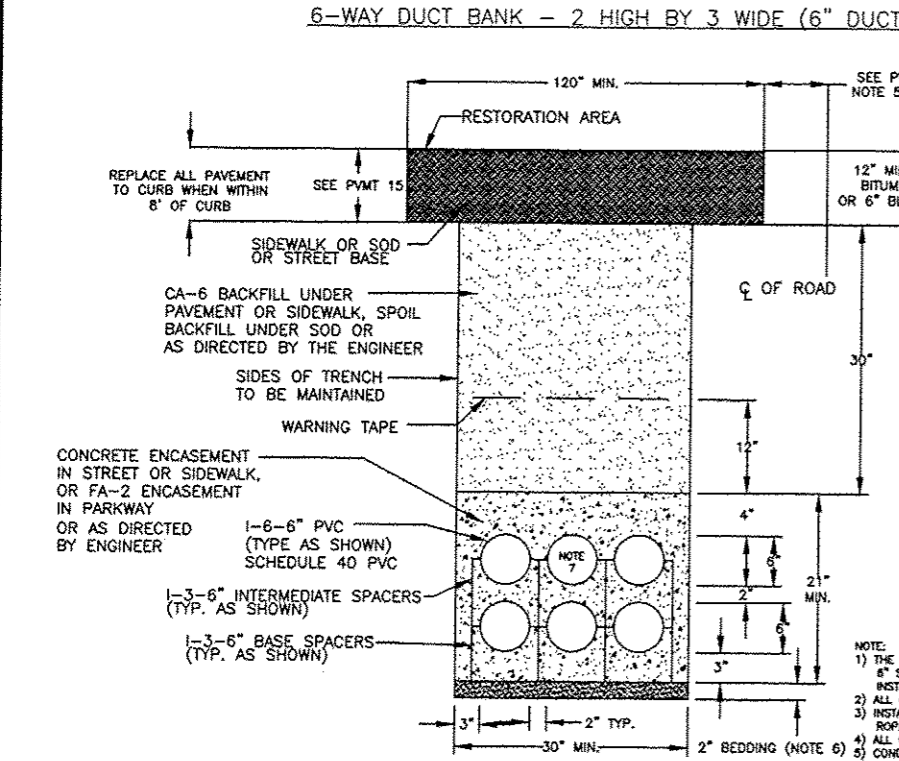

CITY OF NAPERVILLE
DEPARTMENT OF PUBLIC UTILITIES-ELECTRIC
TYPICAL CONDUIT SECTION F-F
ROUTE 59

APPROXIMATE LENGTH = (NONE) CONCRETE ENCASE SPOIL BACKFILL
APPROXIMATE LENGTH = (NONE) CONCRETE ENCASE CA-6 BACKFILL
APPROXIMATE LENGTH = 200 FEET (FA-2 ENCASED) SPOIL BACKFILL
APPROXIMATE LENGTH = (NONE) (FA-2 ENCASED) CA-6 BACKFILL

- NOTE:
- 1) THE BASE AND INTERMEDIATE 6" SPACERS SHALL BE INSTALLED AT 5' CENTERS.
 - 2) ALL CONDUIT RUNS ARE ASSEMBLED IN FIELD.
 - 3) INSTALL 1/8" DIA. (PULLING) NYLON ROPE IN EACH DUCT.
 - 4) ALL CABLES BY OTHERS.
 - 5) CONDUIT AND SPACERS AND ALL OTHER MATERIALS INCLUDING GLUE, COUPLINGS AND MANHOLE ENTRANCES FURNISHED BY CITY OF NAPERVILLE AND INSTALLED BY CONTRACTOR.
 - 6) INSTALL BEDDING FA-2 OR CA-6.
 - 7) INSTALL MULE TAPE OR #12 COPPER WIRE THIN IN THIS DUCT ONLY.
 - 8) CONTRACTOR TO SUPPLY PLASTIC TIES TO HOLD 3", 5", AND 6" CONDUIT TO 6" SPACERS.
 - 9) CONTRACTOR TO INSTALL DUCT RUN PER C30-1900.




CITY OF NAPERVILLE
DEPARTMENT OF PUBLIC UTILITIES-ELECTRIC
TYPICAL CONDUIT SECTION D-D
ROUTE 59

APPROXIMATE LENGTH = (NONE) CONCRETE ENCASE SPOIL BACKFILL
APPROXIMATE LENGTH = 175 FEET CONCRETE ENCASE CA-6 BACKFILL
APPROXIMATE LENGTH = 120 FEET (FA-2 ENCASED) SPOIL BACKFILL
APPROXIMATE LENGTH = (NONE) (FA-2 ENCASED) CA-6 BACKFILL

ADDENDUM A 7-16-12

PROJECT TITLE				ROUTE 59 ROAD IMPROVEMENTS			
PROJECT DESCRIPTION				DETAILS AND STANDARDS			
ENGINEER	BCC	DRAWING DATE	5-11-12	MAP #	4211.4212.4223	SCALE	N.T.S.
DESIGN BY	DL	DESIGNED BY	PSM	REVISIONS DATE	N/A	PROJECT #	EU-12
CHECKED BY		APPROVED BY		CAD FILE	0060648001016.DWG	SHEET #	16 OF 63
Naperville				Department of Public Utilities Electric Division		WORK REQUEST # 60468	




F.A.P. RTE.	SECTION	COUNTY	TOTAL SHEETS	SHEET NO.
338/IL 59	2011-035	DUPAGE		
FED. ROAD DIST. NO.		ILLINOIS	CONTRACT 60P42	
		FED. AID PROJECT		

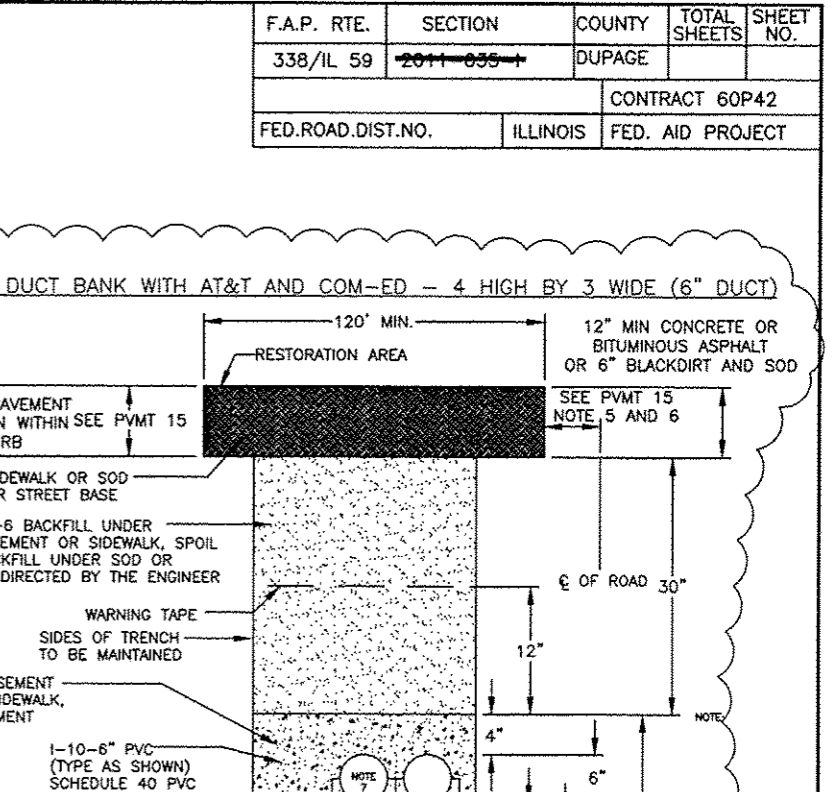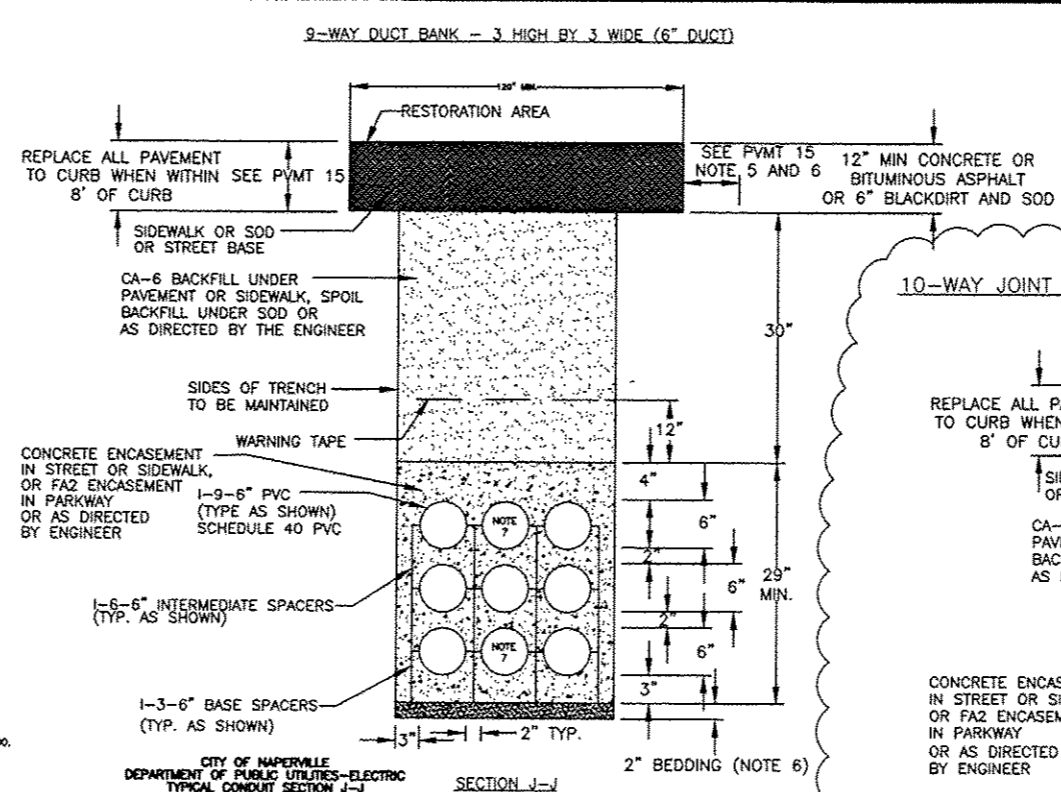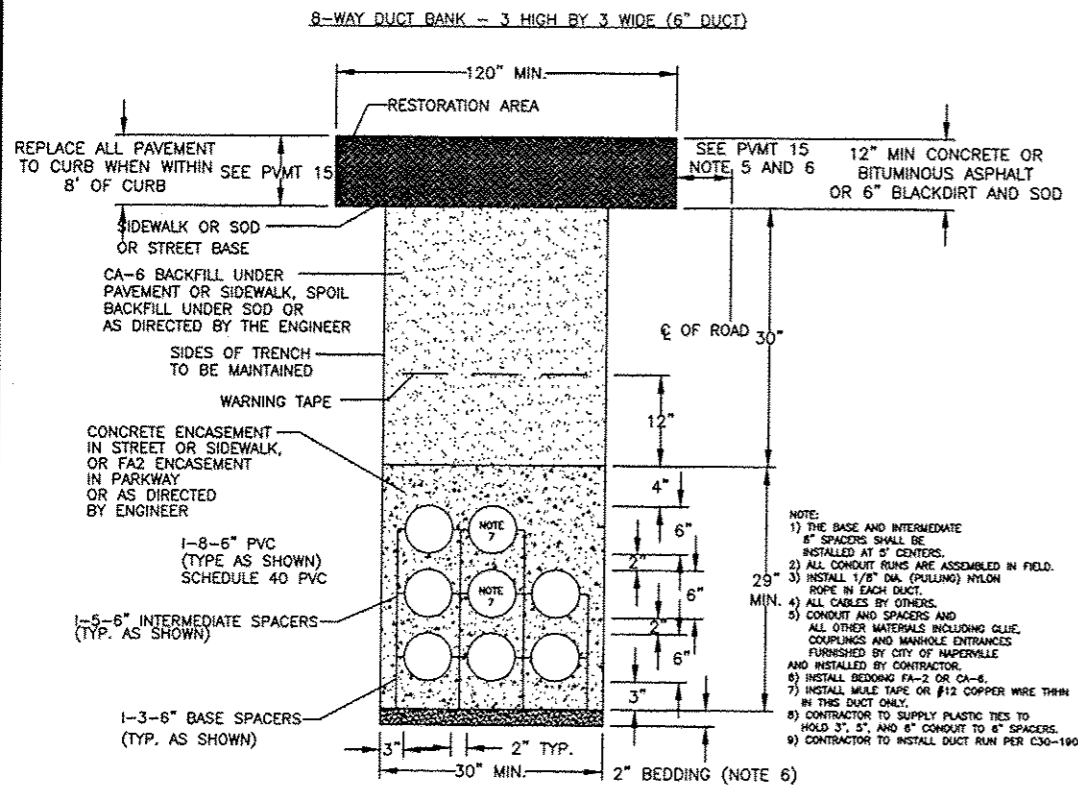

SECTION H-H
 CITY OF NAPERVILLE
 DEPARTMENT OF PUBLIC UTILITIES-ELECTRIC
 TYPICAL CONDUIT SECTION H-H
 ROUTE 59
 APPROXIMATE LENGTH = (NONE) FEET CONCRETE ENCASE SPOIL BACKFILL
 APPROXIMATE LENGTH = 30 FEET CONCRETE ENCASE CA-6 BACKFILL
 APPROXIMATE LENGTH = 570 FEET (FA-2 ENCASED) SPOIL BACKFILL
 APPROXIMATE LENGTH = (NONE) (FA-2 ENCASED) CA-6 BACKFILL

SECTION J-J
 CITY OF NAPERVILLE
 DEPARTMENT OF PUBLIC UTILITIES-ELECTRIC
 TYPICAL CONDUIT SECTION J-J
 ROUTE 59
 APPROXIMATE LENGTH = (NONE) CONCRETE ENCASE SPOIL BACKFILL
 APPROXIMATE LENGTH = 200 FEET CONCRETE ENCASE CA-6 BACKFILL
 APPROXIMATE LENGTH = (NONE) (FA-2 ENCASED) SPOIL BACKFILL
 APPROXIMATE LENGTH = (NONE) (FA-2 ENCASED) CA-6 BACKFILL

SECTION Z-Z
 CITY OF NAPERVILLE
 DEPARTMENT OF PUBLIC UTILITIES-ELECTRIC
 TYPICAL CONDUIT SECTION Z-Z
 ROUTE 59
 APPROXIMATE LENGTH = (NONE) CONCRETE AND CONCRETE ENCASE SPOIL BACKFILL
 APPROXIMATE LENGTH = 100 FEET CONCRETE AND CONCRETE ENCASE CA-6 BACKFILL
 APPROXIMATE LENGTH = (NONE) CONCRETE AND (FA-2 ENCASED) SPOIL BACKFILL
 APPROXIMATE LENGTH = (NONE) CONCRETE AND (FA-2 ENCASED) CA-6 BACKFILL

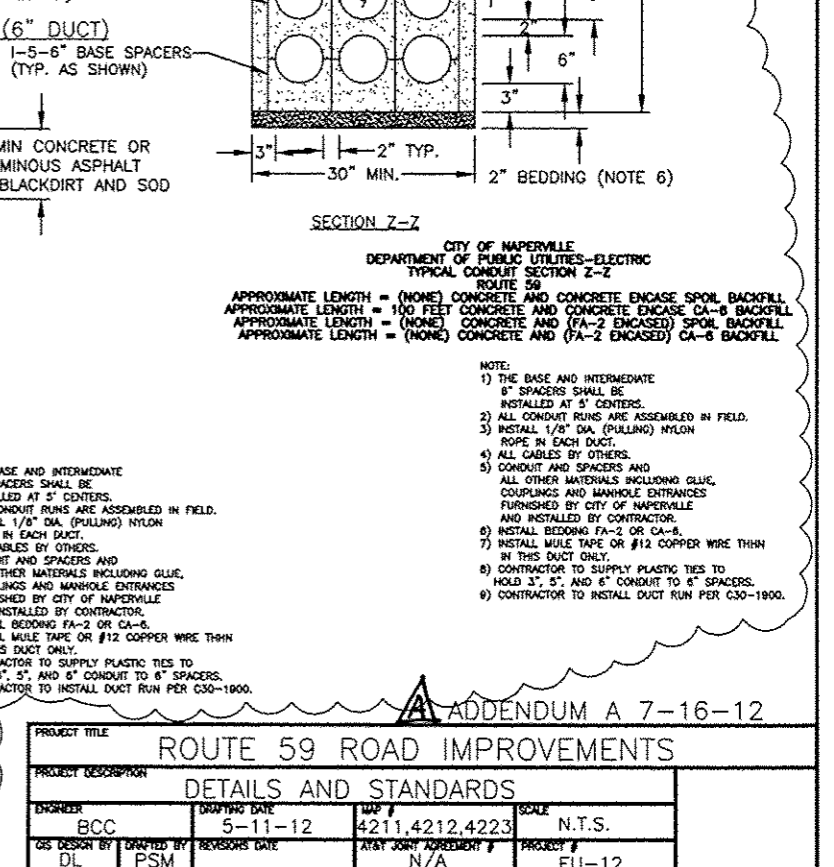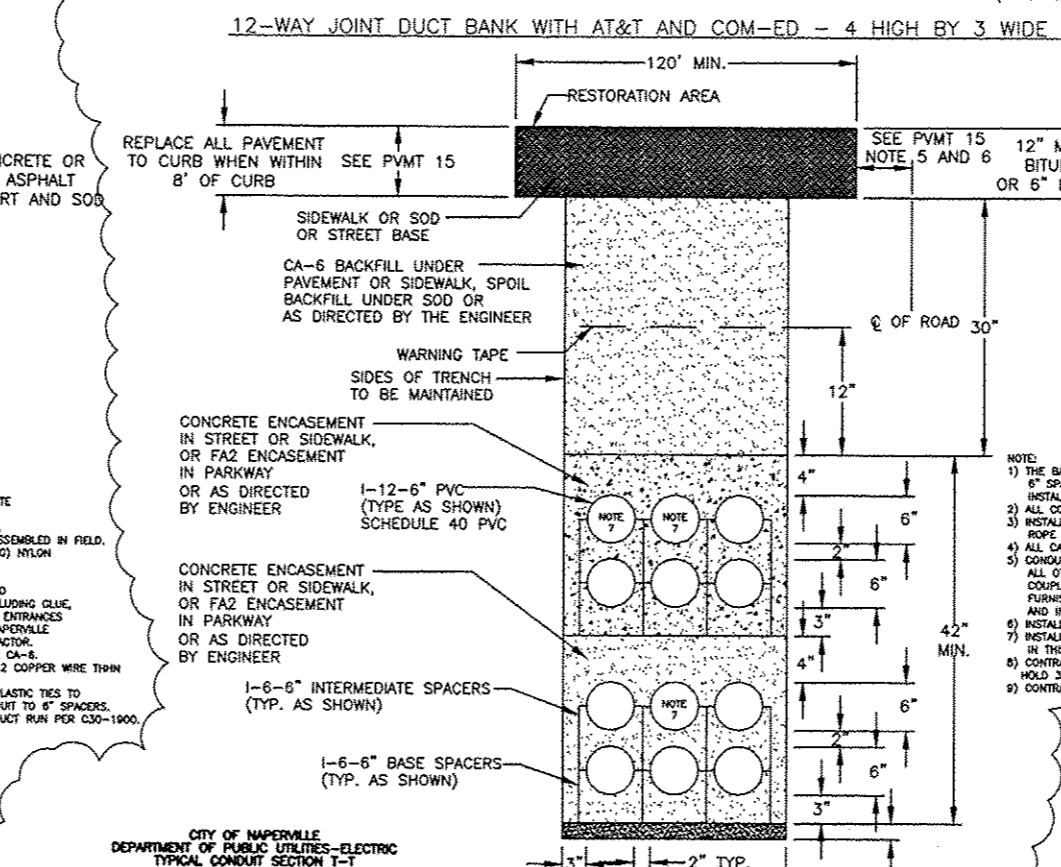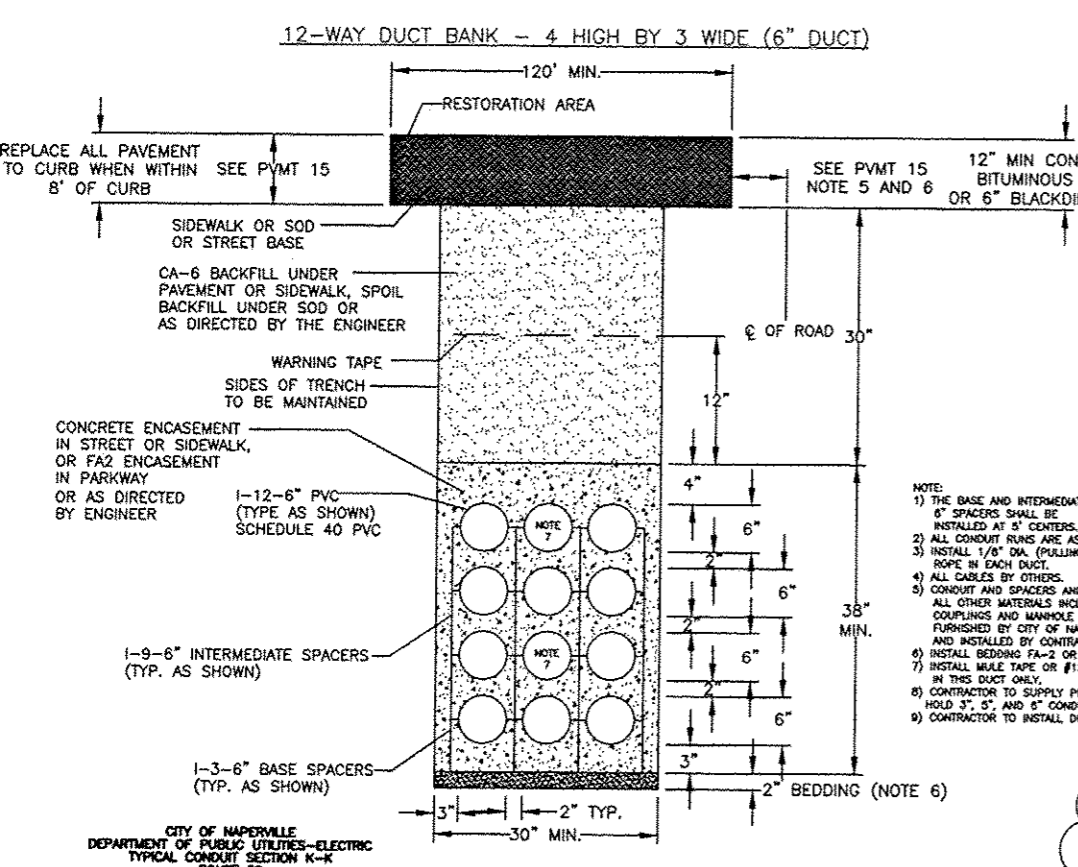

SECTION K-K
 CITY OF NAPERVILLE
 DEPARTMENT OF PUBLIC UTILITIES-ELECTRIC
 TYPICAL CONDUIT SECTION K-K
 ROUTE 59
 APPROXIMATE LENGTH = 80 FEET CONCRETE ENCASE SPOIL BACKFILL
 APPROXIMATE LENGTH = (NONE) FEET CONCRETE ENCASE CA-6 BACKFILL
 APPROXIMATE LENGTH = 420 FEET (FA-2 ENCASED) SPOIL BACKFILL
 APPROXIMATE LENGTH = (NONE) (FA-2 ENCASED) CA-6 BACKFILL

SECTION I-I
 CITY OF NAPERVILLE
 DEPARTMENT OF PUBLIC UTILITIES-ELECTRIC
 TYPICAL CONDUIT SECTION I-I
 ROUTE 59
 APPROXIMATE LENGTH = (NONE) CONCRETE AND CONCRETE ENCASE SPOIL BACKFILL
 APPROXIMATE LENGTH = 250 FEET CONCRETE AND CONCRETE ENCASE CA-6 BACKFILL
 APPROXIMATE LENGTH = 1,220 FEET CONCRETE AND (FA-2 ENCASED) SPOIL BACKFILL
 APPROXIMATE LENGTH = (NONE) CONCRETE AND (FA-2 ENCASED) CA-6 BACKFILL

SECTION Z-Z
 CITY OF NAPERVILLE
 DEPARTMENT OF PUBLIC UTILITIES-ELECTRIC
 TYPICAL CONDUIT SECTION Z-Z
 ROUTE 59
 APPROXIMATE LENGTH = (NONE) CONCRETE AND CONCRETE ENCASE SPOIL BACKFILL
 APPROXIMATE LENGTH = 100 FEET CONCRETE AND CONCRETE ENCASE CA-6 BACKFILL
 APPROXIMATE LENGTH = (NONE) CONCRETE AND (FA-2 ENCASED) SPOIL BACKFILL
 APPROXIMATE LENGTH = (NONE) CONCRETE AND (FA-2 ENCASED) CA-6 BACKFILL


- NOTE:**
- 1) THE BASE AND INTERMEDIATE 6" SPACERS SHALL BE INSTALLED AT 5' CENTERS.
 - 2) ALL CONDUIT RUNS ARE ASSEMBLED IN FIELD.
 - 3) INSTALL 1/8" DIA. (PULLING) NYLON ROPE IN EACH DUCT.
 - 4) ALL CABLES BY OTHERS.
 - 5) CONDUIT AND SPACERS AND ALL OTHER MATERIALS INCLUDING GLUE, COUPLINGS AND MANHOLE ENTRANCES FURNISHED BY CITY OF NAPERVILLE AND INSTALLED BY CONTRACTOR.
 - 6) INSTALL BEDDING FA-2 OR CA-6.
 - 7) INSTALL MULE TAPE OR #12 COPPER WIRE THIN IN THIS DUCT ONLY.
 - 8) CONTRACTOR TO SUPPLY PLASTIC TIES TO HOLD 3", 5", AND 6" CONDUIT TO 6" SPACERS.
 - 9) CONTRACTOR TO INSTALL DUCT RUN PER C30-1900.

ADDENDUM A 7-16-12

PROJECT TITLE				ROUTE 59 ROAD IMPROVEMENTS	
PROJECT DESCRIPTION				DETAILS AND STANDARDS	
DRAWN BY	DRAWING DATE	MAP #	SCALE		
BCC	5-11-12	4211,4212,4223	N.T.S.		
DESIGN BY	REVISIONS DATE	AT&T JOINT AGREEMENT #	PROJECT #		
DL	PSM	N/A	EU-12		
CHECKED BY	APPROVED BY	CAD FILE	SHEET #		
		0060648001D17.DWG	17 OF 63		
Naperville			Department of Public Utilities		WORK REQUEST #
			Electric Division		60468

F.A.P. RTE.	SECTION	COUNTY	TOTAL SHEETS	SHEET NO.
338/IL 59	2011-0557	DUPAGE		
CONTRACT 60P42			FED. AID PROJECT	
FED. ROAD DIST. NO.	ILLINOIS			

HORIZONTAL DIRECTIONAL DRILLING METHOD 9-6" HDPE

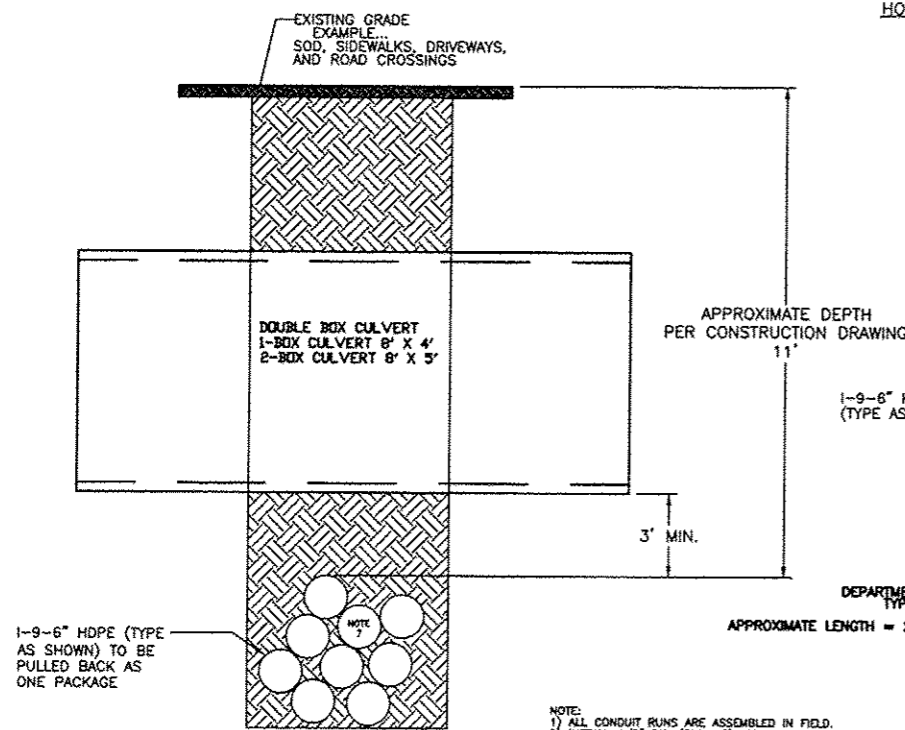


- NOTE:
- 1) ALL CONDUIT RUNS ARE ASSEMBLED IN FIELD.
 - 2) INSTALL 1/8" DIA. (PULLING) NYLON ROPE IN EACH DUCT.
 - 3) ALL CABLES BY OTHERS.
 - 4) CONDUIT
 - 5) ALL OTHER MATERIALS INCLUDING GLUE, COUPLINGS AND MANHOLE ENTRANCES FURNISHED BY CITY OF NAPERVILLE AND INSTALLED BY CONTRACTOR.
 - 6) CONTRACTOR TO SUPPLY POLY TO PVC CONNECTOR OR POLY TO STEEL CONNECTOR.
 - 7) CONTRACTOR TO INSTALL MULE TAPE OR #12 COPPER WIRE THHN IN THIS DUCT ONLY.
 - 8) CONTRACTOR TO INSTALL PUSH PER C30-1950.

HORIZONTAL DIRECTIONAL DRILL METHOD SECTION L-L

CITY OF NAPERVILLE
DEPARTMENT OF PUBLIC UTILITIES-ELECTRIC
TYPICAL CONDUIT SECTION L-L
ROUTE 59
APPROXIMATE LENGTH = 210 FEET, HORIZONTAL DIRECTIONAL DRILL METHOD

HORIZONTAL DIRECTIONAL DRILLING METHOD 9-6" HDPE

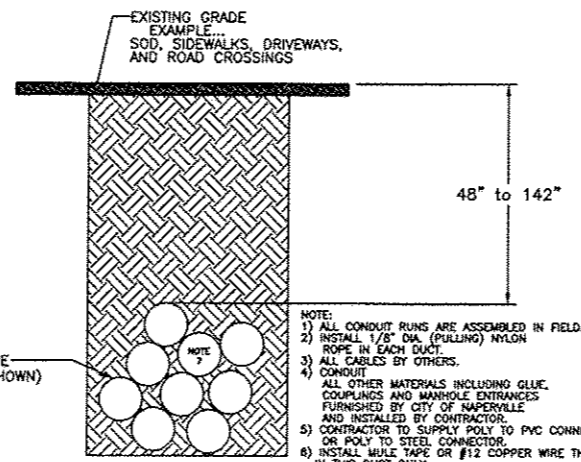


- NOTE:
- 1) ALL CONDUIT RUNS ARE ASSEMBLED IN FIELD.
 - 2) INSTALL 1/8" DIA. (PULLING) NYLON ROPE IN EACH DUCT.
 - 3) ALL CABLES BY OTHERS.
 - 4) CONDUIT
 - 5) ALL OTHER MATERIALS INCLUDING GLUE, COUPLINGS AND MANHOLE ENTRANCES FURNISHED BY CITY OF NAPERVILLE AND INSTALLED BY CONTRACTOR.
 - 6) CONTRACTOR TO SUPPLY POLY TO PVC CONNECTOR OR POLY TO STEEL CONNECTOR.
 - 7) CONTRACTOR TO INSTALL MULE TAPE OR #12 COPPER WIRE THHN IN THIS DUCT ONLY.
 - 8) CONTRACTOR TO INSTALL PUSH PER C30-1950.

HORIZONTAL DIRECTIONAL DRILL METHOD SECTION M-M

CITY OF NAPERVILLE
DEPARTMENT OF PUBLIC UTILITIES-ELECTRIC
TYPICAL CONDUIT SECTION M-M
ROUTE 59
APPROXIMATE LENGTH = 210 FEET, HORIZONTAL DIRECTIONAL DRILL METHOD

HORIZONTAL DIRECTIONAL DRILLING METHOD 6-6" HDPE

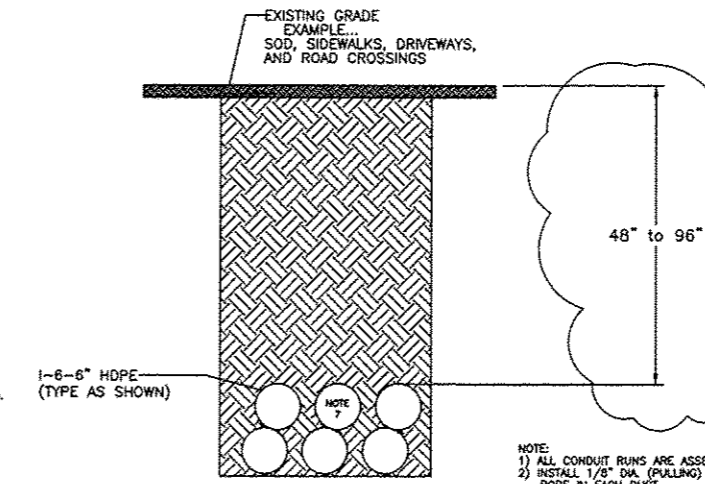


- NOTE:
- 1) ALL CONDUIT RUNS ARE ASSEMBLED IN FIELD.
 - 2) INSTALL 1/8" DIA. (PULLING) NYLON ROPE IN EACH DUCT.
 - 3) ALL CABLES BY OTHERS.
 - 4) CONDUIT
 - 5) ALL OTHER MATERIALS INCLUDING GLUE, COUPLINGS AND MANHOLE ENTRANCES FURNISHED BY CITY OF NAPERVILLE AND INSTALLED BY CONTRACTOR.
 - 6) CONTRACTOR TO SUPPLY POLY TO PVC CONNECTOR OR POLY TO STEEL CONNECTOR.
 - 7) CONTRACTOR TO INSTALL MULE TAPE OR #12 COPPER WIRE THHN IN THIS DUCT ONLY.
 - 8) CONTRACTOR TO INSTALL PUSH PER C30-1950.

HORIZONTAL DIRECTIONAL DRILL METHOD SECTION N-N

CITY OF NAPERVILLE
DEPARTMENT OF PUBLIC UTILITIES-ELECTRIC
TYPICAL CONDUIT SECTION N-N
ROUTE 59
APPROXIMATE LENGTH = 970 FEET, HORIZONTAL DIRECTIONAL DRILL METHOD


14-WAY JOINT DUCT BANK WITH AT&T AND COM-ED - 5 HIGH BY 3 WIDE (6" DUCT)

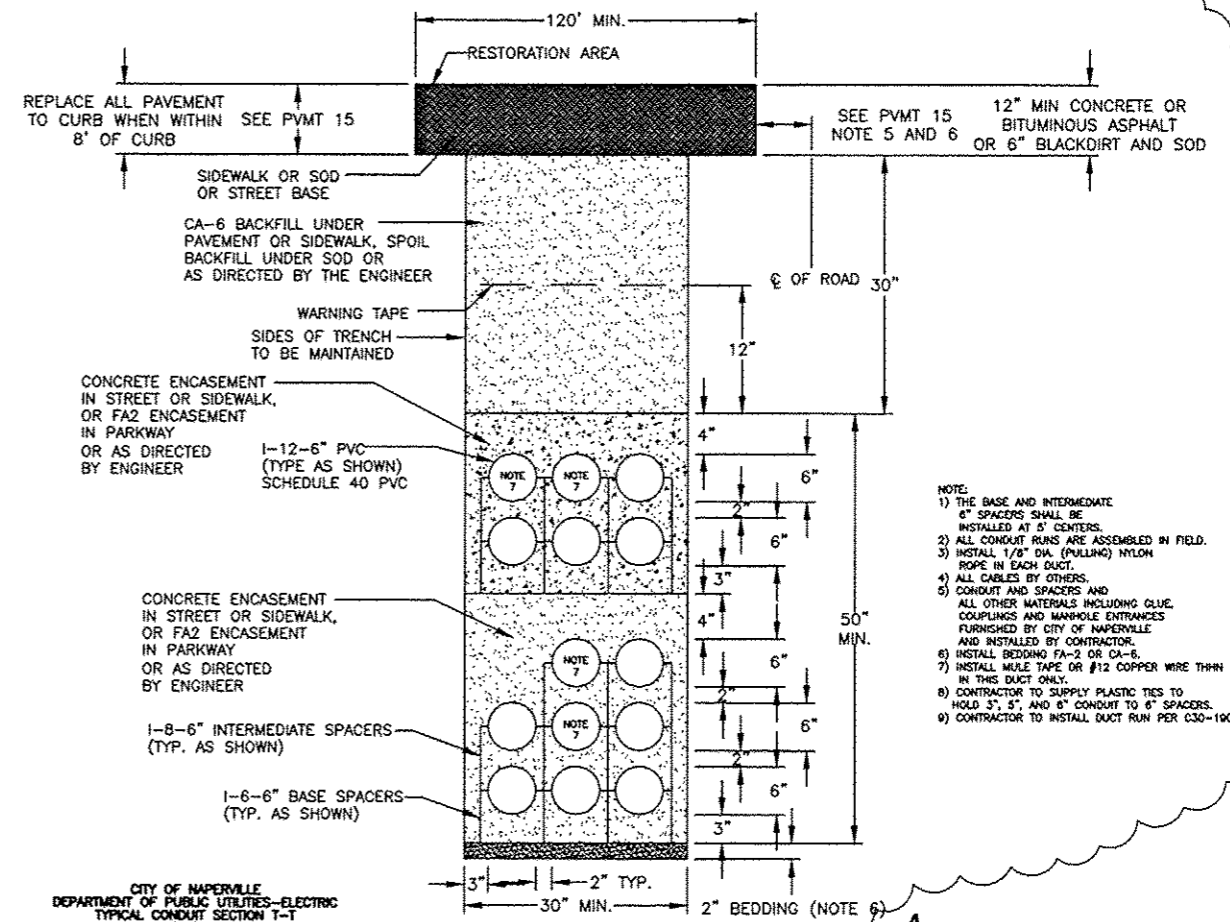

- NOTE:
- 1) THE BASE AND INTERMEDIATE 8" SPACERS SHALL BE INSTALLED AT 6" CENTERS.
 - 2) ALL CONDUIT RUNS ARE ASSEMBLED IN FIELD.
 - 3) INSTALL 1/8" DIA. (PULLING) NYLON ROPE IN EACH DUCT.
 - 4) ALL CABLES BY OTHERS.
 - 5) CONDUIT AND SPACERS AND ALL OTHER MATERIALS INCLUDING GLUE, COUPLINGS AND MANHOLE ENTRANCES FURNISHED BY CITY OF NAPERVILLE AND INSTALLED BY CONTRACTOR.
 - 6) INSTALL BEDDING FA-2 OR CA-6.
 - 7) INSTALL MULE TAPE OR #12 COPPER WIRE THHN IN THIS DUCT ONLY.
 - 8) CONTRACTOR TO SUPPLY PLASTIC TIES TO HOLD 3", 5", AND 8" CONDUIT TO 6" SPACERS.
 - 9) CONTRACTOR TO INSTALL DUCT RUN PER C30-1900.

ADDENDUM A 7-16-12

HORIZONTAL DIRECTIONAL DRILLING METHOD 12-6" HDPE

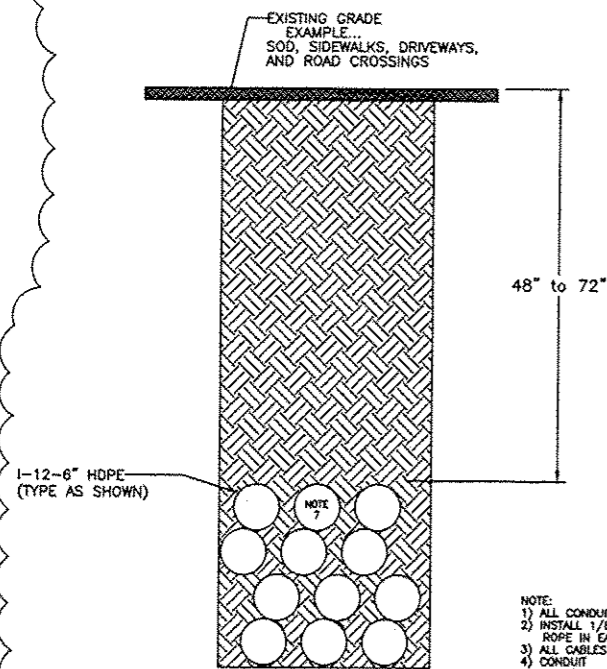


- NOTE:
- 1) ALL CONDUIT RUNS ARE ASSEMBLED IN FIELD.
 - 2) INSTALL 1/8" DIA. (PULLING) NYLON ROPE IN EACH DUCT.
 - 3) ALL CABLES BY OTHERS.
 - 4) CONDUIT
 - 5) ALL OTHER MATERIALS INCLUDING GLUE, COUPLINGS AND MANHOLE ENTRANCES FURNISHED BY CITY OF NAPERVILLE AND INSTALLED BY CONTRACTOR.
 - 6) CONTRACTOR TO SUPPLY POLY TO PVC CONNECTOR OR POLY TO STEEL CONNECTOR.
 - 7) CONTRACTOR TO INSTALL MULE TAPE OR #12 COPPER WIRE THHN IN THIS DUCT ONLY.
 - 8) CONTRACTOR TO INSTALL PUSH PER C30-1950.

HORIZONTAL DIRECTIONAL DRILL METHOD SECTION P-P

CITY OF NAPERVILLE
DEPARTMENT OF PUBLIC UTILITIES-ELECTRIC
TYPICAL CONDUIT SECTION P-P
ROUTE 59
APPROXIMATE LENGTH = 90 FEET, HORIZONTAL DIRECTIONAL DRILL METHOD

HORIZONTAL DIRECTIONAL DRILLING METHOD 2-6" HDPE

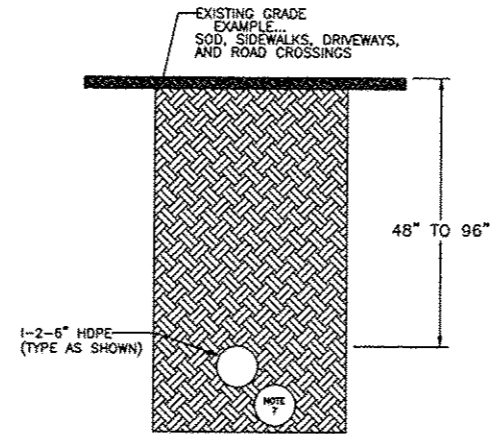

- NOTE:
- 1) ALL CONDUIT RUNS ARE ASSEMBLED IN FIELD.
 - 2) INSTALL 1/8" DIA. (PULLING) NYLON ROPE IN EACH DUCT.
 - 3) ALL CABLES BY OTHERS.
 - 4) CONDUIT
 - 5) ALL OTHER MATERIALS INCLUDING GLUE, COUPLINGS AND MANHOLE ENTRANCES FURNISHED BY CITY OF NAPERVILLE AND INSTALLED BY CONTRACTOR.
 - 6) CONTRACTOR TO SUPPLY POLY TO PVC CONNECTOR OR POLY TO STEEL CONNECTOR.
 - 7) CONTRACTOR TO INSTALL MULE TAPE OR #12 COPPER WIRE THHN IN THIS DUCT ONLY.
 - 8) CONTRACTOR TO INSTALL PUSH PER C30-1950.

HORIZONTAL DIRECTIONAL DRILL METHOD SECTION S-S


CITY OF NAPERVILLE
DEPARTMENT OF PUBLIC UTILITIES-ELECTRIC
TYPICAL CONDUIT SECTION S-S
ROUTE 59
APPROXIMATE LENGTH = 195 FEET, HORIZONTAL DIRECTIONAL DRILL METHOD

- NOTE:
- 1) ALL CONDUIT RUNS ARE ASSEMBLED IN FIELD.
 - 2) INSTALL 1/8" DIA. (PULLING) NYLON ROPE IN EACH DUCT.
 - 3) ALL CABLES BY OTHERS.
 - 4) CONDUIT
 - 5) ALL OTHER MATERIALS INCLUDING GLUE, COUPLINGS AND MANHOLE ENTRANCES FURNISHED BY CITY OF NAPERVILLE AND INSTALLED BY CONTRACTOR.
 - 6) CONTRACTOR TO SUPPLY POLY TO PVC CONNECTOR OR POLY TO STEEL CONNECTOR.
 - 7) CONTRACTOR TO INSTALL MULE TAPE OR #12 COPPER WIRE THHN IN THIS DUCT ONLY.
 - 8) CONTRACTOR TO INSTALL PUSH PER C30-1950.

HORIZONTAL DIRECTIONAL DRILL METHOD SECTION T-T

CITY OF NAPERVILLE
DEPARTMENT OF PUBLIC UTILITIES-ELECTRIC
TYPICAL CONDUIT SECTION T-T
ROUTE 59
APPROXIMATE LENGTH = (NONE) CONCRETE AND CONCRETE ENCASE SPOIL BACKFILL
APPROXIMATE LENGTH = (NONE) CONCRETE AND CONCRETE ENCASE CA-6 BACKFILL
APPROXIMATE LENGTH = 400 FEET CONCRETE AND (FA-2 ENCASED) SPOIL BACKFILL
APPROXIMATE LENGTH = (NONE) CONCRETE AND (FA-2 ENCASED) CA-6 BACKFILL

PROJECT TITLE				ROUTE 59 ROAD IMPROVEMENTS			
PROJECT DESCRIPTION				DETAILS AND STANDARDS			
ENGINEER	BCC	DRAWING DATE	5-11-12	MAP #	4211,4212,4223	SCALE	N.T.S.
DESIGN BY	DL	DRAWN BY	PSM	ASSET ID	N/A	PROJECT #	EU-12
CHECKED BY		APPROVED BY		CAD FILE	0060648001018.DWG	SHEET #	18 OF 63
Naperville			Department of Public Utilities Electric Division			WORK REQUEST # 60468	

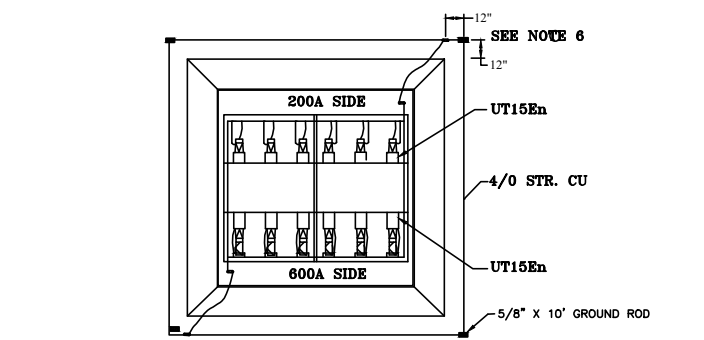


NOTES (CONTINUED):

8) THIS DRAWING SHOWS AN EXISTING SWITCH GEAR WITH CABLE INSTALLED WITH MATERIAL LIST ON RIGHT.

9) CONTRACTOR TO OBTAIN OUTAGE OF SWITCH GEAR PRIOR TO DOING ANY WORK.

10) CONTRACTOR TO INSTALL 3", 5" AND 6" CONDUIT INTO EXISTING AS SPECIFIED IN SPECIFICATIONS CAP AND PULLS ALL CONDUITS.

11) ALL GROUNDING CONNECTIONS AND TERMINATORS SHALL BE INSPECTED TO DETERMINE CONDITION OF CONNECTIONS BY THE CONTRACTOR REPORT FINDING.

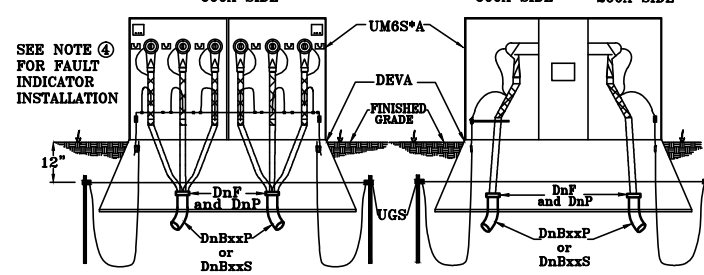

NOTES:

- BENDS SHALL BE INSTALLED PER FIELD CONDITION.
- SPARES NOT SHOWN.
- INSTALL ELBOW ARRESTERS AT NORMAL OPEN SWITCH LOCATIONS ON 600A SIDE.
- SEE C30-1010 FOR FAULT INDICATOR LOCATION.
- FOR VAULT INSTALLATIONS ONLY, INSTALL LIDS - DEVAL
- GROUND GRID INSTALLED 12" FROM VAULT AND 12" BELOW GRADE.
- CONTRACTOR IS ADVISED THIS SPECIFICATION INDICATES WHAT IS INSIDE AN EXISTING ENERGIZED SWITCH GEAR THAT IS TO BE WORKED IN BY THE CONTRACTOR.

THE ASSEMBLY CODE UTAB1 - BUSHING INSERT, 15KV 200 Amps WAS ELIMINATED AFTER S&C ADDED THE BUSHING INSERT OPTION TO ALL NEW PME SWITCHGEAR! THE UTAB1 OPTION IS STILL AVAILABLE FOR USE AS A REPLACEMENT OPTION.

CODE	QTY	DESCRIPTION
DEVA	1	Vault, Air Switch
DnBxxP	**	Bend, PVC
DnBxxS	**	Bend, Steel
DnF	**	Bell Fitting, PVC
DnP	**	Plug, PVC
UI15n	**	Faulted Circuit Indicator
UFnSMU	**	Fuse Unit, 15KV, SMU 20
UM6S*A	1	Switch, Pad mounted
UGS#	1	Grounding, Switchgear
UT15AE	**	Arrester, Elbow, 9KV
UT15En	**	Elbow, 15KV

n is dependent on size
 * 2(2-way) or 3(3-way)
 ** qty is dependent on application
 xx bend angle dependent on field condition, (typically 45°)
 # V for vault only, E for switchgear only

NAPERVILLE PUBLIC UTILITIES DEPARTMENT ELECTRIC STANDARDS	3Ø 15kV AIR SWITCH MODULE ASSEMBLY	DATE: 4-22-07 Page 1 of 3 C30-0013
--	------------------------------------	--

Item Code	Description 1	Description 2	Qty
284 100 00120	EXTENDER, 1Ø TRF VAULT	44" X 44" X 9" W/25" X 25" OPEN	1
284 101 00010	VAULT, AIR SWITCH	74" X 76" X 36" (FIBER-CRETE)	1
284 101 00020	VAULT, 1Ø TRF/FUSE CAN	44" X 44" X 36" (FIBER-CRETE)	1
284 101 00030	VAULT, 3Ø PULL CAN	22" X 22" X 36" (FIBER-CRETE)	1
284 101 00040	VAULT, 3Ø FUSE CAN	49" X 29" X 36" (FIBER-CRETE)	1
284 101 00100	EXTENDER, AIR SWITCH VAULT	74" X 76" X 36" (FIBER-CRETE)	1
NON	CRUSHED LIMESTONE		
NON	VAULT, 12.47KV PRL METERING	56" X 56" X 20"	
NON	LID, AIR SWITCH VAULT	2-PIECE DESIGN W/HARDWARE	

Assembly	Item Code	Description 1	Description 2	Qty
DnBxxP: BEND, PVC	DnBxxP	285 101 00025	ELBOW, 30° R PVC 30 DEG 3"	STANDARD RADIUS SCH 40
	DnBxxP	285 101 00030	ELBOW, 30° R PVC 45 DEG 3"	SCH 40
DnBxxS: BEND, 3" STEEL	DnBxxS	285 101 00110	ELBOW, 30° R STL 30 DEG 3"	GALVANIZED
	DnBxxS	285 101 00120	ELBOW, 30° R STL 45 DEG 3"	GALVANIZED

Item Code	Description 1	Description 2	Qty
285 101 00140	ELBOW, 30° R STL 90 DEG 3"	GALVANIZED	
285 102 00040	COUPLING, PVC 3"	LONG LINE SCH 40	

Item Code	Description 1	Description 2	Qty
285 101 00160	ELBOW, 30° R STL 30 DEG 5"	GALVANIZED	
285 101 00170	ELBOW, 30° R STL 45 DEG 5"	GALVANIZED	
285 101 00180	ELBOW, 30° R STL 90 DEG 5"	GALVANIZED	
285 102 00110	COUPLING, PVC 5"	LONG LINE SCH 40	

Item Code	Description 1	Description 2	Qty
285 103 00040	BELL FITTING, PVC 3"	SCH 40 & SCH 80	1
285 103 00060	BELL FITTING, PVC 5"	SCH 40 & SCH 80	1
285 103 00100	BELL FITTING, PVC 6"	SCH 40 & SCH 80	1

NAPERVILLE PUBLIC UTILITIES DEPARTMENT ELECTRIC STANDARDS	3Ø 15kV AIR SWITCH MODULE ASSEMBLY	DATE: 10-22-06 Page 1 of 1 C30-0013
--	------------------------------------	---

Item Code	Description 1	Description 2	Qty
289 105 00030	FUSE UNIT, SMU20, 15KV	25K	1
289 105 00040	FUSE UNIT, SMU20, 15KV	50K	1
289 105 00050	FUSE UNIT, SMU20, 15KV	80K	1
289 105 00060	FUSE UNIT, SMU20, 15KV	100K	1
289 105 00070	FUSE UNIT, SMU20, 15KV	140K	1
289 105 00080	FUSE UNIT, SMU20, 15KV	200K	1

Item Code	Description 1	Description 2	UGS	UGSV	UGSB
280 107 00070	CU BASE SD	4/0 7-STR	75	45	30
285 155 00010	GROUND ROD, COPPER CLAD	5/8" X 10'	4	4	4
284 199 00184	CLAMP, CABLE TO FLAT GND	4Ø SOL - 250 MCM CU	4	-	-
286 100 00280	CONNECTOR, WEDGE CU	4/0 STR (7) - 4/0 STR (7)	4	2	2
284 100 00320	CONNECTOR, WEDGE CU	4/0 STR (7) - 5/8" ROD	4	4	-
286 101 00010	SHELL, WEDGE AMP	WHITE	4	4	4
284 199 00220	BREAK-AWAY	1/0-4/0 STR X 1/0 - 4/0 STR	12	-	12

Item Code	Description 1	Description 2	Qty
283 199 00210	GUARD, WIRE	SPIRAL	4
284 120 00010	FAULT INDICATOR, 1/0 - 4/0 15KV		1
284 120 00020	FAULT INDICATOR, 750 - 1000 15KV		3
284 120 00030	INDICATOR CABLE, 3 TO 1	10 FOOT	1
284 120 00040	INDICATOR CABLE, 1 TO 1	6 FOOT	1
284 120 00050	TIES, CABLE	SMALL	4
284 120 00060	CLIP	ADHESIVE BACKED	4


Item Code	Description 1	Description 2	Qty
NON	3PH, 2-WAY AUTOMATED SWITCH	15KV 600A	1
NON	3PH, 3-WAY AUTOMATED SWITCH	15KV 600A	1
284 200 00050	3PH, 2 WAY	8.3/15KV, 600A	1
284 200 00080	3PH, 3-WAY	8.3/15KV, 600A	1
284 199 00010	SIGN NOTICE/OBSTRUCTION	8" X 5"	2
287 109 00240	PADLOCK, BRONZE	W/1-1/2" SHACKLE	4

Item Code	Description 1	Description 2	Qty
284 117 00090	INSERT, LOADBREAK BUSHING	15KV, 200A	1

Item Code	Description 1	Description 2	Qty
284 118 00020	ARRESTER, ELBOW	9/10 KV	1
284 118 00030	ARRESTER, PARKING STAND	9/10 KV	1
284 118 00040	ARRESTER, BUSHING INSERT	9/10KV	1
285 199 00220	CONNECTOR, BREAKAWAY CU	1/0 - 4/0 STR	1

Item Code	Description 1	Description 2	Qty
284 109 00010	FUSE, ELBOW 8KV	30A	1
284 117 00020	ELBOW, FUSED 8.3KV 200A	1/0 STR AL 175-220 MIL	1
284 117 00030	ELBOW, 15KV 200A	1/0 STR AL 175-220 MIL	1
284 117 00051	ELBOW, 15KV 200A EXTENDED	1/0 STR AL 175-220 MIL	1
284 117 00040	ELBOW, 15KV 200A	4/0 STR AL 175-220 MIL	1
284 117 00041	ELBOW, 15KV 200A EXTENDED	4/0 STR AL 175-220 MIL	1
284 117 00065	ELBOW, 15KV 600A W/LRTP	750 MCM STR AL 175-220 MIL	1
284 117 00066	ELBOW, 15KV 600A EXTENDED	750 MCM STR AL 175-220 MIL	1
284 117 00068	ELBOW, 15KV 600A W/LRTP	1000 MCM STR AL 175-220 MIL	1
284 117 00069	ELBOW, 15KV 600A EXTENDED	1000 MCM STR AL 175-220 MIL	1
284 117 00400	ELBOW, 15KV 600A	4/0 STR AL 175-220 MIL	1
284 117 00450	KTY CABLE JACKET SEAL	1/0-4/0 (1.05"-1.50")	1
284 117 00440	KTY CABLE JACKET SEAL	250-1000 MCM (1.30"-2.67")	1
285 199 00100	CABLE CLEANER	QUARTS	.01
284 199 00120	CAP, INSULATED W/GROUND	15KV 200A	1


NAPERVILLE PUBLIC UTILITIES DEPARTMENT ELECTRIC STANDARDS	3Ø 15kV AIR SWITCH MODULE ASSEMBLY	DATE: 10-22-06 PAGE 3 OF 3 C30-0013
--	------------------------------------	---

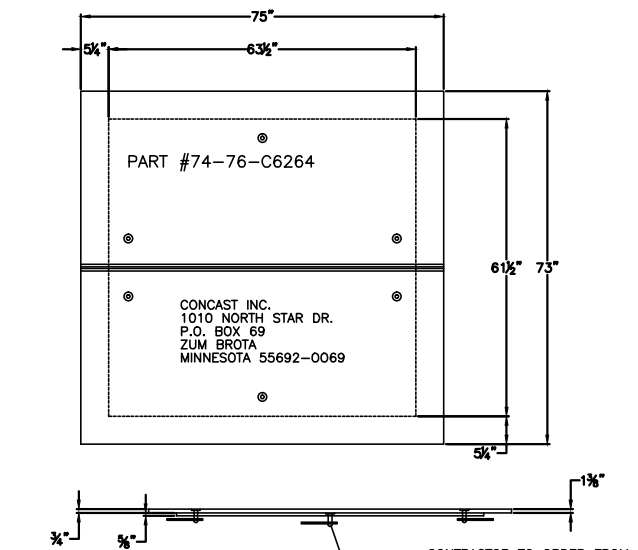

MATERIAL: FIBERCRETE (REQUIRED - 10)

CONTRACTOR TO ORDER FROM ELECTRO TECH
 ATTN: JAMES FLEMING
 1478 McCORMICK PLACE
 WHEATON, IL 60187
 PHONE: 1-800-544-4285

NOTES:
 1) INSTALL THIS COVER OVER SWITCH GEAR VAULT UNTIL SWITCH IS INSTALLED.
 2) RETURN COVER TO CITY OF NAPERVILLE'S STOCK ROOM.
 3) CONTRACTOR TO FURNISH LID.

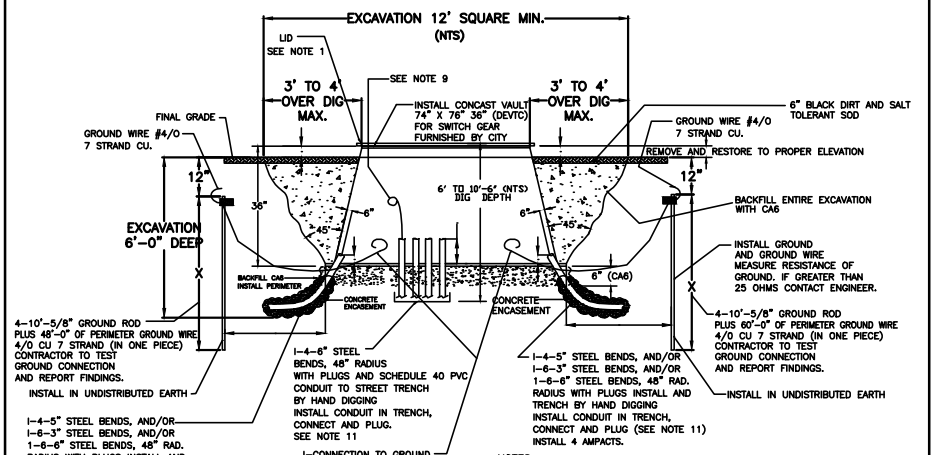



NOTES:

- INSTALL LID OVER OPENING FURNISHED BY CONTRACTOR.
- ESTIMATED WEIGHT - 700 LBS TO 800 LBS.
- VAULT MATERIAL - FIBERCRETE FORMED.
- INSTALL TOP OF VAULT 6" ABOVE FINAL GRADE.
- INSTALL GALVANIZED STEEL ELBOWS INTO VAULT. CONTACT CITY ELECTRICAL ENGINEER FOR LOCATION OF THE ELBOWS IN THE VAULT AND ORIENTATION OF VAULT.
- INSTALL 4-5/8" DIA. X 10'-0" LONG GROUND RODS FOR EACH VAULT. LOCATE ONE ROD AT EACH OF THE CORNERS. INSTALL 1 FOOT FROM THE CORNER. GROUND ROD TO BE DRIVEN 12" BELOW FINISHED GRADE.
- INSTALL PERIMETER GROUND WIRE #4/0, 7 STRANDS COPPER AND ATTACH TO 4 RODS. (ONE CONTINUOUS PIECE, APPROXIMATELY 60' OF WIRE)
- ALL MATERIALS INSTALLED SHALL BE FURNISHED BY CITY OF NAPERVILLE OR CONTRACTOR AS NEW AT EACH LOCATION USED MATERIALS ARE NOT ACCEPTABLE
- INSTALL MULE TAPE OR #12 COPPER WIRE THIN INTO VAULT AND TIE OFF TO LID AND LEAVE TAIL TO CONNECT TOO.
- TEST GROUNDS TO 25 OHMS (REPORT FINDINGS).
- CONTACT ON SITE INSPECTOR FOR ORIENTATION ONLY.
- TESTING EQUIPMENT BY CONTRACTOR.
- TESTING RESULTS TO BE GIVEN TO THE CITY IN WRITTEN FORM.
- VAULT, GROUND MATERIALS, PLASTIC AND STEEL BENDS AND GROUND WIRE FURNISHED BY CITY, INSTALLED BY CONTRACTOR.
- CUT VAULT TO INSTALL CONDUIT AS REQUIRED.
- SEE SPEC. C30-6332 FOR VAULT EXTENDER.

NAPERVILLE PUBLIC UTILITIES DEPARTMENT ELECTRIC STANDARDS	INSTALL NEW SWITCH GEAR VAULT	DATE: 05-01-06 Page 1 of 1 60468-120
--	-------------------------------	--

PROJECT TITLE ROUTE 59 ROAD IMPROVEMENTS			
PROJECT DESCRIPTION DETAILS AND STANDARDS			
ENGINEER BCC	DRAFTING DATE 5-11-12	MAP # 4211,4212,4223	SCALE N.T.S.
DESIGN BY DL	DRAWN BY PSM	AT&T JOINT AGREEMENT # N/A	PROJECT # EU-12
CHECKED BY	APPROVED BY	CAD FILE 0060648001D19.DWG	SHEET # 19 OF 63
Naperville		Department of Public Utilities Electric Division	
		WORK REQUEST # 60468	

F.A.P. RTE.	SECTION	COUNTY	TOTAL SHEETS	SHEET NO.
338/IL 59	2011-035-1	DUPAGE		
			CONTRACT 60P42	
FED.ROAD.DIST.NO.	ILLINOIS	FED. AID PROJECT		

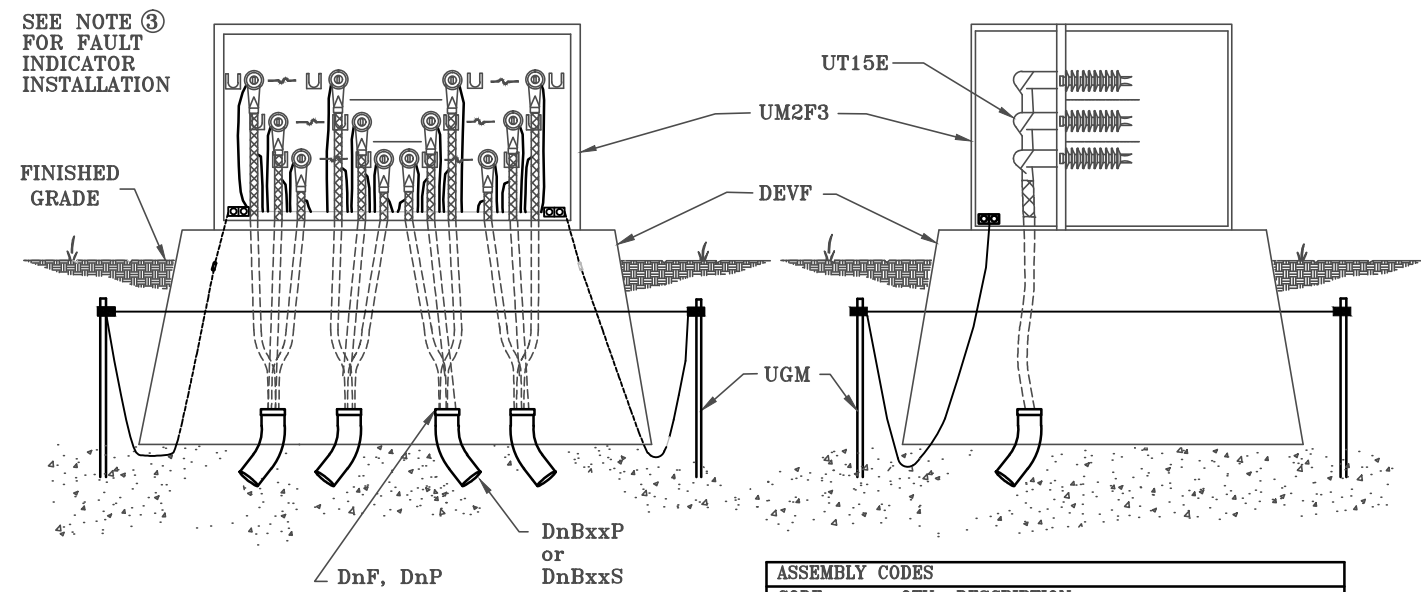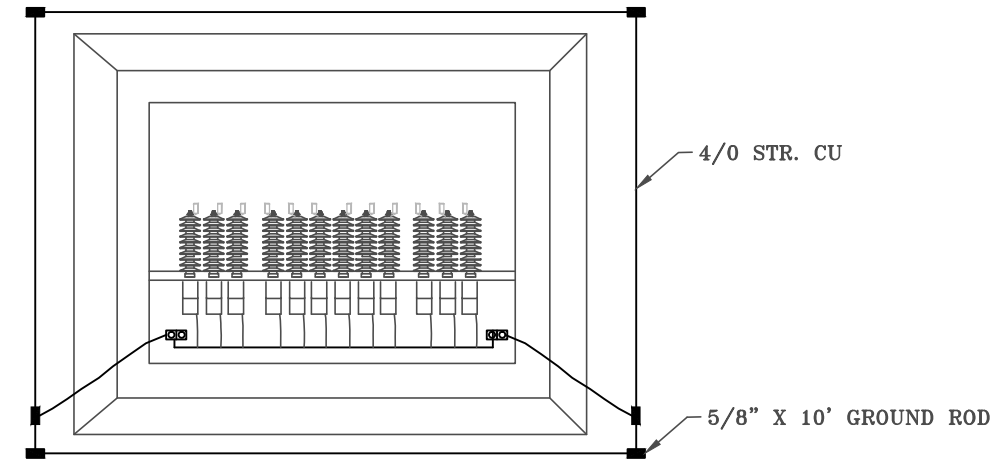

SEE NOTE ③ FOR FAULT INDICATOR INSTALLATION

FINISHED GRADE

DnBxxP or DnBxxS
DnF, DnP

ASSEMBLY CODES		
CODE	QTY	DESCRIPTION
DEVF	1	Vault, 30 Fuse Module
DnBxxP	**	Bend, PVC
DnBxxS	**	Bend, Steel
DnF	**	Bell Fitting, PVC
DnP	**	Plug, PVC
UGM	1	Grounding, Fuse/Termination Module
UI15n	1	Faulted Circuit Indicator
UM2F3	1	30 Fuse Module
UT15En	**	Elbow, 15kV


** quantity is dependent on application
n is dependent on size
xx bend angle dependent on field condition (typically 45°)

- NOTE:**
- BENDS SHALL BE INSTALLED PER FIELD CONDITION.
 - SPARES NOT SHOWN.
 - SEE C30-1010 FOR FAULT INDICATOR LOCATION.


NAPERVILLE PUBLIC UTILITIES DEPARTMENT	30 FUSE/TERMINATION MODULE ASSEMBLY	DATE: 04-17-08
ELECTRIC STANDARDS		Page 1 of 3 C30-0014

PROJECT TITLE					ROUTE 59 ROAD IMPROVEMENTS				
PROJECT DESCRIPTION					DETAILS AND STANDARDS				
ENGINEER	DRAFTING DATE	MAP #	SCALE						
BCC	5-11-12	4211,4212,4223	N.T.S.						
DESIGN BY	DRAFTED BY	AT&T JOINT AGREEMENT #	PROJECT #						
DL	PSM	N/A	EU-12						
CHECKED BY	APPROVED BY	CAD FILE	SHEET #						
		0060648001D120.DWG	20 OF 63						
Naperville			Department of Public Utilities Electric Division			WORK REQUEST #		60468	


F.A.P. RTE.	SECTION	COUNTY	TOTAL SHEETS	SHEET NO.
338/IL 59	2011-035-1	DUPAGE		
CONTRACT 60P42				
FED. ROAD. DIST. NO.	ILLINOIS	FED. AID PROJECT		

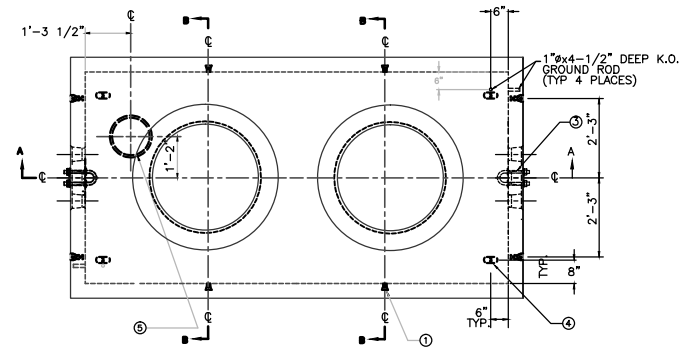

PLAN VIEW

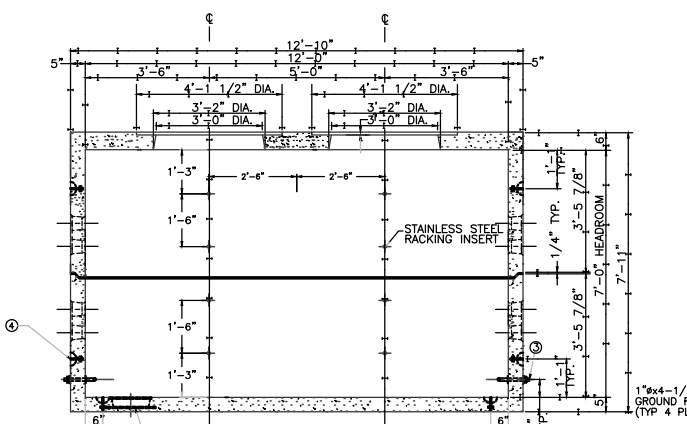

SECTION A-A

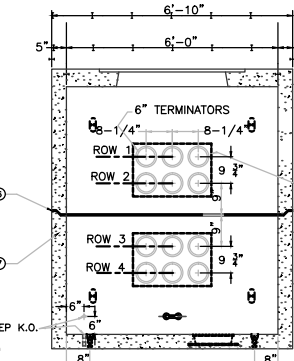


SECTION B-B


ADDING THE MANHOLE CENTER ASSEMBLY CONVERTS TYPE "A" MANHOLE TO TYPE "C" MANHOLE.

ITEM	DESCRIPTION	QTY	NOTE
	TOTAL MANHOLE WEIGHT	5000	40,615 LBS.
①	TOP SECTION WEIGHT	P.S.I.	13,570 LBS.
	BASE SECTION WEIGHT	CONC.	27,045 LBS.
⑦	REBAR, 60, EPOXY COATED	2	
⑧	6" DUCT TERMINATORS	24	
⑨	1 1/2" BUTYL RUBBER JOINT SEALANT ROLLS	4	
⑩	SUMP GRATE & 12"x12"x1/8" P	1	4
⑪	5" LIFTING ANCHORS	12	
⑫	1 1/2" S.S. PULLING IRONS	2	
⑬	1/2" x 3" DEEP S/S INSERTS	16	
⑭	WITH 1/2" x 3" S/S HEX HEAD BOLT AND WASHER		


- NOTES:
1. CONCRETE: 5000 psi @ 28 DAYS, 5%-8% ENTRAINED AIR, 4" MAX. SLUMP.
 2. REBAR: ASTM A-615 GRD. 60 EPOXY COATED.
 3. DUCT ENTRANCE: SINGLE DUCT TERMINATORS TO ACCEPT 6" DIAMETER SCH. 40 PVC CONDUIT. SEE DETAIL ON THIS SHEET.
 4. PLEASE NOTE PULLING IRON DESIGNED AS PER A.C.I. 318 FOR WORKING LOAD CAPACITY OF 28,000 POUNDS APPLIED COINCIDENT TO THE MAJOR AXIS OF THE PULLING IRON.
 5. IDENTIFICATION: IMPRESSED INTO CEILING OF VAULT.
 6. DESIGN CRITERIA:
 - A.) DESIGNED AND BUILT IN ACCORDANCE WITH ASTM C858 "STANDARD SPECIFICATION FOR UNDERGROUND PRECAST CONCRETE UTILITY STRUCTURES".
 - B.) ALL LOADING AS PER ASTM C857 "MINIMUM STRUCTURAL DESIGN LOADING FOR UNDERGROUND PRECAST CONCRETE UTILITY STRUCTURES" INCLUDING:
 - EARTH COVER: MIN. 2.0', MAX. 5.0'.
 - AASHTO HS-20 WHEEL LOAD AND APPLICABLE IMPACT.
 - VERTICAL AND LATERAL SOIL PRESSURES DETERMINED USING A SOIL DENSITY OF 120 PCF.
 - GROUND WATER AT 3'-0" BELOW GRADE.
 - C.) STRUCTURAL DESIGN PERFORMED USING AASHTO STRENGTH DESIGN METHOD.
 - D.) REINFORCING COVER REQUIREMENTS AS PER ACI 318.
 7. SEE SPECIFICATION C30-1900 FOR ROW IDENTIFICATION WITH CONDUIT.

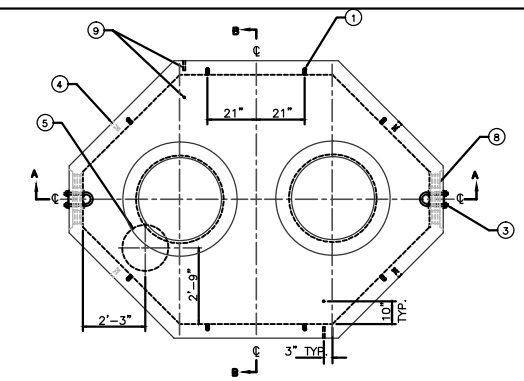


PLAN VIEW

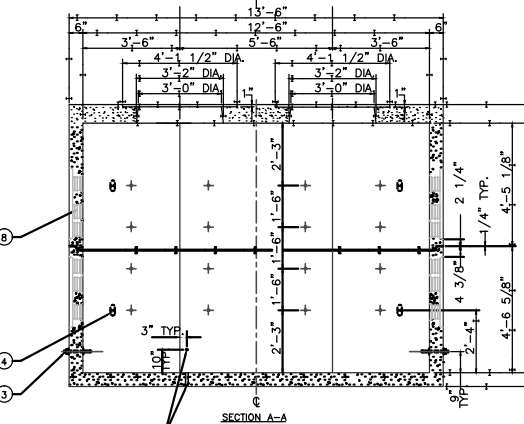

SECTION A-A

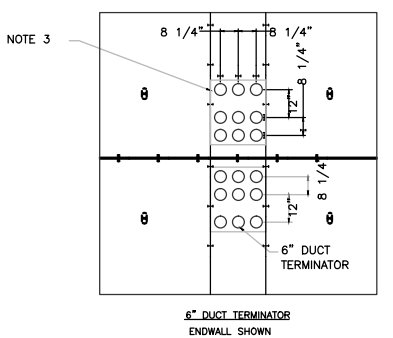

6" DUCT TERMINATOR ENDWALL SHOWN

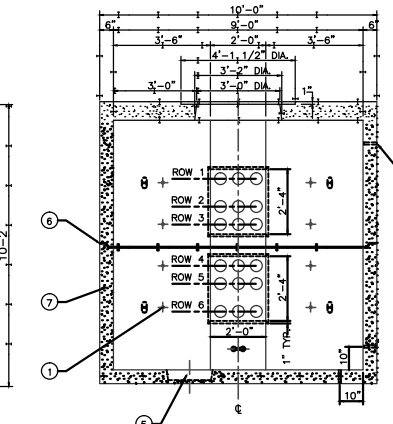


SECTION B-B

ITEM	DESCRIPTION	QTY	NOTE
	TOTAL MANHOLE WEIGHT	5000	42,470 LBS.
⑦	TOP SECTION WEIGHT	P.S.I.	21,470 LBS.
	BASE SECTION WEIGHT	CONC.	21,000 LBS.
⑦	REBAR, EPOXY COATED	2	
⑨	1 1/2" x 5 1/2" GROUND WIRE HOLE, 1/2" KNOCKOUT	4	
⑩	6" DUCT TERMINATORS	36	3
⑪	1 1/2" BUTYL RUBBER JOINT SEALANT	4	ROLLS
⑫	IBT SUMP DEPRESSION	1	
⑬	6" LIFTING ANCHORS	8	
⑭	1 1/2" S.S. PULLING IRONS	2	4
⑮	CABLE RACK INSERTS: 1/2" 304 STAINLESS STEEL THREADED INSERTS EACH WITH 1/2" x 2" 304 S.S. HEX HEAD BOLT, 1/2" S.S. WASHER, AND 1/2" PVC WASHER	32	


- NOTES:
1. CONCRETE: 5000 psi @ 28 DAYS, 5%-8% ENTRAINED AIR, 4" MAX. SLUMP.
 2. REBAR: ASTM A-615 GRD. 60, EPOXY COATED.
 3. DUCT ENTRANCE: SINGLE DUCT TERMINATORS TO ACCEPT 6" DIAMETER SCH. 40 PVC CONDUIT. SEE DETAIL THIS SHEET.
 4. PLEASE NOTE PULLING IRON DESIGNED AS PER A.C.I. 318 FOR WORKING LOAD CAPACITY OF 28,000 POUNDS APPLIED COINCIDENT TO THE MAJOR AXIS OF THE PULLING IRON.
 5. IDENTIFICATION: IMPRESSED INTO CEILING OF VAULT.
 6. DESIGN CRITERIA:
 - A.) DESIGNED AND BUILT IN ACCORDANCE WITH ASTM C858 "STANDARD SPECIFICATION FOR UNDERGROUND PRECAST CONCRETE UTILITY STRUCTURES".
 - B.) ALL LOADING AS PER ASTM C857 "MINIMUM STRUCTURAL DESIGN LOADING FOR UNDERGROUND PRECAST CONCRETE UTILITY STRUCTURES" INCLUDING:
 - EARTH COVER: MIN. 2.0', MAX. 5.0'.
 - AASHTO HS-20 WHEEL LOAD AND APPLICABLE IMPACT.
 - VERTICAL AND LATERAL SOIL PRESSURES DETERMINED USING A SOIL DENSITY OF 120 PCF.
 - GROUND WATER AT 3'-0" BELOW GRADE.
 - C.) STRUCTURAL DESIGN PERFORMED USING AASHTO STRENGTH DESIGN METHOD.
 - D.) REINFORCING COVER REQUIREMENTS AS PER ACI 318.
 7. SEE SPECIFICATION C30-1900 FOR ROW IDENTIFICATION WITH CONDUIT.

NAPEVILLE PUBLIC UTILITIES DEPARTMENT ELECTRIC DIVISION	TYPE A MANHOLE	DATE 08-08-08
	M30-1140	


NAPEVILLE PUBLIC UTILITIES DEPARTMENT ELECTRIC DIVISION	TYPE E MANHOLE	DATE 08-08-08
	M30-1160	

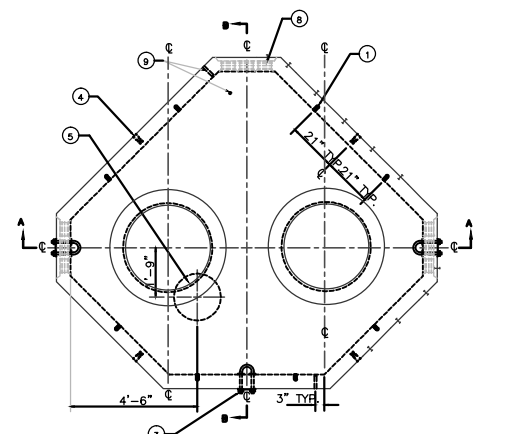


PLAN VIEW

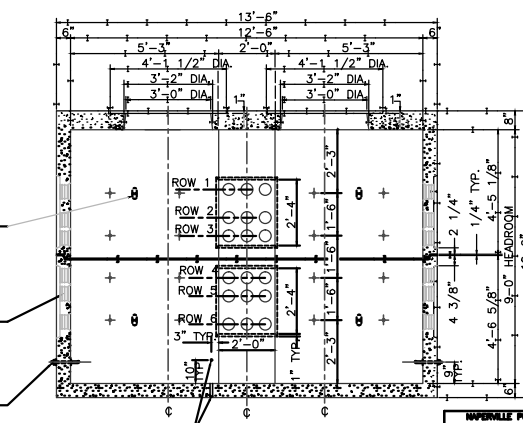

SECTION A-A

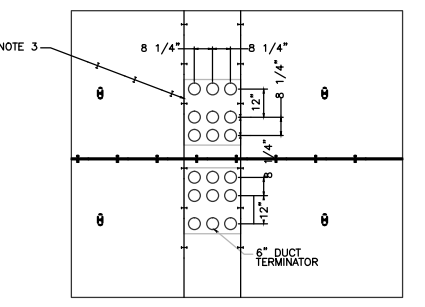

6" DUCT TERMINATOR ENDWALL SHOWN

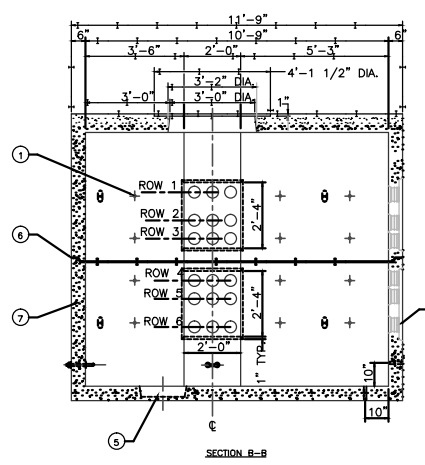


SECTION B-B

ITEM	DESCRIPTION	QTY	NOTE
	TOTAL MANHOLE WEIGHT	5000	45,470 LBS.
⑦	TOP SECTION WEIGHT	P.S.I.	23,470 LBS.
	BASE SECTION WEIGHT	CONC.	22,000 LBS.
⑦	REBAR, EPOXY COATED	2	
⑨	1 1/2" x 5 1/2" GROUND WIRE HOLE, 1/2" KNOCKOUT	4	
⑩	6" DUCT TERMINATORS	54	3
⑪	1 1/2" BUTYL RUBBER JOINT SEALANT	4	ROLLS
⑫	IBT SUMP DEPRESSION	1	
⑬	6" LIFTING ANCHORS	8	
⑭	1 1/2" S.S. PULLING IRONS	3	4
⑮	CABLE RACK INSERTS: 1/2" 304 STAINLESS STEEL THREADED INSERTS EACH WITH 1/2" x 2" 304 S.S. HEX HEAD BOLT, 1/2" S.S. WASHER, AND 1/2" PVC WASHER	32	

- NOTES:
1. CONCRETE: 5000 psi @ 28 DAYS, 5%-8% ENTRAINED AIR, 4" MAX. SLUMP.
 2. REBAR: ASTM A-615 GRD. 60, EPOXY COATED.
 3. PULLING IRON: 1 1/2" STAINLESS STEEL.
 4. ADD GROUND ROD KNOCKOUTS IN FLOOR AND WALLS.
 5. RACKING INSERTS: STAINLESS STEEL.
 6. IDENTIFICATION: IMPRESSED INTO CEILING OF VAULT.
 7. DESIGN CRITERIA:
 - A.) DESIGNED AND BUILT IN ACCORDANCE WITH ASTM C858 "STANDARD SPECIFICATION FOR UNDERGROUND PRECAST CONCRETE UTILITY STRUCTURES".
 - B.) ALL LOADING AS PER ASTM C857 "MINIMUM STRUCTURAL DESIGN LOADING FOR UNDERGROUND PRECAST CONCRETE UTILITY STRUCTURES" INCLUDING:
 - EARTH COVER: MIN. 2.0', MAX. 5.0'.
 - AASHTO HS-20 WHEEL LOAD AND APPLICABLE IMPACT.
 - VERTICAL AND LATERAL SOIL PRESSURES DETERMINED USING A SOIL DENSITY OF 120 PCF.
 - GROUND WATER AT 3'-0" BELOW GRADE.
 - C.) STRUCTURAL DESIGN PERFORMED USING AASHTO STRENGTH DESIGN METHOD.
 - D.) REINFORCING COVER REQUIREMENTS AS PER ACI 318.
 - 7.) SEE SPECIFICATION C30-1900 FOR ROW IDENTIFICATION WITH CONDUIT.

NAPEVILLE PUBLIC UTILITIES DEPARTMENT ELECTRIC DIVISION	TYPE G MANHOLE	DATE 08-08-08
	M30-1170	


3. 5 AND 6 INCH PLASTIC TRANSITION CONDUIT COUPLINGS
PVC TO HDPE
GALVANIZED STEEL TO HDPE

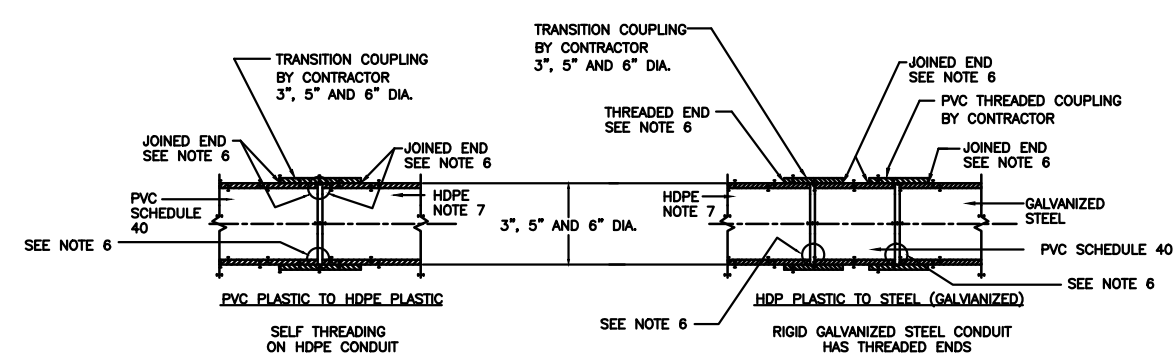


- NOTES:
- 1) CONTRACTOR SHALL SUPPLY TRANSITION COUPLING TO GO FROM HDPE TO STEEL AND HDPE TO PVC SCHEDULE 40.
 - 2) THE COST OF THIS MATERIAL IS INCLUDED IN UNIT PRICES FOR VAULTS AND HANDHOLES, PLUG CANS, FUSE CANS, SIDE WALK SPLICE BOXES AND CONDUIT.
 - 3) THE CONTRACTOR SHALL SUPPLY ALL TRANSITION COUPLINGS.
 - 4) THE CONTRACTOR SHALL NOT USE TRANSITION COUPLING TO CONNECT HDPE TO HDPE IN THE MAIN LINE. ALL MAINLINE CONNECTIONS SHALL BE BUTT FUSED.
 - 5) CONTRACTOR TO USE ELECTROFUSION PROCESS AT ALL TIMES TO MAKE HDPE TO HDPE CONNECTIONS.
 - 6) CONTRACTOR TO ASSEMBLE, CUT, ALIGN, BEVEL, AND FIT TO CREATE A SMOOTH INSIDE INTERFACE AT CONNECTION POINT.
 - 7) HDPE, PVC AND STEEL CONDUIT HAVE DIFFERENT INSIDE DIAMETER.
 - 8) ENCASE IN CONCRETE FOR 5 FEET.

PROJECT TITLE				ROUTE 59 ROAD IMPROVEMENTS			
PROJECT DESCRIPTION				DETAILS AND STANDARDS			
ENGINEER	DRAFTING DATE	MAP #	SCALE				
BCC	5-11-12	4211,4212,4223	N.T.S.				
GS DESIGN BY	DRAFTED BY	REVISIONS DATE	AT&T JOINT AGREEMENT #	PROJECT #			
DL	PSM		N/A	EU-12			
CHECKED BY	APPROVED BY	CAD FILE	SHEET #				
		0060648001D121.DWG	21 OF 63				
Naperville			Department of Public Utilities Electric Division		WORK REQUEST #		
					60468		


F.A.P. RTE.	SECTION	COUNTY	TOTAL SHEETS	SHEET NO.
338/IL 59	2011-035-1	DUPAGE		
FED. ROAD. DIST. NO.		ILLINOIS	CONTRACT 60P42	
		FED. AID PROJECT		

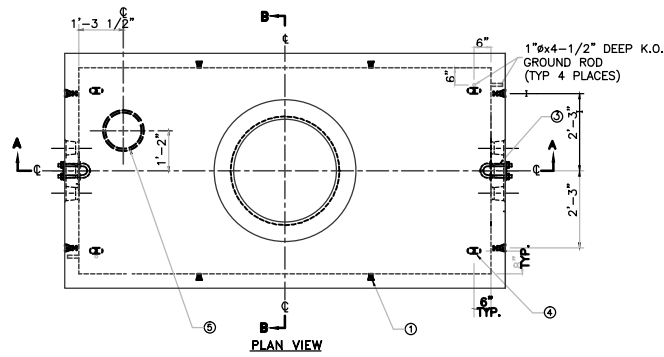

PLAN VIEW

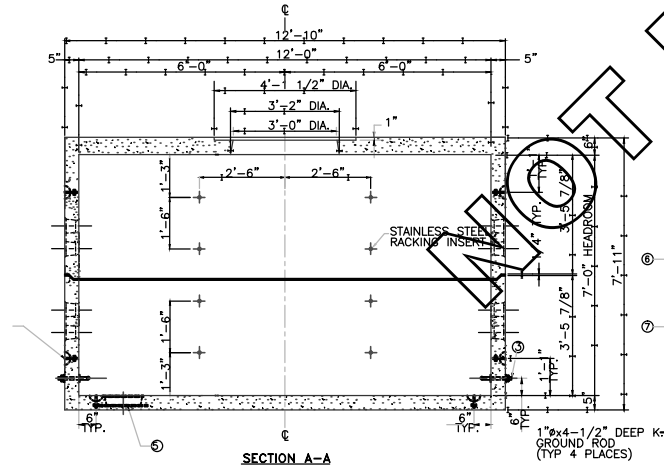

SECTION A-A

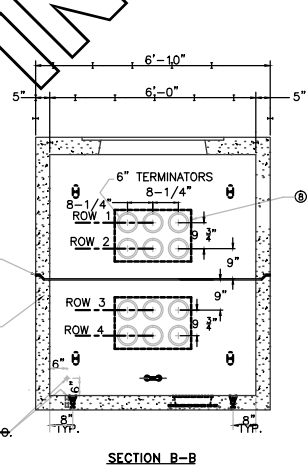

SECTION B-B


ITEM	DESCRIPTION	QTY	NOTE
	TOTAL MANHOLE WEIGHT	4500	27,405 LBS.
⑦	TOP SECTION WEIGHT	P.S.I.	14,100 LBS.
	BASE SECTION WEIGHT	CONC.	13,305 LBS.
⑦	REBAR, GR. 60, EPOXY COATED		2
⑧	6" DUCT TERMINATORS	24	
⑨	1" BUTYL RUBBER JOINT SEALANT	4 ROLLS	
⑩	SUMP GRATE & 12"x12"x1/8" PL	1	4
④	5" LIFTING ANCHORS	12	
③	1" S/S PULLING IRONS	2	
①	1/2" x 3" DEEP, S/S INSERTS WITH 1/2" x 3" S/S HEX HEAD BOLT AND WASHER.	16	

NOTES:


- CONCRETE: 4500 psi @ 28 DAYS, 5%-8% ENTRAINED AIR, 4" MAX. SLUMP.
- REBAR: ASTM A-615 GRD. 60 EPOXY COATED
- PULLING IRON: 1" STAINLESS STEEL
- ADD GROUNDROD KNOCKOUTS IN FLOOR AND WALLS.
- RACKING INSERTS: STAINLESS STEEL.
- IDENTIFICATION: IMPRESSED INTO CEILING OF VAULT.
- DESIGN CRITERIA:
 - DESIGNED AND BUILT IN ACCORDANCE WITH ASTM C858 STANDARD SPECIFICATION FOR UNDERGROUND PRECAST CONCRETE UTILITY STRUCTURES.
 - ALL LOADING AS PER ASTM C857 "MINIMUM STRUCTURAL DESIGN LOADING FOR UNDERGROUND PRECAST CONCRETE UTILITY STRUCTURES" INCLUDING:
 - EARTH COVER: MIN. 2.0', MAX. 5.0'
 - AASHTO HS-20 WHEEL LOAD AND APPLICABLE IMPACT.
 - VERTICAL AND LATERAL SOIL PRESSURES DETERMINED USING A SOIL DENSITY OF 120 PCF.
 - GROUNDWATER AT 3'-0" BELOW GRADE.
 - STRUCTURAL DESIGN PERFORMED USING AASHTO STRENGTH DESIGN METHOD.
 - REINFORCING COVER REQUIREMENTS AS PER ACI 318.
- CONTRACTOR SHALL CONFIRM DUCT LOCATION WITH INSPECTOR.
- SEE SPECIFICATION C30-1900 FOR ROW IDENTIFICATION WITH CONDUIT.

ADDING THE MANHOLE CENTER ASSEMBLY CONVERTS TYPE "A" MANHOLE TO TYPE "C" MANHOLE.


NAPEVILLE PUBLIC UTILITIES DEPARTMENT ELECTRIC STANDARDS	TYPE A MANHOLE	DATE: 12-18-04 M30-1140
---	-----------------------	----------------------------

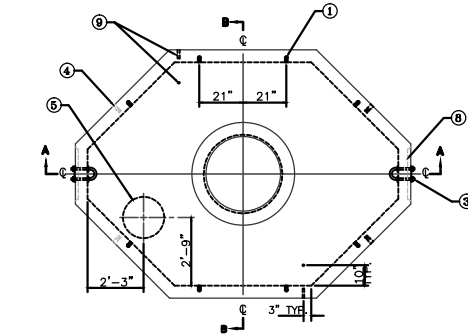


PLAN VIEW

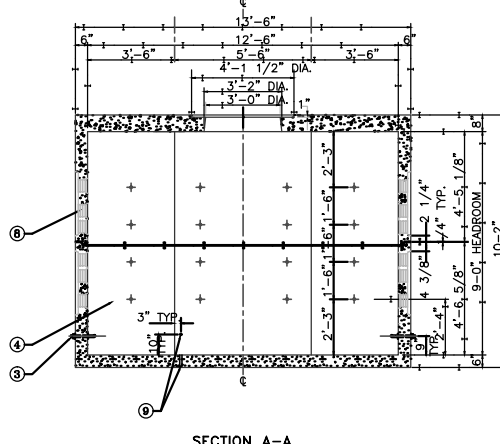

SECTION A-A

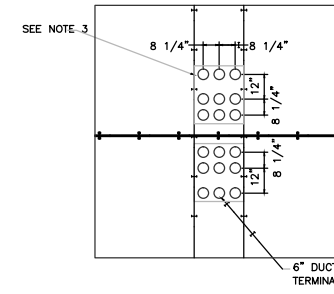

6" DUCT TERMINATOR
ENDWALL SHOWN

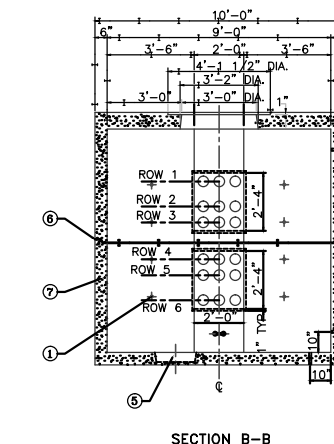


SECTION B-B

ITEM	DESCRIPTION	QTY	NOTE
	TOTAL MANHOLE WEIGHT	4500	43,000 LBS.
⑦	TOP SECTION WEIGHT	P.S.I.	22,000 LBS.
	BASE SECTION WEIGHT	CONC.	21,000 LBS.
⑦	REBAR, EPOXY COATED		2
⑨	1" x 5 1/2" GROUND WIRE HOLE, 1/2" KNOCKOUT		4
⑧	6" DUCT TERMINATORS	36	3
⑨	1" BUTYL RUBBER JOINT SEALANT	4 ROLLS	
④	IBT SUMP DEPRESSION	1	
④	6" LIFTING ANCHORS	8	
③	1" S/S PULLING IRONS	2	4
①	CABLE RACK INSERTS: 1/2" 304 STAINLESS STEEL THREADED INSERTS EACH WITH 1/2" x 2" 304 S.S. HEX HEAD BOLT, 1/2" S.S. WASHER, AND 1/2" PVC WASHER		32


NOTES:

- CONCRETE: 4500 psi @ 28 DAYS, 5%-8% ENTRAINED AIR, 4" MAX. SLUMP.
- REBAR: ASTM A-615 GRD. 60, EPOXY COATED.
- DUCT ENTRANCE: SINGLE DUCT TERMINATORS TO ACCEPT 6" DIAMETER SCH. 40 PVC CONDUIT. SEE DETAIL THIS SHEET.
- PLEASE NOTE PULLING IRON DESIGNED AS PER A.C.I. 318 FOR WORKING LOAD CAPACITY OF 25,000 POUNDS APPLIED CONCURRENT TO THE MAJOR AXIS OF THE PULLING IRON.
- IDENTIFICATION: IMPRESSED INTO CEILING OF VAULT.
- DESIGN CRITERIA:
 - DESIGNED AND BUILT IN ACCORDANCE WITH ASTM C858 STANDARD SPECIFICATION FOR UNDERGROUND PRECAST CONCRETE UTILITY STRUCTURES.
 - ALL LOADING AS PER ASTM C857 "MINIMUM STRUCTURAL DESIGN LOADING FOR UNDERGROUND PRECAST CONCRETE UTILITY STRUCTURES" INCLUDING:
 - EARTH COVER: MIN. 2.0', MAX. 5.0'
 - AASHTO HS-20 WHEEL LOAD AND APPLICABLE IMPACT.
 - VERTICAL AND LATERAL SOIL PRESSURES DETERMINED USING A SOIL DENSITY OF 120 PCF.
 - GROUNDWATER AT 3'-0" BELOW GRADE.
 - STRUCTURAL DESIGN PERFORMED USING AASHTO STRENGTH DESIGN METHOD.
 - REINFORCING COVER REQUIREMENTS AS PER ACI 318.
- SEE SPECIFICATION C30-1900 FOR ROW IDENTIFICATION WITH CONDUIT.


NAPEVILLE PUBLIC UTILITIES DEPARTMENT ELECTRIC STANDARDS	TYPE B MANHOLE	DATE: 12-24-04 M30-1160
---	-----------------------	----------------------------

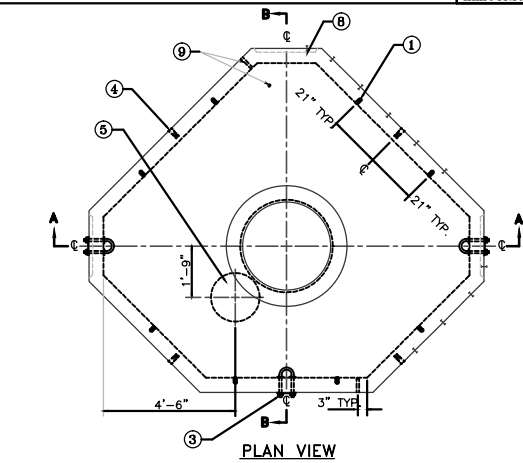


PLAN VIEW

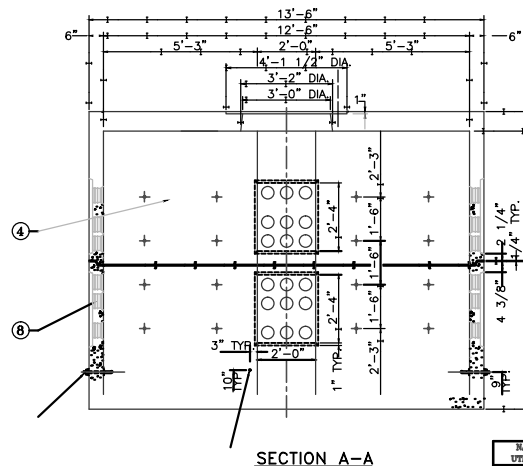

SECTION A-A

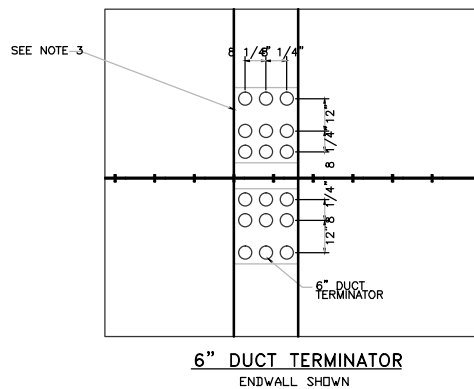

6" DUCT TERMINATOR
ENDWALL SHOWN

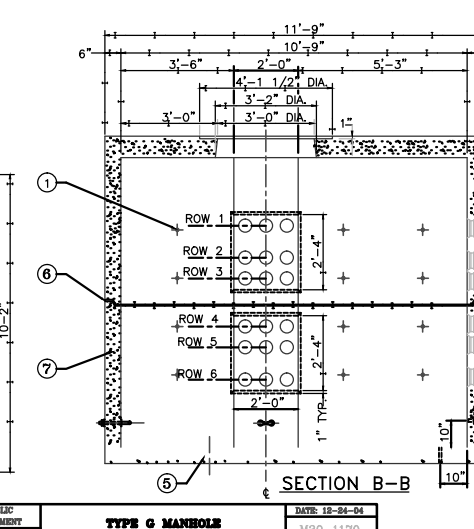

SECTION B-B

ITEM	DESCRIPTION	QTY	NOTE
	TOTAL MANHOLE WEIGHT	4500	46,000 LBS.
⑦	TOP SECTION WEIGHT	P.S.I.	24,000 LBS.
	BASE SECTION WEIGHT	CONC.	22,000 LBS.
⑦	REBAR, EPOXY COATED		2
⑨	1" x 5 1/2" GROUND WIRE HOLE, 1/2" KNOCKOUT	4	
⑧	6" DUCT TERMINATORS	36	3
⑨	1" BUTYL RUBBER JOINT SEALANT	4 ROLLS	
④	IBT SUMP DEPRESSION	1	
④	6" LIFTING ANCHORS	8	
③	1" S/S PULLING IRONS	2	4
①	CABLE RACK INSERTS: 1/2" 304 STAINLESS STEEL THREADED INSERTS EACH WITH 1/2" x 2" 304 S.S. HEX HEAD BOLT, 1/2" S.S. WASHER, AND 1/2" PVC WASHER		32

NOTES:

- CONCRETE: 4500 psi @ 28 DAYS, 5%-8% ENTRAINED AIR, 4" MAX. SLUMP.
- REBAR: ASTM A-615 GRD. 60, EPOXY COATED.
- DUCT ENTRANCE: SINGLE DUCT TERMINATORS TO ACCEPT 6" DIAMETER SCH. 40 PVC CONDUIT. SEE DETAIL THIS SHEET.
- PLEASE NOTE PULLING IRON DESIGNED AS PER A.C.I. 318 FOR WORKING LOAD CAPACITY OF 25,000 POUNDS APPLIED CONCURRENT TO THE MAJOR AXIS OF THE PULLING IRON.
- IDENTIFICATION: IMPRESSED INTO CEILING OF VAULT.
- DESIGN CRITERIA:
 - DESIGNED AND BUILT IN ACCORDANCE WITH ASTM C858 STANDARD SPECIFICATION FOR UNDERGROUND PRECAST CONCRETE UTILITY STRUCTURES.
 - ALL LOADING AS PER ASTM C857 "MINIMUM STRUCTURAL DESIGN LOADING FOR UNDERGROUND PRECAST CONCRETE UTILITY STRUCTURES" INCLUDING:
 - EARTH COVER: MIN. 2.0', MAX. 5.0'
 - AASHTO HS-20 WHEEL LOAD AND APPLICABLE IMPACT.
 - VERTICAL AND LATERAL SOIL PRESSURES DETERMINED USING A SOIL DENSITY OF 120 PCF.
 - GROUNDWATER AT 3'-0" BELOW GRADE.
 - STRUCTURAL DESIGN PERFORMED USING AASHTO STRENGTH DESIGN METHOD.
 - REINFORCING COVER REQUIREMENTS AS PER ACI 318.
- SEE SPECIFICATION C30-1900 FOR ROW IDENTIFICATION WITH CONDUIT.




NOTE:

- EXISTING MANHOLES USUALLY SINGLE OPENING MANHOLES

NAPEVILLE PUBLIC UTILITIES DEPARTMENT ELECTRIC STANDARDS	TYPE C MANHOLE	DATE: 12-24-04 M30-1170
---	-----------------------	----------------------------

PROJECT TITLE				ROUTE 59 ROAD IMPROVEMENTS			
PROJECT DESCRIPTION				DETAILS AND STANDARDS			
ENGINEER	DRAFTING DATE	MAP #	SCALE				
BCC	5-11-12	4211,4212,4223	N.T.S.				
DESIGNED BY	DRAFTED BY	REVISIONS DATE	AT&T JOINT AGREEMENT #	PROJECT #			
DL	PSM		N/A	EU-12			
CHECKED BY	APPROVED BY	CAD FILE	SHEET #				
		0060648001D122.DWG	22 OF 63				
Naperville		Department of Public Utilities Electric Division		WORK REQUEST #			
				60468			

F.A.P. RTE.	SECTION	COUNTY	TOTAL SHEETS	SHEET NO.
338/IL 59	2011-035-1	DUPAGE		
CONTRACT 60P42				
FED.ROAD.DIST.NO.	ILLINOIS	FED. AID PROJECT		

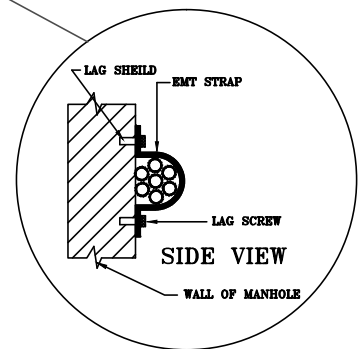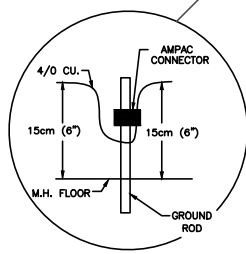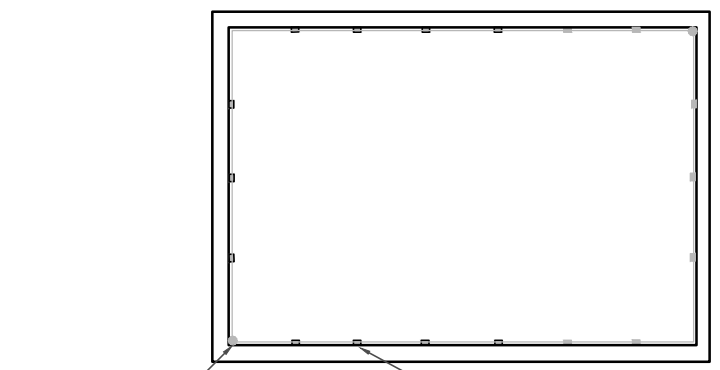



UGMH: GROUNDING MANHOLE

Item	Item Code	Description 1	Description 2	QTY	QTY	QTY	QTY
A	280 107 00070	CU BARE SD	4/0 7-STR	40	40		200
B	283 155 00030	GROUND ROD, COPPER CLAD	5/8" X 6' USE 10 FOOTER	4		4	4
C	283 155 00040	COUPLING, BRONZE	5/8" ROD	2		2	2
D	284 199 00460	LAG SHIELD, LEAD SHEET	1/4"	28			
E	284 199 00470	LAG SCREW, SS	1/4" X 1"	28	28		
F	285 199 00200	STRAP, EMT	1/2" SS	28	28		
G	286 100 00260	CONNECTOR, WEDGE CU	4/0 STR(7) - 4/0 STR(7)	1		1	2
H	286 100 00320	CONNECTOR, WEDGE CU	4/0 STR(7) - 5/8" ROD	2		2	
I	286 101 00010	SHELL, WEDGE AMP	WHITE	3	3		

- KEEP 4/0 CU IN ONE PIECE AROUND INNER WALL; TIE TOGETHER WITH ONE AMPAC.
- 4/0 IS SUPPORTED ALONG INNER WALL OF M.H., 15cm (6") ABOVE M.H. FLOOR, AT (2 FOOT) INTERVALS.
- COPPER STRAP AND LEAD ANCHOR SHALL BE INSTALL AT 60cm (TWO FOOT) INTERVALS.
- THE TWO KNOCKOUTS IN THE FLOOR SHOULD BE USED. IF SOLID ROCK IS ENCOUNTERED UNDER THE MANHOLE, REFER TO ENGINEERING.
- TWO 1.5 METER (5') GROUND RODS AND ONE COUPLING SHOULD BE INSTALLED WITH A DRIVING STUD PER KNOCKOUT.
- SEE STANDARD C30-0020 FOR COUNTERPOISE IF TYPICAL DRIVEN GROUNDS ARE IMPOSSIBLE.

ASSEMBLY CODES		
CODE	QTY	DESCRIPTION
UGMH	1	GROUNDING MANHOLE

NAPEVILLE PUBLIC UTILITIES DEPARTMENT ELECTRIC DIVISION	GROUNDING DETAIL TYPE "A" MANHOLE	DATE: 03-17-04 C30-1140
--	-----------------------------------	----------------------------

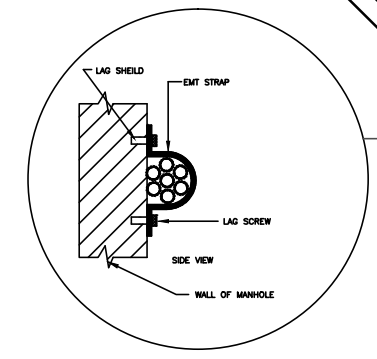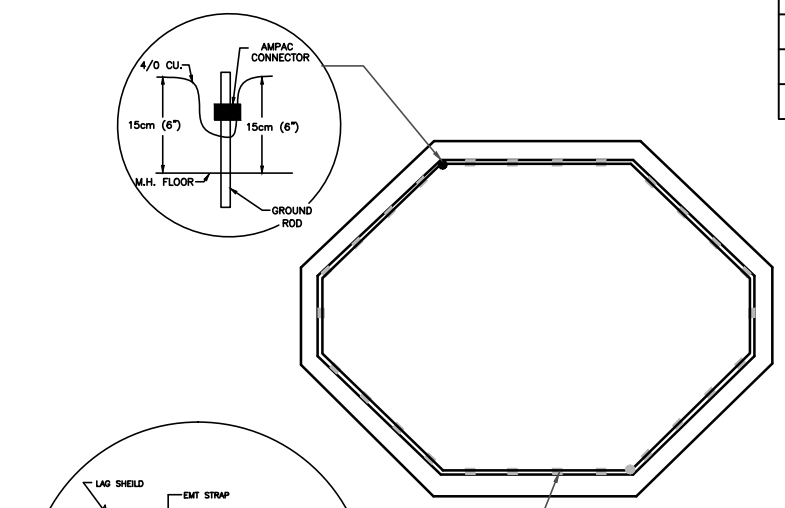




UGMH: GROUNDING MANHOLE

Item	Item Code	Description 1	Description 2	QTY	QTY	QTY	QTY
A	280 107 00070	CU BARE SD	4/0 7-STR	40	40		200
B	283 155 00030	GROUND ROD, COPPER CLAD	5/8" X 6' USE 10 FOOTER	4		4	4
C	283 155 00040	COUPLING, BRONZE	5/8" ROD	2		2	2
D	284 199 00460	LAG SHIELD, LEAD SHEET	1/4"	28			
E	284 199 00470	LAG SCREW, SS	1/4" X 1"	28	28		
F	285 199 00200	STRAP, EMT	1/2" SS	28	28		
G	286 100 00260	CONNECTOR, WEDGE CU	4/0 STR(7) - 4/0 STR(7)	1		1	2
H	286 100 00320	CONNECTOR, WEDGE CU	4/0 STR(7) - 5/8" ROD	2		2	
I	286 101 00010	SHELL, WEDGE AMP	WHITE	3	3		

- KEEP 4/0 CU IN ONE PIECE AROUND INNER WALL; TIE TOGETHER WITH ONE AMPAC.
- 4/0 IS SUPPORTED ALONG INNER WALL OF M.H., 15cm (6") ABOVE M.H. FLOOR, AT (2 FOOT) INTERVALS.
- COPPER STRAP AND LEAD ANCHOR SHALL BE INSTALL AT 60cm (TWO FOOT) INTERVALS.
- THE TWO KNOCKOUTS IN THE FLOOR SHOULD BE USED. IF SOLID ROCK IS ENCOUNTERED UNDER THE MANHOLE, REFER TO ENGINEERING.
- TWO 1.5 METER (5') GROUND RODS AND ONE COUPLING SHOULD BE INSTALLED WITH A DRIVING STUD PER KNOCKOUT.
- SEE STANDARD C30-0020 FOR COUNTERPOISE IF TYPICAL DRIVEN GROUNDS ARE IMPOSSIBLE.

ASSEMBLY CODES		
CODE	QTY	DESCRIPTION
UGMH	1	GROUNDING MANHOLE

NAPEVILLE PUBLIC UTILITIES DEPARTMENT ELECTRIC DIVISION	GROUNDING DETAIL TYPE "E" MANHOLE	DATE: 03-17-04 C30-1160
--	-----------------------------------	----------------------------

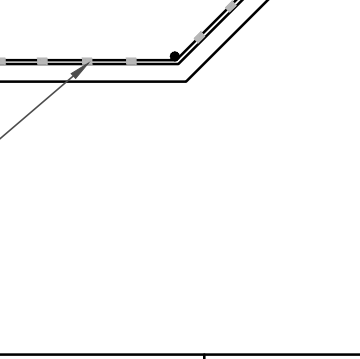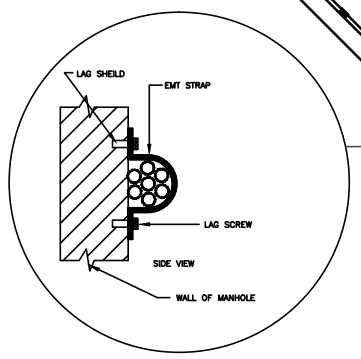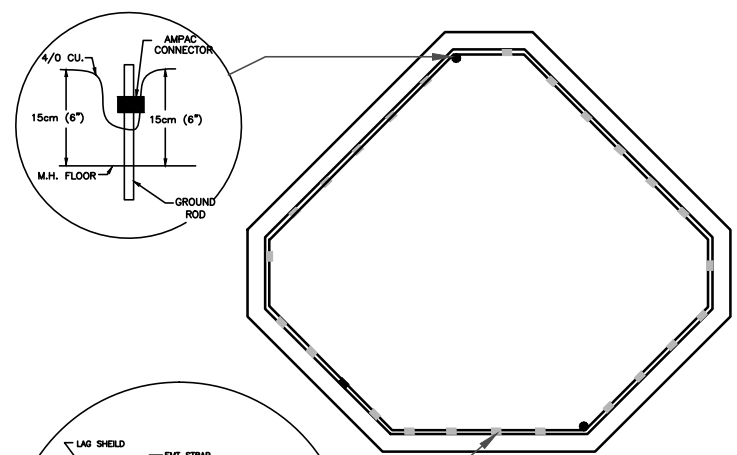

UGMH: GROUNDING MANHOLE

Item	Item Code	Description 1	Description 2	QTY	QTY	QTY	QTY
A	280 107 00070	CU BARE SD	4/0 7-STR	40	40		200
B	283 155 00030	GROUND ROD, COPPER CLAD	5/8" X 6' USE 10 FOOTER	4		4	4
C	283 155 00040	COUPLING, BRONZE	5/8" ROD	2		2	2
D	284 199 00460	LAG SHIELD, LEAD SHEET	1/4"	28			
E	284 199 00470	LAG SCREW, SS	1/4" X 1"	28	28		
F	285 199 00200	STRAP, EMT	1/2" SS	28	28		
G	286 100 00260	CONNECTOR, WEDGE CU	4/0 STR(7) - 4/0 STR(7)	1		1	2
H	286 100 00320	CONNECTOR, WEDGE CU	4/0 STR(7) - 5/8" ROD	2		2	
I	286 101 00010	SHELL, WEDGE AMP	WHITE	3	3		

- KEEP 4/0 CU IN ONE PIECE AROUND INNER WALL; TIE TOGETHER WITH ONE AMPAC.
- 4/0 IS SUPPORTED ALONG INNER WALL OF M.H., 15cm (6") ABOVE M.H. FLOOR, AT (2 FOOT) INTERVALS.
- COPPER STRAP AND LEAD ANCHOR SHALL BE INSTALL AT 60cm (TWO FOOT) INTERVALS.
- THE TWO KNOCKOUTS IN THE FLOOR SHOULD BE USED. IF SOLID ROCK IS ENCOUNTERED UNDER THE MANHOLE, REFER TO ENGINEERING.
- TWO 1.5 METER (5') GROUND RODS AND ONE COUPLING SHOULD BE INSTALLED WITH A DRIVING STUD PER KNOCKOUT.
- SEE STANDARD C30-0020 FOR COUNTERPOISE IF TYPICAL DRIVEN GROUNDS ARE IMPOSSIBLE.

ASSEMBLY CODES		
CODE	QTY	DESCRIPTION
UGMH	1	GROUNDING MANHOLE












NAPEVILLE PUBLIC UTILITIES DEPARTMENT ELECTRIC DIVISION	GROUNDING DETAIL TYPE "G" MANHOLE	DATE: 03-17-04 C30-1170
--	-----------------------------------	----------------------------

NOTES:

- ALL MANHOLES SHALL BE INSTALLED AND GROUNDS INSTALLED AND GROUND RODS TESTED IMMEDIATELY.
- IF TESTING INDICATES A GROUND RESISTANCE MORE THAN 25 OHMS ADDITIONAL RODS NEED TO BE ADDED OR COUNTER POISE INSTALLED.
- THE COUNTER POISE IF REQUIRED, WILL BE INSTALLED IN THE TRENCH WHEN THE DUCT IS INSTALLED. INSTALL 4/0 BARE 7-STRAND COPPER WIRE THRU THE 2-KNOCKOUTS IN WALL. TRAIN AROUND MANHOLE TO DUCT RUNS AND INSTALL 200 FEET OF COUNTER POISE IN TWO DIRECTIONS FROM MANHOLE ABOVE DUCT AND BEFORE BACK FILLING.
- CONTRACTOR IS ADVISED IF THE DUCT IS INSTALLED PRIOR TO MANHOLE WORK. THE CONTRACTOR SHALL TEST SOIL RESISTANCE AT MANHOLE LOCATION PRIOR TO INSTALLING DUCT.
- AFTER COUNTER POISE IS INSTALLED GROUNDS SHALL BE RETESTED AND FINDINGS GIVEN TO THE CITY.

PROJECT TITLE				ROUTE 59 ROAD IMPROVEMENTS			
PROJECT DESCRIPTION				DETAILS AND STANDARDS			
ENGINEER	DRAFTING DATE	MAP #	SCALE				
BCC	5-11-12	4211,4212,4223	N.T.S.				
DESIGN BY	DRAFTED BY	REVISIONS DATE	AT&T JOINT AGREEMENT #	PROJECT #			
DL	PSM		N/A	EU-12			
CHECKED BY	APPROVED BY	CAD FILE	SHEET #				
		0060648001D13DWG	23 OF 63				
Naperville			Department of Public Utilities Electric Division			WORK REQUEST #	
						60468	



F.A.P. RTE.	SECTION	COUNTY	TOTAL SHEETS	SHEET NO.
338/IL 59	2011-035-1	DUPAGE		
FED. ROAD. DIST. NO.		ILLINOIS	CONTRACT 60P42	
		FED. AID PROJECT		

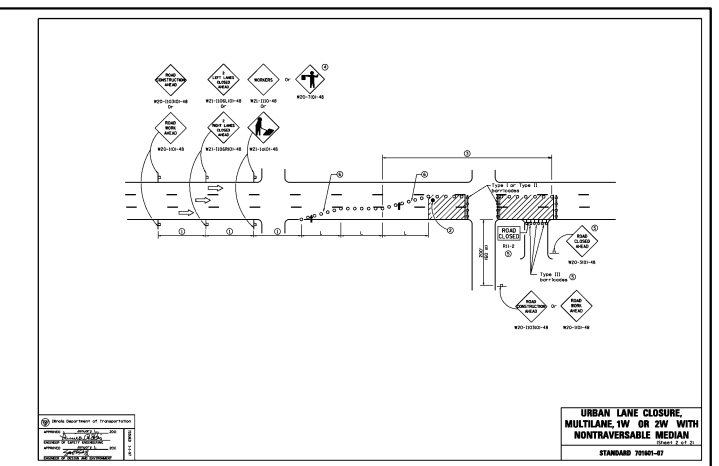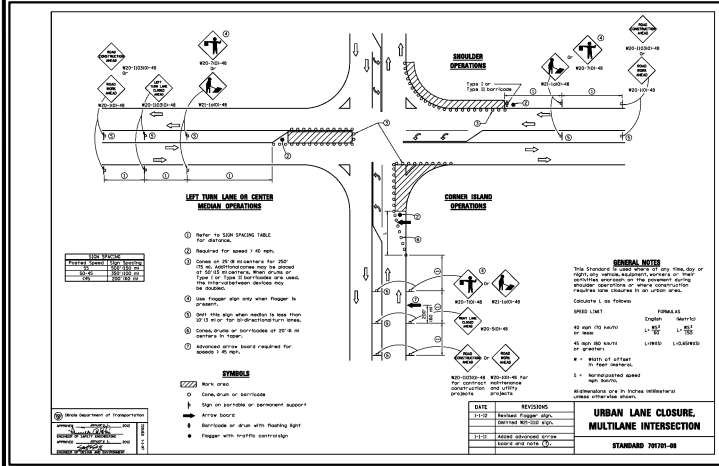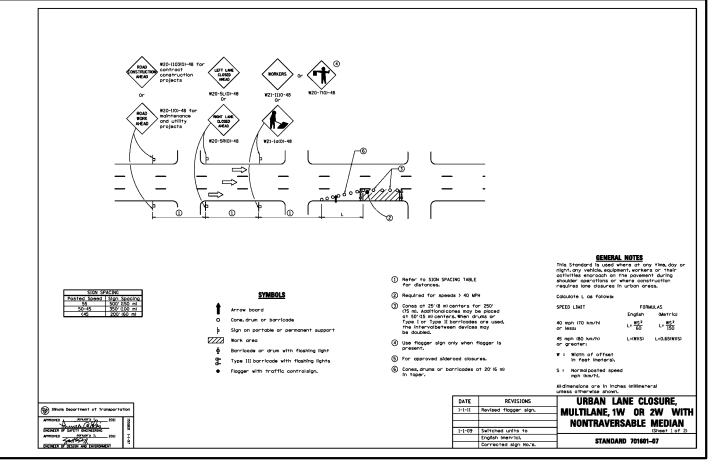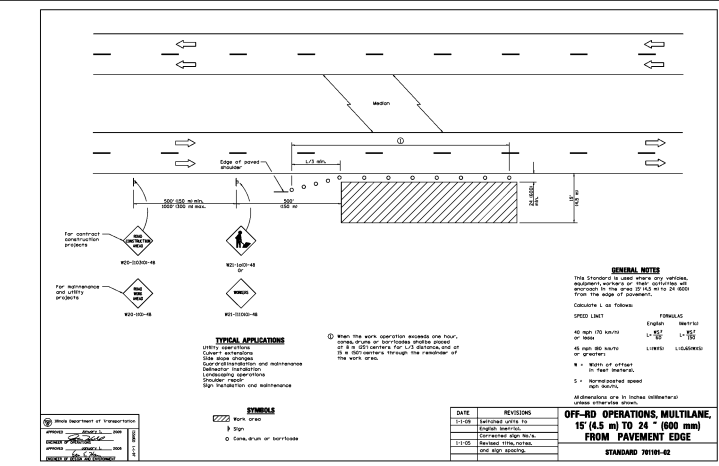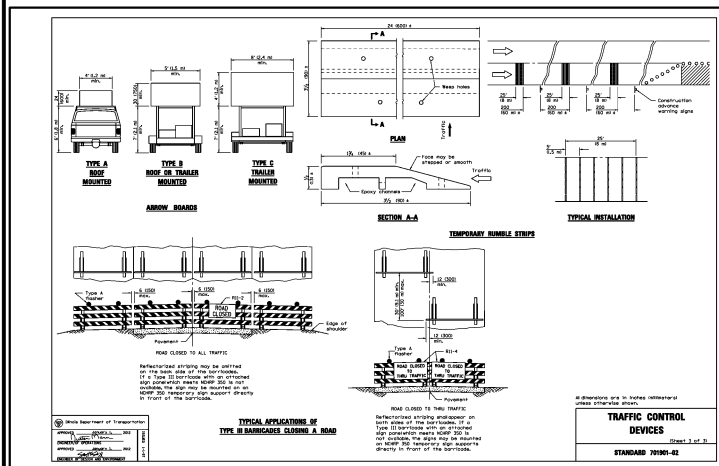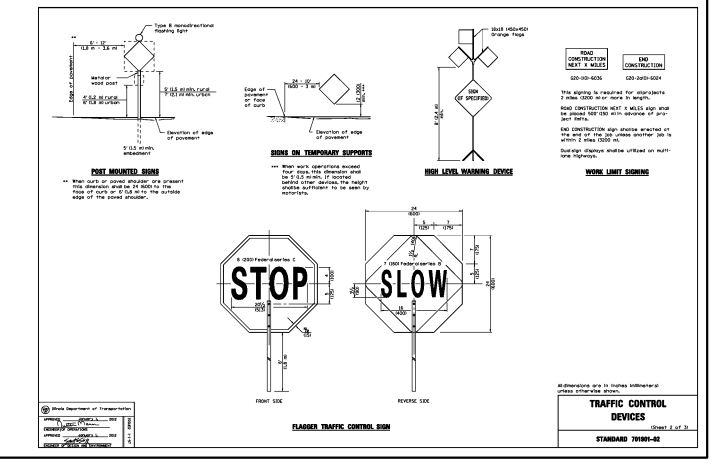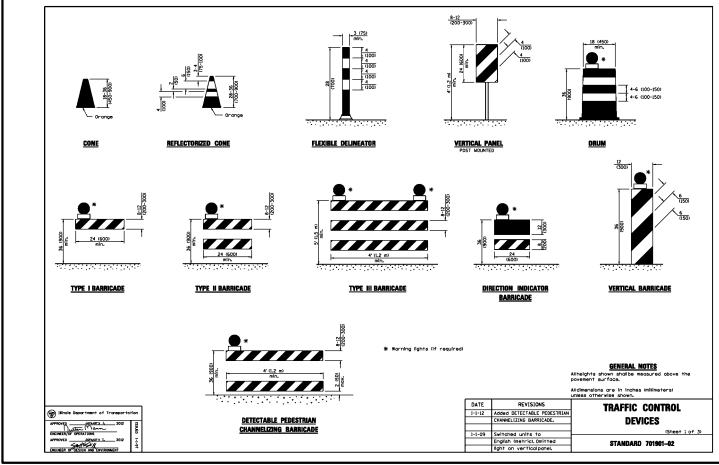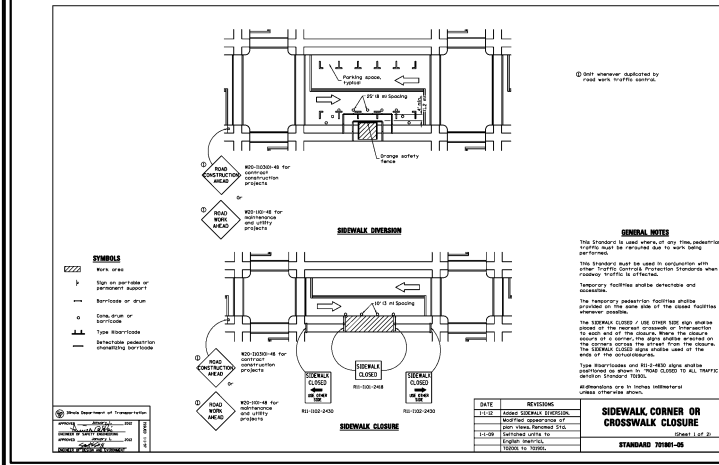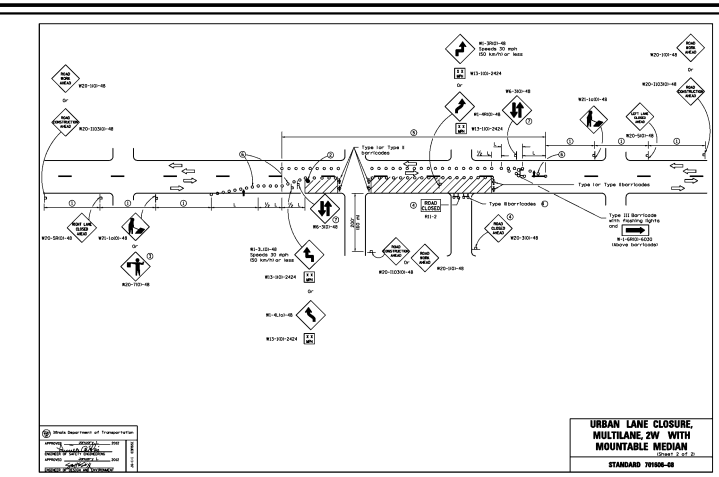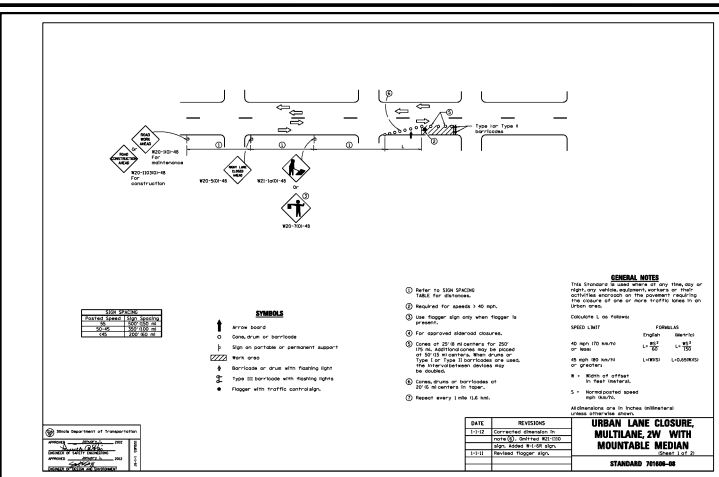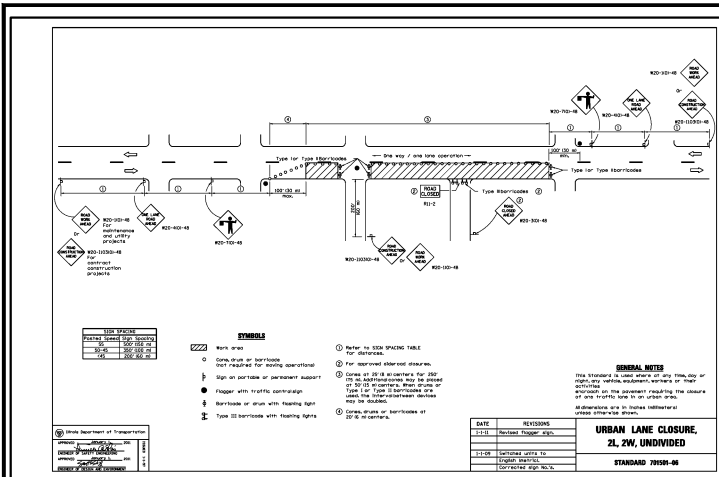

- TRAFFIC CONTROL AND PROTECTION**
- All work conducted within public right-of-ways shall be governed by the following specifications for traffic control. Traffic Control shall be in accordance with the applicable articles of section 107 and 700 of the "Standard Specifications for Road and Bridge Construction", the latest edition of the Illinois Manual on Uniform Traffic Control Devices for Streets and Highways and special details of Illinois Highway Standards listed herein.
 - Special attention is called to articles 107.09 of the Standard Specifications and the following highway standards, details and supplemental specifications and mimeographed special provisions contained herein, relating to traffic control.
 - The CONTRACTOR shall contact the local agency at least 72 hours in advance of beginning work.
 - Standards
70101 701501 701602 701801
701301 701502 701606 701901
701401 701601 701701 704001
 - At the pre-construction meeting the CONTRACTOR shall furnish the name of the individual in his direct employ who is to be responsible for the installation and maintenance of the traffic control for this project. If the actual installation and maintenance are to be accomplished by SUB-CONTRACTOR, consent shall be requested of the ENGINEER at the time of the pre-construction meeting in accordance with Article 108.01 of the Standard Specifications. This shall not relieve the CONTRACTOR of the foregoing requirement for a responsible individual in his direct employ to supervise the work. The CONTRACTOR will provide the name of its representative who will be responsible for the administration of the traffic control plan.
 - This item of work shall include furnishing, installing, maintaining, relocating and removing all traffic control devices used for the purpose of regulating, warning or directing traffic during the construction or maintenance of this improvement.
 - Traffic control and protection shall be provided as called for in the plans, these special provisions, applicable highway standards, applicable sections of the standard specifications, or as directed by the ENGINEER.
 - The following traffic control requirements are of special importance. Conformance to these requirements, however, shall not relieve the CONTRACTOR from conforming to all other applicable requirements of the Standard Specifications for Road and Bridge Construction.
 - The governing factor in the execution and staging of work for this project is to provide the motoring public with the safest possible conditions along the roadway through this construction zone. The CONTRACTOR shall so arrange his operation as to keep the closing of any lane of the roadway to a minimum.
 - All traffic control devices used on this project shall conform to the plans, special provisions, traffic control standards, "Standard Specifications for Traffic Control Devices" and the "Illinois Manual on Uniform Traffic Control Devices for Streets and Highways". No modification of these requirements will be allowed without prior written approval of the ENGINEER.
 - Traffic control devices include: signs and their supports, signals, pavement markings, barricades with sand bags, channelizing devices, warning lights, arrow boards, flags, or any other device used for the purpose of regulating, warning or guiding traffic through the construction zone.
 - The CONTRACTOR shall be responsible for the proper location, installation, and arrangement of all traffic control devices. Special attention shall be given to advance warning signs during construction operations in order to keep lane assignment constant with barricade placement at all times. The CONTRACTOR shall cover all traffic control devices which are inconsistent with detour or lane assignment patterns during the transition from one construction stage to another.
 - Construction signs referring to daytime lane closures during working hours shall be removed or covered during non-working hours.
 - The CONTRACTOR shall coordinate all traffic control work on this project with adjoining or overlapping projects, including barricade placement necessary to provide a uniform traffic detour pattern. When directed by the ENGINEER, the CONTRACTOR shall remove all traffic control devices which were furnished, installed and maintained by him under this contract and such devices shall remain the property of the CONTRACTOR. All traffic control devices shall remain in place until specific authorization for relocation or removal is received from the ENGINEER.
 - The CONTRACTOR shall ensure that all traffic control devices installed by him are operational 24 hours a day, including Sundays and Holidays.
 - The CONTRACTOR shall provide a manned telephone on a continuous 24-hour-a-day basis to receive notification of any deficiencies regarding traffic control and protection and shall dispatch men, materials and equipment to correct any such deficiencies. The CONTRACTOR shall respond to any call from the department concerning any request for improving or correcting traffic control devices and begin the requested repairs within two hours from the time of notification.
 - When traveling in lanes open to the public the CONTRACTOR'S vehicles shall always move with and not against the flow of traffic. These vehicles shall enter or leave work areas in a manner which will not be hazardous to, or interfere with, traffic and shall not park or stop except within designated work areas. Personal vehicles shall not park within the right-of-way except in specific areas designated by the ENGINEER.
 - Any drop off greater than three inches, but less than six inches within eight feet of the pavement edge shall be protected by Type I or II barricades equipped with mono-directional steady burn lights at 100 foot center to center spacing. If the drop off within eight feet of the pavement edge exceeds six inches, the barricades mentioned above shall be placed at 50 foot center to center spaces. Barricades that must be placed in excavated areas shall have leg extensions installed such that the top of the barricade is in compliance with the height requirements of standard 702001. Vertical panel or other delineating device may be substituted for Type I or II barricades with the approval of the ENGINEER.
 - Check barricades shall be placed in work areas perpendicular to traffic every 100 feet, one (1) lane and shoulder, to prevent motorist from using work areas as a travel way. Additional check barricades shall be placed in advance of any hazard in the work area which would endanger a motorist. Check barricades shall be Type I or II and equipped with a flashing light.
 - Placement of all signs and barricades shall proceed in the direction of flow of traffic. Removal of all signs and barricades shall start at the end of the construction area and proceed toward oncoming traffic unless otherwise directed by the ENGINEER.
 - Delays on the CONTRACTOR caused by complying with these requirements will be considered incidental to the item for traffic control and protection, and no additional compensation will be allowed.
 - This item of work will be measured on a lump sum basis for furnishing, installing, maintaining, relocating and removing the traffic control devices required in the plans and these special provisions. Payment for traffic control and protection shall be considered as included in the work being done or as specified in the contract.



PROJECT TITLE				ROUTE 59 ROAD IMPROVEMENTS			
PROJECT DESCRIPTION				DETAILS AND STANDARDS			
ENGINEER	BCC	DRAFTING DATE	5-11-12	MAP #	4211,4212,4223	SCALE	N.T.S.
DESIGN BY	DL	DRAFTED BY	PSM	AT&T JOINT AGREEMENT #	N/A	PROJECT #	EU-12
CHECKED BY		APPROVED BY		CAD FILE	0060648001D124.DWG	SHEET #	24 OF 63
Naperville				Department of Public Utilities Electric Division			
				WORK REQUEST # 60468			

F.A.P. RTE.	SECTION	COUNTY	TOTAL SHEETS	SHEET NO.
338/IL 59	2011-035-1	DUPAGE		
FED.ROAD.DIST.NO.			ILLINOIS	
			CONTRACT 60P42	
			FED. AID PROJECT	

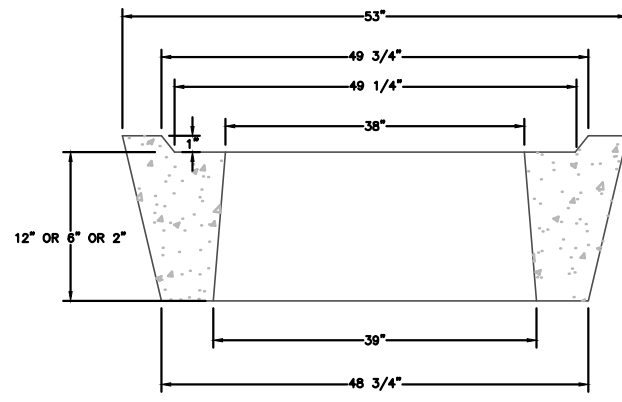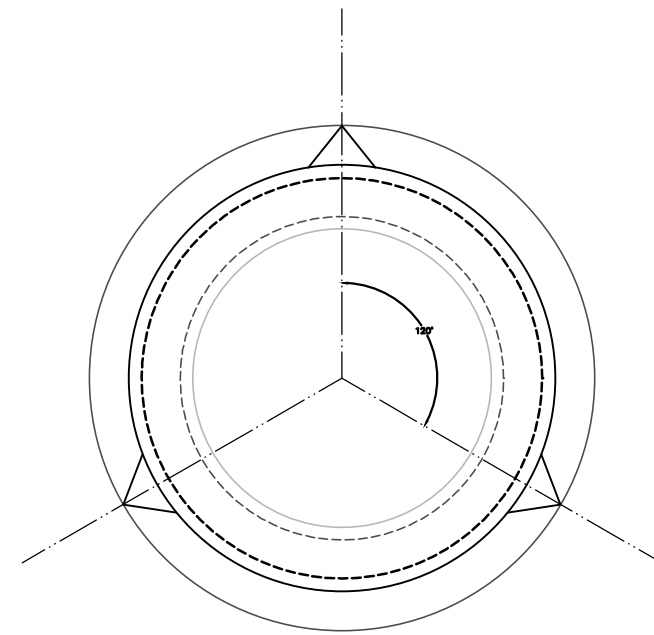

- NOTES:
1. CONCRETE 4500 PSI AT 28 DAYS
 2. EACH ADJUSTING RING SHALL COME WITH 14 FEET OF 1" INCH DIAMETER JOINT SEALANT TAPE.


**MANHOLE
ADJUSTING RING**

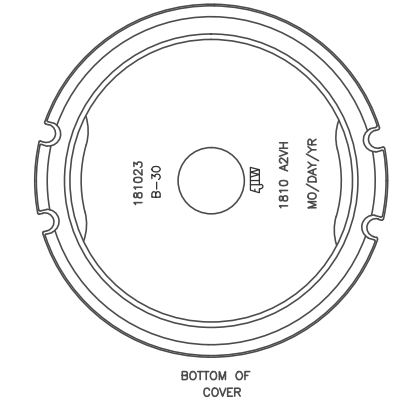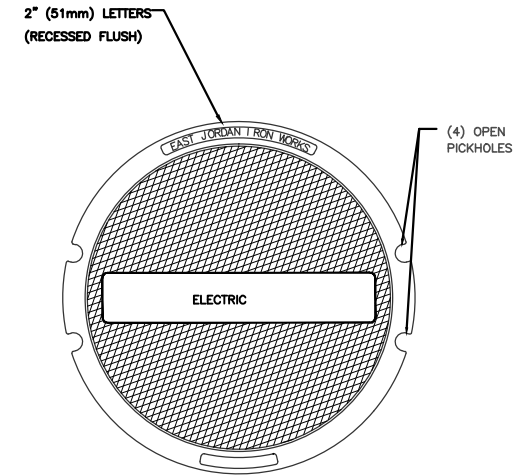


EAST JORDAN
IRON WORKS, INC.
P.O. BOX 439
EAST JORDAN, MI. 49727
1-800-874-4100
FAX 231-536-4458

EST. WT.
COVER: 295 LBS 134kg

✓ MACHINED SURFACE

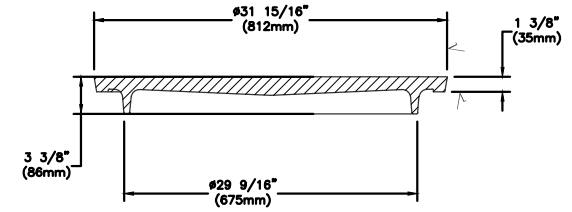


COVER SECTION

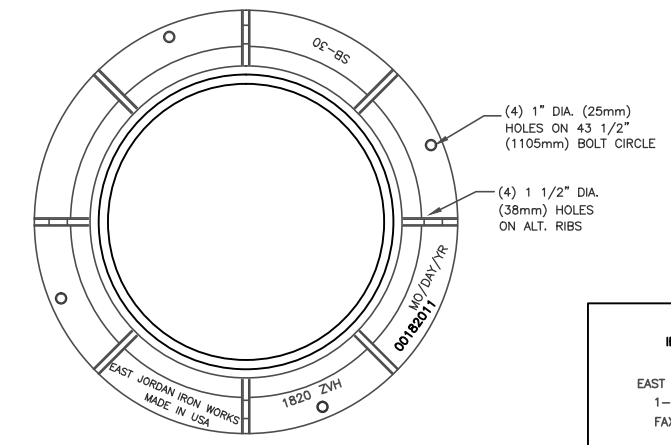

EAST JORDAN
IRON WORKS, INC.
P.O. BOX 439
EAST JORDAN, MI. 49727
1-800-874-4100
FAX 231-536-4458

EST. WT.
FRAME: 295 LBS 134kg

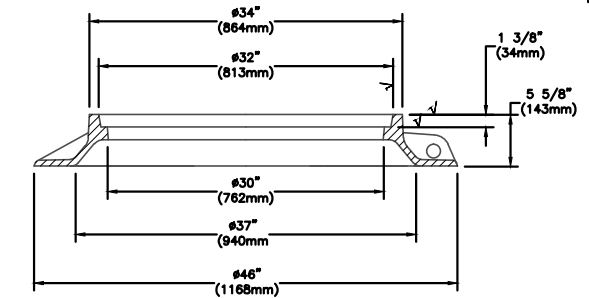

✓ MACHINED SURFACE


FRAME SECTION

- NOTES:
- 1) CONTRACTOR IS ADVISED THE MANHOLE AS SUPPLIED FROM UTILITY CONCRETE PRODUCTS (UCP). IS SHIPPED WITH 4-12" ADJUSTING RING ONLY.
 - 2) CONTRACTOR IS ADVISED THAT 2" AND 6" ADJUSTING RINGS ARE AVAILABLE FROM THE CITY, IF REQUESTED BY THE CONTRACTOR. CONTRACTOR TO PICK UP AND IS INCIDENTAL TO THE CONTRACT.
 - 3) COVERS AND FRAME SECTIONS ARE TO BE PICKED UP AT THE CITY STORAGE YARD AND IS INCIDENTAL TO THE CONTRACT.

PROJECT TITLE				ROUTE 59 ROAD IMPROVEMENTS			
PROJECT DESCRIPTION				DETAILS AND STANDARDS			
ENGINEER	DRAFTING DATE	MAP #	SCALE				
BCC	5-11-12	4211,4212,4223	N.T.S.				
GIS DESIGN BY	DRAFTED BY	REVISIONS DATE	AY&T JOINT AGREEMENT #	PROJECT #			
DL	PSM		N/A	EU-12			
CHECKED BY	APPROVED BY	CAD FILE	SHEET #				
		0060648001D125.DWG	25 OF 63				
Naperville			Department of Public Utilities Electric Division			WORK REQUEST #	
						60468	

**TYPICAL
EXCAVATION DETAIL
TYPE "A", "E", "G" OR "X" MANHOLE**





F.A.P. RTE.	SECTION	COUNTY	TOTAL SHEETS	SHEET NO.
338/IL 59	2011-035-1	DUPAGE		
CONTRACT 60P42				
FED.ROAD.DIST.NO.	ILLINOIS	FED. AID PROJECT		

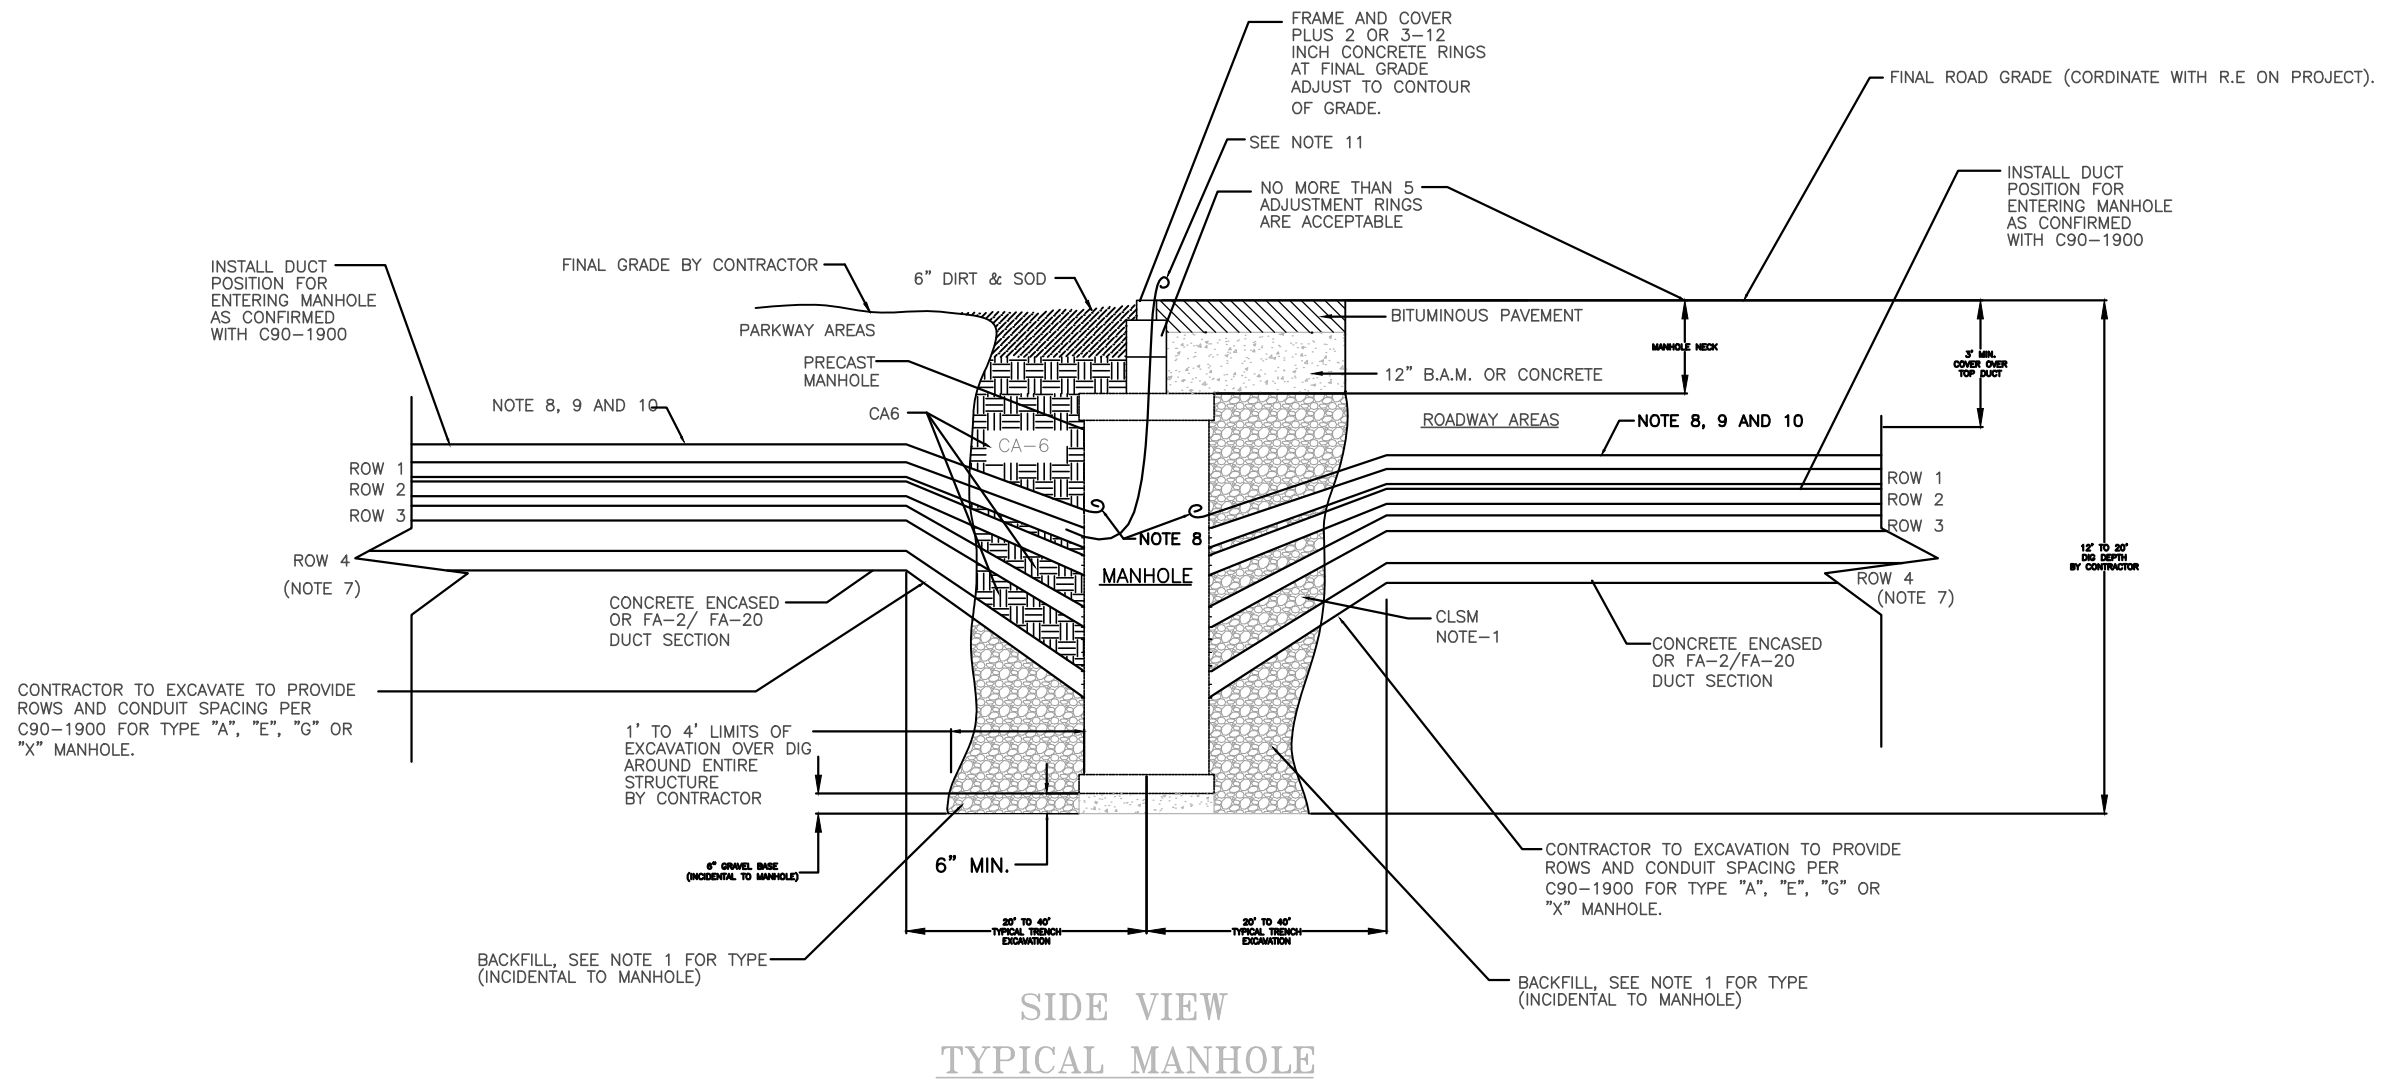

**SIDE VIEW
TYPICAL MANHOLE**

- NOTE:**
1. CA-6 BACKFILL TO BE PLACED 360 DEGREES AROUND MANHOLES TO GRADE. MINUS SURFACE RESTORATION. WHERE MANHOLE IS WITHIN 5' OF ROADWAY, CLSM BACKFILL TO BE USED TO FILL TO TOP OF ROOF OF MANHOLE AND CA-6 BACKFILL TO FILL TO GRADE.
 2. SEE MANHOLE DETAIL DRAWINGS FOR DIMENSIONS AND WEIGHT.
 3. CONTRACTOR TO ESTABLISH FINAL ELEVATION, LEVEL AND GRADE FOR MANHOLE.
 4. MANHOLES DELIVERED TO SITE BY MANUFACTURER. CONTRACTOR TO COORDINATE UNLOAD, STORE AND INSTALL (TAIL GATE DELIVERY BY UCP).
 5. CONTRACTOR SHALL SUPPORT AND REROUTE UTILITIES AS REQUIRED.
 6. CONTRACTOR SHALL INSTALL CONDUIT INTO MANHOLES PER C30-1900, AND IS PART OF PRICE TO INSTALL MANHOLE.
 7. ROWS 5 AND 6 OMITTED FOR CLARITY.
 8. ABOUT 20 FEET OF 4/0 BARE COPPER CONDUCTOR FOR TAIL (COUNTER POISE).
 9. INSTALL 250 FEET OF 4/0 BARE COPPER CONDUCTOR ABOVE DUCT BANK, COUNTER POISE, IF NEEDED IN 2 DIRECTIONS.
 10. CORE DRILL 1 1/2" HOLE THRU WALL OF 6" THICK MANHOLE WALL TO CONNECT COUNTER POISE. IF KNOCK OUTS ARE NOT INSTALLED.
 11. INSTALL #12 THHN WIRE (25' AND COIL) FROM MIDDLE DUCT TO MANHOLE COVER, LEAVING 12" TAIL (USED FOR LOCATING).
 12. ALL OF THE ABOVE ITEMS AND DETAIL EXCEPT ITEM 9, ARE INCLUDED IN THE COST OF INSTALLING THE MANHOLE.
 13. INSTALL MANHOLE PER O.S.H.A REGULATIONS OF LATEST ISSUE.

PROJECT TITLE					ROUTE 59 ROAD IMPROVEMENTS									
PROJECT DESCRIPTION										DETAILS AND STANDARDS				
ENGINEER	BCC	DRAFTING DATE	5-11-12	MAP #	4211,4212,4223	SCALE	N.T.S.							
GIS DESIGN BY	DL	DRAFTED BY	PSM	REVISIONS DATE		AT&T JOINT AGREEMENT #	N/A	PROJECT #	EU-12					
CHECKED BY		APPROVED BY		CAD FILE	0060648001D126.DWG	SHEET #	26 OF 63							
Naperville					Department of Public Utilities Electric Division					WORK REQUEST # 60468				

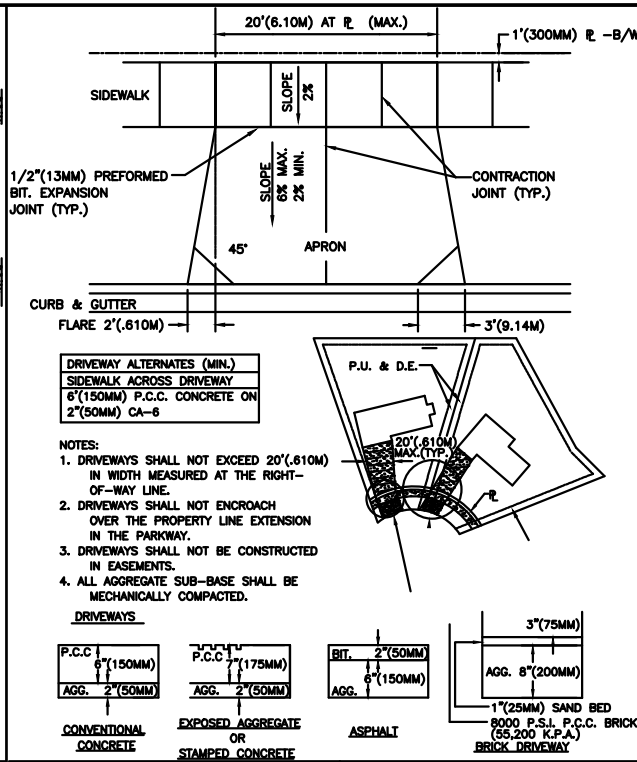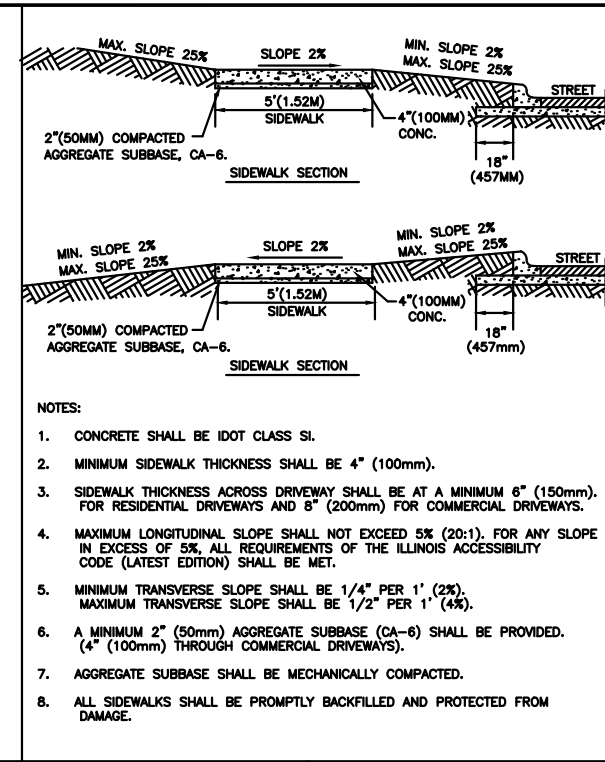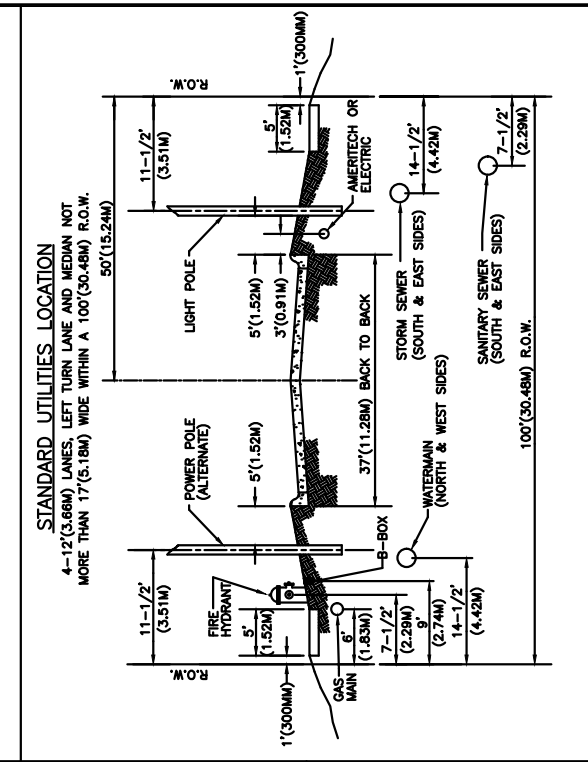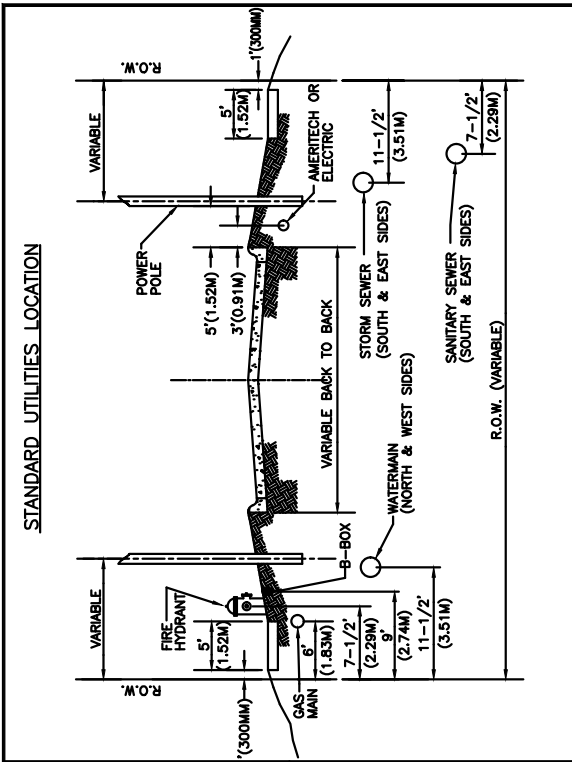











F.A.P. RTE.	SECTION	COUNTY	TOTAL SHEETS	SHEET NO.
338/IL 59	2011-035-1	DUPAGE		
FED. ROAD. DIST. NO.		ILLINOIS	FED. AID PROJECT	
CONTRACT 60P42				

Title: STANDARD UTILITIES LOCATION
CITY OF NAPERVILLE STANDARD DETAIL
Approved By: DATE: 9/21/98 REV: MISC 1
SCALE: NTS SHEET 1 OF 2

Title: STANDARD UTILITIES LOCATION
CITY OF NAPERVILLE STANDARD DETAIL
Approved By: DATE: 9/29/98 REV: MISC 1
SCALE: NTS SHEET 2 OF 2

Title: SIDEWALK
CITY OF NAPERVILLE STANDARD DETAIL
Approved By: DATE: 6/9/98 REV: PVMT 3
SCALE: NTS

Title: TYPICAL RESIDENTIAL DRIVEWAY STANDARD DETAIL
CITY OF NAPERVILLE STANDARD DETAIL
Approved By: DATE: 6/2/98 REV: PVMT 9
SCALE: NTS SHEET 1 OF 2

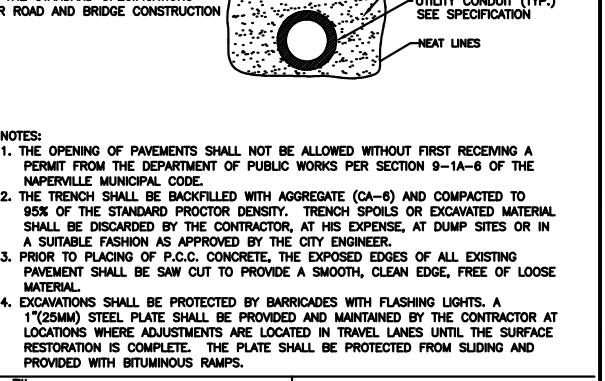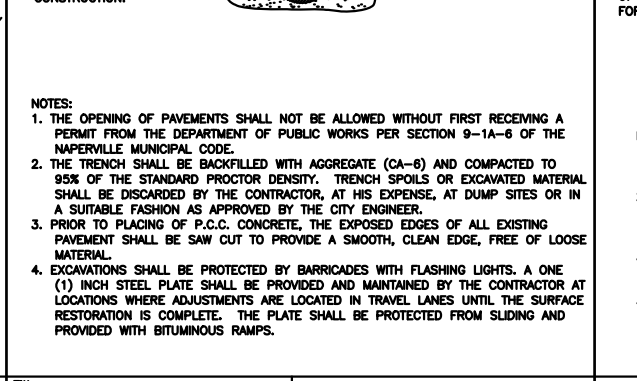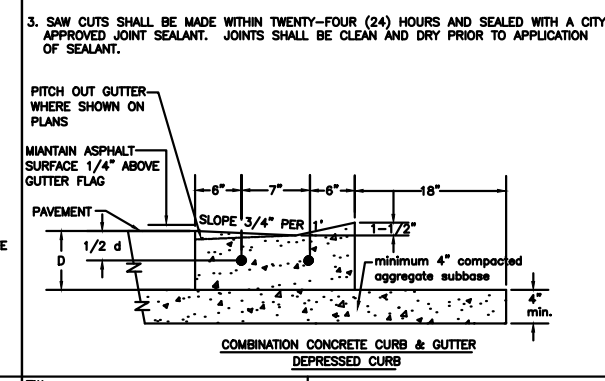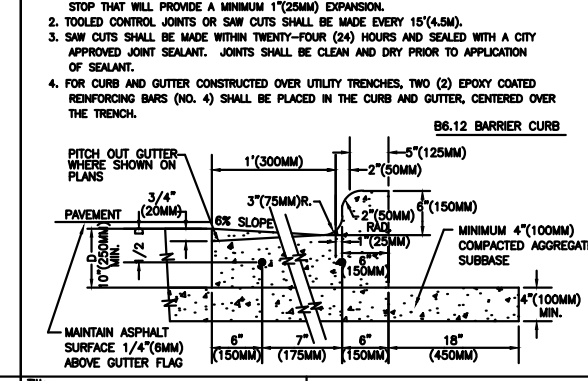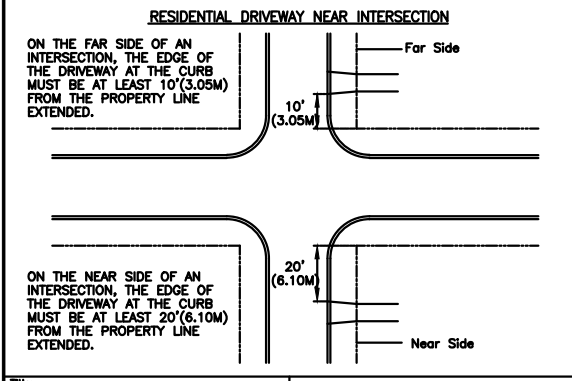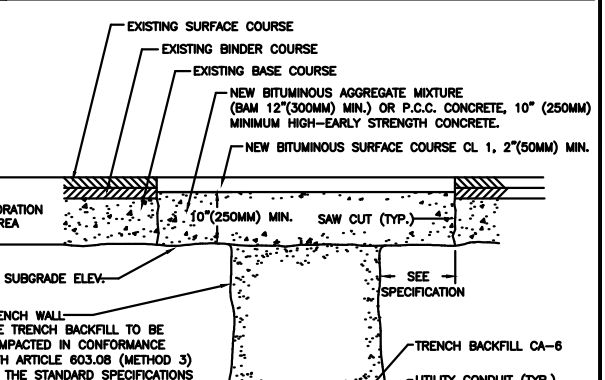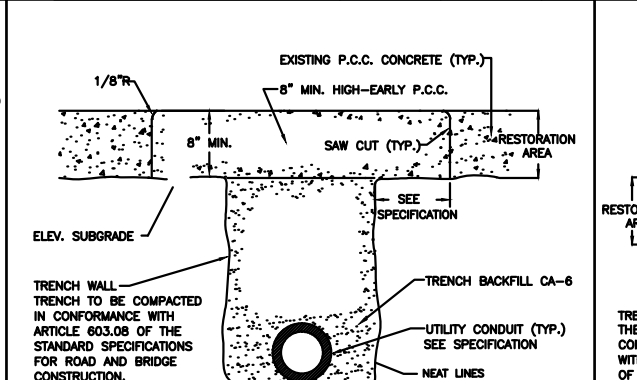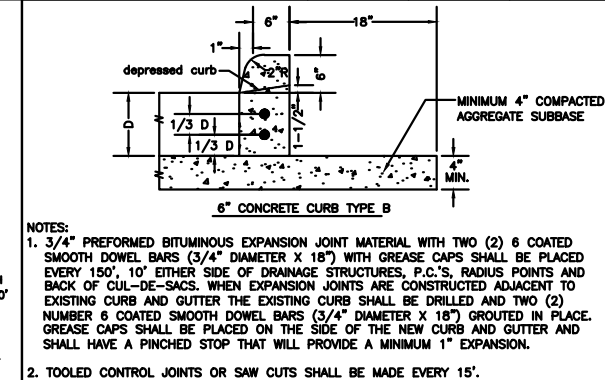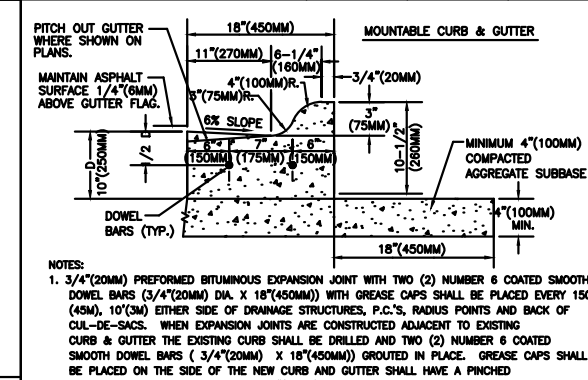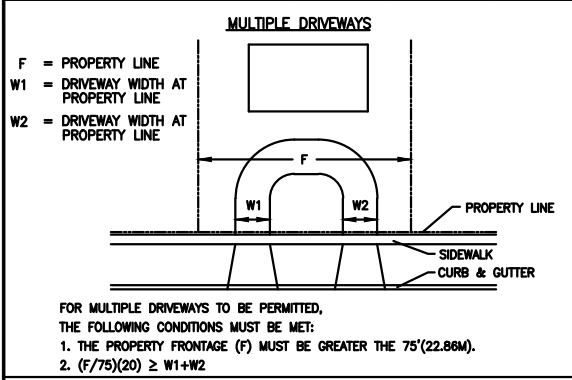

Title: TYPICAL RESIDENTIAL DRIVEWAY STANDARD DETAIL
CITY OF NAPERVILLE STANDARD DETAIL
Approved By: DATE: 6/2/98 REV: PVMT 9
SCALE: NTS SHEET 2 OF 2

Title: CURB & GUTTER
CITY OF NAPERVILLE STANDARD DETAIL
Approved By: DATE: 6/2/98 REV: PVMT 11
SCALE: NTS

Title: Curb & Gutter
City of Naperville Standard Detail
Scale: N.T.S. Date: 11/13/94 Detail: PVMT 12

Title: Utility Trench Paving Section Thru Existing Rigid Pavements
City of Naperville Standard Detail
Scale: N.T.S. Date: 1/13/94 Detail: PVMT 14

Title: UTILITY TRENCH PAVING SECTION THROUGH EXISTING FLEXIBLE PAVEMENTS
CITY OF NAPERVILLE STANDARD DETAIL
Approved By: DATE: 6/8/98 REV: PVMT 15
SCALE: NTS

NOTES:
1) SEE GENERAL SPECIFICATIONS FOR CHANGES TO THE ABOVE SPECIFICATIONS.

PROJECT TITLE				
ROUTE 59 ROAD IMPROVEMENTS				
PROJECT DESCRIPTION				
ENGINEER	DRAFTING DATE	MAP #	SCALE	
BCC	5-11-12	4211,4212,4223	N.T.S.	
DESIGN BY	REVISIONS DATE	AT&T JOINT AGREEMENT #	PROJECT #	
DL	PSM	N/A	EU-12	
CHECKED BY	APPROVED BY	CAD FILE	SHEET #	
		0060648001D127.DWG	27 OF 63	
Naperville		Department of Public Utilities Electric Division		WORK REQUEST # 60468

F.A.P. RTE.	SECTION	COUNTY	TOTAL SHEETS	SHEET NO.
338/IL 59	2011-035-1	DUPAGE		
CONTRACT 60P42				
FED.ROAD.DIST.NO.		ILLINOIS	FED. AID PROJECT	

CONDUIT RUN TRENCH PREPARATION

THESE INSTRUCTIONS COVER DESIGN AND CONSTRUCTION INFORMATION NECESSARY FOR THE LAY-OUT AND INSTALLATION OF CONDUIT RUNS. SAFEGUARDING UNDERGROUND FACILITIES

IN ORDER TO SAFEGUARD THE UNDERGROUND FACILITIES OF BOTH THE CITY OF NAPERVILLE AND OTHERS, APPLICABLE INSTRUCTIONS AND PROCEDURES COVERING THE PROVISIONS OF ANY AGREEMENT BETWEEN THE CITY OF NAPERVILLE AND ANOTHER UTILITY CONCERNING INTERCHANGE OF INFORMATION AND CONSTRUCTION WORK PRACTICES SHALL BE FOLLOWED. BEFORE ANY SOIL IS DISTURBED, J.U.L.I.E. MUST BE NOTIFIED TO MARK ALL UTILITIES IN THE AREA OF THE TRENCH.

CONDUIT RUN LAYOUT

CONDUIT RUNS AND MANHOLES SHOULD BE LOCATED SO THAT THE RUN WILL FOLLOW AS NEARLY AS POSSIBLE A STRAIGHT LINE BETWEEN MANHOLES. IF OBSTRUCTIONS MAKE THIS IMPRACTICAL, THE RUN MAY BE CURVED AS NECESSARY. CONDUIT RUNS BETWEEN MANHOLES SHALL HAVE AN OVERALL LENGTH FROM MANHOLE TO MANHOLE NOT TO EXCEED 475 FT. SPECIAL CASES INVOLVING LONGER LENGTHS MAY BE CONSIDERED BY THE ENGINEER, BUT ONLY IF SPECIALLY ORDERED CABLE REELS CAN ACCOMMODATE THIS LONG-PULL CONSTRUCTION. A CONDUIT RUN MAY ENTER A STANDARD MANHOLE AT A MAXIMUM ANGLE OF 15° TO THE RESPECTIVE AXIS OF THE MANHOLE. IN CASES WHERE A LARGER ANGLE IS REQUIRED, THE MANHOLE SHALL BE REDESIGNED TO OBTAIN SATISFACTORY CABLE PULLING AND TRAINING CONDITION. IN LOCATIONS WHERE STREET LINES ARE NOT DETERMINED BY CURBS, SIDEWALKS OR BUILDINGS, THE EXACT POSITION OF THE CONDUIT RUN SHALL BE DETERMINED BY A SURVEY. THE PROPOSED TRENCH MAY BE MARKED OFF BY MEANS OF A CHALK LINE IN UNPAVED TERRITORY AND BY A ROUTE IDENTIFICATION SPRAY PAINTED IN PAVED TERRITORY. BOTH SIDES OF THE TRENCH SHALL BE MARKED IF THE TRENCH IS TO BE DUG BY HAND. IF A MACHINE IS TO BE USED, ONLY ONE SIDE OF THE TRENCH NEED BE MARKED.

EXCAVATION

THE STANDARD WIDTH OF THE TRENCH SHALL BE EQUAL TO THE OVERALL WIDTH OF THE CONDUIT RUN AS SHOWN ON PAGE 6 FOR REGULAR FORMATIONS, AND SHALL BE ADJUSTED TO INCLUDE WHERE TRANSPORTATIONS ARE NECESSARY TO PASS OBSTRUCTIONS. THE SIDES OF THE TRENCH SHALL BE TRIMMED SMOOTHLY TO GIVE A UNIFORM THICKNESS OF CONCRETE AROUND THE CONDUIT. THE SIDES OF THE EXCAVATION SHALL BE SHORED IN ACCORDANCE WITH SAFETY REGULATING COMMISSION PRACTICES TO PREVENT CAVE-INS.

DEPTH OF TRENCH

THE DEPTH OF THE TRENCH IN THE RUN IS GOVERNED BY THE MINIMUM DEPTH OF THE CONDUIT RUN BELOW THE STREET SURFACE OR ESTABLISHED GRADE, THE HEIGHT OF THE DUCT SECTION, AND THE PRESENCE OF OBSTRUCTIONS. AT THE APPROACH TO THE MANHOLE, THE MINIMUM DISTANCE FROM THE MANHOLE ROOF TO THE TOP DUCTS AND THE FANNING OF THE DUCTS AT THE DUCT ENTRANCE OF THE MANHOLE ALSO GOVERN THE DEPTH OF THE TRENCH.

IF CINDERS, SLAG, RUBBISH FILL OR OTHER MATERIAL HAVING POOR HEAT CONDUCTING PROPERTIES ARE UNCOVERED IN THE EXCAVATION, THE WIDTH AND DEPTH OF THE TRENCH SHALL BE INCREASED. THIS EXTRA SPACE IS TO PROVIDE FOR THE PLACING OF SPECIAL BACKFILL GRAVEL AROUND THE CONDUIT.

THE MINIMUM DISTANCE FROM THE TOP OF A CONDUIT RUN TO THE SURFACE OF A ROADWAY OR ESTABLISHED GRADE SHALL BE 2 FEET 6 INCHES EXCEPT WHERE THE CONDUIT PASSES UNDER A VIADUCT AND CAUSES A SUMP IN THE LINE. IN THIS CASE THE MINIMUM DISTANCE SHALL BE 3 FEET 0 INCHES. CONDUIT RUNS WHICH PASS UNDER RAILROAD SWITCH TRACKS, OR MAIN LINE TRACKS SHALL HAVE THE MINIMUM DISTANCE OF 4 FEET 2 INCHES BELOW THE TOP OF THE RAIL.

THE HEIGHT OF THE DUCT SECTION FOR VARIOUS STANDARD CONDUIT FORMATIONS OF DUCTS IS SHOWN ON PAGE 6, AND SHALL BE ADJUSTED FOR TRANSPORTATION SECTIONS.

THE MINIMUM DISTANCE FROM THE TOP OF THE DUCTS TO THE MANHOLE ROOF IS SPECIFIED ON THE MANHOLE DRAWINGS AND THE SEPARATION OF THE DUCTS AT THE MANHOLE DUCT ENTRANCE IS SHOWN ON THE MANHOLE STANDARDS. THIS WILL DETERMINE THE MINIMUM WIDTH AND DEPTH OF THE TRENCH AT THE MANHOLE.

OBSTRUCTIONS AFFECT THE DEPTH OF THE TRENCH IN THAT THE GRADE OF THE CONDUIT RUN MUST BE ADJUSTED TO AVOID THEM. THE ENTIRE TRENCH SHOULD BE OPENED BETWEEN MANHOLES BEFORE ANY CONDUIT IS LAID TO ASCERTAIN THE EXISTENCE AND POSITION OF ANY OBSTRUCTIONS.

WHEN THE REQUIRED DEPTH OF THE TRENCH IS KNOWN FOR ALL POINTS, THE GRADE MAY BE ESTABLISHED.

GRADE

IN GENERAL, ALL CONDUIT RUNS SHALL BE UNIFORMLY GRADED SO THAT WATER WILL DRAIN INTO THE MANHOLES FROM ANY POINT IN THE RUN. THE EXCEPTIONS TO THIS RULE ARE CONDUIT RUNS WHICH PASS UNDER RIVERS, VIADUCTS, AND ABNORMAL OBSTRUCTIONS IN THE RUN. IT IS ESSENTIAL THAT THE CONDUIT RUN SHALL BE UNIFORMLY GRADED SO THAT THERE WILL BE NO RIPPLES IN THE RUN.


THE MINIMUM GRADE FOR A CONDUIT RUN SHALL BE 1 INCH PER 100 FT. ALL GRADES SHALL BE ESTABLISHED WITH A LEVEL BY THE CONTRACTOR'S ENGINEER AND MARKED BY WOODEN GRADE STAKES ON THE CENTER LINE OF THE BOTTOM OF THE TRENCH. THE STAKES SHALL BE SET 5 FT. APART WHEN CONCRETE CONDUIT IS TO BE INSTALLED AND 10 FT. APART FOR PLASTIC CONDUIT ALONE.

THE TOP OF THE GRADE STAKE SHALL INDICATE THE TOP SURFACE OF THE BOTTOM CONDUIT CONCRETE ENCASEMENT.

AFTER THE GRADE OF THE CONDUIT RUN HAS BEEN ESTABLISHED BY MEANS OF THE GRADE STAKES, THE BOTTOM OF THE TRENCH SHALL BE TRIMMED 3 INCHES BELOW THE TOP OF THE STAKES EXCEPT WHERE THE TRENCH CROSSES A RAILROAD TRACK. IN SUCH CASES THE BOTTOM SHALL BE TRIMMED 6 INCHES BELOW THE TOP OF THE STAKES. TRENCHES WHICH HAVE BEEN DUG TOO DEEP AND THEN PARTIALLY REFILLED SHALL BE TAMPED SOLID AFTER REFILLING BEFORE POURING THE CONCRETE ENCASMENT.

DOUBLE SLOPE GRADING

THE MOST DESIRABLE METHOD OF GRADING A CONDUIT RUN BETWEEN MANHOLES IS ILLUSTRATED IN THE SKETCH SHOWN BELOW. THE MINIMUM DISTANCE FROM THE TOP OF THE CONDUIT RUN TO THE STREET SURFACE IS 3 FT. 0 INCHES, AT THE CENTER OF THE RUN. FROM THERE THE RUN FALLS IN A DOUBLE SLOPE AND DRAINS TOWARD BOTH MANHOLES.

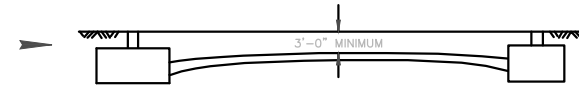


SINGLE SLOPE GRADING

WHERE THE STREET LEVEL SLOPES FROM ONE MANHOLE TO THE OTHER, OR WHERE OBSTRUCTIONS WILL NOT PERMIT DOUBLE SLOPE GRADING, THE CONDUIT RUN SHALL BE GRADED IN ONLY ONE DIRECTION AS SHOWN.



GRADING UNDER VIADUCT OR LARGE OBSTRUCTIONS

A CONDUIT RUN, WHICH IS TO BE INSTALLED UNDER A VIADUCT WHERE THE STREET GRADE IS DEPRECATED, OR UNDER A LARGE OBSTRUCTION, MAY BE GRADED WITH A SUMP IN THE LINE AS SHOWN, PROVIDED THAT THE SINGLE SLOPE GRADING METHOD IS NOT PRACTICAL OR ECONOMICAL. THE TOP OF THE RUN SHALL BE AT LEAST 3 FT., BELOW STREET GRADE TO PREVENT FREEZING. IF THE STREET GRADE IS LEVEL UNDER THE VIADUCT THIS RULE DOES NOT APPLY.

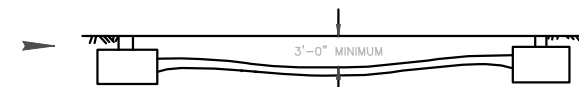

CONDUIT RUN INSTALLATION MONOLITHIC METHOD

APPLICATION

- THIS STANDARD COVERS THE PROCEDURE TO BE FOLLOWED WHEN INSTALLING CONCRETE ENCASED CONDUIT BY THE MONOLITHIC METHOD. THIS METHOD CONSISTS OF BUILDING UP THE LAYERS OF CONDUIT ON SPACERS AND THEN POURING THE CONCRETE ENCASMENT IN A MONOLITHIC MASS.

GENERAL

THE SIZE AND TYPE OF CONDUIT IS GIVEN ON M30-1500 BUT SHALL BE SPECIFIED FOR EACH JOB ON THE INSTALLATION DRAWINGS.

SPLIT CONDUIT, IF AVAILABLE, MAY BE USED TO REBUILD OR CHANGE THE LOCATION OF EXISTING DUCTS THAT CONTAIN CABLES

ALL CONDUIT TRENCHES SHALL BE DUG WITH A 100 FOOT HEADWAY TO ALLOW FOR VERTICAL ADJUSTMENTS.

INSTALL ALL TRENCHES AS PER OSHA STANDARDS FOR OPEN CUTTING THE GROUND.

ALL CONDUIT WITH BROKEN ENDS SHALL BE CUT, AND USED WHENEVER POSSIBLE.

TRENCH PREPARATION

THE PREPARATION OF THE TRENCH FOR CONDUIT RUNS SHALL BE AS PRESCRIBED ON PAGE 1 OF THIS STANDARD. WHERE SWAMPY OR UNSTABLE SOIL IS ENCOUNTERED, CONDUIT SHALL BE PLACED ON A CONCRETE BASE, LAYING THE CONDUIT AFTER THE CONCRETE IS LEVELED AND STARTS TO SET. AT THIS POINT THE BASE OF THE CONCRETE WILL SUPPORT THE CONDUIT AND PERMIT THE BASE SPACERS TO BE DEPRECATED AND TO FIND AN EVEN BEARING WHILE THE BASE CONCRETE IS STILL YIELDING. THE BASE CONCRETE IS BY VOLUME: 1 PART PORTLAND CEMENT, 3 PARTS #2 TORPEDO SAND, AND 5 PARTS 3/4 INCH TO #4 GRAVEL (NOT CRUSHED STONE).

IF THE CONDUIT DOES NOT REST ON UNDISTURBED EARTH WITHIN 3 FEET OF THE MANHOLE OR VAULT, BRIDGE THE GAP TO THE UNDISTURBED EARTH WITH A 6 INCH BASE OF REINFORCED CONCRETE. THIS CONCRETE SHALL BE A "DENSE SHEATHING" (PAGE 5) WITH #4 REINFORCING BARS ON 6 INCH CENTERS, 3 INCHES FROM THE BOTTOM.

CONCRETE MIX FOR CONDUIT ENCASMENT (SHEATHING)

(a) READY-MIXED

READY MIXED CONCRETE DELIVERED TO THE JOB SHALL BE SPECIFIED AS 3000 POUNDS PER SQUARE INCH MINIMUM (AT 28 DAYS) CONCRETE. THE COARSE AGGREGATE SHALL BE PEA GRAVEL. THE FINE AGGREGATE SHALL BE #2 TORPEDO SAND. SLUMP AT POINT OF DELIVERY SHALL NOT BE MORE THAN 4 INCHES NOR LESS THAN 2 INCHES.

MINIMUM CEMENT CONTENT SHALL BE 3 1/2 BAGS OF TYPE 1 PORTLAND CEMENT PER CUBIC YARD. FLY ASH SHALL BE INCORPORATED INTO THE MIX ON THE BASIS OF 20 POUNDS PER SACK OF CEMENT. INCLUDE AIR ENTRAINMENT AGENT TO ENTRAIN BETWEEN 4 PERCENT AND 6 PERCENT OF AIR IN THE CONCRETE.

EXCEPT AS OTHERWISE DESIGNATED IN THIS STANDARD, ANY READY-MIXED CONCRETE SHALL CONFORM TO THE REQUIREMENTS OF SPECIFICATIONS FOR READY-MIXED CONCRETE (ASTM C94 LATEST EDITION).

READY-MIXED CONCRETE SHALL BE PLACED WITHIN 1 HOUR AFTER WATER HAS BEEN ADDED TO THE MIX.

(b) BATCH-MIXED

WHEN THE CONCRETE IS MIXED ON THE JOB, A PRE-BAGGED CEMENT MIX CONSISTING BY WEIGHT OF 70 PERCENT PORTLAND CEMENT AND 30 PERCENT FLY ASH SHALL NORMALLY BE USED. THE CONCRETE MIX PROPORTIONS BY VOLUME (RODDED SATURATED SURFACE DRY BASIS) SHALL BE: 1 PART OF PRE-BAGGED MIX (1 BAG IS 1 CUBIC FOOT), 3 1/2 PARTS OF #2 TORPEDO SAND, AND 2 1/2 PARTS PEA GRAVEL. MAXIMUM WATER CONTENT, INCLUDING FREE SURFACE MOISTURE IN AGGREGATES, SHALL NOT EXCEED 7 GALLONS PER BAG OF CEMENT MIX. SLUMP SHALL BE AS SPECIFIED ABOVE UNDER READY-MIXED CONCRETE.

IN THE EVENT THAT THE PRE-BAGGED CEMENT MIX IS NOT AVAILABLE, 1 BAG OF TYPE 1 PORTLAND CEMENT SHALL BE SUBSTITUTED FOR 1 BAG OF THE CEMENT MIX. WATER CONTENT, SLUMP, AND THE CONCRETE MIX PROPORTIONS SHALL REMAIN AS STATED IN THE PRECEDING PARAGRAPH.

THE AGGREGATES SHALL BE MEASURED BEFORE BEING PUT IN THE MIXER, AND SHALL BE IN SUCH PROPORTIONS THAT ONE FULL BAG OF CEMENT WILL BE USED IN EACH BATCH. ALL CONCRETE SHALL BE MIXED FOR A MINIMUM OF TWO MINUTES IN A MACHINE MIXER.

HAND MIXING SHALL NOT BE DONE EXCEPT BY THE SPECIAL PERMISSION OF THE ENGINEER. NO MORTAR OR CONCRETE SHALL BE "RETEMPERED" EITHER BY REMIXING OR BY THE ADDITION OF ANY MATERIALS OR ADMIXTURES. THE DRUM OF THE MIXER SHALL BE COMPLETELY EMPTIED BEFORE RECEIVING MATERIALS FOR THE SUCCEEDING BATCH. CONCRETE THAT HAS OBTAINED ITS INITIAL SET BEFORE BEING PLACED SHALL BE DISCARDED AND NOT USED ON THE JOB.

COLD WEATHER CONCRETING (BELOW 40°F)

INGREDIENTS OF CONCRETE POURED WHEN THE SURROUNDING AIR IS BELOW 40°F SHALL BE HEATED SO THAT THE TEMPERATURE OF THE CONCRETE IS NEITHER LOWER THAN 55°F NOR GREATER THAN 65°F. PLUG ENDS OF CONDUIT RUN TO PREVENT AIR CIRCULATION. PROTECT CONCRETE FROM FREEZING FOR A MINIMUM OF 48 HOURS.


WHEREVER POSSIBLE, ALL CONCRETE MATERIALS AND ALL REINFORCEMENT, FORMS, FILLERS AND GROUND WITH WHICH CONCRETE IS TO COME IN CONTACT SHOULD BE FREE FROM FROST.

NAPERVILLE PUBLIC UTILITIES DEPARTMENT	DUCTBANK CONSTRUCTION SPECIFICATION	DATE: 04-24-07
ELECTRIC STANDARDS		Page 1 of 12 C30-1900

NAPERVILLE PUBLIC UTILITIES DEPARTMENT	DUCTBANK CONSTRUCTION SPECIFICATION	DATE: 04-24-07
ELECTRIC STANDARDS		Page 2 of 12 C30-1900

NAPERVILLE PUBLIC UTILITIES DEPARTMENT	DUCTBANK CONSTRUCTION SPECIFICATION	DATE: 04-24-07
ELECTRIC STANDARDS		Page 3 of 12 C30-1900

LAYING CONDUIT

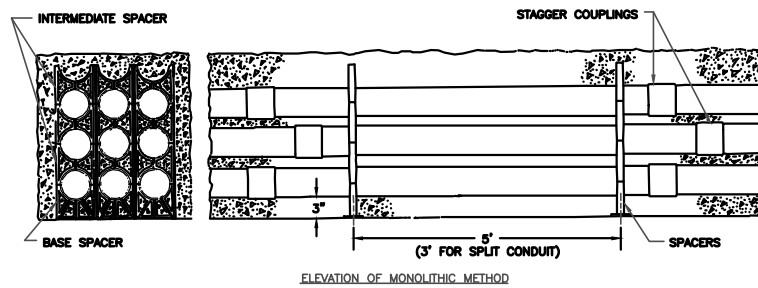

CONDUIT INSTALLATION

THE STANDARD ARRANGEMENT AND SEPARATION OF DUCTS AND THE THICKNESS OF CONCRETE SHEATHING SHALL BE AS SHOWN ON PAGE 7 FOR CONDUIT RUNS UNDER MAIN LINE RAILROAD TRACK, OR ON PAGE 6 OF THIS STANDARD FOR ALL OTHER LOCATIONS. IF SPECIAL ARRANGEMENTS ARE REQUIRED, THE SECTIONAL OUTLINE OF THE DUCTS SHALL BE SHOWN ON THE INSTALLATION DRAWINGS. TRANSPORTATION OF THE DUCTS, MADE NECESSARY BY OBSTRUCTIONS, SHALL BE FOLLOWING THIS STANDARD, BUT SHALL BE DONE ONLY WHEN SPECIFIED ON THE DRAWINGS OR WHEN SPECIALLY AUTHORIZED BY THE ENGINEER AFTER UNFORESEEN OBSTRUCTIONS ARE UNCOVERED.

THE FIRST LAYER OF THE CONDUIT SHALL BE LAID ON PLASTIC 6 INCH BASE SPACERS (DPU-E #285-199-00170) HORIZONTALLY LOCKED, WHICH WILL PROVIDE A 3-INCH LAYER OF CONCRETE BELOW THE CONDUIT. THEY SHALL BE PLACED AT INTERVALS OF APPROXIMATELY 5 FEET. ALL OF THE SUCCEEDING LAYERS ARE PLACED ON PLASTIC 6 INCH INTERMEDIATE SPACERS (DPU-E # 285-199-00180) VERTICALLY LOCKED TO PREVIOUSLY PLACED SPACERS. THE CONDUIT COUPLINGS SHALL BE STAGGERED SO THAT NO COUPLING IS IN-LINE WITH THE COUPLING ON AN ADJACENT CONDUIT. WHEN THE REQUIRED LAYERS OF CONDUIT ARE BUILT UP, THE ENTIRE ASSEMBLY SHALL BE BRACED TO PREVENT LATERAL AND VERTICAL MOVEMENT. WHEN THE INSTALLATION OF SPLIT DUCT IS SPECIFIED, PLACE SPACERS AT THREE FOOT INTERVALS.

THE CONCRETE SHALL BE THOROUGHLY SPADED AND PUDDLED IN AND AROUND THE CONDUIT PACKAGE. BRACING SHALL BE REMOVED WHEN CONCRETE HAS STARTED TO SET AND THERE IS NO FURTHER DANGER THAT DUCTS WILL FLOAT OR MOVE OUT OF ALIGNMENT. HOLES LEFT BY BRACING SHOULD THEN BE FILLED WITH GROUT.

IN FORMATIONS GREATER THAN 4 DUCTS HIGH, THE PREFERRED PRACTICE IS TO INSTALL THE FORMATION IN TWO LAYERS WITH THE CONCRETE BEING POURED IN 2 STEPS. THIS WILL PREVENT THE SPACERS FROM SPREADING OUT UNEVENLY AND CREATING UNEVEN VARIANCES IN CLEARANCES BETWEEN CONDUITS. THIS PROCEDURE WILL ALSO ENSURE THAT THERE IS A CONCRETE ENVELOPE AROUND EVERY DUCT AND DECREASE VERTICAL DROP TO THE LOWEST POSSIBLE DISTANCE WHEN POURING THE CONCRETE.

UNFINISHED CONSTRUCTION

IF THE CONDUIT RUN MUST BE TEMPORARILY LEFT UNFINISHED DURING CONSTRUCTION, CONDUIT SHALL BE CLOSED WITH PLASTIC CONDUIT PLUGS. IF THE CONDUIT RUN IS TO BE DEAD-ENDED, FOR COMPLETION AT SOME FUTURE TIME, THE END OF EACH CONDUIT SHALL BE PLUGGED AND STAGGERED APPROXIMATELY 3 INCHES FROM THE ADJACENT CONDUIT. THE END OF THE CONCRETE SHEATHING SHALL BE STEPPED BACK APPROXIMATELY 6 INCHES FOR EACH HORIZONTAL ROW OF CONDUIT. THE ENDS OF THE INSTALLED CONDUIT SHALL EXTEND BEYOND THE SHEATHING TO PERMIT CONNECTION TO FUTURE CONDUIT.

IN INSTANCES WHERE THE CONDUIT ENDS MAY NOT BE EASILY LOCATED, INSTALL AN ELECTRONIC MARKER BALL (DPU-E # 284-199-00250) TO ASSIST IN LOCATION. AFTER THE CONDUIT IS INSTALLED, BACKFILL THE HOLE COVERING THE CONDUIT ENDS APPROXIMATELY 6 TO 12 INCHES AND INSERT MARKER IN HOLE ABOVE THE CONDUIT END. LAY MARKER ON FLAT GROUND AND CONTINUE BACKFILLING, INSURING THAT THE MARKER STAYS IN A HORIZONTAL POSITION SO THAT IT MAY BE LOCATED BY THE LOCATOR TOOL.

TRANSPORTING AROUND OBSTRUCTIONS

WHEN SMALL OBSTRUCTIONS ARE ENCOUNTERED, AND IT IS NOT ECONOMICAL OR DESIRABLE TO INSTALL THE CONDUIT RUN BELOW THE OBSTRUCTION, THE CONDUIT PACKAGE MAY BE TRANSPORTED. IN SUCH AN OPERATION, A 1-INCH SPACE SHALL BE LEFT ABOVE AND BELOW BETWEEN THE CONCRETE SHEATH AND THE OBSTRUCTION. A 6 INCH GAP SHALL BE LEFT AROUND UTILITIES THAT ARE OBSTRUCTIONS. EACH PORTION OF THE TRANSPORTED CONDUIT SECTION SHALL BE INSTALLED AS A DOUBLE REVERSE CURVE USING A MINIMUM RADIUS OF 300 FEET.

THE SPACE BETWEEN THE TWO PORTIONS OF THE TRANSPORTED SECTION SHALL BE COMPLETELY FILLED WITH CONCRETE TO


NAPERVILLE PUBLIC UTILITIES DEPARTMENT	DUCTBANK CONSTRUCTION SPECIFICATION	DATE: 04-24-07
ELECTRIC STANDARDS		Page 4 of 12 C30-1900

PROJECT TITLE		ROUTE 59 ROAD IMPROVEMENTS	
PROJECT DESCRIPTION		DETAILS AND STANDARDS	
ENGINEER	DRAFTING DATE	MAP #	SCALE
BCC	5-11-12	4211,4212,4223	N.T.S.
DESIGN BY	DRAFTED BY	AT&T JOINT AGREEMENT #	PROJECT #
DL	PSM	N/A	EU-12
CHECKED BY	APPROVED BY	CAD FILE	SHEET #
		0060648001D128.DWG	28 OF 63
Naperville		Department of Public Utilities Electric Division	
		WORK REQUEST # 60468	

F.A.P. RTE.	SECTION	COUNTY	TOTAL SHEETS	SHEET NO.
338/IL 59	2011-035-1	DUPAGE		
FED.ROAD.DIST.NO.		ILLINOIS	CONTRACT 60P42	
		FED. AID PROJECT		

CONDUIT RUN FORMATIONS

BETWEEN MANHOLES

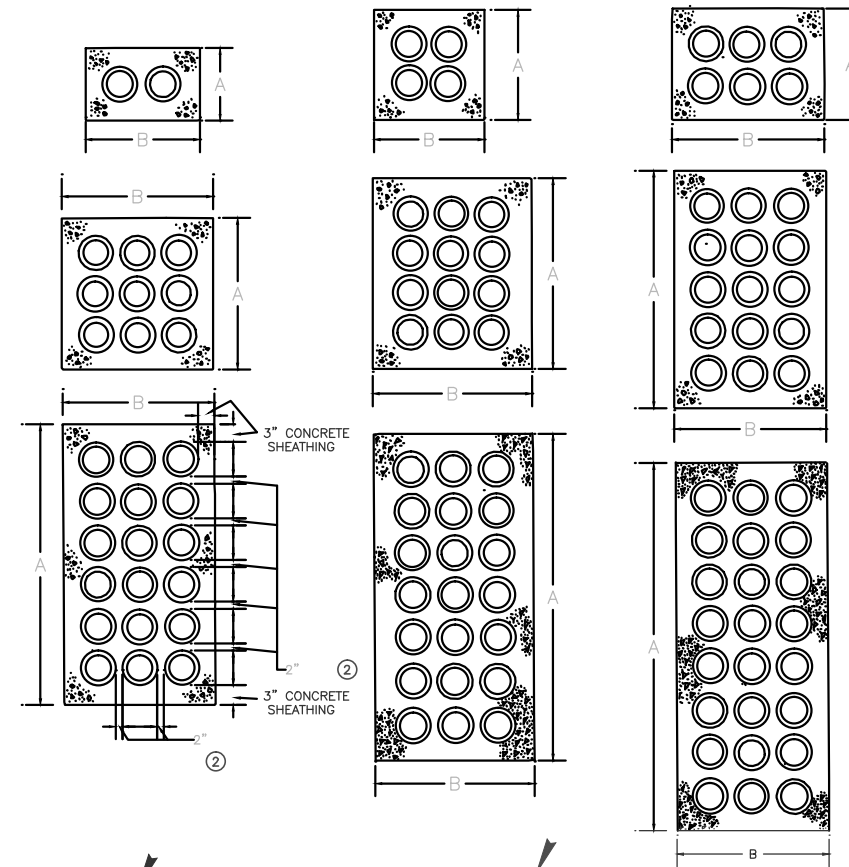

NO. OF DUCTS	DIMENSIONS (2)(3)			
	PLASTIC CONDUIT			
	5" CONDUIT		6" CONDUIT	
4	A*	B*	A*	B*
6	11 3/4"	19"	12 3/4"	21 1/2"
9	19"	19"	21 1/2"	21 1/2"
	19"	26 1/2"	21 1/2"	30"
	26 1/2"	26 1/2"	30"	30"
12	33 3/4"	26 1/2"	38 3/4"	30"
15	41"	26 1/2"	47 1/2"	30"
18	48 1/4"	26 1/2"	55 3/4"	30"
	55 1/2"	26 1/2"	64 3/4"	30"
24(3x8)	63"	26 1/2"	73"	30"
24(4x6)	48 1/4"	34"	55 3/4"	38 3/4"

* DIMENSIONS ARE TO THE NEXT LARGER 1/4"

- NOTES:**
- APPLICATION**
- THIS STANDARD SHALL BE USED FOR THE ARRANGEMENT OF CONDUIT FORMATIONS BETWEEN MANHOLES.
- INFORMATION**
- THIS STANDARD COVERS THE ARRANGEMENT OF THE CONDUIT IN CONDUIT RUNS AND LATERALS.
 - THE SEPARATION BETWEEN CONDUITS SHALL BE 2" INCHES. CONCRETE SHEATHING SHALL BE 3" INCHES THICK EXCEPT WHERE A CONDUIT RUN IS UNDER RAILROAD SWITCH TRACKS OR MAIN LINE RAILROAD TRACKS. THEN THE SHEATHING SHALL BE AS SHOWN ON PAGE 7.
 - THESE DIMENSIONS REFLECT THE USE OF PLASTIC BASE SPACERS WHICH PROVIDES A HORIZONTAL AND VERTICAL SEPARATION AT OR GREATER THAN THE MINIMUM REQUIREMENTS.

CONDUIT BELLS

ALL CONDUITS SHALL TERMINATE AT A PRE-CAST MANHOLE IN PLASTIC CONDUIT ENTRANCE BELL ENDS AS SHOWN ON PAGE 8 OF THIS STANDARD. ALL CONDUITS SHALL TERMINATE AT A VAULT PER THIS STANDARD. IF CONDUIT PLUGS ARE USED, THEY SHOULD BE REMOVED AFTER CONSTRUCTION IS COMPLETED UNLESS OTHERWISE SPECIFIED.

BACKFILLING

AFTER THE CONCRETE SHEATHING HAS ATTAINED ITS INITIAL SET, THE TRENCH SHALL BE BACKFILLED. SAND OR OTHER STATE OR MUNICIPAL APPROVED MATERIAL SHALL BE USED UNDER PAVEMENTS EXCEPT WHEN THE EXCAVATED MATERIAL IS FINE, DRY, CAN BE WELL COMPACTED, AND WILL NOT SETTLE AFTER PAVEMENT IS RESTORED. IF THE EXCAVATION IS MADE IN SANDY SOIL, THE REMOVED MATERIAL MAY BE USED FOR BACKFILL IF SATISFACTORY TO THE ENGINEER. LAKE SAND SHALL NEVER BE USED FOR THE BACKFILL IN CONDUIT TRENCHES BECAUSE OF ITS POOR HEAT-CONDUCTING PROPERTIES. ALL BACKFILL IN PAVED AREAS SHALL BE THOROUGHLY COMPACTED AND FLOODED.

CONDUIT RUNS IN PARKWAYS MAY BE BACKFILLED WITH THE EXCAVATED MATERIAL IF IT IS CLAY, COARSE SAND, OR CA6 GRAVEL. ALL BACKFILL MATERIALS SHALL BE FREE OF ALL ORGANIC MATERIALS AND ROCKS LARGER THAN 1".

WHEN LAKE SAND, PEAT, CINDERS, SLAG, OR OTHER MATERIALS WITH POOR HEAT CONDUCTING PROPERTIES ARE ENCOUNTERED IN THE CONDUIT EXCAVATION, THERMAL BACKFILL SHALL BE ADDED AROUND AND ABOVE THE CONDUIT, AS SPECIFIED ON THE INSTALLATION PLANS OR BY THE ENGINEER. THIS THERMAL BACKFILL WILL BE SPECIFIED OR BANK RUN GRAVEL FROM A LOCATION APPROVED BY THE ENGINEER.

PAVING, CURBS, SIDEWALKS

REPLACEMENT OF PAVING, CURBS, AND SIDEWALKS SHALL BE DONE IN ACCORDANCE WITH THE MUNICIPAL OR STATE REQUIREMENTS.

CONDUIT PREPARATION

AFTER THE CONCRETE SHEATHING HAS ATTAINED ITS INITIAL SET, EACH CONDUIT SHALL BE RODDED AND MANDRELLED, BY THE CONTRACTOR OR CREW, THROUGH EACH OF THE CONDUIT. WHEN A PREVIOUSLY DEAD-END CONDUIT RUN IS EXTENDED, THE ENTIRE RUN SHALL BE RODDED AND MANDRELLED. CONDUIT RUNS CONTAINING OR TERMINATING IN SMALL RADIUS BENDS THAT WILL NOT PERMIT THE PASSAGE OF A STANDARD SIZE MANDREL, SHALL BE MANDRELLED THROUGH THEIR STRAIGHT PORTION PRIOR TO THE CONSTRUCTION OR INSTALLATION OF THE BENDS. THE MANDRELING OF SMALL RADIUS BENDS SHALL BE DONE WITH A FLEXIBLE MANDREL NO SMALLER IN DIAMETER THAN 1/2 INCH LESS THAN THE NOMINAL DIAMETER OF THE BEND.

WHEN REQUESTED, THE CONTRACTOR SHALL, AS A PART OF THE MANDRELING OPERATION, PULL IN AND LEAVE IN CERTAIN DESIGNATED DUCTS A #12 SOL. CU. MARKER CABLE (DPU-E# 280-113-00040, WHITE), (DPU-E# 280-113-00041, BLACK), (DPU-E# 280-113-00042, RED), (DPU-E# 280-113-00043, GREEN), (DPU-E# 280-113-00044, BLUE), (DPU-E# 280-113-00045, ORANGE), OR (DPU-E# 280-113-00046, YELLOW). ADDITIONALLY A 22GA. DETECTABLE MULETAPE 1250# STRENGTH @ 3000' (DPU-E# 450-024-00010), MAY BE USED. EITHER OPTION WILL BE FURNISHED BY THE CITY OF NAPERVILLE DPU-E.

LATERALS

CONDUIT LATERALS THAT ARE TO BE CONCRETE ENCASED SHALL BE INSTALLED IN THE SAME MANNER AS MAIN CONDUIT RUNS. LATERALS THAT TERMINATE AT MANHOLE WALLS SHALL BE CONSTRUCTED AS SHOWN ON THIS STANDARD. THOSE THAT TERMINATE AT A POLE SHALL BE CONSTRUCTED PER PAGE 9 OF THIS STANDARD. THOSE TERMINATING AT AN EQUIPMENT FOUNDATION SHALL BE CONSTRUCTED PER THAT SPECIFIC EQUIPMENT FOUNDATION STANDARD.

DENSE CONDUIT SHEATHING FOR SPECIAL CONDITIONS

WHEN SPECIFIED ON THE INSTALLATION DRAWINGS, CONDUIT RUNS TO BE INSTALLED IN KNOWN CORROSIVE LOCATIONS, SUCH AS IN CINDER FILL, ADJACENT TO COAL STORAGE PILES, IN GAS PURIFIER SLAG, ETC., SHALL BE CONSTRUCTED IN ACCORDANCE WITH THE FOLLOWING INSTRUCTIONS. ALL OTHER PROCEDURES GIVEN IN PRECEDING PAGES OF THIS STANDARD SHALL BE FOLLOWED.

FA-2 CONDUIT ENCASEMENT

CONDUIT RUNS IN PARKWAY NOT UNDER, BIKE PATHS, SIDEWALKS OR DRIVEWAY MAY BACKFILL WITH FA-2. AGGREGATE TO THE DIMENSIONS SHOWN ON PAGE 6.


THE OUTER SHEATHING ALL AROUND SHALL BE 4 INCHES THICK.

CONCRETE SHALL CONSIST OF THE FOLLOWING MIX:

- | | |
|--|---------------------------------|
| 1 PART TYPE 1 PORTLAND CEMENT | INCLUDING FREE SURFACE MOISTURE |
| 2 PARTS #2 TORPEDO SAND | IN THE AGGREGATES OF NOT MORE |
| 2 PARTS PEA GRAVEL (NOT CRUSHED LIME STONE) | THAN 6 GALLONS OF WATER PER |
| 1/2 BAG OF FLY ASH SHALL BE ADDED TO THE | BAG OF CEMENT SHALL BE USED. |
| MIX FOR EACH BAG OF PORTLAND CEMENT USED. | MINIMUM SLUMP SHALL BE 2 INCHES |
| FOR AN ALTERNATIVE TO PORTLAND CEMENT AND | AND MAXIMUM SLUMP IS 4 INCHES. |
| FLY ASH, LUMINITE CEMENT SHALL BE SPECIFIED. | |
| INCLUDE AIR ENTRAINMENT AGENT TO ENTRAIN | |
| 7 1/2 PERCENT OF AIR IN CONCRETE. | |


CONDUIT RUN RR TRACK CROSSING

SWITCH TRACKS OR MAIN LINE TRACKS

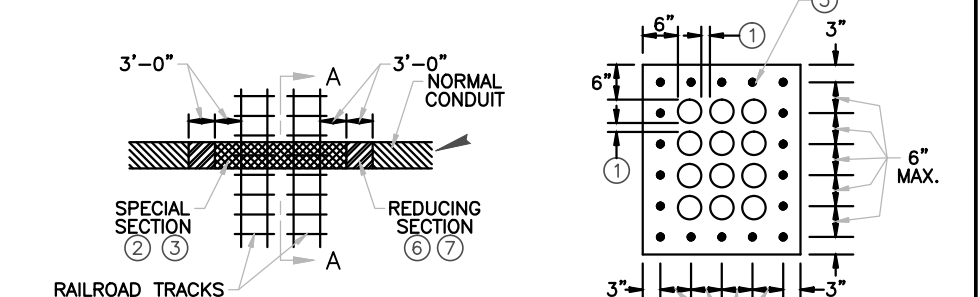

PLAN
1 OR 2 TRACKS

SECTION A-A
TYPICAL

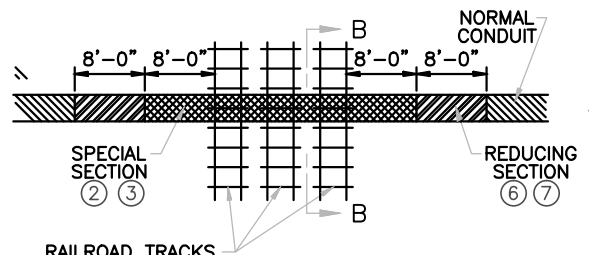

PLAN
3 OR MORE TRACKS

SECTION B-B
TYPICAL

- NOTES:**
- APPLICATION**
- THIS STANDARD SHALL BE USED FOR THE FORMATION OF CONDUIT RUNS THAT CROSS UNDER RAILROAD TRACKS.
- INFORMATION**
- NORMAL DUCT SPACING AS ON PAGE 6 (2 INCHES).
 - TOP OF SPECIAL SECTION TO BE AT LEAST 50" BELOW TOP OF RAIL.
 - CONCRETE MIXTURE OF SPECIAL SECTION TO BE OF DENSE SHEATHING, SEE PAGE 5.
 - LEAVE TRACK SHORING IN PLACE AT LEAST 7 DAYS UNLESS QUICK SETTING CEMENT IS USED.
- #6 GRADE 60 REINFORCING BARS, OVERLAP THE ENDS 18".
 - DUCTS OF REDUCING SECTION TO BE LAID AS REVERSE CURVE.
 - REDUCE HORIZONTAL AND VERTICAL SEPARATION OF DUCTS FROM 3" TO NORMAL, AND THE ENVELOPE FROM 6" TO 3". CONCRETE MIXTURE OF REDUCING SECTION TO BE NORMAL SHEATHING.

NAPERVILLE PUBLIC UTILITIES DEPARTMENT ELECTRIC STANDARDS	DUCTBANK CONSTRUCTION SPECIFICATION	DATE: 04-24-07 Page 5 of 12 C30-1900
--	-------------------------------------	--

NAPERVILLE PUBLIC UTILITIES DEPARTMENT ELECTRIC STANDARDS	DUCTBANK CONSTRUCTION SPECIFICATION	DATE: 04-24-07 Page 6 of 12 C30-1900
--	-------------------------------------	--

NAPERVILLE PUBLIC UTILITIES DEPARTMENT ELECTRIC STANDARDS	DUCTBANK CONSTRUCTION SPECIFICATION	DATE: 04-24-07 Page 7 of 12 C30-1900
--	-------------------------------------	--

PROJECT TITLE ROUTE 59 ROAD IMPROVEMENTS			
PROJECT DESCRIPTION DETAILS AND STANDARDS			
ENGINEER BCC	DRAFTING DATE 5-11-12	MAP # 4211,4212,4223	SCALE N.T.S.
DESIGN BY DL	DRAFTED BY PSM	AT&T JOINT AGREEMENT # N/A	PROJECT # EU-12
CHECKED BY	APPROVED BY	CAD FILE 0060648001D129.DWG	SHEET # 29 OF 63
Naperville		Department of Public Utilities Electric Division	
			WORK REQUEST # 60468

CONDUIT ENTRANCE INTO MANHOLE/HANDHOLE APPLICABLE TO SWITCHGEAR AND TRANSFORMER VAULTS

GENERAL

CONDUIT ENTRANCES INTO MANHOLES/HANDHOLES SHALL NORMALLY BE MADE WITH PLASTIC ENTRANCE BELLS PER FIGURE 1 OR 2. THE ENTRANCE CONDUIT SHALL BE PLASTIC OR STEEL ENCASED IN CONCRETE AS PER FIGURE 1 AND 2 BELOW, SPECIFIED BY THE ENGINEER ON THE CONSTRUCTION DRAWINGS.

POCKETS

DUCT POCKETS SHALL BE PROVIDED IN WALLS WHERE SPECIFIED ON CONSTRUCTION DRAWINGS. POCKET NOT REQUIRED ON NEWER STYLE MANHOLE DESIGNS (FIGURE 2). TYPICAL POCKET DIMENSIONS ARE INDICATED BELOW ON FIGURE 1.

CONDUIT SPACING

CONDUIT SHALL NORMALLY BE SUPPORTED BY VERTICAL AND HORIZONTALLY INTERLOCKED PLASTIC SPACERS TO PROVIDE ALIGNMENT WITH PLASTIC ENTRANCE BELL UNITS AT 8 1/4 IN. SPACING.

ENTRANCE BELL UNITS

PLASTIC 6 INCH ENTRANCE BELLS, DPU-E# 285-103-00100 SHALL BE USED ON CONDUIT ENTRANCES TO MANHOLES.

ENTRANCE PIPES

GALVANIZED STEEL CONDUIT, M30-1550, SHALL BE USED FOR ALL BENDS. PIPES INTENDED FOR CABLES ON INITIAL INSTALLATION SHALL BE CAPPED WITH PLUGS (DPU-E# 285-103-00090) TO PREVENT CONTAMINATION FROM ENTERING THE PIPES.

INSTALLATION METHODS

EVERY EFFORT SHALL BE MADE TO INSURE A WATERTIGHT INSTALLATION OF ENTRANCE PIPES. WHERE PIPES ARE INSTALLED THROUGH AN OPENING LEFT IN A MANHOLE, OR BROKEN OUT OF AN EXISTING MANHOLE WALL, SURFACES SHALL BE CLEANED, WETTED AND COVERED WITH A COATING OF 3 TO 1 SAND AND CEMENT MORTAR. IF BRICKWORK IS EXISTING ON THE INNER FACE OF WALL, IT SHALL ALSO BE COATED WITH A SAND AND CEMENT MORTAR. AN ALTERNATE PROCEDURE IS TO DRILL HOLES IN THE WALL AND GROUT THE PIPES IN PLACE WITH A SAND AND CEMENT MORTAR. THE INSIDE SURFACE OF THE HOLES SHALL BE ROUGHENED TO OBTAIN A STRONG AND WATERTIGHT BOND.

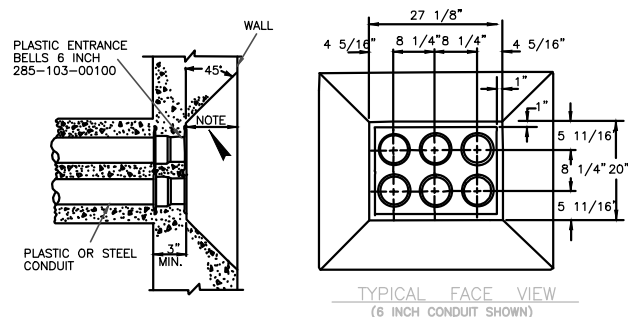


FIG. 1 MANHOLE ENTRANCE WITH PLASTIC TERMINATORS (OLDER STYLE)
FOR PLASTIC OR STEEL CONDUIT (POCKET TYPE)

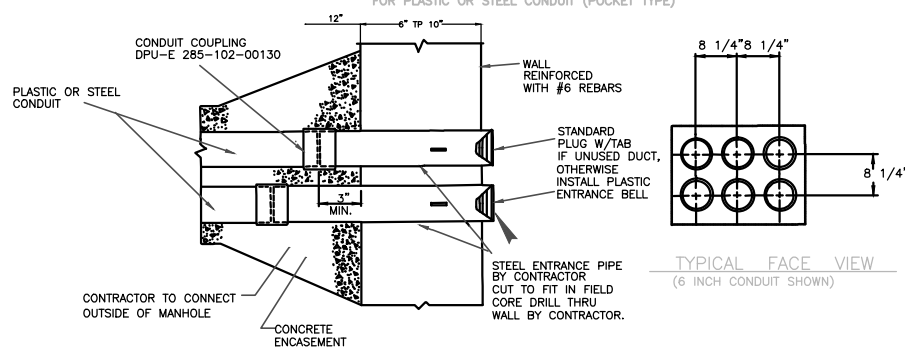


FIG. 2 ENTRANCE IN MANHOLE/HANDHOLE (NEWER STYLE)



NAPERVILLE PUBLIC UTILITIES DEPARTMENT ELECTRIC STANDARDS	DUCTBANK CONSTRUCTION SPECIFICATION	DATE: 04-24-07 Page 8 of 12 C30-1900
--	-------------------------------------	--

CONDUIT TO RISER AT POLE

CONDUIT TO RISER AT POLE
FOR PLASTIC OR STEEL CONDUIT

APPLICATION

- THIS STANDARD SHALL BE USED WHEN A TRANSITION FROM A SINGLE DUCT TO SINGLE RISER PIPE IS REQUIRED.

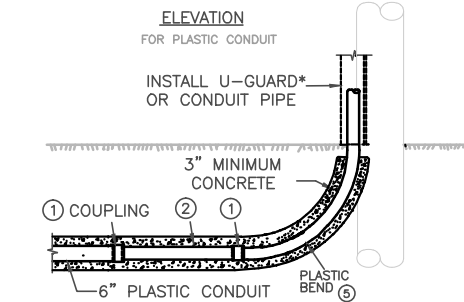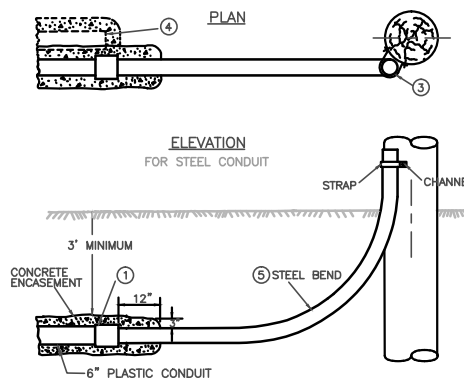

SUPPLEMENTARY MATERIAL


- IF BELLED END OF PLASTIC CONDUIT CAN BE CONNECTED TO STEEL BEND OMIT COUPLING.

NOTES:

- FIRST SECTION ABOVE ELBOW MUST BE SCHEDULE 80.
- FOR LARGER POLES (>50'), ADDITIONAL CONDUIT AND HARDWARE MAY BE REQUIRED.
- STEEL BEND AND POLE BRACKET EXISTING FROM PREVIOUS DUCT BANK INSTALLATION.
- INSTALL STEEL BEND AND POLE BRACKET AND CHANNEL.
- INSTALL SPARE OF CONDUIT UP POLE WITH BEND, ATTACH TO BRACKET AND PLUG.

NAPERVILLE PUBLIC UTILITIES DEPARTMENT ELECTRIC STANDARDS	DUCTBANK CONSTRUCTION SPECIFICATION	DATE: 04-24-07 Page 9 of 12 C30-1900
--	-------------------------------------	--

RISER CONSTRUCTION FOLLOW CONSTRUCTION STANDARD C20-5220

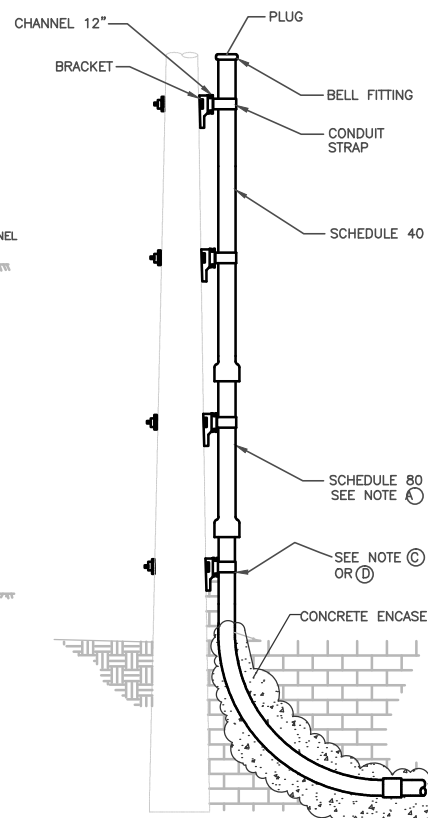


INFORMATION

- FIELD CUT SO THAT A GOOD CONNECTING FIT CAN BE MADE BETWEEN THE CONDUITS AND BENDS.
- LOCATE THE BEND ON A QUADRANT OF THE POLE WHERE IT IS THE LEAST SUSCEPTIBLE TO DAMAGE BY VEHICLES.
- IF SPARE DUCT IS INSTALLED, PLUG AT BOTH ENDS AND ENCASE IN CONCRETE WHEN NECESSARY.
- SCHEDULE 80 PVC DOES NOT REQUIRE CONCRETE ENCASEMENT.
- CONDUIT TO A U-GUARD* RISER FOLLOWS C20-5222, FOR USE AS MAINTENANCE ONLY.


PLASTIC CONDUIT COUPLINGS

SUBTITLE LINE TWO

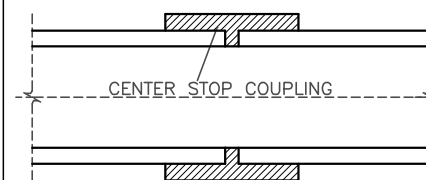

PLASTIC TO PLASTIC OR PLASTIC TO STEEL COUPLING

SIZE	DPU-E #	MATERIAL / USE
3"	285-102-00040	PLASTIC TO PLASTIC
5"	285-102-00110	PLASTIC TO PLASTIC
6"	285-102-00140	PLASTIC TO PLASTIC
5"	285-102-00110	PLASTIC TO STEEL
6"	285-102-00140	PLASTIC TO STEEL

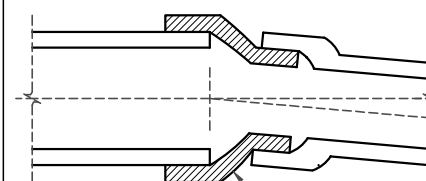

PLASTIC TO PLASTIC 5" COUPLING

SIZE	DPU-E #	MATERIAL / USE
3"	285-102-00050	PLASTIC TO PLASTIC
5"	285-102-00120	PLASTIC TO PLASTIC
6"	285-102-00150	PLASTIC TO PLASTIC


PLUG W/PULL TAB

SIZE	DPU-E #
3"	285-103-00030
5"	285-103-00070
6"	285-103-00090

APPLICATION


THIS STANDARD SHALL BE USED FOR THE INSTALLATION OF CONDUIT CONNECTIONS ON CONCRETE ENCASED PLASTIC CONDUIT DUCTBANK.

NAPERVILLE PUBLIC UTILITIES DEPARTMENT ELECTRIC STANDARDS	DUCTBANK CONSTRUCTION SPECIFICATION	DATE: 04-24-07 Page 10 of 12 C30-1900
--	-------------------------------------	---

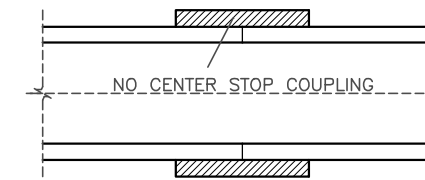


PLASTIC TO PLASTIC OR PLASTIC TO STEEL SLEEVE

SIZE	DPU-E #	MATERIAL / USE
3"	285-102-00060	PLASTIC TO PLASTIC
5"	285-102-00100	PLASTIC OR STEEL
6"	285-102-00130	PLASTIC OR STEEL

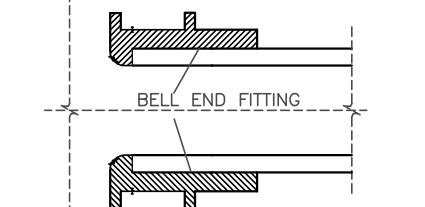

PLASTIC BELL END FITTINGS


SIZE	DPU-E #	MATERIAL
3"	285-103-00040	PLASTIC
5"	285-103-00080	PLASTIC
6"	285-103-00100	PLASTIC

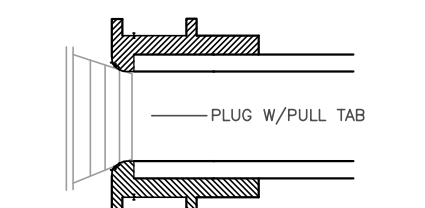

THE 6" EXPANDING PLUG W/EYE NUT DPU-E# 285-103-00150



PROJECT TITLE ROUTE 59 ROAD IMPROVEMENTS			
PROJECT DESCRIPTION DETAILS AND STANDARDS			
ENGINEER BCC	DRAFTING DATE 5-11-12	MAP # 4211,4212,4223	SCALE N.T.S.
GIS DESIGN BY DL	DRAFTED BY PSM	AT&T JOINT AGREEMENT # N/A	PROJECT # EU-12
CHECKED BY	APPROVED BY	CAD FILE 0060648001D130.DWG	SHEET # 30 OF 63
Naperville		Department of Public Utilities Electric Division	
CONTRACT 60P42 SHEET 162 OF 234			WORK REQUEST # 60468

PLASTIC & STEEL CONDUIT BENDS
FOR CONCRETE ENCASED CONDUIT
BENDS, UP TO 90° DEGREE ANGLES

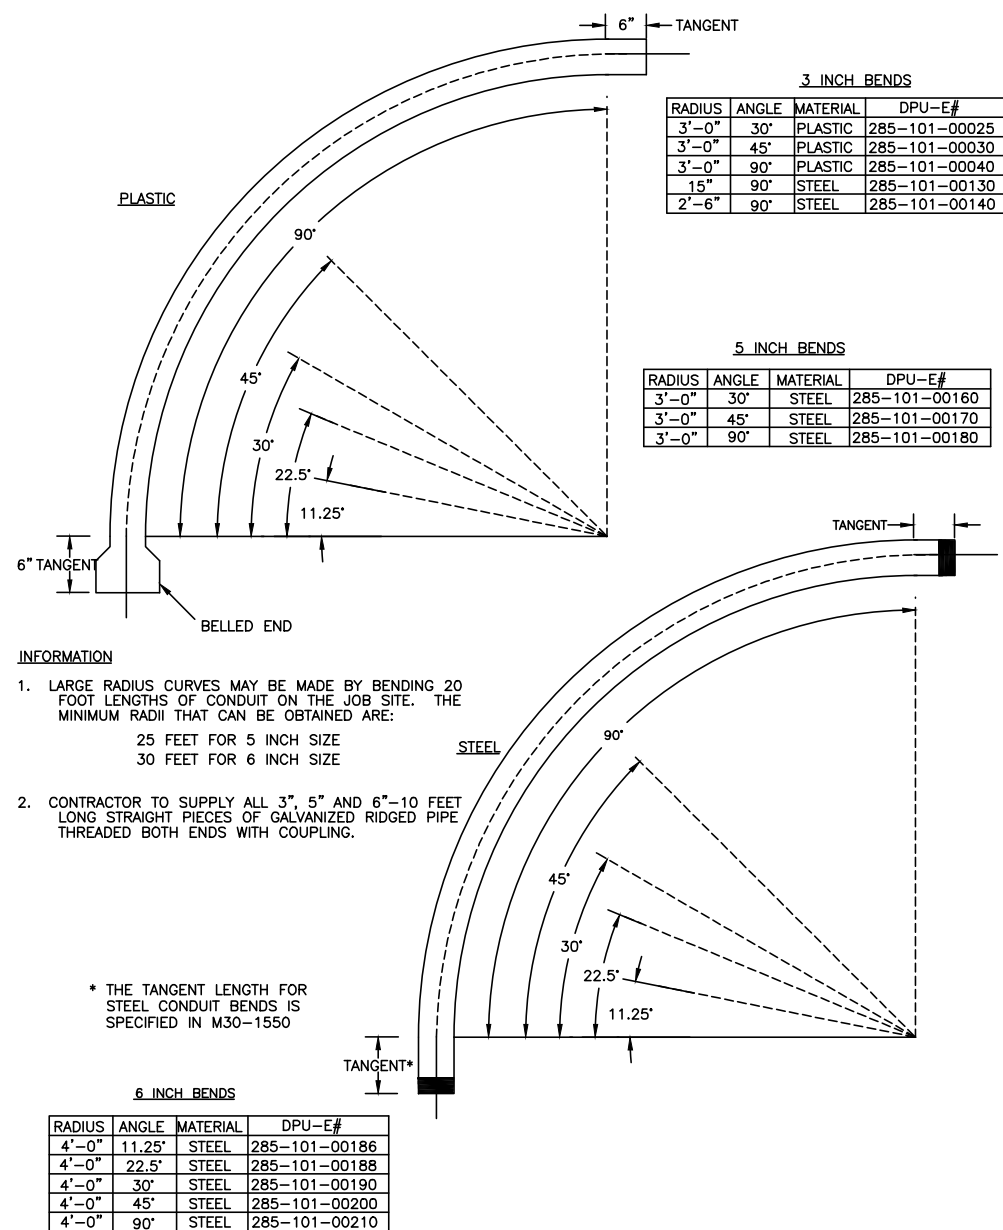

- INFORMATION**
- LARGE RADIUS CURVES MAY BE MADE BY BENDING 20 FOOT LENGTHS OF CONDUIT ON THE JOB SITE. THE MINIMUM RADII THAT CAN BE OBTAINED ARE:
25 FEET FOR 5 INCH SIZE
30 FEET FOR 6 INCH SIZE
 - CONTRACTOR TO SUPPLY ALL 3", 5" AND 6"-10 FEET LONG STRAIGHT PIECES OF GALVANIZED RIDGED PIPE THREADED BOTH ENDS WITH COUPLING.

* THE TANGENT LENGTH FOR STEEL CONDUIT BENDS IS SPECIFIED IN M30-1550

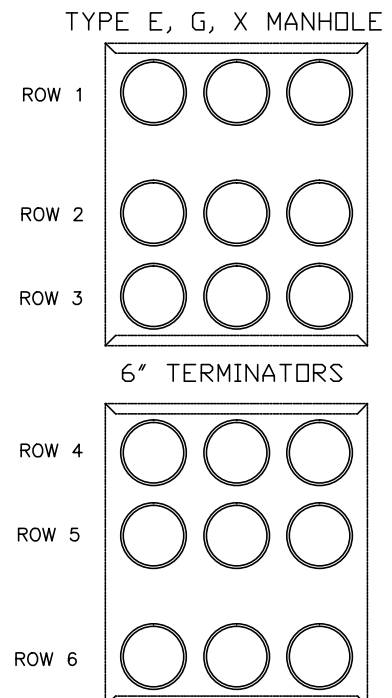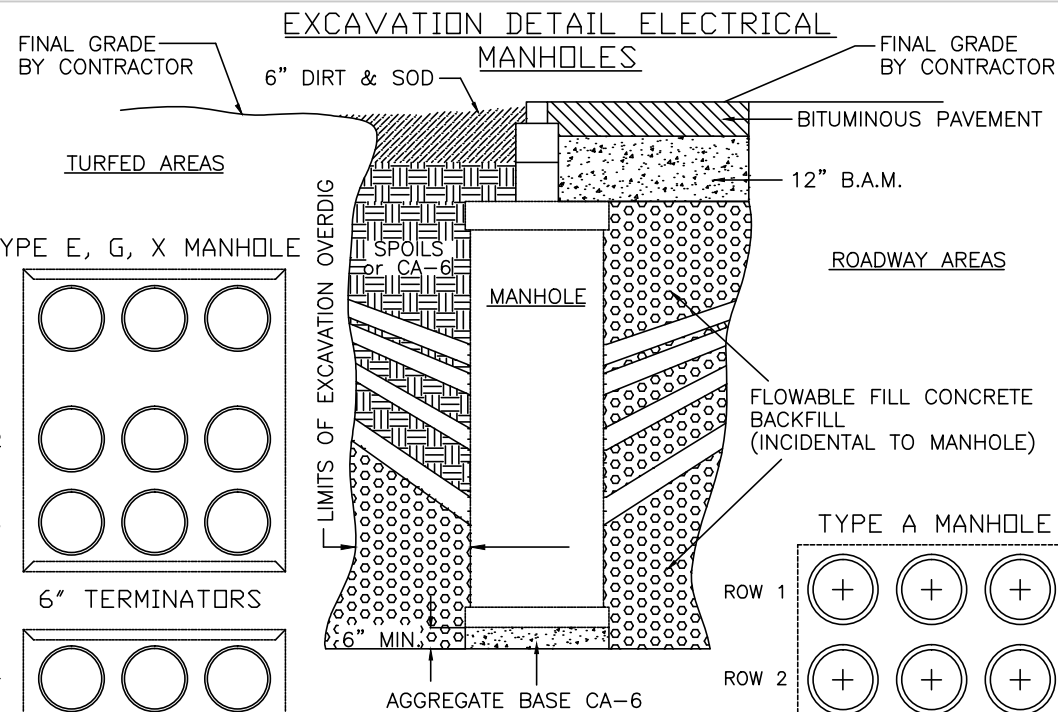


NOTE:
FLOWABLE FILL CONCRETE TO BE PLACED 360° AROUND MANHOLES TO THE BASE OF THE PVC CONDUITS ONLY IN TURFED AREAS. IN ROADWAY AREAS FLOWABLE FILL CONCRETE MUST COMPLETELY ENCASE 360° THE MANHOLE AND DUCTBANK.

TYPE	ROW 1	ROW 2	ROW 3	ROW 4	ROW 5	ROW 6
4-WAY DUCT BANK	-----	-----	-----	2 X 6"	2 X 6"	-----
6-WAY DUCT BANK	-----	-----	-----	3 X 6"	3 X 6"	-----
8-WAY DUCT BANK	-----	-----	2 X 6"	3 X 6"	3 X 6"	-----
9-WAY DUCT BANK	-----	-----	3 X 6"	3 X 6"	3 X 6"	-----
10-WAY DUCT BANK	-----	1 X 6"	3 X 6"	3 X 6"	3 X 6"	-----
12-WAY DUCT BANK	-----	3 X 6"	3 X 6"	3 X 6"	3 X 6"	-----


FILL THE OUTSIDE DUCTS IN EACH ROW FIRST

PROJECT TITLE				ROUTE 59 ROAD IMPROVEMENTS			
PROJECT DESCRIPTION				DETAILS AND STANDARDS			
ENGINEER	DRAFTING DATE	MAP #	SCALE				
BCC	5-11-12	4211,4212,4223	N.T.S.				
GIS DESIGN BY	DRAFTED BY	AT&T JOINT AGREEMENT #	PROJECT #				
DL	PSM	N/A	EU-12				
CHECKED BY	APPROVED BY	CAD FILE	SHEET #				
		0060648001D131.DWG	31 OF 63				
Naperville			Department of Public Utilities Electric Division			WORK REQUEST # 60468	

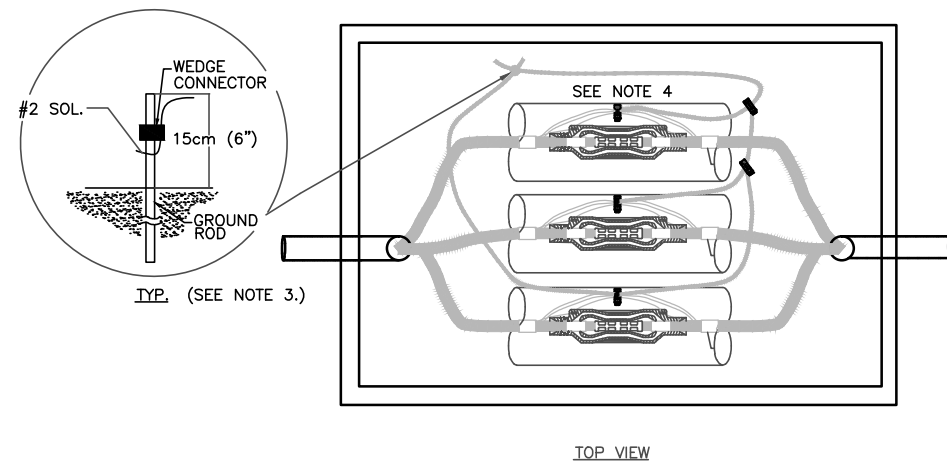

ASSEMBLY CODES		
CODE	QTY	DESCRIPTION
DEHn	1	SPLICE BOX
DnBxxP	**	BEND, PVC
DnBxxS	**	BEND, STEEL
UGHn	1	GROUNDING HANDHOLE

n dependent on size
xx bend angle dependent on field condition (typically 30°)
** quantity is dependent on application

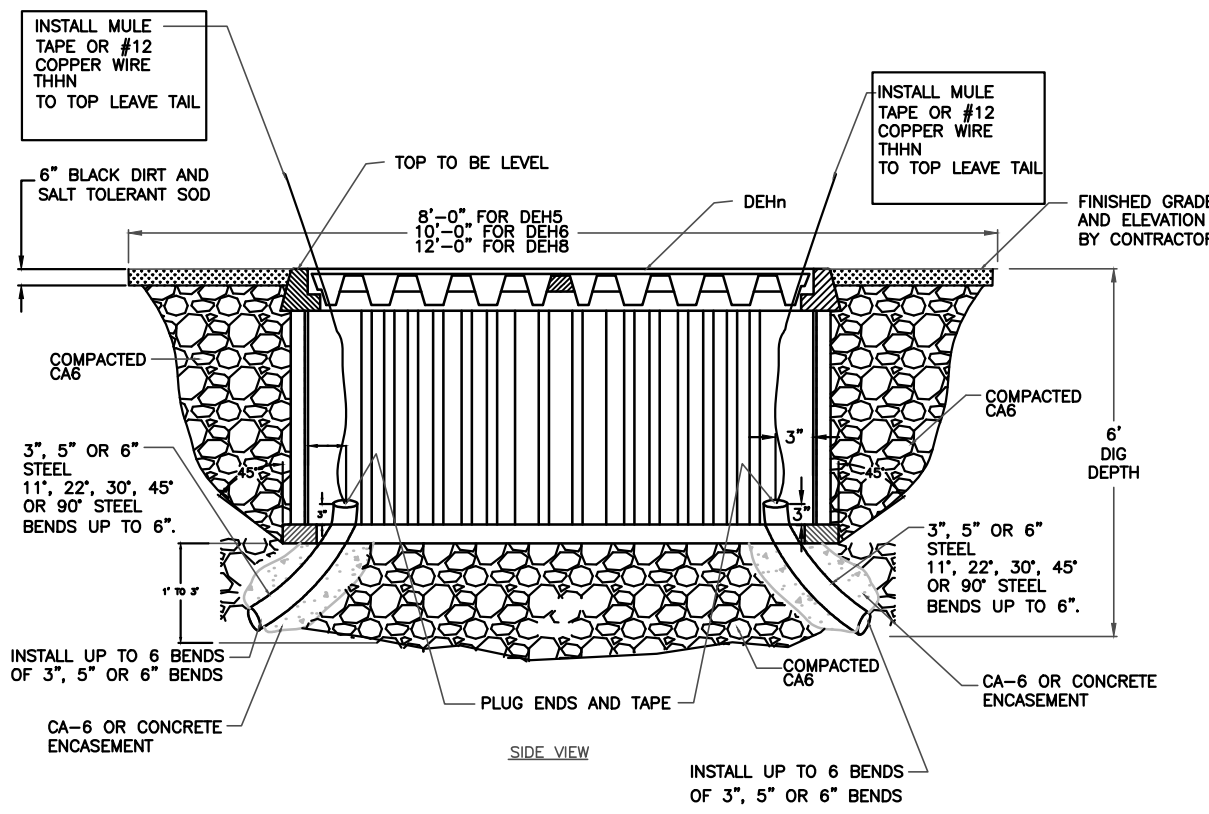

- NOTE:
- BENDS SHALL BE INSTALLED PER FIELD CONDITION.
 - SPARES NOT SHOWN.
 - GROUNDING WILL NOT BE INSTALLED AT TIME OF HANDHOLE INSTALLATION, BUT WILL BE INSTALLED WITH SPLICE.
 - BREAK-AWAY MUST BE WRAPPED WITH AQUA SEAL MASTIC TO PREVENT TEARING OF HEAT SHRINK WRAP AROUND SLEEVE.
 - INSTALL COVERS BEFORE BACKFILLING OPERATIONS TO HELP SUPPORT UPPER BOX SECTION WHILE EARTH IS PLACED AND COMPACTED.
 - EXCAVATION:
 - 8' LONG BY 6' DEEP BY 6' WIDE DEH5.
 - 10' LONG BY 6' DEEP BY 6' WIDE DEH6.
 - 12' LONG BY 6' DEEP BY 6' WIDE DEH8.
 - BACKFILL WITH COMPACTED CA6.
 - CUT HANDHOLE TO INSTALL PIPE, IF REQUIRED.
 - ALL MATERIALS BY THE CITY EXCEPT BACKFILL AND RESTORATION.
 - CABLE WORK NOT REQUIRED.
 - RESTORATION BY CONTRACTOR.

DEHn: HANDHOLE (SPLICE BOX)

Item Code	Description 1	Description 2	DEH			
			5 Qty	6 Qty	8 Qty	8A Qty
284 104 00010	HANDHOLE	36" X 60" X 36"	1			
284 104 00020	HANDHOLE	48" X 78" X 36"		1		
284 104 00030	HANDHOLE	48" X 96" X 36"			1	
284 104 00040	HANDHOLE, ADJUSTABLE	48" X 96" X 36"				1

DnBxxP: BEND, PVC

Assembly	Item Code	Description 1	Description 2	Qty
D3B30P	285 101 00025	ELBOW, PVC 30 DEG 3"	STANDARD RADIUS SCH 40	1
D3B45P	285 101 00030	ELBOW, 36"R PVC 45 DEG 3"	SCH 40	1
D3B90P	285 101 00040	ELBOW, 36"R PVC 90 DEG 3"	SCH 40	1
D5B30P	285 101 00080	ELBOW, 36"R PVC 30 DEG 5"	SCH 40	1
D5B45P	285 101 00090	ELBOW, 36"R PVC 45 DEG 5"	SCH 40	1
D5B90P	285 101 00100	ELBOW, 36"R PVC 90 DEG 5"	SCH 40	1
D6B30P	285 101 00220	ELBOW, 48"R PVC 30 DEG 6"	SCH 40	1
D6B45P	285 101 00230	ELBOW, 48"R PVC 45 DEG 6"	SCH 40	1
D6B90P	285 101 00240	ELBOW, 48"R PVC 90 DEG 6"	SCH 40	1

D3BxxS: BEND, 3" STEEL

Item Code	Description 1	Description 2	D3B90S Qty
			285 101 00140
285 102 00040	COUPLING, PVC 3"	LONG LINE SCH 40	1

D5BxxS: BEND, 5" STEEL

Item Code	Description 1	Description 2	D5B30S Qty	D5B45S Qty	D5B90S Qty
			285 101 00160	ELBOW, 36"R STL 30 DEG 5"	GALVANIZED
285 101 00170	ELBOW, 36"R STL 45 DEG 5"	GALVANIZED		1	
285 101 00180	ELBOW, 36"R STL 90 DEG 5"	GALVANIZED			1
285 102 00110	COUPLING, PVC 5"	LONG LINE SCH 40	1	1	1

D6BxxS: BEND, 6" STEEL

Item Code	Description 1	Description 2	D6B11S Qty	D6B22S Qty	D6B30S Qty	D6B45S Qty	D6B90S Qty
			285 101 00186	ELBOW, 48"R STL 11 DEG 6"	GALVANIZED	1	
285 101 00188	ELBOW, 48"R 22.5 DEG 6"	GALVANIZED		1			
285 101 00190	ELBOW, 48"R STL 30 DEG 6"	GALVANIZED			1		
285 101 00200	ELBOW, 48"R STL 45 DEG 6"	GALVANIZED				1	
285 101 00210	ELBOW, 48"R STL 90 DEG 6"	GALVANIZED					1
285 102 00140	COUPLING, PVC 6"	LONG LINE SCH 40	1	1	1	1	1

UGHn: GROUNDING, HANDHOLE

Item Code	Description 1	Description 2	UGH1 Qty	UGH3 Qty
			280 107 00020	CU BARE SD
283 156 00010	GROUND ROD COPPER CLAD	5/8" X 10'	1	1
286 100 00320	CONNECTOR, WEDGE CU	4/0 STR(7) - 5/8" ROD	1	1
286 101 00010	SHELL, WEDGE AMP	BLUE	1	1
286 199 00210	CONNECTOR, BREAK-AWAY CU	2SOL-2/0STR X 2SOL-2/0STR	1	2

NAPERVILLE PUBLIC UTILITIES DEPARTMENT
ELECTRIC STANDARDS
HANDHOLE ASSEMBLY
DATE: 04-07-04
Page 1 of 2
C30-6336

NAPERVILLE PUBLIC UTILITIES DEPARTMENT
ELECTRIC STANDARDS
HANDHOLE ASSEMBLY
DATE: 04-07-04
Page 2 of 2
C30-6336

PROJECT TITLE					ROUTE 59 ROAD IMPROVEMENTS					
PROJECT DESCRIPTION					DETAILS AND STANDARDS					
ENGINEER	DRAFTING DATE	MAP #	SCALE							
BCC	5-11-12	4211,4212,4223	N.T.S.							
DESIGN BY	DRAFTED BY	REVISIONS DATE	AT&T JOINT AGREEMENT #	PROJECT #						
DL	PSM		N/A	EU-12						
CHECKED BY	APPROVED BY	CAD FILE	SHEET #							
		0060648001D132.DWG	32 OF 63							
Naperville			Department of Public Utilities Electric Division			WORK REQUEST #		60468		

GROUND ELECTRODE MEASUREMENT

SCOPE:

GROUNDING TESTS SHALL BE DONE FOR MANHOLE GROUNDS, GROUND ROD CONNECTIONS AND COUNTERPOISE CONNECTIONS TO ENSURE THE INTEGRITY OF THE ELECTRODE INSTALLATION. TESTING OF THE GROUND SYSTEM AND CONNECTIONS SHALL BE DONE USING THE CLAMP-ON RESISTANCE TEST METHOD FOR GROUND RODS AND COUNTERPOISE.

CLAMP-ON GROUND RESISTANCE TEST (NORMAL TEST)
THREE POINT FALL OF POTENTIAL TEST (NORMAL TEST)


TESTS SHALL BE PERFORMED WHEN THE GROUND IS NOT FROZEN TO ELIMINATE HIGH RESISTANCE READINGS IN THE MANHOLES. THE CLAMP ON TEST SHALL BE DONE AT EACH GROUND ROD AND COUNTERPOISE CONNECTION AND FROM THE MANHOLE PERIMETER GROUND CABLE TO THE GROUND ROD. AEMC INSTRUMENT MODEL 3710, 3730, OR EQUIVALENT MAY BE USED. THE CLAMP ON GROUND METER SHALL CLAMP ON TO THE POWER NEUTRAL BETWEEN THE UTILITY TRANSFORMER, POLE GROUND, SWITCH GEAR GROUND AND THE SITE GROUND. THE USER MUST BE AWARE THAT A 0.7 READING INDICATES A CONTINUITY LOOP AND NOT A GROUND RESISTANCE. IF A POWER NEUTRAL IS NOT CLOSE TO THE NEW INSTALLATION THEN THE THREE POINT FALL OF Ω POTENTIAL, GROUND RESISTANCE CAN BE USED.

ALL TESTING MATERIAL AND TOOLS ARE FURNISHED BY THE CONTRACTOR. THIS SPECIFICATION IS USED TO TEST HANDHOLES, SWITCH GEAR VAULTS, MANHOLES, TRANSFORMER VAULTS AND OTHER EQUIPMENT AS DIRECTED.

NAPERVILLE PUBLIC UTILITIES DEPARTMENT ELECTRIC STANDARDS	GROUNDING WITH GROUND RODS (DETAIL)	DATE: 05-01-05 Page 1 of 7 56270-100
--	--	--

CLAMP ON METER TEST STANDARD MANHOLE

(GROUNDING WITH GROUND RODS AND COUNTERPOISE)

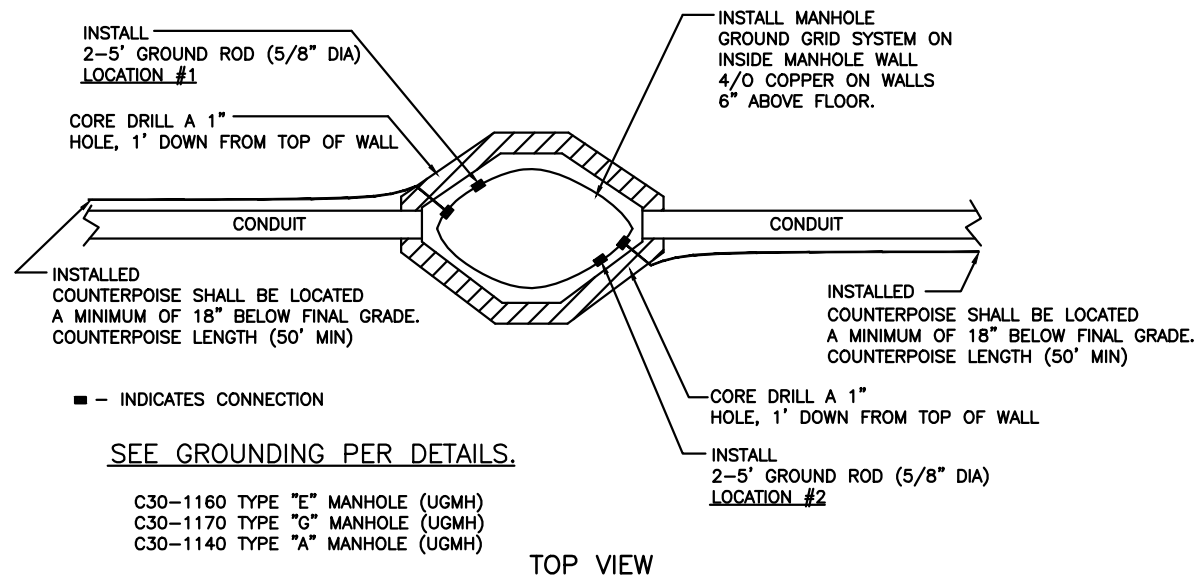


SEE GROUNDING PER DETAILS.

- C30-1160 TYPE "E" MANHOLE (UGMH)
- C30-1170 TYPE "G" MANHOLE (UGMH)
- C30-1140 TYPE "A" MANHOLE (UGMH)

NAPERVILLE PUBLIC UTILITIES DEPARTMENT ELECTRIC STANDARDS	GROUNDING WITH GROUND RODS (DETAIL)	DATE: 05-01-05 Page 2 of 7 56270-100
--	--	--

STANDARD MANHOLE (GROUNDING WITH RODS)

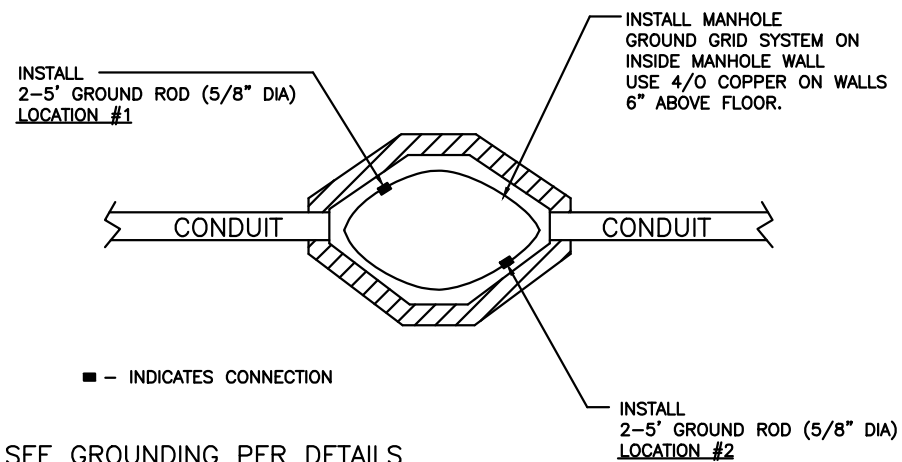


SEE GROUNDING PER DETAILS

- C30-1160 TYPE "E" MANHOLE (UGMH)
- C30-1170 TYPE "G" MANHOLE (UGMH)
- C30-1140 TYPE "A" MANHOLE (UGMH)

NAPERVILLE PUBLIC UTILITIES DEPARTMENT ELECTRIC STANDARDS	GROUNDING WITH GROUND RODS (DETAIL)	DATE: 05-01-05 Page 3 of 7 56270-100
--	--	--

PLACEMENT OF METER FOR READING

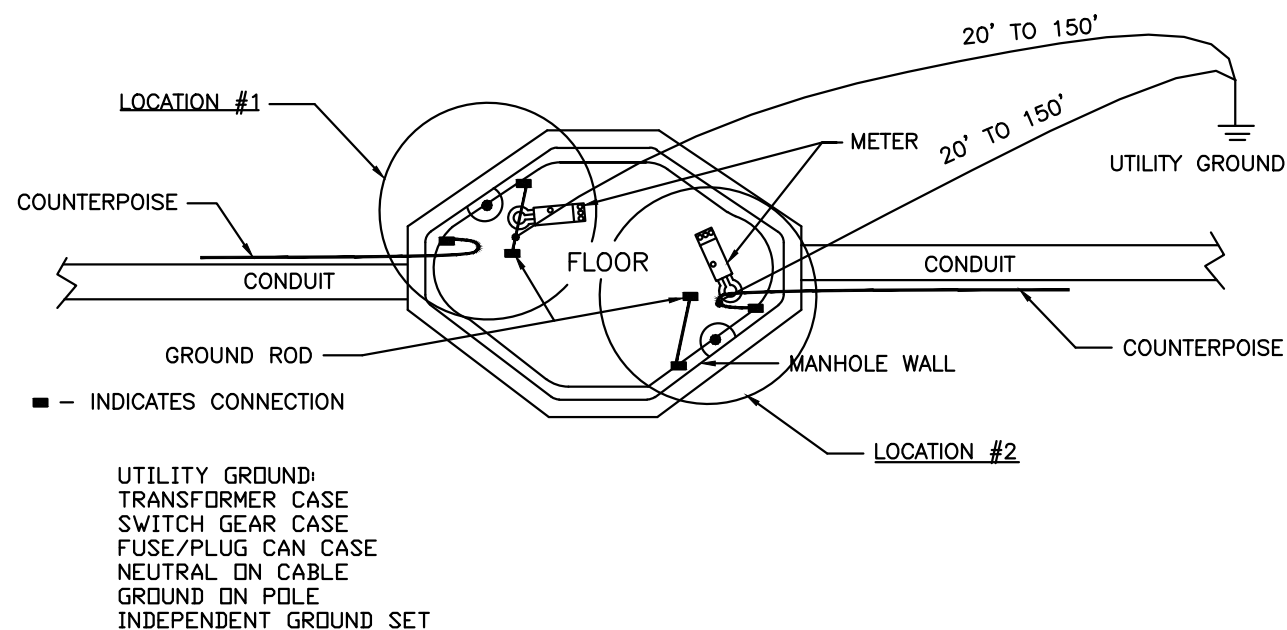


UTILITY GROUND:
TRANSFORMER CASE
SWITCH GEAR CASE
FUSE/PLUG CAN CASE
NEUTRAL ON CABLE
GROUND ON POLE
INDEPENDENT GROUND SET

NAPERVILLE PUBLIC UTILITIES DEPARTMENT ELECTRIC STANDARDS	GROUNDING WITH GROUND RODS (DETAIL)	DATE: 05-01-05 Page 4 of 7 56270-100
--	--	--

PROJECT TITLE ROUTE 59 ROAD IMPROVEMENTS			
PROJECT DESCRIPTION DETAILS AND STANDARDS			
ENGINEER BCC	DRAFTING DATE 5-11-12	MAP # 4211,4212,4223	SCALE N.T.S.
GIS DESIGN BY DL	DRAFTED BY PSM	AT&T JOINT AGREEMENT # N/A	PROJECT # EU-12
CHECKED BY	APPROVED BY	CAD FILE 0060648001D133.DWG	SHEET # 33 OF 63
Naperville		Department of Public Utilities Electric Division	
			WORK REQUEST # 60468

SAMPLE INSTALLATION (CLAMP ON METER)

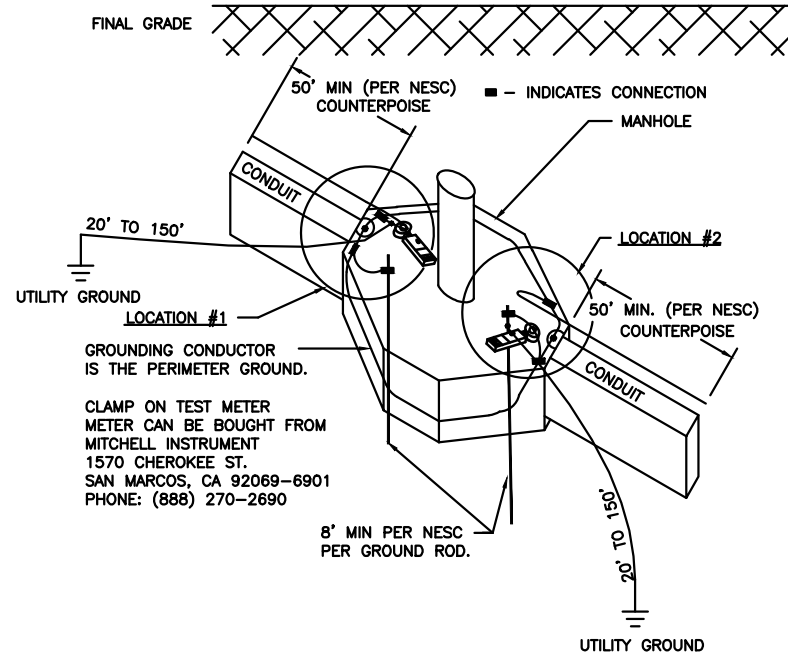

NOTE:

OBSERVE ALL SAFETY REQUIREMENTS AND THEN REMOVE COVERING ON THE GROUND CONDUCTOR IF PRESENT AND PROVIDE SUFFICIENT ROOM FOR THE MODEL 3710/3730 JAWS, WHICH MUST BE ABLE TO CLOSE EASILY AROUND THE CONDUCTOR. THE JAWS CAN BE PLACED AROUND THE GROUND ROD ITSELF.
 NOTE: THE CLAMP MUST BE PLACED SO THAT THE JAWS ARE IN AN ELECTRICAL PATH FROM THE SYSTEM NEUTRAL OR GROUND WIRE TO THE GROUND ROD, OR COUNTERPOISE.
 SELECT THE CURRENT RANGE "A". CLAMP ONTO THE GROUND CONDUCTOR AND MEASURE THE GROUND CURRENT. THE MAXIMUM CURRENT RANGE IS 30 A. IF THE GROUND CURRENT EXCEEDS 5 A, GROUND RESISTANCE MEASUREMENTS ARE NOT POSSIBLE. DO NOT PROCEED FURTHER WITH THE MEASUREMENT. REMOVE THE CLAMP-ON TESTER FROM THE CIRCUIT, NOTING THE LOCATION FOR MAINTENANCE, AND CONTINUE TO THE NEXT TEST LOCATION. RECORD CURRENT ON DATA SHEET.

AFTER NOTING THE GROUND CURRENT, SELECT THE GROUND RESISTANCE RANGE Ω (OHM) AND MEASURE THE RESISTANCE DIRECTLY. THE READING YOU MEASURE WITH THE 3710/3730 INDICATES THE RESISTANCE OF THE ROD, RESISTANCE OF THE COUNTERPOISE, BUT ALSO OF THE CONNECTION TO THE SYSTEM NEUTRAL AND ALL BONDING CONNECTIONS BETWEEN THE NEUTRAL AND THE ROD.
 RECORD 2 OR 4 RESISTANCE READINGS ON DATA SHEET. IF ANY ONE READING IS ABOVE 25 OHMS, CONTACT DPU-E IMMEDIATELY. SEND COMPLETED DATA SHEET TO THE PROJECT ENGINEER AND RECORDS.


NAPERVILLE PUBLIC UTILITIES DEPARTMENT ELECTRIC STANDARDS	GROUNDING WITH GROUND RODS (DETAIL)	DATE: 05-01-05 Page 5 of 7 56270-100
--	--	--

**DATA SHEET FOR RECORDING
GROUND RESISTANCE BY THE FALL OF POTENTIAL METHOD.**

F.A.P. RTE.	SECTION	COUNTY	TOTAL SHEETS	SHEET NO.
338/IL 59	2011-035-1	DUPAGE		
CONTRACT 60P42				
FED.ROAD.DIST.NO.	ILLINOIS	FED. AID PROJECT		

TYPE OF METER AND MFG.: _____
 MANHOLE NUMBER + TYPE: _____
 POLE NUMBER + SIZE: _____
 STREET ADDRESS: _____
 NAME OF PERSON PERFORMING TEST: _____
 W.F. #: _____
 TEMPERATURE (AIR): _____ °F
 SIZE OF GROUND RODS: 5/8 DIA COPPER CLAD, UNLESS NOTED
 SIZE OF CABLE FOR GROUND WIRE AND/OR COUNTERPOISE IS 4/0 COPPER (BARE) 7 STRAND, UNLESS NOTED

TEST INSTRUMENT:
 MANUFACTURER: _____
 MODEL NO.: _____
 CALIBRATION DATE: _____

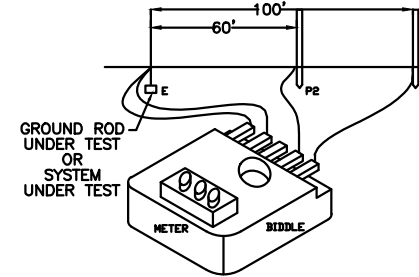

TEST METHOD USED
 1) 3 POINT ELECTRODE AC "FALL-OF-POTENTIAL"

LOCATION	TEST METHOD	NO. OF RODS	ROD SIZE & LENGTH	DISTANCE BETWEEN RODS (FT.)	AUX. ELECTRODE TEST POINT (FT.)		RESISTANCE OHMS	REMARKS
					P2	C2		

NOTE

NAPERVILLE PUBLIC UTILITIES DEPARTMENT ELECTRIC STANDARDS	GROUNDING WITH GROUND RODS (DETAIL)	DATE: 05-01-05 Page 6 of 7 56270-100
--	--	--

**DATA SHEET FOR RECORDING
GROUND RESISTANCE MEASUREMENT
BY THE CLAMP ON GROUND RESISTANCE TEST METHOD**


DATE: _____
 TYPE OF METER AND MFG.: _____
 MANHOLE NUMBER + TYPE: _____
 POLE NUMBER + SIZE: _____
 STREET ADDRESS: _____
 NAME OF PERSON PERFORMING TEST: _____
 W.F. #: _____
 TEMPERATURE (AIR): _____ °F
 SIZE OF GROUND RODS: 5/8 DIA COPPER CLAD, UNLESS NOTED
 SIZE OF CABLE FOR GROUND WIRE AND/OR COUNTERPOISE IS 4/0 COPPER (BARE) 7 STRAND, UNLESS NOTED

INSTALL FEET OF GROUND RODS TOTAL PER LOCATION		INSTALL FEET OF COUNTERPOISE TOTAL PER LOCATION		MEASURED RESISTANCE OF GROUND RODS (OHMS)		MEASURED RESISTANCE OF COUNTERPOISE (OHMS)		MEASURED RESISTANCE OF GROUND RODS AND COUNTERPOISE (OHMS)		SOIL CONDITION i.e. ROCK, CLAY SAND, WET OR DRY		METHOD OF CONNECTION TO GROUND RODS i.e. CADWELD BOLTED, AMPACT, CRIMP.		CURRENT READING (AMPS)		MEASURED WATER LEVEL IN MANHOLE (FT)	REMARKS
LOCATION #1	LOCATION #2	LOCATION #1	LOCATION #2	LOCATION #1	LOCATION #2	LOCATION #1	LOCATION #2	LOCATION #1	LOCATION #2	LOCATION #1	LOCATION #2	LOCATION #1	LOCATION #2	LOCATION #1	LOCATION #2		

NOTE:
 A HIGH READING INDICATES ONE OR MORE OF THE FOLLOWING:
 1) POOR GROUND RODS.
 2) OPEN GROUND CONDUCTOR.
 3) HIGH RESISTANCE, DUE TO POOR CONNECTIONS ON RODS, HARDWARE & CLAMPS.
 4) METER CLAMP IS IMPROPERLY CLOSED.
 5) FAULTY METER.

NAPERVILLE PUBLIC UTILITIES DEPARTMENT	GROUNDING WITH GROUND RODS (DETAIL)	DATE: 05-01-05 Page 7 of 7 56270-100
--	--	--

PROJECT TITLE ROUTE 59 ROAD IMPROVEMENTS			
PROJECT DESCRIPTION DETAILS AND STANDARDS			
ENGINEER BCC	DRAFTING DATE 5-11-12	MAP # 4211,4212,4223	SCALE N.T.S.
DESIGN BY DL	DRAFTED BY PSM	AT&T JOINT AGREEMENT # N/A	PROJECT # EU-12
CHECKED BY	APPROVED BY	CAD FILE 0060648001D134.DWG	SHEET # 34 OF 63
Naperville		Department of Public Utilities Electric Division	
CONTRACT 60P42 SHEET 166 OF 234			WORK REQUEST # 60468

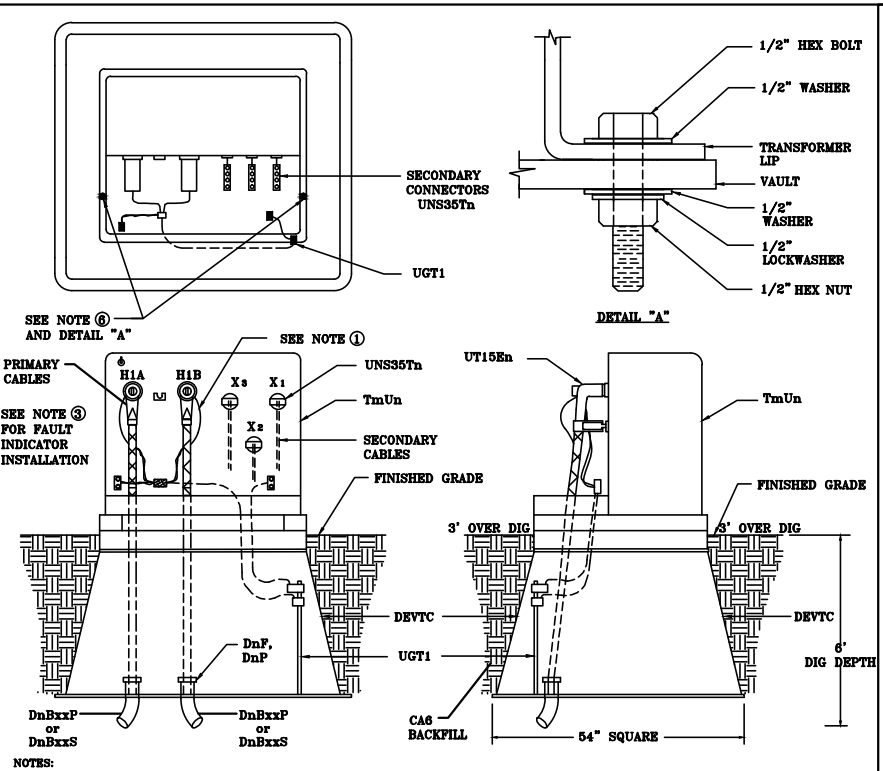


- NOTES:**
- ONE STRAND OF CONCENTRIC NEUTRAL FOR DRAIN WIRE.
 - SEE C30-0500 FOR 200A ELBOW STANDARD.
 - SEE C30-1010 FOR FAULT INDICATOR INSTALLATION. FAULT INDICATORS NOT REQUIRED FOR RADIAL TRANSFORMER INSTALLATION.
 - BENDS SHALL BE INSTALLED PER FIELD CONDITION.
 - SPARES NOT SHOWN.
 - TRANSFORMER TO BE BOLTED TO VAULT IN TWO LOCATIONS. DRILL 9/16" HOLES IN VAULT. REFER TO TOP VIEW AND DETAIL "A."
 - ALLOW SUFFICIENT SLACK IN PRIMARY AND SECONDARY CABLES TO ACCOMMODATE SLIGHT VARIATIONS IN BUSHING HEIGHTS BETWEEN DIFFERENT TRANSFORMER SIZES AND MANUFACTURERS.
 - THIS DRAWING SHOWS AN EXISTING TRANSFORMER WITH CABLE INSTALLED WITH MATERIAL LIST ON RIGHT.
 - CONTRACTOR TO OBTAIN OUTAGE OF TRANSFORMER PRIOR TO DOING ANY WORK.
 - CONTRACTOR TO INSTALL 3", 5" AND 6" CONDUIT INTO EXISTING AS SPECIFIED IN SPECIFICATIONS CAP AND PLUGS ALL CONDUITS.
 - ALL GROUNDING CONNECTIONS AND TERMINATORS SHALL BE INSPECTED TO DETERMINE CONDITION OF CONNECTIONS BY THE CONTRACTOR REPORT FINDING.

CODE	QTY	DESCRIPTION
DEVTC	1	Vault, 1φ Trf/fuse can
DnBxxP	**	Bend, PVC
DnBxxS	**	Bend, Steel
DnF	**	Bell Fitting, PVC
TmUn	1	Plug, PVC
TmUn	1	Transformer, pad mounted
UGT1	1	Grounding, Transformer, 1φ
UT15n	**	Faulted Circuit Indicator
UNSS57n	3	Connector 1φ Set Screw
UT15a*	**	Arrester
UT15En	2	Elbow, 15kV

* E or P (Elbow or Parking Stand)
 ** qty is dependent on application
 n is dependent on size
 m is dependent on secondary voltage
 x is bend angle dependent on field condition (typically 45°)

NAPERVILLE PUBLIC UTILITIES DEPARTMENT ELECTRIC STANDARDS	SINGLE PHASE PADMOUNT TRANSFORMER ASSEMBLY	DATE: 01-16-06 Page 1 of 4 C30-0011
--	--	---

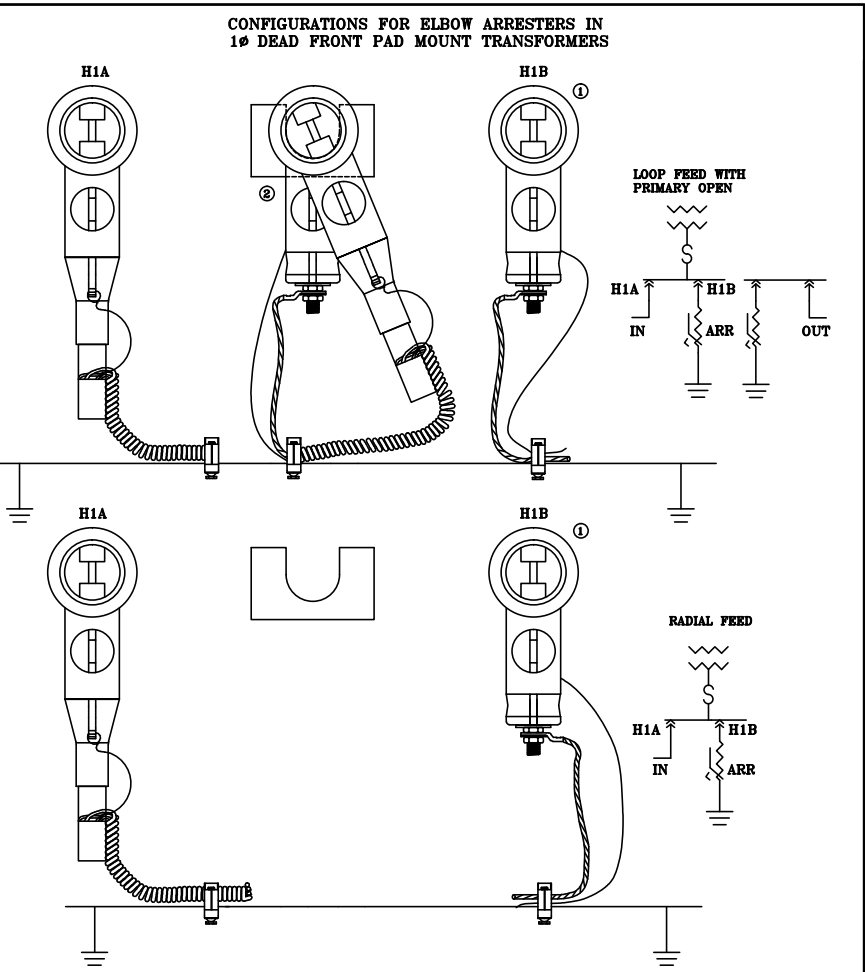

- NOTES:**
- ELBOW ARRESTER.
 - PARKING STAND ARRESTER.

NAPERVILLE PUBLIC UTILITIES DEPARTMENT ELECTRIC STANDARDS	SINGLE PHASE PADMOUNT TRANSFORMER ASSEMBLY	DATE: 01-16-06 Page 2 of 4 C30-0011
--	--	---

Item Code	Description 1	Description 2	QTY	QTY	QTY	QTY	QTY
283 199 00210	GUARD, WIRE	SPIRAL	4	3	8		
284 120 00010	FAULT INDICATOR, 1/0 - 4/0 15kV		1	3			
284 120 00020	FAULT INDICATOR, 750 - 1000 15kV						
284 120 00030	INDICATOR CABLE, 3 TO 1	10 FOOT	-	1	1		
284 120 00040	INDICATOR CABLE, 1 TO 1	8 FOOT	1	-	-		
284 120 00050	TIES, CABLE	SMALL	4	6	6		
284 120 00060	CLIP	ADHESIVE BACKED	4	6	6		

Assembly Code	Item Code	Description 1	Description 2	Qty
UNSS57n	286 199 00230	CONN, 5/8 STUD, 10-350	1PH TRF, 6 CONDUCTORS	1
UNSS57n	286 199 00235	CONN, 5/8 STUD, 6-500	1 PH TRF	1

Item Code	Description 1	Description 2	UT15A			UT15A3		
			B	E	P	B	E	P
284 11B 00020	ARRESTER, ELBOW	9/10 kV						
284 11B 00030	ARRESTER, PARKING STAND	9/10 kV						
284 11B 00040	ARRESTER, BUSHING INSERT	9/10kV	1	1	3			
286 199 00220	CONNECTOR, BREAKAWAY CU	1/0 - 4/0 STR	1	1	3	3	3	

Item Code	Description 1	Description 2	UT15E			UT15EE								
			10	10P	40	40E	C75	C99	10	40	75	99		
284 109 00010	FUSE, ELBOW 6kV	30A												
284 117 00020	ELBOW, FUSED 8.3kV 200A	1/0 STR AL 175-220 MIL	1											
284 117 00030	ELBOW, 15kV 200A	1/0 STR AL 175-220 MIL	1											
284 117 00051	ELBOW, 15kV 200A EXTENDED	1/0 STR AL 175-220 MIL												
284 117 00040	ELBOW, 15kV 200A	4/0 STR AL 175-220 MIL												
284 117 00041	ELBOW, 15kV 200A EXTENDED	4/0 STR AL 175-220 MIL												
284 117 00065	ELBOW, 15kV 600A, W/LTTP	750 MCM STR AL 175-220 MIL												
284 117 00066	ELBOW, 15kV 600A EXTENDED	750 MCM STR AL 175-220 MIL												
284 117 00095	ELBOW, 15kV 600A, W/LTTP	1000 MCM STR AL 175-220 MIL												
284 117 00096	ELBOW, 15kV 600A EXTENDED	1000 MCM STR AL 175-220 MIL												
284 117 00400	ELBOW, 15kV 600A	4/0 STR AL 175-220 MIL												
284 117 00430	KIT CABLE JACKET SEAL	1/0-4/0 (0.95"-1.50")	1	1	1	1	1			1	1	1	1	1
284 117 00440	KIT CABLE JACKET SEAL	250-1000 MCM (1.30"-2.67")	1	1	1	1	1			1	1	1	1	1
255 199 00100	CABLE CLEANER	QUARTS												

NAPERVILLE PUBLIC UTILITIES DEPARTMENT ELECTRIC STANDARDS	SINGLE PHASE PADMOUNT TRANSFORMER ASSEMBLY	DATE: 01-16-06 Page 4 of 4 C30-0011
--	--	---

DEVTC: VAULT, 1φ TRF/FUSE CAN

Item Code	Description 1	Description 2	QTY	A	TC	PC	F	AR	M
284 100 00120	EXTENDER, 1φ TRF VAULT	44" X 44" X 36" W/25" X25" OPEN	1						
284 101 00010	VAULT, AIR SWITCH	74" X 76" X 36" (FIBER-CRETE)		1					
284 101 00020	VAULT, 1φ TRF/FUSE CAN	44" X 44" X 36" (FIBER-CRETE)							
284 101 00030	VAULT, 3φ PLUG CAN	28" X 60" X 36" (FIBER-CRETE)				1			
284 101 00040	VAULT, 3φ FUSE CAN	49" X 60" X 36" (FIBER-CRETE)					1		
284 101 00100	EXTENDER, AIR SWITCH VAULT	74" X 76" X 36" (FIBER-CRETE)						1	
NON	CA-6	CRUSHED LIMESTONE	1		.25	.25			
NON	VAULT, 12.47kV PRL METERING	56" X 56" X 20" (FIBER-CRETE)							1

DnBxxP: BEND, PVC

Assembly	Item Code	Description 1	Description 2	Qty
D3B30P	285 101 00025	ELBOW, PVC 30 DEG 3"	STANDARD RADIUS SCH 40	1
D3B45P	285 101 00030	ELBOW, 36" R PVC 45 DEG 3"	SCH 40	1
D3B90P	285 101 00040	ELBOW, 36" R PVC 90 DEG 3"	SCH 40	1
D5B30P	285 101 00080	ELBOW, 36" R PVC 30 DEG 5"	SCH 40	1
D5B45P	285 101 00090	ELBOW, 36" R PVC 45 DEG 5"	SCH 40	1
D5B90P	285 101 00100	ELBOW, 36" R PVC 90 DEG 5"	SCH 40	1
D6B30P	285 101 00220	ELBOW, 48" R PVC 30 DEG 6"	SCH 40	1
D6B45P	285 101 00230	ELBOW, 48" R PVC 45 DEG 6"	SCH 40	1
D6B90P	285 101 00240	ELBOW, 48" R PVC 90 DEG 6"	SCH 40	1

D3BxxS: BEND, 3" STEEL

Item Code	Description 1	Description 2	Qty
285 101 00140	ELBOW, 30" R STL 90 DEG 3"	GALVANIZED	1
285 102 00040	COUPLING, PVC 3"	LONG LINK SCH 40	1

D5BxxS: BEND, 5" STEEL

Item Code	Description 1	Description 2	D5B30S	D5B45S	D5B90S
285 101 00160	ELBOW, 36" R STL 30 DEG 5"	GALVANIZED	1		
285 101 00170	ELBOW, 36" R STL 45 DEG 5"	GALVANIZED		1	
285 101 00180	ELBOW, 36" R STL 90 DEG 5"	GALVANIZED			1
285 102 00110	COUPLING, PVC 5"	LONG LINK SCH 40	1	1	1

D6BxxS: BEND, 6" STEEL

Item Code	Description 1	Description 2	D6B11S	D6B22S	D6B30S	D6B45S	D6B90S
285 101 00186	ELBOW, 48" R STL 11 DEG 6"	GALVANIZED	1				
285 101 00188	ELBOW, 48" R 22.5 DEG 6"	GALVANIZED		1			
285 101 00190	ELBOW, 48" R STL 30 DEG 6"	GALVANIZED			1		
285 101 00200	ELBOW, 48" R STL 45 DEG 6"	GALVANIZED				1	
285 101 00210	ELBOW, 48" R STL 90 DEG 6"	GALVANIZED					1
285 102 00140	COUPLING, PVC 6"	LONG LINK SCH 40	1	1	1	1	1

DnF: BELL FITTING, PVC

Item Code	Description 1	Description 2	D3F	D5F	D6F
285 103 00040	BELL FITTING, PVC 3"	SCH 40 & SCH 80	1		
285 103 00060	BELL FITTING, PVC 5"	SCH 40 & SCH 80		1	
285 103 00100	BELL FITTING, PVC 6"	SCH 40 & SCH 80			1

DnP: PLUG, PVC

Item Code	Description 1	Description 2	D3P	D5P	D6P
285 103 00030	PLUG, PVC 3"	WITH PULL TAB	1		
285 103 00070	PLUG, PVC 5"	WITH PULL TAB		1	
285 103 00090	PLUG, PVC 6"	WITH PULL TAB			1

NAPERVILLE PUBLIC UTILITIES DEPARTMENT ELECTRIC STANDARDS	SINGLE PHASE PADMOUNT TRANSFORMER ASSEMBLY	DATE: 01-16-06 Page 3 of 4 C30-0011
--	--	---

- NOTES:**
- CONTRACTOR IS ADVISED THIS SPECIFICATION SHOWS AN EXISTING TRANSFORMER AND VAULT INSTALLATION. THIS IS WHAT IS STANDARD SO WHEN CONTRACTOR HAS TO INSTALL DUCTS INTO AN EXISTING LOCATION. THE CONTRACTOR CAN PLAN THE WORK.
 - WHEN A VAULT IS TO BE INSTALLED THE CONTRACTOR SHALL INSTALL THE VAULT, GROUNDING, EXCAVATION, BACKFILL AND RESTORATION TO THE ELEVATION IN THE GENERAL SPECIFICATION.

TmUn: TRANSFORMER, PAD MOUNTED

Item Code	Description 1	Description 2	T24U							
QTY	7200	240/120	10	25	37	50	75	100	167	250
281 100 00120	1-PH LOOP TRANSFORMER	10kVA 7.2kV 120/240 V	1							
281 100 00130	1-PH LOOP TRANSFORMER	25kVA 7.2kV 120/240 V		1						
281 100 00140	1-PH LOOP TRANSFORMER	37.5kVA 7.2kV 120/240 V			1					
281 100 00150	1-PH LOOP TRANSFORMER	50kVA 7.2kV 120/240 V				1				
281 100 00160	1-PH LOOP TRANSFORMER	75kVA 7.2kV 120/240 V					1			
281 100 00170	1-PH LOOP TRANSFORMER	100kVA 7.2kV 120/240 V						1		
281 100 00180	1-PH LOOP TRANSFORMER	167kVA 7.2kV 120/240 V							1	
281 100 00190	1-PH LOOP TRANSFORMER	250kVA 7.2kV 120/240 V								1
284 199 00310	SIGN	8" X 5" WITH BRUSHES	1	1	1	1	1	1	1	1
286 199 00232	CONNECTOR, 1" STUD, 10-350	1PH TRF, 6 CONDUCTORS							1	1
286 199 00235	CONNECTOR, 5/8 STUD, 6-500	1PH TRF	1	1	1	1	1	1	1	1
287 103 00240	PADLOCK, BRONZE	W/1 1/2" SHACKLE	1	1	1	1	1	1	1	1

UGT1: GROUNDING, TRANSFORMER, 1φ

Item Code	Description 1	Description 2	UGT1	UGT3
280 107 00050	CU BARE SD	#4 7-STR	12	
280 107 00070	CU BARE SD	4/0 7-STR		75
283 156 00010	GROUND ROD, COPPER CLAD	5/8" X 10'	1	4
283 156 00020	CLAMP, GROUND ROD	5/8" ROD - #4 STR		
284 199 00180	CLAMP, TRANSF TANK GND.	#8 SOL - 2/0 STR CU	2	
284 199 00182	CLAMP, TRANSF TANK GND.	#6 SOL - 250MCM		2
284 100 00260	CONNECTOR, WEDGE CU	4/0 STR (7) - 4/0 STR (7)		2
286 100 00320	CONNECTOR, WEDGE CU	4/0 STR (7) - 3/8" ROD		4
286 101 00010	SHELL, WEDGE AMP	WHITE		6
286 199 00210	BREAK-AWAY	2 SOL - 2/0 STR X 2 SOL - 2/0 STR	2	
286 199 00220	BREAK-AWAY	1/0-4/0 STR X 1/0-4/0 STR		6

PROJECT TITLE ROUTE 59 ROAD IMPROVEMENTS			
PROJECT DESCRIPTION DETAILS AND STANDARDS			
ENGINEER BCC	DRAFTING DATE 5-11-12	MAP # 4211,4212,4223	SCALE N.T.S.
DESIGN BY DL	DRAWN BY PSM	REVISIONS DATE N/A	PROJECT # EU-12
CHECKED BY	APPROVED BY	CAD FILE 0060648001D135.DWG	SHEET # 35 OF 63
Naperville		Department of Public Utilities Electric Division	
		WORK REQUEST # 60468	

F.A.P. RTE.	SECTION	COUNTY	TOTAL SHEETS	SHEET NO.
338/IL 59	2011-035-1	DUPAGE		
FED.ROAD.DIST.NO.			CONTRACT 60P42	
ILLINOIS			FED. AID PROJECT	

1. SCOPE

This specification covers the manufacture and delivery of concrete pads and vaults for three phase transformers.

2. APPLICATION

The concrete pads and vaults are intended for an underground application as a base for three phase pad mounted distribution transformers, on a 60 Hertz electric system, up to and including 15kV power cables.

3. STANDARDS

The concrete pads and vaults shall be manufactured and tested according to the latest applicable standards of ACI, ASTM, AASHTO and other related specifications and standards.

4. TECHNICAL REQUIREMENTS

4.1 DESIGN

The concrete pads and vaults must meet or exceed the minimum requirements of the ACI Code, Section 318-89 and AASHTO requirement for an HS-20 loading. The pads and vaults should be designed and built according to ASTM C-858 and ASTM C-857 requirements. The pad must be poured separately from the vault so that it is removable.

4.2 MATERIAL

Concrete shall have a minimum strength of 4500 psi at 28 days. Reinforcing steel bars (#4) shall be epoxy coated according to ASTM A-615 grade 60 and ASTM A-775.

4.3 CONSTRUCTION

Pad and vault rebar are to be placed at 30 centimeters (12 inch) intervals, center to center, and be tied at points of crossing. Vault reinforcing is to be continuous in the four sides of the vault, overlap 30 centimeters (12 inches), and tied at rebar ends.

Pad and vault are to each have four lifting devices, which shall be verified for capacity and will have an adequate factor of safety for lifting and handling, taking into account the various forces acting on the device, including release, impact and various positions of pads and vaults during handling. Each vault is to have four knockout windows, 30 centimeters (12 inches) square and 4 centimeters (1-1/2 inch) thick as shown on the detail. In addition, a 1-1/2 inch pipe shall be placed in the front wall, as shown on the detail, to allow a grounding conductor to be extended to the outside of the vault.

A pulling iron is to be installed opposite each window (3 required). Each iron shall be galvanized or coated to provide 30 years service in a corrosive atmosphere and have an installed pulling strength of 1360 kilograms (3000 pounds) minimum.

Joint tape shall be 2.5 x 2.5 cm (1" x 1") Butyl Sealant as approved by the City.

Top edges of transformer pad must be tooled or chamfered to eliminate roughness. Tool or chamfer the bottom edges of the transformer pad opening to remove any rough edges.

Top edges of transformer pad must be tooled or chamfered to eliminate roughness. Tool or chamfer the bottom edges of the transformer pad opening to remove any rough edges.

4.4 DIMENSIONS

There are three different sizes for pads and vaults. The dimensions are shown on the attached detail sheet.

4.5 MARKING

The concrete pad and vault shall have a durable identification, showing the name or trademark of the manufacturer, size (identified by code ratings), date, and the words CITY OF NAPERVILLE - ELECTRIC embossed on the inside of each pad and vault respectively.


5. DELIVERY

Concrete products are to be stored at the manufacturer's site until needed.

The Department of Public Utilities-Electric will notify the manufacturer, when a contract is let, of anticipated demand and a tentative delivery schedule. The contractor will notify the manufacturer 48 hours before delivery. Vaults will be delivered to the site and off-loaded at specified locations. Should the excavation be prepared to accept the vault upon delivery, the contractor may be responsible for setting the vault in the excavation. The setting of the vault in the prepared excavation shall be considered incidental to the contract, and no additional compensation will be allowed.

Note: Manufacturer must address any deviation from these specifications at time of bid.

The Naperville Department of Public Utilities-Electric (DPU-E) shall be notified before manufacturing to allow for periodic inspections at the plant. Call (630) 548-2961 48 hours before manufacturing, to allow for scheduling said inspection.

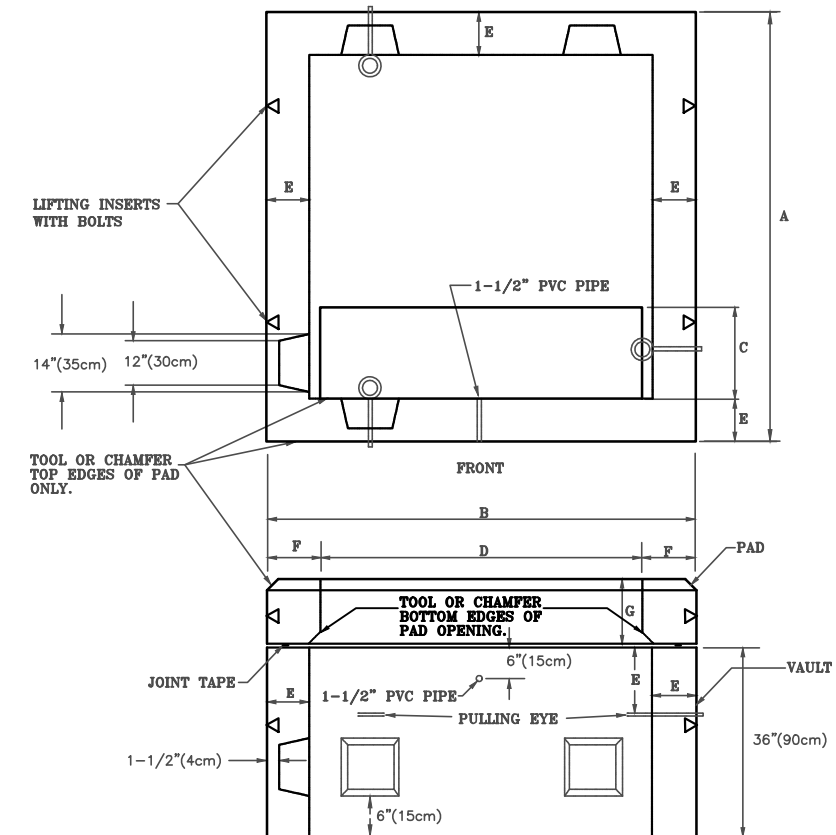

TRANSFORMER KVA	ASSEMBLY CODE	DIMENSIONS-CENTIMETERS(INCHES)							APPROXIMATE WEIGHT IN KILOGRAMS (POUNDS)		
		A	B	C	D	E	F	G	PAD	VAULT	TOTAL
75-150	DEVT 150	175(70)	175(70)	38(15)	115(46)	20(8)	30(12)	30(12)	1987(4380)	3007(6630)	4994(11010)


NAPERVILLE PUBLIC UTILITIES DEPARTMENT ELECTRIC STANDARDS	3Ø TRANSFORMER PAD AND VAULT	DATE: 03-24-10 Page 1 of 3 M30-1350
--	-------------------------------------	---

NAPERVILLE PUBLIC UTILITIES DEPARTMENT ELECTRIC STANDARDS	3Ø TRANSFORMER PAD AND VAULT	DATE: 03-24-10 Page 2 of 3 M30-1350
--	-------------------------------------	---

NAPERVILLE PUBLIC UTILITIES DEPARTMENT ELECTRIC STANDARDS	3Ø TRANSFORMER PAD AND VAULT	DATE: 03-24-10 Page 3 of 3 M30-1350
--	-------------------------------------	---

PROJECT TITLE						ROUTE 59 ROAD IMPROVEMENTS					
PROJECT DESCRIPTION						DETAILS AND STANDARDS					
ENGINEER	DRAFTING DATE	MAP #	SCALE								
BCC	5-11-12	4211,4212,4223	N.T.S.								
GIS DESIGN BY	DRAFTED BY	REVISIONS DATE	AT&T JOINT AGREEMENT #	PROJECT #							
DL	PSM		N/A	EU-12							
CHECKED BY	APPROVED BY	CAD FILE	SHEET #								
		0060648001D136.DWG	36 OF 63								
Naperville						Department of Public Utilities Electric Division					
						WORK REQUEST # 60468					

F.A.P. RTE.	SECTION	COUNTY	TOTAL SHEETS	SHEET NO.
338/IL 59	2011-035-1	DUPAGE		
		CONTRACT 60P42		
FED.ROAD.DIST.NO.	ILLINOIS	FED. AID PROJECT		

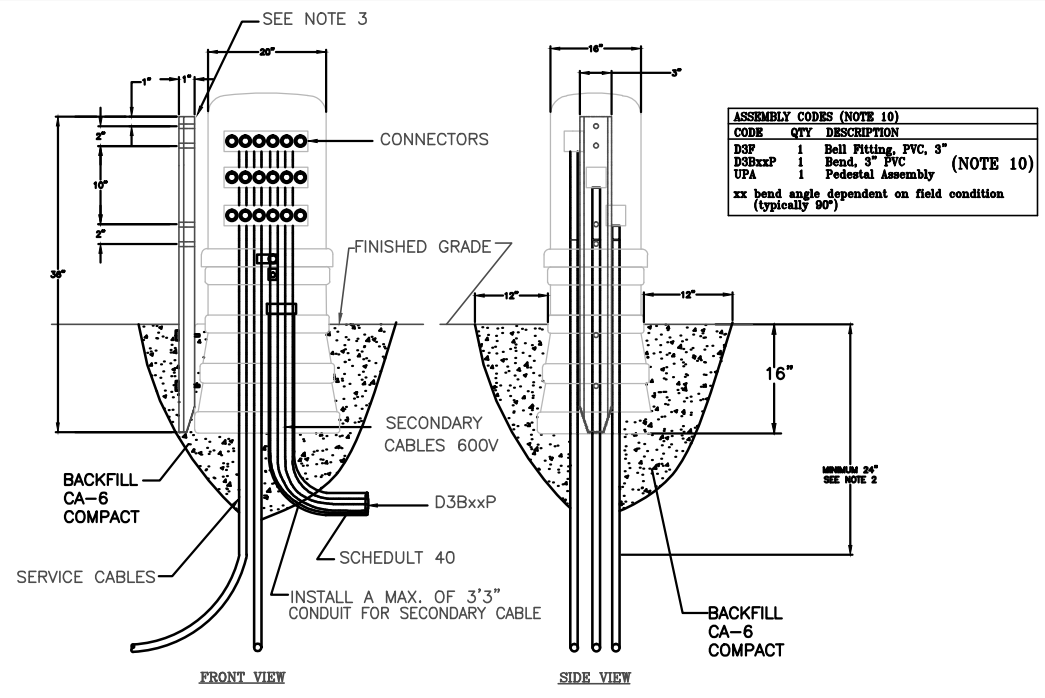

ASSEMBLY CODES (NOTE 10)		
CODE	QTY	DESCRIPTION
D3F	1	Bell Fitting, PVC, 3"
D3BxxP	1	Bend, 3" PVC (NOTE 10)
UPA	1	Pedestal Assembly

xx bend angle dependent on field condition (typically 90°)

DnBxxP: BEND, PVC

Assembly	Item Code	Description 1	Description 2	Qty
D3B30P	285 101 00025	ELBOW, PVC 30 DEG 3"	STANDARD RADIUS SCH 40	1
D3B45P	285 101 00030	ELBOW, 36"R PVC 45 DEG 3"	SCH 40	1
D3B90P	285 101 00040	ELBOW, 36"R PVC 90 DEG 3"	SCH 40	1
D5B30P	285 101 00080	ELBOW, 36"R PVC 30 DEG 5"	SCH 40	1
D5B45P	285 101 00090	ELBOW, 36"R PVC 45 DEG 5"	SCH 40	1
D5B90P	285 101 00100	ELBOW, 36"R PVC 90 DEG 5"	SCH 40	1
D6B30P	285 101 00220	ELBOW, 48"R PVC 30 DEG 6"	SCH 40	1
D6B45P	285 101 00230	ELBOW, 48"R PVC 45 DEG 6"	SCH 40	1
D6B90P	285 101 00240	ELBOW, 48"R PVC 90 DEG 6"	SCH 40	1

DnF: BELL FITTING, PVC

Item Code	Description 1	Description 2	D3F Qty	D5F Qty	D6F Qty
285 103 00040	BELL FITTING, PVC 3"	SCH 40 & SCH 80	1		
285 103 00080	BELL FITTING, PVC 5"	SCH 40 & SCH 80		1	
285 103 00100	BELL FITTING, PVC 6"	SCH 40 & SCH 80			1

UPA: PEDESTAL ASSEMBLY

Item Code	Description 1	Description 2	UP			
			A Qty	S6 Qty	C Qty	CC Qty
284 105 00010	PEDESTAL, SECONDARY UPRGT	HDPE RECT. 10"X14"X41"	1	1		
284 106 00040	CONNECTOR, 6 COND. 10-350	1 EA	3			1
284 106 00050	COVER, FOR 6 COND 10-350	EPDM	2			1

- NOTES:
- ALL CABLES MUST BE TAGGED TO PROVIDE POSITIVE IDENTIFICATION.
 - THE CABLE MUST BE PROTECTED BY THE FOOTPRINT OF THE PEDESTAL FOR A MINIMUM OF 24". IF AN EXCEPTION HAS TO BE MADE, THE CABLE MUST BE PROTECTED INSIDE OF CONDUIT.
 - SECONDARY PEDESTAL POST IS FOR JOINT LOCATIONS WITH AMERITECH ONLY.
 - BENDS SHALL BE INSTALLED PER FIELD CONDITION.
 - ALL CONDUIT SHALL BE PLUGGED.
 - THIS DRAWING SHOWS AN EXISTING PEDESTAL WITH CABLE INSTALLED WITH MATERIAL LIST ON RIGHT.
 - CONTRACTOR TO OBTAIN OUTAGE OF PEDESTAL PRIOR TO DOING ANY WORK.
 - CONTRACTOR TO INSTALL 3", 5" AND 6" CONDUIT INTO EXISTING OR NEW PEDESTAL AS SPECIFIED IN SPECIFICATIONS CAP AND PLUGS ALL CONDUITS.
 - ALL GROUNDING CONNECTIONS AND TERMINATORS SHALL BE INSPECTED TO DETERMINE CONDITION OF CONNECTIONS BY THE CONTRACTOR REPORT FINDING.
 - CONTRACTOR TO INSTALL PEDESTAL, EXCAVATION CONDUIT, CONDUIT BENDS AND FITINGS FOR A COMPLETE JOB.
 - GROUNDING BY OTHERS.

NAPERVILLE PUBLIC UTILITIES DEPARTMENT ELECTRIC STANDARDS	SECONDARY PEDESTAL WIDE BASE	DATE: 03-17-04 Page 1 of 2 C30-2020
--	-------------------------------------	---

NAPERVILLE PUBLIC UTILITIES DEPARTMENT ELECTRIC STANDARDS	SECONDARY PEDESTAL	DATE: 03-17-04 Page 2 of 2 C30-2020
--	---------------------------	---

1. SCOPE

This specification covers the manufacture and delivery of Large Radius Rigid Steel Conduit Galvanized Elbows.

2. STANDARDS

The steel elbows shall be manufactured and tested in accordance with the latest applicable standards of Underwriters Laboratory (UL 6), ANSI C80-1, and NEC 2002 - Article 344.

3. TECHNICAL REQUIREMENTS

3.1 Material

The elbows shall be manufactured from rigid galvanized steel conduit and conform to the most recent UL specifications.

3.2 Specifications

SIZE (INCHES)	RADIUS (INCHES)	DEGREES BEND	TANGENT (INCHES)*	NOM WT (LBS)	ARC LENGTH (INCHES)	MATERIAL ID
2"	36"	45°	11" ± 1	16	28.28"	N/A
2"	36"	90°	11" ± 1	18	56.57"	N/A
3"	15"	90°	9" ± 1/2	22	23.57"	285 101 00130
3"	30"	90°	11" ± 1	42	47.14"	285 101 00140
5"	36"	30°	11" ± 1	73	18.85"	285 101 00160
5"	36"	45°	11" ± 1	77	28.28"	285 101 00170
5"	36"	90°	11" ± 1	91	56.57"	285 101 00180
6"	48"	11°	12" ± 1	112	9.43"	285 101 00186
6"	48"	22.5°	12" ± 1	118	18.85"	285 101 00188
6"	48"	30°	12" ± 1	122	25.14"	285 101 00190
6"	48"	45°	12" ± 1	129	37.71"	285 101 00200
6"	48"	90°	12" ± 1	152	75.43"	285 101 00210

*Tangent length shall be the same on both ends of the elbow.

4. SHIPPING

4.1 Size

The rigid steel galvanized elbows shall be shipped in palletized cartons or on pallets. Pallets shall be non-returnable and any associated costs shall be included in the quoted price of the steel elbows. All galvanized items shall have a total skid weight of less than 3000 pounds. Each layer shall have at least three (3) 2" X 4"s as dividers for layer support and improved handling characteristics. The top layer shall be level dependent on the quantity ordered.

4.2 Capping

Plastic open-end thread protector caps to prevent the entrance of dirt and/or moisture shall be supplied to the open threaded ends of each rigid steel elbow.


NAPERVILLE PUBLIC UTILITIES DEPARTMENT ELECTRIC STANDARDS	LARGE RADIUS RIGID STEEL CONDUIT GALVANIZED ELBOWS	DATE: 01-16-05 Page 1 of 2 M30-1550
--	---	---

4.3 Identification

Rigid Steel Elbows shall have a durable label securely attached (or have a permanent stencil) on the elbows with the following information: Manufacturer's identification, radius, size, theoretic tangent length and degrees bend, P.O. number, shipping length of elbow, and year of manufacture.

5. DELIVERY

All pallets shall be shipped on a flat-bed trailer when the load requires. Pallets shall not be double stacked for shipment. There shall be no mixture of items on each pallet. The City shall be notified by telephone (630-420-6186) at least 24 hours prior to delivery of the pallets. Pallets shall be unloaded by the City between 8:00 a.m. and 3:30 p.m. on weekdays only, holidays excluded. Additional shipping costs resulting from failure to provide the 24 hour notice or from delivery of goods outside the specified times shall be paid by the vendor.

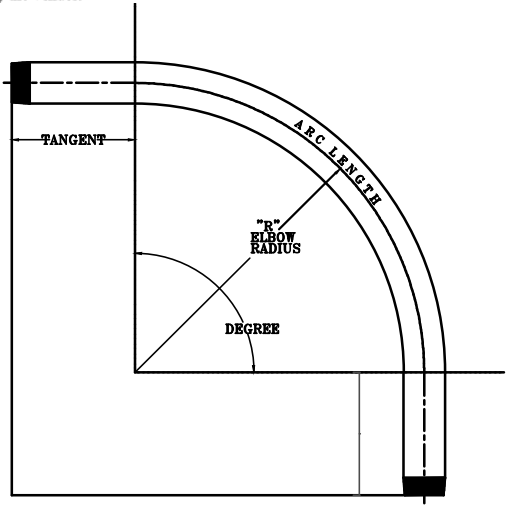

NAPERVILLE PUBLIC UTILITIES DEPARTMENT ELECTRIC STANDARDS	LARGE RADIUS RIGID STEEL CONDUIT GALVANIZED ELBOWS	DATE: 01-16-05 Page 2 of 2 M30-1550
--	---	---

PROJECT TITLE ROUTE 59 ROAD IMPROVEMENTS			
PROJECT DESCRIPTION DETAILS AND STANDARDS			
ENGINEER BCC	DRAFTING DATE 5-11-12	MAP # 4211,4212,4223	SCALE N.T.S.
GIS DESIGN BY DL	DRAFTED BY PSM	AT&T JOINT AGREEMENT # N/A	PROJECT # EU-12
CHECKED BY	APPROVED BY	CAD FILE 0060648001D137.DWG	SHEET # 37 OF 63
Naperville		Department of Public Utilities Electric Division	
			WORK REQUEST # 60468

F.A.P. RTE.	SECTION	COUNTY	TOTAL SHEETS	SHEET NO.
338/IL 59	2011-035-1	DUPAGE		
			CONTRACT 60P42	
FED.ROAD.DIST.NO.		ILLINOIS	FED. AID PROJECT	

I. GENERAL

- A. THIS SPECIFICATION COVERS THE SODDING AND SEEDING THAT ARE APPLICABLE TO ALL CITY PROPERTIES.
- B. ALL CONTRACTOR'S OPERATIONS ON CITY PROPERTIES SHALL MEET THE APPROVAL OF AND SHALL BE DONE TO THE SATISFACTION OF THE GENERAL SUPERINTENDENT OF THE CITY OR HIS AUTHORIZED REPRESENTATIVE.
- C. THE CONTRACTOR SHALL DEPOSIT WITH THE CITY A CERTIFIED OR CASHIER'S CHECK IN AN AMOUNT AS SPECIFIED IN "SPECIAL INSTRUCTIONS" OF THE "GENERAL SPECIFICATION AND INSTRUCTIONS TO BIDDERS". THE CONTRACTOR SHALL ALSO FURNISH THE CITY WITH A CERTIFICATE OF INSURANCE, PUBLIC LIABILITY AND PROPERTY DAMAGE. IN THE EVENT THE INSURANCE IS DEEMED UNSATISFACTORY BY THE CITY, THE CONTRACTOR SHALL, UPON REQUEST, FURNISH THE CITY WITH A SURETY BOND IN AN AMOUNT AS SPECIFIED IN THE SPECIFICATION "SPECIAL INSTRUCTIONS" OF THE "GENERAL SPECIFICATION".
- D. ALL WORK SHALL BE PAID FOR WORK, IN PLACE. ALL MEASUREMENT MADE BY THE CITY OF NAPERVILLE WITH ASSISTANCE OF THE CONTRACTOR OR NO ASSISTANCE IS FINAL.

II. NOTIFICATION

THE CONTRACTOR SHALL GIVE THE CITY 72 HOURS PRIOR NOTICE, EXCLUSIVE OF SATURDAYS, SUNDAYS OR LEGAL HOLIDAYS, BEFORE STARTING WORK OR ANY OPERATIONS ON THE CITY'S PROPERTY.

III. TREE REMOVAL AND PROTECTION

- A. ONLY TREES AND/OR OTHER PLANTINGS MARKED WITH PAINT SHALL BE REMOVED OR TRIMMED. ALL OTHER TREES OR PLANTINGS WITHIN THE WORK AREA ARE TO BE PROTECTED BY WOOD CRIBBING. ALL OTHER WORK REQUIRED SHALL BE DIRECTED BY THE PROJECT ENGINEER.

IV. SODDING

- B. ALL CONSTRUCTION STORAGE OF EQUIPMENT AND MATERIALS SHALL BE CONFINED TO THE RIGHT-OF-WAY OR SET ASIDE AREA PROVIDED BY THE CONTRACTOR OFF SITE AND SUBJECT TO THE APPROVAL OF THE GENERAL SUPERINTENDENT OF THE CITY OR HIS AUTHORIZED REPRESENTATIVE. ALL CONSTRUCTIONS ACTIVITIES SHALL BE CONFIRMED TO THE RIGHT-OF-WAY.
- C. ALL SURPLUS EXCAVATED MATERIALS SHALL BE DISPOSED OF OFF THE CITY'S PROPERTY. ALL TREES, STUMPS AND OTHER DEBRIS RESULTING FROM CONSTRUCTION OPERATIONS SHALL BE DISPOSED OF OFF THE CITY'S PROPERTY.
- D. IMMEDIATELY AFTER CONSTRUCTION OPERATIONS HAVE BEEN COMPLETED, ALL AREAS DISTURBED BY CONSTRUCTION OPERATIONS SHALL BE GRADED AS NEARLY AS POSSIBLE TO THEIR ORIGINAL CONTOURS EXCEPT AREAS OF EXCAVATION WHICH SHALL BE NEATLY CROWNED OVER TO ALLOW FOR SETTLEMENT.
- E. THE CONTRACTOR SHALL RETAIN A LICENSED LANDSCAPE CONTRACTOR APPROVED BY THE CITY TO PERFORM ALL THE FINAL TOPSOILING, FINE GRADING AND SEEDING OR SODDING WORK IN ACCORDANCE WITH PARAGRAPH F AND G BELOW. THE SEEDING OR SODDING SHALL BE DONE UNDER THE SUPERVISION OF THE CITY IN THE PROPER SEASON FOR SUCH WORK AND SHALL BE AT NO COST TO THE CITY.
- F. THE GRASS AREAS DISTURBED DURING CONSTRUCTION SHALL BE RESTORED WITH SOD AND 6 INCHES OF BLACK PULVERIZED DIRT, AREA PREPARED, EXISTING DIRT AND GRASS DEBRIS REMOVED AND DISPOSED OF OFF SITE, MADE LEVEL AND GRADED, ALL AREAS SHALL PROMOTE DRAINAGE, ALL EXCAVATED MATERIALS AND EXISTING GRASS AND LANDSCAPING SHALL REMOVED AND UNACCEPTABLE FILL REMOVED AND DEPOSITED OFF SITE.
- G. ALL GRASS WORK AREA'S SHOWN ON THE CONSTRUCTION DRAWINGS PLUS ALL OTHER AREAS DISTURBED DURING CONSTRUCTION SHALL BE RESTORED BY THE CONTRACTOR AND IS INCIDENTAL TO THE WORK. THE CONTRACTOR IS ADVISED SOME OF THE WORK AREAS ARE BETWEEN ROAD WAY PROPERTY LINES AND WITHIN THE ROAD AREA AS SHOWN ON COUNTY DRAWINGS SHALL BE DONE TO THE DUPAGE COUNTY DEPARTMENT OF TRANSPORTATION, SATISFACTION THE ELECTRICAL CONTRACTOR IS RESPONSIBLE FOR SURFACE RESTORATION, FOR ALL AREA'S INSIDE/OUTSIDE THE ROAD AREA'S. THE CONTRACTOR SHALL REVIEW ALL DRAWING PREPARED TO DETERMINE THE EXACT LIMITS OF THE ROADWAY TO DETERMINE THE RESTORATION AREA'S, WHICH IS THEREFORE THE CONTRACTOR'S RESPONSIBILITY. THE CONTRACTOR SHALL NOT BE GIVEN ANY CONSIDERATION BY THE OWNER FOR ANY CLAIM ARISING OUT OF A LACK OF UNDERSTANDING, INTENT, OR INTERPRETATION NOT CONSIDER WITH DRAWINGS OF THE ROAD AS APPLIED TO SURFACE RESTORATION.

ALL GRASS AREAS SHALL BE RESTORED WITH A MINIMUM 6 INCH LAYER OF DELIVERED SCREENED RICK DARK PULVERIZED TOP SOIL. TOP SOIL SHALL NOT BE PULVERIZED ON THE JOB SITE PRIOR TO THE APPLICATION OF THE TOP SOIL. ALL EXCAVATIONS SHALL BE PROPERLY BACKFILLED AND COMPACTED SO AS MINIMIZE FUTURE SETTLEMENT. TOP SOIL SHALL BE FREE FROM ROOTS STICKS, WEEDS, BRUSH, STONES, OR OTHER LITTER, WASTE PRODUCTS OR VISIBLE ORGANIC MATERIALS SUCH AS WOOD. IT SHALL BE A LOAMY MIXTURE HAVING AT LEAST 90 PERCENT PASSING THE NUMBER 10 SIEVE.

IV. SODDING (CONTINUED)

- H. A SAMPLE, FREE FROM EXTRANEIOUS MATERIALS, SHALL COMPLY WITH FOLLOWING REQUIREMENTS.
IT SHALL CONTAIN NOT LESS THEN 1 PERCENT NOR MORE THAN 10 PERCENT ORGANIC MATTER AS DETERMINED BY THE TEST FOR ORGANIC MATTER IN ACCORDANCE WITH AASHTO T 194.
IT SHALL CONTAIN NOT LESS THAN 12 PERCENT NOT MORE THAN 50 PERCENT CLAY AS DETERMINED IN ACCORDANCE WITH AASHTO 88.
THE SAND CONTENT SHALL NOT EXCEED 55 PERCENT AS DETERMINED IN ACCORDANCE WITH AASHTO T 88.
- I. THE PH OF THE SAMPLE SHALL NOT BE LOWER THAN 5.0 OR HIGHER THAN 8.0. THE PH SHALL BE DETERMINED WITH AN ACCEPTABLE PH METER, IN THAT PORTION OF THE SAMPLE PASSING THE NUMBER 10 SIEVE, IN ACCORDANCE WITH THE SUGGESTED METHODS OF TEST FOR HYDROGEN ION CONCENTRATION (PH) OF SOILS INCLUDED IN THE PROCEDURES FOR TESTING SOILS ISSUED DECEMBER 1964 BY THE AMERICAN SOCIETY FOR TESTING AND MATERIALS.
- J. FERTILIZER SHALL BE A COMPLETE FERTILIZER, PART OF THE ELEMENTS OF WHICH IS DERIVED FROM ORGANIC SOURCES. IT SHALL CONTAIN A MINIMUM OF 5 PERCENT NITROGEN, 10 PERCENT PHOSPHORUS AND 5 PERCENT POTASH BY WEIGHT.
- K. SOD SHALL BE GOOD QUALITY KENTUCKY BLUE GRASS (POA PRATENSIS). SODDING SHALL BE DONE IN ACCORDANCE SECTION 252 (SODDING) OF THE LATEST REVISION OF THE STANDARD SPECIFICATION FOR ROAD AND BRIDGE CONSTRUCTION, ILLINOIS DEPARTMENT OF TRANSPORTATION. THE SOD SHALL BE SALT TOLERANT. THE SOD SHALL BE STAKED TO MAINTAIN POSITION ON THE GROUND DUE TO A SLOPE OR A POSSIBLE TURNOFF.
- L. THE SOD SHALL BE STAKED ON ALL SLOPES OF 1:4 (V:H) OR STEEPER. SOD SHALL BE STAKED WITH NOT LESS THAN 4 STAKED PER SQUARE YARD, WITH A MINIMUM OF ONE STAKE FOR EACH PIECE OF SOD, MOWING STAKES SHALL BE INSTALLED SO THEY HOLD THE SOD FIRMLY AND PRESENT NO DANGER TO PEDESTRIAN OR MOWING CREWS.
- M. WITHIN 2 HOURS AFTER THE SOD HAS BEEN PLACED, 5 GALLONS OF WATER PER SQUARE YARD SHALL BE APPLIED. ANOTHER WATERING WITHIN 3 DAYS OF THE PLACEMENT SHALL BE APPLIED (5 GAL/S.Y.), THEN ONE MORE WATERING WITHIN 5 DAYS OF THE LAST AT THE SAME 5 GAL/S.Y. RATE. HOWEVER, IN THE ABSENCE OF 1 INCH OF RAIN PER WEEK, SODDED AREAS SHALL BE WATERED A MINIMUM OF 3 TIMES A WEEK WITH 5 GALLONS OF WATER PER SQUARE YARD APPLIED FOR NOT LESS THAN 6 WEEKS USING CONTRACTORS SUPPLIED WATER AND AS CALLED FOR IN ACCORDANCE WITH SECTION 250 AND SECTION 252 OF THE STANDARD SPECIFICATIONS FOR ROAD AND BRIDGE CONSTRUCTION OF THE LATEST REVISION, ILLINOIS OF TRANSPORTATION. ALL WATERING SHALL START THE DAY THE SOD IS FIRST PUT DOWN. ALL WATER USED SHALL BE CONTRACTOR SUPPLIED WATER. A FAILURE TO WATER THE SOD MAY RESULT IN THE CITY OF NAPERVILLE REJECTING ALL RESTORATION WORK PERFORMED. CITY OF NAPERVILLE SHALL REQUIRE ALL SOD IN AN AREA REMOVED, RE-PREP THE AREA, AND INSTALL NEW SOD.
- N. THE CONTRACTOR AT HIS EXPENSE SHALL DISPOSE OF SURPLUS MATERIALS AND WASTE ITEMS.
- O. SODDING SHALL BE MEASURED BY THE SQUARE YARD. ALL TURFED AREAS RESTORED WITH SOD WITHIN THE LIMITS OF RESTORATION WILL BE ELIGIBLE FOR PAYMENT. AREAS BEYOND THE PUBLIC RIGHT-OF-WAY OR THE EASEMENT AREAS SHOWN THAT ARE DISTURBED BY THE CONTRACTOR'S ACTIVITIES SHALL BE RESTORED TO EQUAL OR BETTER CONDITION BY THE CONTRACTOR AT THE CONTRACTOR'S EXPENSE. IN NO CASE SHALL THE PAY LIMITS FOR RESTORATION EXTEND BEYOND 20 FEET TOTAL WIDTH/RADIUS FROM THE CENTER OF THE PROPOSED WORK LOCATION BEING CONSTRUCTED OR A 20 FEET WIDTH FOR A TRENCH LENGTH.
- P. CONTRACTOR IS ADVISED SODDING INSTALLATION, REMOVAL AND REPLACEMENT IS INCLUDED IN THE APPROPRIATE UNIT PRICING FOR FOUNDATIONS, POLE ERECTION, CONDUIT WORK, MANHOLE WORK AND VAULT WORK OR AS SPECIFIED.
- Q. ALL VANDALISM, RUTS, OR DAMAGE OF ANY KIND SHALL BE CAUSE FOR REPLACEMENT AT CONTRACTOR'S COST.
- R. PAYMENT FOR SODDING SHALL BE MADE AT THE CONTRACT UNIT PRICE BID PER SQUARE YARD FOR SALT TOLERANT SODDING. PAYMENT SHALL BE FULL COMPENSATION FOR ALL MATERIALS, LABOR, EQUIPMENT AND INCIDENTALS TO COMPLETE THE ITEM AS SHOWN ON THE PLANS AND AS SPECIFIED. FERTILIZING AND INITIAL WATERING SHALL BE CONSIDERED INCIDENTAL TO THE CONTRACT UNIT PRICE FOR SODDING.
- S. THE SODDING AND RESTORATION WORK SHALL CARRY A 1 YEAR 6 MONTHS GUARANTEE FROM THE DATE OF FINAL PAYMENT AND IS INCLUDE IN THE PRICING FOR THIS ITEM.

V. SEEDING

- A. THE WORK SHALL INCLUDE THE SEEDING AND FERTILIZING OF ALL DISTURBED AREAS ALONG THE PROPOSED IMPROVEMENTS AS DIRECTED BY THE ENGINEER.
- B. SEEDING AND FERTILIZING MATERIALS SHALL BE IN ACCORDANCE WITH SECTION 250 OF THE STANDARD SPECIFICATIONS. SEED SHALL BE CLASS 1A, SALT TOLERANT LAWN MIXTURE.
- C. CONTRACTOR SHALL REMOVE ALL UNSUITABLE MATERIALS, DEBRIS AND RUBBISH RESULTING FROM CONSTRUCTION OPERATIONS, AND AN STONES OR BOULDERS LARGER THAN 1 INCH SHALL BE REMOVED FROM THE SITE.
- D. THE GROUND SHALL BE PREPARED PRIOR, BUT NOT IN EXCESS OF 24 HOURS BEFORE THE SEED IS PLACED. THE SOIL SHALL BE WORKED UNTIL IT IS RELATIVELY FREE FROM DEBRIS, WASHES, GULLIES, CLODS AND STONES. THE SURFACE SHALL BE WORKED TO A DEPTH OF NOT LESS THAN 3 INCHES, WITH A DISK, TILLER, OR THEIR EQUIPMENT APPROVED BY THE ENGINEER. PREPARED SURFACES THAT BECOME CRUSTED SHALL BE REWORKED TO AN ACCEPTABLE CONDITION FOR SEEDING AND A MINIMUM 6 INCHES OF PULVERIZED TOP SOIL SHALL BE PLACED OVER ALL DISTRIBUTED AREAS. ALL SOIL SURFACES SHALL BE MOIST WHEN THE SEED IS APPLIED. AREAS SHOWN TO BE AGRICULTURE IN NATURE SHALL BE RESTORED WITH AN EQUAL DEPTH OF TOP SOIL. SEEDED AREAS SHALL BE COVERED IMMEDIATELY AN EXCELSIOR BLANKET IS INCLUDED IN THIS WORK.
- E. FERTILIZER SHALL BE APPLIED AT THE FOLLOWING RATES:
NITROGEN FERTILIZER NUTRIENTS 90 LBS/ACRE.
PHOSPHORUS FERTILIZER NUTRIENTS 54 LBS/ACRE.
POTASSIUM FERTILIZER NUTRIENTS 36 LBS/ACRE.
- F. HYDRO SEEDED WITH APPROVED GRASS SEED AT A RATE OF 175 POUNDS PER ACRE AND MULCHED AS DIRECTED BY THE CITY OF NAPERVILLE. THE CONTRACTOR SHALL FURNISH APPROVED TOP SOIL TO INSURE A 6 INCH COVERAGE OVER THE AREA TO SEEDED AND WATERED. THE SEED IS TO BE MIXED IN THE FOLLOWING PROPERTIES.
40 LBS. KENTUCKY BLUE GRASS PLUS FERTILIZER PER IDOT REQUIREMENTS.
40 LBS. ALTA FESCUE GRASS.
20 LBS. PERENNIAL RYE GRASS.
- G. AREAS BEYOND THE PUBLIC RIGHT-OF-WAY OR THE EASEMENT AREAS SHOWN THAT ARE DISTURBED BY THE CONTRACTOR'S ACTIVITIES SHALL BE RESTORED TO EQUAL OR BETTER CONDITION BY THE CONTRACTOR AT THE CONTRACTOR'S EXPENSE. IN NO CASE SHALL THE PAY LIMITS FOR RESTORATION EXTEND BEYOND 20 FEET TOTAL WIDTH/RADIUS FROM THE CENTER OF THE PROPOSED UTILITY BEING CONSTRUCTED OR A 20 FEET WIDTH FOR A TRENCH LENGTH.
- H. ALL SEEDED AREAS SHALL BE MOWED 4 TIMES TO A HEIGHT OF 3 INCHES. THE CUT MATERIAL SHALL NOT BE WIND ROWED OR LEFT IN A LUMPY CONDITION BY EVENLY DISTRIBUTED. AREAS BEYOND THE WORK AREA LIMITS SHOWN ON THE PLAN SHALL BE RESTORED TO BETTER OR EQUAL CONDITIONS AT THE CONTRACTOR'S EXPENSE.
- I. WITHIN 2 HOURS AFTER THE SEED HAS BEEN PLACED, 3 GALLONS OF WATER PER SQUARE YARD SHALL BE APPLIED. ANOTHER WATERING WITHIN 3 DAYS OF THE PLACEMENT SHALL BE APPLIED (3 GAL/S.Y.), THEN ONE MORE WATERING WITHIN 5 DAYS OF THE LAST AT THE SAME 3 GAL/S.Y. RATE. HOWEVER, IN THE ABSENCE OF 1 INCH OF RAIN PER WEEK, SEEDED AREAS SHALL BE WATERED A MINIMUM OF 3 TIMES A WEEK, WITH 3 GALLONS OF WATER PER SQUARE YARD APPLIED FOR NOT LESS THAN 6 WEEKS USING CONTRACTORS SUPPLIED WATER AND AS CALLED FOR IN ACCORDANCE WITH SECTION 250 AND SECTION 252 OF THE STANDARD SPECIFICATIONS FOR ROAD AND BRIDGE CONSTRUCTION OF THE LATEST REVISION, ILLINOIS DEPARTMENT OF TRANSPORTATION. ALL WATERING SHALL START THE DAY THE SEED IS FIRST PUT DOWN. ALL WATER USED SHALL BE CONTRACTOR SUPPLIED WATER. A FAILURE TO WATER THE SEED MAY RESULT IN THE CITY OF NAPERVILLE REJECTING ALL RESTORATION WORK PERFORMED. CITY OF NAPERVILLE SHALL REQUIRE ALL SEEDED AREAS REMOVED, RE-PREP THE AREA, AND INSTALL NEW SEED.
- J. THIS WORK INCLUDES ALL SEED, FERTILIZER, WATERING, OTHER MATERIALS, LABOR EQUIPMENT AND INCIDENTALS TO COMPLETE THE JOB OR AS DIRECTED BY THE ENGINEER ON A UNIT OF PER ACRE.
- K. THE SEEDING AND RESTORATION WORK SHALL CARRY A 1 YEAR 6 MONTHS GUARANTEE FROM THE DATE OF FINAL PAYMENT (RECEIPT OF AS BUILTS) AND IS INCLUDED IN PRICING FOR THIS ITEM.
- L. CONTRACTOR IS ADVISED SEEDING INSTALLATION, REMOVAL AND REPLACEMENT IS INCLUDED IN THE APPROPRIATE UNIT PRICING FOR FOUNDATIONS, POLE ERECTION, CONDUIT WORK, MANHOLE WORK AND VAULT WORK OR AS SPECIFIED.
- M. ALL VANDALISM, RUTS, OR DAMAGE OF ANY KIND SHALL BE CAUSE FOR REPLACEMENT AT CONTRACTOR'S COST.
- N. PAYMENT FOR SEEDING SHALL BE MADE AT THE CONTRACT UNIT PRICE BID PER ACRE FOR SEEDING. PAYMENT SHALL BE FULL COMPENSATION FOR ALL MATERIALS, LABOR, EQUIPMENT AND INCIDENTALS TO COMPLETE THE ITEM AS SHOWN ON THE PLANS AND AS SPECIFIED. FERTILIZING AND INITIAL WATERING SHALL BE CONSIDERED INCIDENTAL TO THE CONTRACT UNIT PRICE FOR SEEDING.

NAPERVILLE PUBLIC UTILITIES DEPARTMENT	SODDING AND SEEDING WORK ON CITY PROPERTY OVERHEAD OR UNDERGROUND CONSTRUCTION (CONSTRUCTION SPECIFICATION)	DATE: 06-01-05 Page 1 of 3 60468-200
--	---	--


NAPERVILLE PUBLIC UTILITIES DEPARTMENT	SODDING AND SEEDING WORK ON CITY PROPERTY OVERHEAD OR UNDERGROUND CONSTRUCTION (CONSTRUCTION SPECIFICATION)	DATE: 06-01-05 Page 2 of 3 60468-200
--	---	--

NAPERVILLE PUBLIC UTILITIES DEPARTMENT	SODDING AND SEEDING WORK ON CITY PROPERTY OVERHEAD OR UNDERGROUND CONSTRUCTION (CONSTRUCTION SPECIFICATION)	DATE: 06-01-05 Page 3 of 3 60468-200
--	---	--

PROJECT TITLE						ROUTE 59 ROAD IMPROVEMENTS											
PROJECT DESCRIPTION												DETAILS AND STANDARDS					
ENGINEER	BCC	DRAFTING DATE	5-11-12	MAP #	4211,4212,4223	SCALE	N.T.S.										
DESIGN BY	DL	DRAFTED BY	PSM	REVISIONS DATE	N/A	PROJECT #	EU-12										
CHECKED BY		APPROVED BY		CAD FILE	0060648001D138.DWG	SHEET #	38 OF 63										
Naperville						Department of Public Utilities Electric Division						WORK REQUEST #	60468				

F.A.P. RTE.	SECTION	COUNTY	TOTAL SHEETS	SHEET NO.
338/IL 59	2011-035-1	DUPAGE		
FED.ROAD.DIST.NO.			CONTRACT 60P42	
ILLINOIS			FED. AID PROJECT	

TREE PROTECTION DETAIL

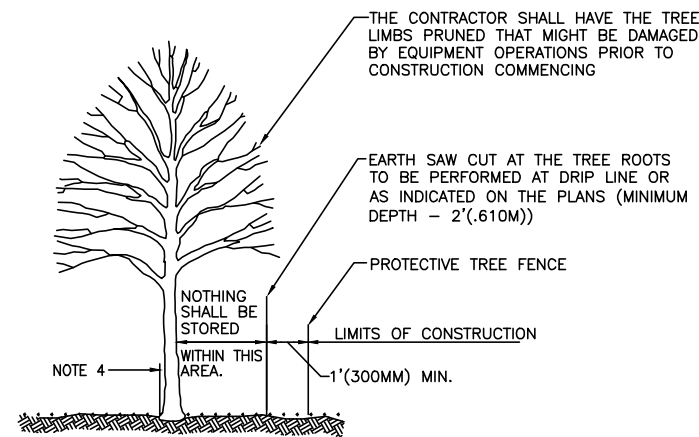


NOTE:

1. IF A UTILITY MUST BE WITHIN 15 FEET OF A TREE TRUNK, IT IS RECOMMENDED THAT IT BE AUGERED.
2. ALL TREES PROTECTED SHALL BE DEEP ROOT FERTILIZED.
3. ALL TREES SHALL BE WATERED.
4. PROTECT TREES WITH PLANKS FOR 10' ABOVE GROUND AND COMPLETELY AROUND TREE.
5. ALL MATERIALS SUPPLIED BY CONTRACTOR.

NAPERVILLE PUBLIC UTILITIES DEPARTMENT ELECTRIC STANDARDS	TREE PROTECTION DETAIL	DATE: 05-01-06 Page 1 of 1 60468-300
---	-------------------------------	--


RECOMMENDED PRACTICES FOR TREES TO BE SAVED

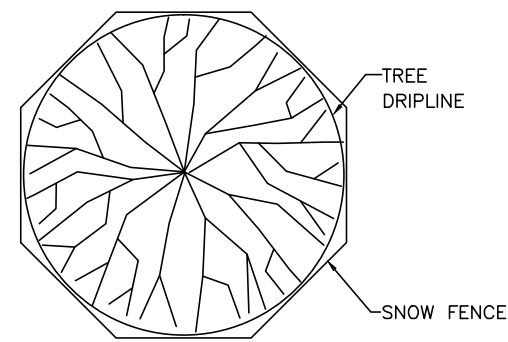

1. SNOW FENCE SHALL EXTEND TO THE DRIPLINE OF THE TREE. THE SNOW FENCE SHALL BE HIGH ENOUGH SO AS TO BE VISIBLE TO ALL CONSTRUCTION PERSONNEL.
2. GRADE CHANGES, UTILITY TRENCHES, STORAGE OF CONSTRUCTION MATERIAL, DUMPING OF WASTE OR STORAGE OF CONSTRUCTION EQUIPMENT SHALL NOT BE ALLOWED WITHIN SNOW FENCING.
3. IF A UTILITY MUST BE WITHIN 15'(4.57M) OF A TREE TRUNK, IT IS RECOMMENDED THAT IT BE AUGERED.
4. ALL TREES TO BE SAVED WHICH HAVE BEEN SUBJECTED TO CONSTRUCTION ACTIVITY WITHIN THE DRIPLINE SHOULD BE SELECTIVELY THINNED 10% BY AN ARBORIST SKILLED AT THE SELECTIVE THINNING PROCEDURE. NONE OF THE TREES SHALL BE TOPPED, HEADED BACK, SKINNED (REMOVAL OF THE INTERIOR BRANCHES), OR CLIMBED WITH SPIKES. ALL DEAD WOOD SHOULD BE REMOVED TO AVOID HAZARD.
5. IT IS RECOMMENDED THAT FOLLOWING CONSTRUCTION, TREES BE MAINTAINED IN THEIR NATIVE CONDITION. NO LAWN SHOULD BE PLACED AROUND THE TREES. IT IS RECOMMENDED THAT THE AREA BE MULCHED WITH 2"(50MM) OF DECOMPOSED LEAVES AND 2"(50MM) OF WOOD CHIPS OR BARK.
6. ALL TREES PROTECTED SHALL BE DEEP ROOT FERTILIZED.
7. ALL TREES SHALL BE WATERED.
8. ALL MATERIALS SUPPLIED BY CONTRACTOR.


NAPERVILLE PUBLIC UTILITIES DEPARTMENT ELECTRIC STANDARDS	RECOMMENDED PRACTICES FOR TREES TO BE SAVED	DATE: 05-01-06 Page 1 of 1 60468-310
---	--	--

TYPICAL CONDUIT CONNECTIONS ENTERING MANHOLE, HANDHOLE AND VAULTS WHEN HDPE CONDUIT IS USED

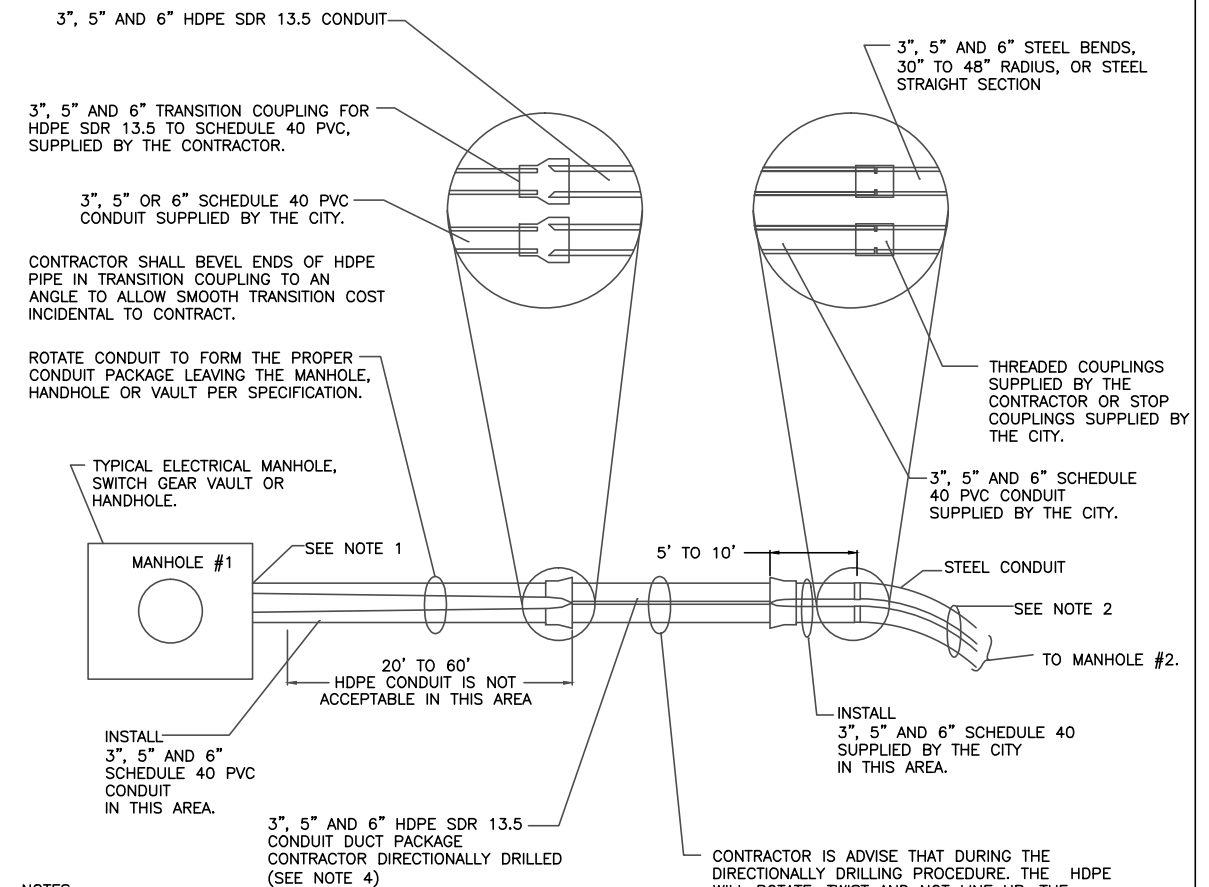

NOTES:

1. SEE SPECIFICATION FOR PROPER DUCT ALIGNMENT INTO MANHOLE
2. SEE SPECIFICATION FOR PROPER DUCT ALIGNMENT ON THE OTHER END OF DUCT RUN THE NUMBERED DUCTS SHOULD BE IN THE SAME LOCATION ON BOTH ENDS (SEE SAMPLE AT LOWER RIGHT).
3. COST TO PROPERLY INSTALL CONDUIT FROM ONE ELECTRICAL FACILITY TO ANOTHER IS INCIDENTAL TO THE COST OF THE WORK.
4. DUCT PACKAGE CAN BE ANY NUMBER OF DUCTS, FROM 2 DUCTS TO 18 DUCTS.
5. COST OF ALIGNING DUCTS ARE INCIDENTAL TO THE CONTRACT.

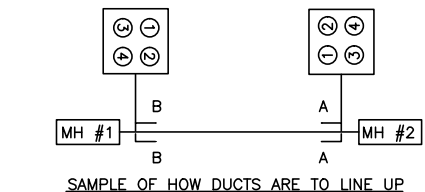

NAPERVILLE PUBLIC UTILITIES DEPARTMENT ELECTRIC STANDARDS	TYPICAL CONDUIT CONNECTIONS	DATE: 01-06-08 60468-320
---	------------------------------------	-----------------------------

PROJECT TITLE			
ROUTE 59 ROAD IMPROVEMENTS			
PROJECT DESCRIPTION			
DETAILS AND STANDARDS			
ENGINEER	DRAFTING DATE	MAP #	SCALE
BCC	5-11-12	4211,4212,4223	N.T.S.
GIS DESIGN BY	DRAFTED BY	AT&T JOINT AGREEMENT #	PROJECT #
DL	PSM	N/A	EU-12
CHECKED BY	APPROVED BY	CAD FILE	SHEET #
		0060648001D139.DWG	39 OF 63
Naperville Department of Public Utilities Electric Division			WORK REQUEST #
			60468

F.A.P. RTE.	SECTION	COUNTY	TOTAL SHEETS	SHEET NO.
338/IL 59	2011-035-1	DUPAGE		
			CONTRACT 60P42	
FED.ROAD.DIST.NO.	ILLINOIS	FED. AID PROJECT		

PART 1: GENERAL SPECIFICATIONS

1.01 Work included

- A. Work shall consist of furnishing and construction a Rockwood Classic 8TM unit segmental retaining wall in accordance with these specifications to the lines and grades shown on the construction plans and drawings. Alternate wall systems will not be considered.
- B. Work includes preparing foundation soil, furnishing and installing leveling pad, unit drainage fill, and backfill to the lines and grades shown on the construction plans and drawings.
- C. Work includes furnishing and installing geogrid soil reinforcement of the type, size, location and lengths as designated on the construction drawings.
- D. Includes design work with calculations and stamped by a registered/licensed professional engineer.
- E. Work includes the services of a professional surveyor to layout the plan, check elevation, plumb ness, and dimensions are followed and prepare a site plan, grades, elevations and proper drainage is maintained.
- F. Work includes all backfilling, grading, grubbing, clearing, and disposal of all materials and excavating materials off site, plus restoration with sod and seed.
- G. Work includes all materials, transportation, tools, equipment, labor, consumables, and traffic control for a complete job.

1.02 Related Sections

- A. See general condition or special condition for additional requirements of the contract
- B. See contract, plans and drawings for locations and dimensions of segmental concrete block wall systems requirements.

1.03 Reference Documents

- A. American Society for Testing and Materials (ASTM)
 1. ASTM C1372 Standard Specification for Segmental Retaining Wall Units
 2. ASTM C 140 Sampling and Testing Concrete Masonry Units
 3. ASTM D 422 Particle Size Analysis
 4. ASTM D 698 Laboratory Compaction Characteristics of Soil-Standard Effort
 5. ASTM D 4318 Liquid Limit, Plastic Limit and Plasticity Index of Soils
 6. ASTM D 4595 Tensile Properties of Geotextiles-Wide Width Strip
 7. ASTM D 5262 Unconfined Tension Creep Behavior of Geosynthetics
 8. ASTM D 3034 Polyvinyl Chloride Pipe (PVC)
 9. ASTM D 1248 Corrugated Plastic Pipe
 10. ASTM D 1262 Freeze-Thaw Durability of Concrete Units
 11. ASTM D 6638 Determining Connection Strength between Geogrid and Segmental Unit
- B. Geosynthetic Research Institute (GRI)
 1. GRI-GG4 Determination of Long Term Design Strength of Geogrid
 2. GRI-GG5 Determination of Geogrid (soil) Pullout
- C. National Concrete Masonry Association (NCMA)
 1. NCMA SRWU-2 Test Method for Determining Shear Strength of SRW

1.04 Submittals/Certification

- A. Prior to the start of work, the Contractor shall prepare construction drawings and design calculations. All calculations and design drawings shall be stamped by a Professional Engineer registered/licensed in the state of the proposed retaining wall. The Contractor shall have the proposed retaining wall drawn so the City can obtain a permit by the appropriate governing authorities

- B. Prior to start of work, the Contractor shall submit a manufacturers certification for each of the retaining wall system components. The certification shall state that the component meets the requirements of this specification.

1.05 Quality Assurance

- A. The Contractor shall be competent and experienced in the construction of reinforced segmental retaining walls. The Contractors competency and experience shall be determined by the Owner thru demonstration of successfully completed projects and/or completion of a nationally recognized course of instruction, such as the NCMA's Segmental Retaining wall Installers Education Program.
- B. The Design Engineer shall be competent and experienced in the design and analysis of reinforced segmental retaining walls. The Design Engineer shall provide proof of current professional liability insurances with an aggregate coverage limit of not less than \$1,000.00
- C. The Contractor shall provide independent soil testing and quality assurance inspection and testing during earthwork and wall construction operations. The quality assurance program does not relieve the Contractor of responsibility for quality control and wall performance.

1.06 Delivery, Storage and handling

- A. The Contractor shall check all materials upon delivery to assure that the proper type, grade, color, and certification have been received.
- B. The Contractor shall protect all materials from damage due to jobsite conditions and in accordance with manufacturer's recommendations. Damaged materials shall not be incorporated into the work.

PART 2: COMPONENTS

2.01 Definitions

- Block** – a Rockwood Classic 8TM concrete segmental wall unit.
- Cap** – a Rockwood Classic Universal CapTM concrete segmental retaining wall unit.
- Geogrid** – a geosynthetic material manufactured for the primary purpose to reinforce soil. Same as geosynthetic reinforcement and soil reinforcement.
- Filter Fabric** – a geosynthetic material manufactured for the primary purpose to filter soils from water. Same as geosynthetic fabric.
- Drainage Fill** – crushed rock aggregate that is placed within and immediately behind the block. Same as core fill and drainage rock.
- Backfill** – compacted soil that is placed behind the blocks and drainage fill and within the reinforced soil volume of the retaining wall as outlined on the plans. Same as reinforced backfill and infill soil.
- Base leveling Pad** – aggregate base material or concrete used as a foundation for the blocks. Same as leveling pad.

Drainage Pipe – typically, a 4" diameter PVC or corrugated HDPE pipe, that is perforated or slotted to accept water from the surrounding soils. Same as drain tile.

2.02 Blocks and Caps

- A. Blocks shall be Rockwood Classic 8TM concrete segmental retaining wall units. The Owner shall specify the color and face finish.
- B. Caps shall be Rockwood Classic CapTM concrete segmental retaining wall units.
- C. Blocks and caps shall conform to the following requirements.
 1. Block dimensions shall be: H = 8", L = 18", W = 12".
 2. Blocks shall have a built in lug protruding 5/8" from the base of the block.
 3. Cap dimensions shall be: H = 4", LFRONT = 18", LREAR = 14", W = 10.5"
 4. Permissible variations in block/cap dimensions shall be per ASTM C 1372.
 5. The finish and appearance of blocks/caps shall be per ASTM C 1372.
 6. Strength and absorption requirements shall be per ASTM C 1372.
 7. The unit weight (weight per unit volume) of an in-filled block shall be greater than 115 pcf.

2.03 Base Leveling Pad Material

- A. Base leveling pad materials shall consist of compacted aggregate base or non-reinforced concrete, as shown on the construction drawings and/or determined based upon field conditions. Aggregate base materials shall meet the following gradation in accordance with ASTM D-422:

Sieve Size	Percent Passing
1 inch	100
No. 4	35 - 70
No. 200	0 - 15

2.04 Drainage Fill Material

- A. Drainage fill material shall consist of crushed rock meeting the following gradation in accordance with ASTM D-422:

Sieve Size	Percent Passing
3 inch	100
¾ inch	75 - 100
No. 4	0 - 25
No. 200	0 - 5

2.05 Backfill

- A. Backfill shall consist of soil that is free of debris and deleterious material. Unless the Designer specifies otherwise and accounts for in his/her design analysis, backfill shall meet the following gradation in accordance with ASTM D-422:

Sieve Size	Percent Passing
3 inch	100
1 inch	50 - 100
No. 4	20 - 100
No. 40	0 - 75
No. 200	0 - 35

NAPERVILLE PUBLIC UTILITIES DEPARTMENT ELECTRIC STANDARDS	SEGMENTAL CONCRETE BLOCK WALL SYSTEM	DATE: 01-02-08 Page 1 of 6 60468-400
--	--------------------------------------	--

NAPERVILLE PUBLIC UTILITIES DEPARTMENT ELECTRIC STANDARDS	SEGMENTAL CONCRETE BLOCK WALL SYSTEM	DATE: 01-02-08 Page 2 of 6 60468-400
--	--------------------------------------	--

NAPERVILLE PUBLIC UTILITIES DEPARTMENT ELECTRIC STANDARDS	SEGMENTAL CONCRETE BLOCK WALL SYSTEM	DATE: 01-02-08 Page 3 of 6 60468-400
--	--------------------------------------	--

PROJECT TITLE ROUTE 59 ROAD IMPROVEMENTS			
PROJECT DESCRIPTION DETAILS AND STANDARDS			
ENGINEER BCC	DRAFTING DATE 5-11-12	MAP # 4211,4212,4223	SCALE N.T.S.
GIS DESIGN BY DL	DRAFTED BY PSM	AT&T JOINT AGREEMENT # N/A	PROJECT # EU-12
CHECKED BY	APPROVED BY	CAD FILE 0060648001D140.DWG	SHEET # 40 OF 63
Naperville		Department of Public Utilities Electric Division	
			WORK REQUEST # 60468

F.A.P. RTE.	SECTION	COUNTY	TOTAL SHEETS	SHEET NO.
338/IL 59	2011-035-1	DUPAGE		
			CONTRACT 60P42	
FED.ROAD.DIST.NO.		ILLINOIS	FED. AID PROJECT	

- B. Backfill shall have a Plasticity Index (PI) < 15 and Liquid Limit (LL) < 40 per ASTM D 4318.
- C. The Contractor shall obtain independent laboratory test results to verify that the backfill meets the requirements of 2.06 A. and B.

2.06 Geogrid

- A. The geogrid, as required by the Contractor's Designer in the construction plans and drawings, shall be manufactured specifically for soil reinforcement applications.

2.07 Drainage Pipe

- A. If required, drainage pipe shall be PVC pipe manufactured in accordance with ASTM D-3034 or corrugated HDPE pipe manufactured in accordance with ASTM D-1248. Drainage pipe shall be perforated, slotted, or non-perforated as shown in the construction drawings.

PART 3: EXECUTION

3.01 Excavation

- A. The Contractor shall excavate to the lines and grades shown on the construction drawings. The Contractor and/or Owner's representative shall inspect the excavation and approve/disapprove its competency as a foundation soil prior to placement of the leveling pad or backfill.
- B. If remedial work is required to improve the foundation soil, the Owner shall compensate the Contractor as mutually agreed.
- C. The foundation soil shall be compacted to minimum of 95% of the maximum density per ASTM D-698.
- D. If seepage or evidence of past seepage is observed in the excavation, the Contractor shall consult the Contractor Design Engineer in order to add or modify a drainage system to mitigate future seepage.

3.02 Base Leveling Pad

- A. Leveling pad materials shall be placed to the lines and grades shown on the construction drawings, to a minimum thickness of 6 inches, extending laterally a minimum of 6 inch, both in front of and behind the block.
- B. Leveling pad materials shall be compacted to a minimum of 95% of the maximum density per ASTM D-698.
- C. Leveling pad shall be prepared to insure full contact to the base surface of the block.

3.03 Block Installation

- A. First course of units shall be placed on the leveling pad at the appropriate line and grade as shown on the construction drawings. Alignment and level shall be checked in all directions. Ensure that all units are in full contact with the leveling pad and properly seated.
- B. Place the front of unit side-by-side. Do not leave gaps between adjacent units. Layout of corners and curves shall be in accordance with manufacturer's recommendations.
- C. Place drainage fills within and behind blocks. Place backfill behind drainage fill in lifts no greater than 6 to 12 inches and compact to a minimum of 95% of the maximum density per ASTM D-698. After placement of backfill, compact drainage fills by probing.
- D. Do not stack more than two courses of block prior to placing and compacting drainage fill and backfill.

3.04 Geogrid Installation

- A. Geogrid shall be oriented with the highest strength axis perpendicular to the wall alignment.
- B. Geogrid shall be placed at the type, lengths, and elevations shown on the construction drawings or as directed by the Contractor's Design Engineer.
- C. The geogrid shall be laid horizontally from within 2 inches of the face of the block back across compacted backfill. Place the next course of blocks over the geogrid. The geogrid shall be pulled taut and anchored prior to placing additional drainage fill or backfill.
- D. Geogrid shall be continuous throughout their embedment length. Geogrid shall be placed side-by-side or overlapped with 3 inch backfill between to provide 100% coverage at each designed geogrid level where possible. Geogrid shall not be spliced along its designed embedment length.

3.05 Backfill Placement

- A. Backfill shall be placed, spread, and compacted in such a manner that minimize the development of slack and installation damage in the geogrid.
- B. Backfill shall be placed and compacted in lifts not to exceed 6 inches where hand compaction is used, or 8 to 12 inches (depending on soil type and soil processing) where heavy compaction equipment is used. Lift thickness shall be decreased to achieve the required compaction.
- C. Backfill shall be compacted to 95% of the maximum density per ASTM D-698. The moisture content of the backfill material, prior to and during compaction, shall be uniformly distributed throughout each layer and shall be within 20% of the optimum moisture content as determined by ASTM D-698.
- D. Only lightweight hand-operated equipment shall be allowed within 4 feet from the face of the block.

- E. Tracked construction equipment shall not be operated directly upon the geogrid. A minimum of 6 inches of backfill is required over the geogrid prior to operation of tracked vehicles over the geogrid. Tracked vehicle turning should be kept to a minimum to prevent tracks from displacing the backfill and damaging the geogrid.
- F. Rubber tired equipment may pass over geogrid at slow speeds, less than 10 mph. Sudden braking and sharp turning shall be avoided.
- G. At the end of each day's operation, the Contractor shall slope the last lift of backfill away from the blocks and drainage fill in order to direct runoff away from wall face. The Contractor shall ensure surface runoff from adjacent areas does not enter the wall construction site.

3.06 Drainage System Installation

- A. Drainage systems, both internal to the wall and surficial, shall be determined based upon site conditions by the Contractor in consultation with the Owner and the Contractor's Design Engineer.
- B. Within the time of construction, the Contractor must ensure that all surficial drainage is directed away from the wall system by use of drainage swales, area drains, or other competent measure.
- C. Within the lifetime of the wall, the Owner must ensure that all surficial drainage is directed away from the wall system.

3.07 Cap Installation

- A. Caps shall be adhered to underlying blocks and caps with Super-Stik™.

3.08 As-Built Construction Tolerances

- A. **Vertical Alignment:** the top of wall shall be within 0.1 feet (1.2 inch) from design grade.
- B. **Wall Batter:** within 2 degrees of design batter, excluding a negative batter.
- C. **Horizontal alignment:** the bottom of the wall (B.W.), at design B.W. grade, shall within 1 foot of design line.
- D. **Maximum horizontal gap:** between erected blocks shall be 1/2 inch.

3.09 Field Quality Control

- A. The Contractor shall engage inspection and testing services (quality control) during construction to ensure project specification are met. The lack of quality control by the Contractor does not relieve the Contractor from meeting project specifications.
- B. Quality control should include, but not be limited to: foundation soil inspection; verification of geotechnical design parameters; and verification that construction is in general compliance with the design drawings and project specifications. (Quality Assurance is usually best performed by the site geotechnical engineer.)
- C. Only qualified and experienced technicians and engineers shall perform testing and inspection services

NAPERVILLE PUBLIC UTILITIES DEPARTMENT ELECTRIC STANDARDS	SEGMENTAL CONCRETE BLOCK WALL SYSTEM	DATE: 01-02-08 Page 4 of 6 60468-400
--	---	--



NAPERVILLE PUBLIC UTILITIES DEPARTMENT ELECTRIC STANDARDS	SEGMENTAL CONCRETE BLOCK WALL SYSTEM	DATE: 01-02-08 Page 5 of 6 60468-400
--	---	--

NAPERVILLE PUBLIC UTILITIES DEPARTMENT ELECTRIC STANDARDS	SEGMENTAL CONCRETE BLOCK WALL SYSTEM	DATE: 01-02-08 Page 6 of 6 60468-400
--	---	--

PROJECT TITLE						ROUTE 59 ROAD IMPROVEMENTS							
PROJECT DESCRIPTION						DETAILS AND STANDARDS							
ENGINEER	DRAFTING DATE	MAP #	SCALE										
BCC	5-11-12	4211,4212,4223	N.T.S.										
DESIGN BY	DRAFTED BY	REVISIONS DATE	AT&T JOINT AGREEMENT #	PROJECT #									
DL	PSM		N/A	EU-12									
CHECKED BY	APPROVED BY	CAD FILE	SHEET #										
		0060648001D141.DWG	41 OF 63										
Naperville						Department of Public Utilities Electric Division							
						WORK REQUEST # 60468							

F.A.P. RTE.	SECTION	COUNTY	TOTAL SHEETS	SHEET NO.
338/IL 59	2011-035-1	DUPAGE		
FED.ROAD.DIST.NO.			CONTRACT 60P42	
ILLINOIS			FED. AID PROJECT	



TRANSFORMER PAD

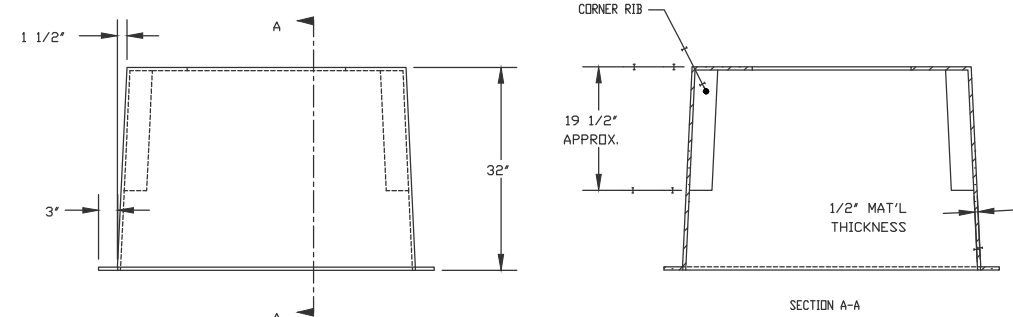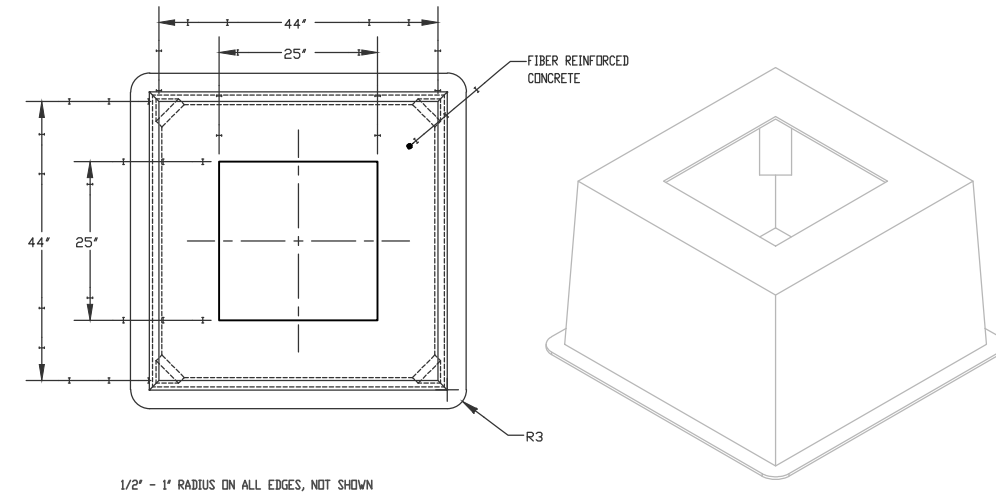

- NOTES:**
- 1) SEE M30-1400 FOR PRODUCT MATERIAL SPECIFICATIONS.
 - 2) BOX PAD EXTENSIONS WILL FIT OVER NEW (44 X 44 X 32) AND EXISTING (38 X 43 X 32) TRANSFORMER BOX PADS (SEE M30-1444).

NAPERVILLE PUBLIC UTILITIES DEPARTMENT ELECTRIC STANDARDS	FIBERCRETE BOX PAD FOR 1Ø TRANSFORMER	DATE: 12-25-04 M30-1440
--	--	----------------------------

1Ø TRANSFORMER PAD EXTENDER

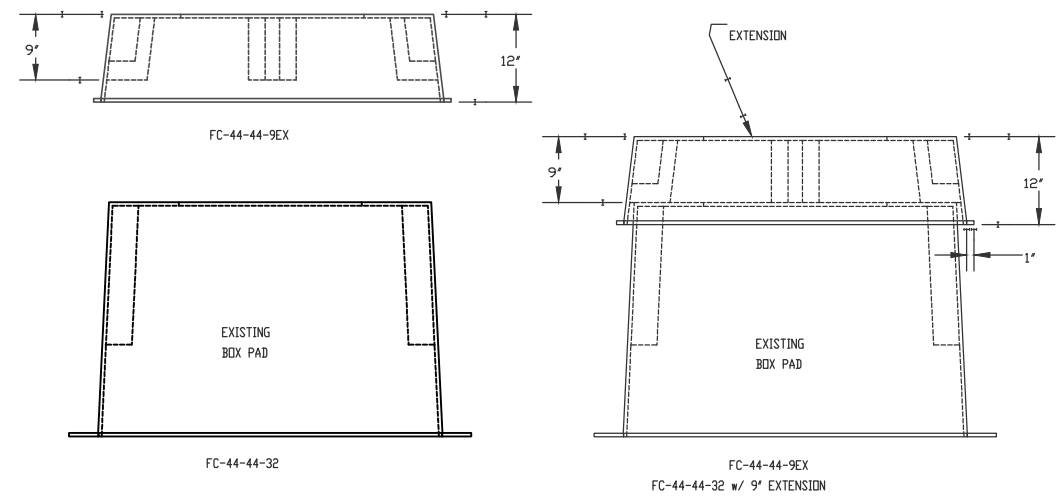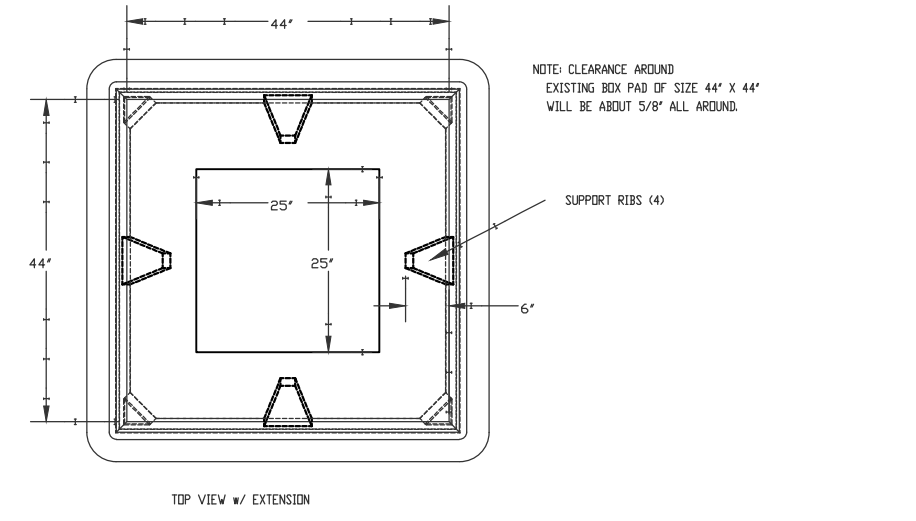

- NOTES:**
- 1) SEE M30-1400 FOR PRODUCT MATERIAL SPECIFICATIONS.
 - 2) BOX PAD EXTENSIONS WILL FIT OVER NEW (44 X 44 X 32) AND EXISTING (43 X 38 X 32) TRANSFORMER BOX PADS (SEE M30-1440).

NAPERVILLE PUBLIC UTILITIES DEPARTMENT ELECTRIC STANDARDS	BOX PAD EXTENSION FOR 1Ø TRANSFORMER	DATE: 11-02-05 M30-1444
--	---	----------------------------

PROJECT TITLE					ROUTE 59 ROAD IMPROVEMENTS				
PROJECT DESCRIPTION					DETAILS AND STANDARDS				
ENGINEER	DRAFTING DATE	MAP #	SCALE						
BCC	5-11-12	4211,4212,4223	N.T.S.						
GIS DESIGN BY	DRAFTED BY	REVISIONS DATE	AT&T JOINT AGREEMENT #	PROJECT #					
DL	PSM		N/A	EU-12					
CHECKED BY	APPROVED BY	CAD FILE	SHEET #						
		0060648001D142.DWG	42 OF 63						
Naperville			Department of Public Utilities Electric Division			WORK REQUEST #		60468	

F.A.P. RTE.	SECTION	COUNTY	TOTAL SHEETS	SHEET NO.
338/IL 59	2011-035-1	DUPAGE		
FED.ROAD.DIST.NO.			CONTRACT 60P42	
ILLINOIS			FED. AID PROJECT	

Guided Horizontal Drilling System (HDD)

The work specified in this specification consists of furnishing and installing underground utilities using the horizontal directional drilling (HDD) method of installation, also commonly referred to as directional boring or guided horizontal boring. This work shall include all services, equipment, materials, and labor for the complete and proper installation, testing, restoration of underground utilities and environmental protection and restoration. For the supply of domestic water during construction, the contractor shall utilize cities supply (meter & backflow device) and pay for all water consumed. Un-accountable domestic water quantities shall be minimized, where possible.

The requirements set forth in this specification specify a wide range of procedure precautions necessary to insure that the very basic, essential aspects of proper directional bore installation are adequately controlled. Strict adherence shall be required under specifically covered conditions outlined in these specifications or within any associated permit. Adherences to the specifications contained herein are required. DPU-E approval on any aspect of any directional bore operation covered by this specification shall in no way relieve the Contractor of their ultimate responsibility for the satisfactory completion of the work authorized under the Contract. The HDD Contractor shall be responsible for the repair of all damage to private and/or public property (at no expense to DPU-E). Repair work shall meet all local state and federal rules and requirements.

The project schedule shall be established on the basis of working a normal work schedule including five days per week, single shift, and eight hours per day. Unless approved otherwise by DPU-E normal or general items of work, such as testing, and final inspections, shall be scheduled during the normal work schedule. Due to operational, and manpower limitations on the DPU-E systems, DPU-E will require the Contractor to perform outage work outside of the normal work schedule. These operational outage and manpower limitations, including but not limited to tie-in work, (cut-in work or other work) and other phases of the work are required to limit the impact and the continued (non-interruptible) service to existing DPU-E customers. The Contractor shall plan and anticipate the cost impact of these systems limitations and provide such work or services at no additional cost to DPU-E.

Prior to beginning work, the Contractor must submit to DPU-E a work plan detailing the procedure and schedule to be used to execute the project. The work plan should include a description of all equipment to be used, down-hole tools, a list of personnel and their qualifications and experience (including back-up personnel in the event that an individual is unavailable), list of sub-Contractor, a schedule of work activity, a safety plan (including MSDS of any potentially hazardous substances to be used), traffic control plan (if applicable), an environmental protection plan and contingency plans for possible problems including a Frac-Out and Surface Spill Contingency Plan. Work plan should be comprehensive, realistic and based on actual working conditions for this particular project. Plan should document the thoughtful planning required to successfully complete the project. The HDD Contractor shall submit and obtain DPU-E's approval of a pre-construction bore-log depicting a plan and profile (horizontal and vertical alignment) of the proposed bore path. The bore-log shall show all utility crossings and existing structures.

The DPU-E representative must be notified 96 hours (minimum) in advance of starting the drilling work. The Directional Bore shall not begin until the proper preparation (work plan) for operation has been completed.

Prior to any alterations to work-site, Contractor shall video tape entire work area. One copy of which shall be given to DPU-E Representative and one copy to remain with Contractor for a period of two (2) years following the completion of the project.

HDD - Horizontally directionally drilling by definition.

NAPERVILLE PUBLIC UTILITIES DEPARTMENT	SPECIFICATION FOR THE INSTALLATION OF HDPE CONDUIT BY THE HORIZONTAL DRILLING SYSTEM (HDD)	DATE: 02-19-08
ELECTRIC STANDARDS		PAGE: 1 OF 25
		C30-1950

Guided Horizontal Drilling System (HDD) (Continued)

Work site shall be graded and filled to provide a level working area. No alterations beyond what is required for operations are to be made. Contractor shall confine all activities to designated work areas. Following drilling operations, Contractor will de-mobilize equipment and restore the work-site to original condition or better. All excavations will be backfilled and compacted to 95% of original density (as a minimum).

Contractor shall place site/silt fence between all drilling operations and any drainage, wetland, waterway or other area designated for such protection by contract documents, state, federal and local regulations. Contractor shall place hay bales, or approved protection, to limit instruction upon project area. Additional environmental protection necessary to contain any hydraulic or drilling fluid spills shall be put in place, including berms, lines, turbidity curtains and other measures. Contractor shall adhere to all applicable environmental regulations including environment condition stated in local, state and federal permits. Fuel may not be stored in bulk containers (greater than 25 gallons) within 200' of any water-body or wetland.

The horizontal Directional Drilling operation is to be operated in a manner to eliminate the discharge of water, drilling mud and cuttings to the adjacent creek or land areas involved during the construction process. The Contractor shall provide equipment and procedures to maximize the recirculation or reuse of drilling mud to minimize waste. All excavated pits used in the drilling operation shall be lined by Contractor with heavy duty plastic sheeting with sealed joints to prevent the migration of drilling fluids and/or ground water.

The Contractor shall visit the site and must be aware of all structures and the limitations at the directional drill crossing and provide the Engineer with a drilling plan outlining procedures to prevent drilling fluid from adversely affecting the surrounding area.

Clearing and grubbing shall consist of the removal and disposal of all trees (less than 6" dia.), stumps, roots, logs, shrubs, grass, weeds, fallen timber and other surface liter, wherever they occur within the right-of-way and within such other areas as directed and staked out by the Contractor.

Within the limits of the right-of-way and staked out by the Contractor's land surveyor all brush and trees, except those designated to be saved, shall be cut level with the ground, and all surface debris, including fallen timber, slash limbs, brush, grass and weeds, shall be disposed of off site.

Within areas where excavation will be made and where the embankment grade is less than 3 feet above the original ground level, all stumps and roots shall be grubbed out.

Trees shall be felled towards the centre of the area to be cleared. Any brush or trees falling outside of the area to be cleared shall be moved back to the right-of-way and disposed of. The Contractor shall take all precautions against damage to other trees, traffic, structures, pole lines or property in his felling of trees, and he shall be liable for any damages occurring in the performance of this work.

Clearing and grubbing shall be completed in advance of grading operations. The Contractor shall not start any clearing, grubbing without permission from the Engineer.

Removal of debris shall be carried on concurrently with clearing operations so that the debris from each day's operations is disposed of in that day. No additional compensation will be payable because of being required to handle the debris in this manner.

NAPERVILLE PUBLIC UTILITIES DEPARTMENT	SPECIFICATION FOR THE INSTALLATION OF HDPE CONDUIT BY THE HORIZONTAL DRILLING SYSTEM (HDD)	DATE: 02-19-08
ELECTRIC STANDARDS		PAGE: 2 OF 25
		C30-1950

Guided Horizontal Drilling System (HDD)

Debris and other materials must be disposed of off site by the Contractor and shall perform these operations well in advance of grading operations

Clearing, grubbing operations shall be conducted in accordance with the applicable Federal, County and Municipal regulations and Acts.

Before final acceptance of the work, the Contractor shall make a final clean-up of the right-of-way and remove debris which may have been covered with snow or blown in by the wind after the original clearing and grubbing operations were completed at no cost.

The general work areas on the entry and exit sides of the crossing shall be enclosed by a berm to contain unplanned spills or discharge.

Waste cuttings and drilling mud shall be processed through a solids control plant comprised as a minimum of sumps, pumps, tanks, desalter/desander, centrifuges, material handlers and haulers all in a quantity sufficient to perform the cleaning/separating operation without interference with the drilling program. The cuttings and excess drilling fluids shall be dewatered and dried by the Contractor to the extent necessary for disposal in offsite landfills. Water from the dewatering process shall be treated by the Contractor to meet permit requirements and disposed of locally. The cuttings and water for disposal are subject to being sampled and tested. The construction site and adjacent areas will be checked frequently for signs of unplanned leaks or seeps.

Equipment (graders, shovels, etc.) and materials (such as groundsheets, hay bales, booms and absorbent pads) for cleanup and contingencies shall be provided in sufficient quantities by the Contractor and maintained at all sites for use in the event of inadvertent leaks, frac out, seeps or spills.

Waste drilling mud and cuttings shall be dewatered, dried, and stock piled such that it can be loaded by a front end loader, transferred to a truck and hauled offsite to a suitable legal disposal site. The maximum allowed water content of these solids is 50% of weight.

Due to a limited storage space at the worksites, dewatering and disposal work shall be concurrent with drilling operations. Treatment of water shall satisfy regulatory agencies before it is discharged.

The Contractor shall install 3 inch, 5 Inch or 6 inch HDPE coilable conduit, into various configurations and lengths and combinations. Contractor to review drawings for all work. The HDPE coilable conduit shall be connected by the butt fusion process. The Contractor shall reposition the conduit, for installation in to electrical facilities after installing the HDPE conduit by the HDD method, using schedule 40 PVC or Steel conduit and positioning conduit into the proper cross sections. The Contractor is to connect HDPE conduit by rotating, aligning, cutting, leveling, bending, coupling, mitering, measuring, cropping, fitting, positioning and laying out the conduit using steel conduit or schedule 40 PVC as required to provide the cross section required and then connecting this cross section to splices boxes, hand holes, manholes, switchgear vaults, transformer vaults, pedestals or risers. The work to reposition the HDPE is included in the contract and is incidental to the pricing.

NAPERVILLE PUBLIC UTILITIES DEPARTMENT	SPECIFICATION FOR THE INSTALLATION OF HDPE CONDUIT BY THE HORIZONTAL DRILLING SYSTEM (HDD)	DATE: 02-19-08
ELECTRIC STANDARDS		PAGE: 3 OF 25
		C30-1950

PROJECT TITLE				ROUTE 59 ROAD IMPROVEMENTS			
PROJECT DESCRIPTION				DETAILS AND STANDARDS			
ENGINEER	DRAFTING DATE	MAP #	SCALE				
BCC	5-11-12	4211,4212,4223	N.T.S.				
GIS DESIGN BY	DRAFTED BY	REVISIONS DATE	AT&T JOINT AGREEMENT #	PROJECT #			
DL	PSM		N/A	EU-12			
CHECKED BY	APPROVED BY	CAD FILE	SHEET #				
		0060648001D143.DWG	43 OF 63				
Naperville			Department of Public Utilities			WORK REQUEST #	
			Electric Division			60468	

F.A.P. RTE.	SECTION	COUNTY	TOTAL SHEETS	SHEET NO.
338/IL 59	2011-035-1	DUPAGE		
			CONTRACT 60P42	
FED.ROAD.DIST.NO.		ILLINOIS	FED. AID PROJECT	

Guided Horizontal Drilling System (HDD)

The HDPE conduit shall be installed based on the use of a guided horizontal drilling system. A guided horizontal drilling system is a trench less technique that employs small diameter fluid jets and/or mechanical cutting tools attached to a flexible drill string to form a bore as the head is thrust forward. Steering in both the vertical and horizontal planes can be effected by controlling the orientation of fluid jets or a slanted face head. Soil conditions and obstructions vary the drilling direction; adjustments are made to keep the drill on-line to the receiving pit. Once the bore is accomplished the conduit section up to 24 inches in diameter shall be installed using the same equipment. The Contractor shall provide boring equipment to bore a minimum length of 20 feet and a maximum length of 1000 feet with varying depths of 2-foot 6inches min to 12-foot 6inches in depth max in one setup. The normal drilling depth of all pulls for 3,5or 6inch HDPE and for all configurations is approximately 5 to 6 feet below grade to top of conduit.

The drilling is accomplished in two steps. The first step consists of drilling a small diameter hole along a specific path. The second step consists of enlarging the pilot hole by a back reamer to the size required to install the conduit/ conduits. The first and second step may require several iterations to accomplish the proper diameter hole to install the duct. The position and location of the drilling operation is monitored with an above ground electronic locator and/or a remote guidance system.

The HDPE conduit sections consists of installing conduit sections of one duct, two ducts, three ducts, four ducts, or six ducts of solid coilable HDPE Conduit. The HDPE is supplied in 3 inch 13.5 SDR, 5 inch 13.5 SDR or 6 inch 13.5 SDR conduit of 450 feet to 500 feet on 10-foot diameter steel non-returnable reels or HDPE 3inch 13.5 SDR conduits of 1000 feet to 1500 feet on 12 feet to 15 foot diameter reels. The Contractor transports the HDPE to the work site, prepares entry pits, exit pits and turning pits at the work site, connecting pits to allow for fusion of the HDPE conduit is done, and the route is prepared, potholes are dug and completed along the route, all prep work is completed, and any adjustments are made to the alignment to miss all obstructions below and above grade, the final alignment is identified and chosen and then the HDPE is assembled into the desired sections, configurations and quantities and lengths. The HDPE shall then be installed. During the installation process the duct section rolls and twists resulting in a cross section not acceptable for connecting to any electrical facilities. The contractor shall correct this situation in the field by performing the following: the HDPE conduits ends shall be connected to a section of schedule 40 PVC or steel conduits, during the connection process the conduits are positioned, rotated and aligned to meet the cross section required by the specification and then connected to the electrical facilities for a complete system by the Contractor. The Contractor is not permitted to install HDPE 3inch SDR or HDPE 5 inch SDR or HDPE 6 inch SDR into any electrical equipment. The conduit to be used for entering equipment is steel conduit section or a section of schedule 40 PVC. HDPE in 40-foot straight sections and then butt fused together is not acceptable. The Contractor is advised 3inch, 5inch, and 6inch HDPE Conduit is furnished on non- returnable steel reels which must be disposed of off site by the contractor. The couplings, connections, materials, and tools to perform the butt fusion process are furnished by the Contractor.

Nominal pipe sizes only are indicated on the drawings and bid form. Outside diameter of pipe is generally 1 to 2 inches greater than the nominal pipe diameter.

Only HDPE conduit shall be installed by the Horizontal Directional Boring method by the Contractor. The 3inch, 5inch, and 6 inch SDR HDPE conduit on steel reels; couplings and connections except 3inch, 5inch or 6inch connections to schedule 40 PVC or steel conduit, which are furnished by the Contractor, are furnished by the City of Naperville and can be picked up at the city storage yard on Aurora Road. The inside duct diameter size is 5.62 inches for 6inch SDR 13.5 and is 4.75 inch for 5inch SDR 13.5 and is 2.75inch for 3inch SDR 13.5. The contractor is advised the wall thickness of HDPE conduit is usually thicker than the wall thickness of steel conduit or Schedule 40 PVC conduit. All duct sections shall be field assembled, cut, positioned, leveled, reamed, fillers inserted, aligned, fused, connected and are to be pulled in at the same time with warning tape and are continuous. The Contractor shall use a spreader tool furnished by the Contractor to reform the HDPE Conduit from oval to round to allow for the installing of couplings. Joining shall be performed by thermal butt fusion in accordance with the manufacturer's recommendations.

NAPERVILLE PUBLIC UTILITIES DEPARTMENT	SPECIFICATION FOR THE INSTALLATION OF HDPE CONDUIT BY THE HORIZONTAL DRILLING SYSTEM (HDD)	DATE: 02-19-08 PAGE: 4 OF 25 C30-1950
ELECTRIC STANDARDS		

Guided Horizontal Drilling System (HDD) (Continued)

The conduit, at the joined inner surface area, at the interface between schedule 40 PVC plastic or steel conduit is to be field milled to a smooth level connection from one material to another. This area shall be level and smooth to allow for the cable to pass with out being obstructed by a difference in conduit thickness or diameters. The Contractor is advised that the site preparation and the process of installing 1 duct, 2ducts, 3ducts, 4ducts or 6ducts of HDPE in a duct package, may require 2 pulls or more and may require additional work to complete the installation and is included in the pricing.

The Contractor at his expense may do exploratory soil borings to determine the existing soil conditions. This information is used to determine the best work method to use, lubricant requirements, determine soil classification, determine the size and type of equipment to use for the HDD operation, determine the auger type to use, speed of installation, and back pressure to help eliminate any frac out of any kind. All work of this type is limited to the City Right of Way. The Contractor is required to HDD bore through all types and classification of earth materials i.e.: sand, clay, clayey sand, peat, mud, muck, silt, water, sandy clay, cobbles, fissured rock, hard pan, splinter rock, gravel, stones, organic materials, and small boulders less than 8 inches in diameter. However, the City will make additional payment on a per linear foot basis of a duct package installed in solid rock for a complete job if the following is met. The city shall be informed when the solid rock is found. Failure to inform the city immediately may be cause for rejecting a claim of solid rock. Solid Rock is defined as having an RDQ of at least 70 or more and bigger than 8 inches in diameter to be classified as solid rock. The Contractor shall employ a materials laboratory, at the Contractors cost, with city approval to make this determination. The final decision is made by the City.

Solid rock, as referred to herein in connection with the classifying of excavation, shall comprise and include (1) 8" diameter or bigger boulders measuring 1 cubic yard or more in volume, (2) all rock material which is in ledges, bedded deposits and unstratified masses and which cannot be removed without drilling and blasting, and (3) conglomerate deposits which are so firmly cemented as to present all the characteristics of solid rock and which cannot be removed without drilling and blasting.

When solid rock layers have an overburden of material of common classification which cannot practically be stripped and handled separately from the solid rock and/or are interspersed with a material of common classification, the entire mass will be classified as solid rock if the solid rock constitutes an area of conduit which crosses under the surfaced portion of the highway or street, the installation shall be either tunneled, jacked, driven or bored under the surface.

The ducts are to be joined together, glued where applicable, fused, and installed with the total degree of bends (vertical and horizontal) not to exceed 235 degrees in 1000 feet. The Contractor is responsible for monitoring this requirement and reports any deviation to the city. The Contractor shall provide a smooth transition from HDPE to HDPE, from HDPE to steel, from HDPE to schedule 40 PVC conduits on the outside and inside of the duct at all connection points. The area at the interface of the connection shall be smooth to the touch without more than a 1/8-inch bead of material left after fusion on the inside of the pipe. Any ridge that is larger than 1/8 inch shall be removed and reconnected to insure the connection will not separate or be an obstruction for the cable pulling process. All connections shall fit uniformly, concrete encased at each connection with ready-mix, and with equal pressure being applied on all exterior conduit pieces and fittings. Connections may be tested in the field for pulling capability at the Contractors expense as directed by the Engineer. All ducts shall be inspected for roundness prior to installing. All ducts shall be pulled to the manufactures recommended tensions. Ducts that are necked down due to pulling or become separated shall be rejected. The 3inch SDR HDPE, 5-inch SDR HDPE, 6-inch SDR HDPE conduit that becomes oval shall be cut back a maximum of 7 feet or until the pipe becomes round or is rejected if more than 7 feet is to be cut off. The contractor shall record all depth, speed information as required on the forms provided, with special interest to the duct pulling tensions, torques and depths as installed. Each pull shall be documented and the form filled out by the contractor and given to the city. Any documentation missing may result in not obtaining approval for payment. All 11, 22, 30, 45 and 90 degree steel bends or schedule 40 PVC bends shall be installed by the machine aided trenching method/or hand dug using prefabricated manufactured type steel bends.

NAPERVILLE PUBLIC UTILITIES DEPARTMENT	SPECIFICATION FOR THE INSTALLATION OF HDPE CONDUIT BY THE HORIZONTAL DRILLING SYSTEM (HDD)	DATE: 02-19-08 PAGE: 5 OF 25 C30-1950
ELECTRIC STANDARDS		

Guided Horizontal Drilling System (HDD) (Continued)

The use of 5 inch and 6 inch steel bends for all angles above 5 degrees and 3 inch steel bends for angles at 90 degrees, shall be required at all angles in the line and as directed by the Engineer. The steel or plastic ducts and the area around the ducts (sometimes called turning pits) where bends are installed shall be supported by ready-mix 3000 pound concrete delivered to the location to provide sufficient strength to withstand a pull of 10,000 lbs and remain serviceable.

Please see the specifications and drawings for the number of 3, 5, and 6- inch ducts, configurations, route, lengths and types of formations to be installed. The Contractor shall coordinate all ingress and egress to the work site with the city prior to performing the work. This work may require the Contractor to provide a detail of the work to be done in a particular area with some down time and this is considered a normal working conditions. The Contractor shall install 3 inch, 5inch and 6-inch HDPE SDR 13.5 conduit under and along all street rights of way, easements or road crossings in the number, lengths and locations shown on the drawings. All splice pits; entry and exit pits, exploratory digging, potholing by machine or hand, turning pits and staging areas to make connections of the conduit are included in the work. All conduit staging areas, entry and exit pits, exploratory digging, potholing, turning pits and splice pits shall be approved by the City of Naperville before any work is started. Failure to get approval of the staging areas, entry and exit pits may result in moving an area or pit, abandoning an area or pit and starting over at another location all at the expense of the Contractor. If at the end of a day's work to install the HDPE conduit is not completed The Contractor shall follow the following guidelines: Equipment shall be disconnected from the rods and moved back to the contractor's storage area if the drilling machine is to be left over the weekend in some one's back yard. However, if the contractor can obtain approval from the property owner and the machine can be made safe to the general public the machine can stay. The Contractor shall abide by all permit restriction and work practice methods about leaving equipment out in the General Public.

The Contractor shall, by his won inspection and by careful examination, fully convince himself as to the accessibility of the site for performing the work. The Contractor shall be responsible for maintaining the access roads during the duration of construction. Any modifications to the construction limits shall be submitted by the Contractor to the Engineer for approval at least one week prior to making any modifications

All areas disturbed by the Contractor in constructing temporary access roads and ramps shall be regarded and restored to the pre-existing conditions, or as otherwise approved by the Engineer

All conduit staging area's, turning pits, or splice pits, entry and exit pits shall be identified in the field with stakes, dimensioned and recorded in the surveyor's field book records after the job is awarded to the Contractor. This information is part of the as Build's and documentation required.

The Contractor shall not at any time leave the work area with conduit protruding above the surface of the ground at equipment location sites, turning pits, exit pits, entry pits, access pits, or splice pits. The Contractor shall dig a ditch of sufficient size to push the conduit below the ground surface for later connection. The open ends of all sections of joined and/or installed pipe (not a service) shall be plugged at night to prevent animals or foreign material from entering the pipe line of pipe section.

Waterproof nightcaps of approved design may be used but they shall also be so constructed that they will prevent the entrance off any type of natural precipitation into the pipe and will be fastened to the pipe in such a manner that the wind cannot blow them loose. The practice of stuffing cloth or paper in the open ends of the pipe will be considered unacceptable.

NAPERVILLE PUBLIC UTILITIES DEPARTMENT	SPECIFICATION FOR THE INSTALLATION OF HDPE CONDUIT BY THE HORIZONTAL DRILLING SYSTEM (HDD)	DATE: 02-19-08 PAGE: 6 OF 25 C30-1950
ELECTRIC STANDARDS		

PROJECT TITLE				ROUTE 59 ROAD IMPROVEMENTS			
PROJECT DESCRIPTION				DETAILS AND STANDARDS			
ENGINEER	DRAFTING DATE	MAP #	SCALE				
BCC	5-11-12	4211,4212,4223	N.T.S.				
GIS DESIGN BY	DRAFTED BY	AT&T JOINT AGREEMENT #	PROJECT #				
DL	PSM	N/A	EU-12				
CHECKED BY	APPROVED BY	CAD FILE	SHEET #				
		0060648001D144.DWG	44 OF 63				
Naperville			Department of Public Utilities Electric Division		WORK REQUEST # 60468		

F.A.P. RTE.	SECTION	COUNTY	TOTAL SHEETS	SHEET NO.
338/IL 59	2011-035-1	DUPAGE		
			CONTRACT 60P42	
FED.ROAD.DIST.NO.		ILLINOIS	FED. AID PROJECT	

Guided Horizontal Drilling System (HDD) (Continued)

The Contractor shall backfill and level area immediately, and remove fill later to make all connections. No claims for extra compensation will be considered for cost incurred because of delay due to changing the location of a staging area, a frac out incident, splice pit location determination, turning pit location determination, or obtaining approval for said work area or opening the equipment for inspection or installation. The Contractor shall minimize the inconvenience to the public when picking and staging the work. The Contractor shall provide CA-6 backfill materials, black dirt, sod, grading, landscaping, stone/rock removal, tunneling, hand digging, install new fencing, removal of fencing, sidewalk replacement, curb and gutter replacement, tree and brush protection, arborist services, and/or replacement and dispose of all removed materials off site. The removal of spoils off the site is a major concern and must be removed off site immediately or by the end of the work day or next day. The excavated materials as well as spilled drilling fluids shall be removed in the same day as the dig or the next day at the latest. The Contractor shall not block pedestrian traffic or create a line of site problem with their equipment or work methods to the general public and this equipment or method shall be moved or changed at the request of the City of Naperville at no cost. Hand digging is considered incidental to the work and no claim for additional funds shall be honored. Storing of excavated materials of any kind in the City Right of Way over night is not permitted unless a permit has been issued that approves such methods.

The Contractor shall explain in detail in the bid submittal the technique and construction method that shall be used on the project to minimize the amount scrap of 3 inch, 5inch and 6-inch conduit. The Contractor shall provide an approximate estimate of scrap in linear feet of each size. A method that minimizes scrap is very desirable.

All 3 inch, 5inch, and 6 inch HDPE SDR 13.5 is furnished to the Contractor by the City of Naperville and picked up by the Contractor. However, the couplings for 3inch, 5inch and 6 inch 13.5 SDR HDPE to schedule 40 PVC plastic or steel shall be furnished and installed by the Contractor and the cost is in the pricing.

Contractor shall furnish all labor, tools, transportation, communication, supervision, equipment, all materials not furnished by the City of Naperville, however, the following is required: registered professional land surveying services, soil boring services, licensed professional landscaping services, services of a registered professional arborist, and all consumables necessary for a complete job and is included in each unit of pricing of the work for a complete job.

The Contractor shall be responsible, at no additional cost, for timely repair or replacement of structures, equipment, pipelines, power lines, or any facilities and/or other on-going or completed construction item damage by the Contractor's and/or his subcontractor's operations and/or personnel.

The Contractor shall be required to inform the residents if drilling work is going to be done during, before and after a snow fall incident so they can move their cars to allow the Contractor to shovel and remove snow from the street that is being used to get to the job site and at the job site. The Contractor has the responsibility to remove and keep clear at all times the roads being used including snow removal and disposal of snow from street. The Contractor shall spread salt to improve drivability. The Contractor shall include in the installation cost of all 3inch SDR HDPE, 5inch SDR HDPE and 6inch SDR HDPE conduit materials and accessories including couplings, shipping and ordering, transportation of materials and disposal of the reels in the pricing of the unit of foot. Landscaping and restoration including fences gates, trees, bushes, grass, and black dirt, humps, frac outs, cleaning up frac outs, remove and restore all plantings, trimming all trees and brush,, all temporary work, all patching, flowers, access to and from job site, pothole repairs, sodding and watering, street repair, curb and gutter repair, side walk repair, transplanting functions, street light cable repair/ move, all cable TV repair/ move, all telephone repairs/ move, and disposal of all excavated materials off site are included.

NAPERVILLE PUBLIC UTILITIES DEPARTMENT	SPECIFICATION FOR THE INSTALLATION OF HDPE CONDUIT BY THE HORIZONTAL DRILLING SYSTEM (HDD)	DATE: 02-19-08 PAGE: 7 OF 25 C30-1950
--	--	---

Guided Horizontal Drilling System (HDD) (Continued)

The Contractor shall submit in writing that the installed HDPE 13.5 (SDR) conduit, pipe couplings, and fittings installed under this specification are in conformance with the material and mechanical requirements for the type of conduit installed and are compatible with the cable tensions required to install: namely 12kv 1000 MCM or 34 Kv 1000 MCM triplexed cable in the installed conduit. The Contractor shall be responsible, for all couplings, fittings, to provide a smooth and unobstructed path through the HDPE conduit and connection area plus provide sufficient strength of the connection to maintain a continuous conduit with out separation for the cable installation. All tooling and connection materials for steel conduit to HDPE conduit and HDPE conduit to PVC schedule 40 conduits are to be supplied by the Contractor. A failure of the cable to be installed in the conduit shall be reason enough to reject the entire installation and delay further payments until the problem is corrected to the satisfaction of the City of Naperville

The contractor shall install pits for example: receiving, sending, entry, exit, turning, connecting etc; the contractor shall layout the work to install the minimum number of pits. The number of pits shall be kept to a minimum to reduce the damage to the surrounding landscaping. All pits must be approved by the city of Naperville before any work is started. All access pits must be identified in the field by staking after the job is awarded by the contractor and documented with a sketch and provided to the City. No claims for extra compensation will be considered for cost incurred because of delay due changing the route location or location of access pits due to lack of notification, or obtaining approval. Contractor to provide compacted CA6 backfill materials and black dirt. Dispose of all removed materials off site.

Hand digging is considered as part of the work. Pits are excavations and must be covered and fenced in and not left open and are to be made safe for the Public and meet OSHA regulations

The Contractor shall furnish all connection fittings, tools, equipment, labor and transportation for joining together the 3-inch, 5inch, and 6- inch flexible poly coiled SDR13.5 HDPE poly conduit to steel conduit or schedule 40 PVC

The Contractor shall provide a butt fused or electro fused coupling to connect the 3, 5or 6-inch to 3, 5 or 6-inch flexible coiled conduit. The Contractor shall provide mechanical adapters to connect 3,5, 6-inch steel or 3,5, 6-inch schedule 40 PVC bends or straight pieces of PVC to the flexible poly coiled 3, 5, 6- inch HDPE (13.5 SDR) conduit.

The Contractor shall provide fast setting glue for schedule 40 PVC conduit connections at the Contractor's cost and furnish in sufficient quantities for a complete job, if the Contractor decides to substitute.

The cost to provide this material is included in the installation price for: 3 inch, 5inch, and 6-inch directional bored 3, 5, and or 6-inch conduit 1-way, 2-way, 3 -way, 4way, and 6 way duct sections of HDPE (13.5 SDR) flexible poly coiled conduit.

The cost of all materials furnished by the Contractor shall be included in the installation of the conduit duct section per the unit pricing.

It is the contractor's responsibility to obtain and direct the surveying services required to establish the right of way limits of all the city of Naperville's recorded easements within the work area. The contractor is responsible for installing all duct sections and maintaining all construction activities inside the limits the city of Naperville's right of way. No ingress or egress will be provided other than shown on the recorded easements

NAPERVILLE PUBLIC UTILITIES DEPARTMENT	SPECIFICATION FOR THE INSTALLATION OF HDPE CONDUIT BY THE HORIZONTAL DRILLING SYSTEM (HDD)	DATE: 02-19-08 PAGE: 8 OF 25 C30-1950
--	--	---

Guided Horizontal Drilling System (HDD) (Continued)

The Contractor shall establish reference points to horizontal and vertical control near and/or within the construction site at the beginning of construction from the County or City records. From these reference points, the Contractor shall provide all horizontal and vertical controls necessary to complete the work to grades, slopes and dimensions shown on the Drawings. The Contractor's surveying service shall be in compliance with the vertical and horizontal tolerances in the specifications, and shall be conducted under the direct supervision of Registered Land Surveyor. Marketing and grade stakes shall be provided as needed by the Contractor to facilitate and expedite inspection of the finished grade for compliance with the dimensions on the Drawings and specified grade tolerances.

The lines, grades and dimensions shown on the Drawings have been selected to approximate the best route based on certain simplifying assumptions, and as such are approximate. Final grades, elevations and dimensions are subject to adjustment during construction at the sole discretion of the Engineer. Any such adjustment shall not constitute a changed condition and shall be undertaken at no additional cost.

It is the responsibility of the Contractor to verify all dimensions prior to fabrication, installation and/or construction of any item of work.

After installation, contractor shall mark the plan drawings or provide new drawings to accurately show the actual installation and alignment of the conduit installed. This information shall be provided to the owner.

The information provided by the Contractor's surveyor to the City shall be the measured conduit lengths from electrical structure to electrical structure, number, and size of conduit and depth of conduits. All above and below ground obstructions, road ways drives, entry and exit pits, turning pits and all equipment installed. All elevations and GPS coordinates of every conduit with dimensions and connections shall be identified and shown.

Materials indicated in these Specifications as supplied by the DPU--E shall be picked up by the Contractor at storage facilities as designated by the DPU--E and this picking up, sorting, hauling, loading, unloading, tracking, security, proper size equipment, labor, tools, storage off site, preparing damage claims, and replacing all materials found unacceptable to use after the contractor accepts the materials and keeping an inventory of all materials picked up until completion of the project shall be considered incidental to the contract.

It is the Contractors responsibility to determine from the work specification that materials furnished by the City of Naperville are sufficient to complete the job. The Contractor shall maintain a tally of all materials picked up by WF number and continuously update the tally to show what has been installed and what is needed to complete each WF# as each project progresses. The Contractor Shall notify the City of Naperville in writing, before the commencement of work, of any shortages of one or more types or quantities of materials required for a complete job. The Contractor shall be responsible to provide any shortages of materials in type or quantity furnished by the City of Naperville during the progress of the work. No claims for extra compensation will be considered for cost incurred because of lack of adequate materials.

The Contractor is responsible for inspecting materials delivered to the site for damage. All materials found during inspection or during the progress of work to have cracks, flaws, cracked linings, or other defects shall be rejected and removed from the job site without delay. Unload and store opposite or near the place where the work will proceed with minimum handling. Store material under cover out of direct sun light. Do not store directly on the ground. Keep all materials free of dirt and debris. Contractor is responsible for obtaining, transporting and sorting any fluids, including water, to the work site. Disposal of fluids is the responsibility of the Contractor. Disposal of fluids shall be done in a manner that is in compliance with all permits and applicable federal, state, or local environmental regulations. The bentonite drilling slurry may be recycled for reuse in the hole opening operation, or shall be hauled by the Contractor to an approved location or landfill for proper disposal. Contractor shall thoroughly clean entire area of any fluid residue upon completion of installation, and replace and all plants and sod damaged, discolored or stained by drilling fluids.

NAPERVILLE PUBLIC UTILITIES DEPARTMENT	SPECIFICATION FOR THE INSTALLATION OF HDPE CONDUIT BY THE HORIZONTAL DRILLING SYSTEM (HDD)	DATE: 02-19-08 PAGE: 9 OF 25 C30-1950
--	--	---

PROJECT TITLE				ROUTE 59 ROAD IMPROVEMENTS			
PROJECT DESCRIPTION				DETAILS AND STANDARDS			
ENGINEER	DRAFTING DATE	MAP #	SCALE				
BCC	5-11-12	4211,4212,4223	N.T.S.				
GIS DESIGN BY	DRAFTED BY	AT&T JOINT AGREEMENT #	PROJECT #				
DL	PSM	N/A	EU-12				
CHECKED BY	APPROVED BY	CAD FILE	SHEET #				
		0060648001D145.DWG	45 OF 63				
Naperville			Department of Public Utilities		WORK REQUEST #		
			Electric Division		60468		

F.A.P. RTE.	SECTION	COUNTY	TOTAL SHEETS	SHEET NO.
338/IL 59	2011-035-1	DUPAGE		
FED.ROAD.DIST.NO.			CONTRACT 60P42	
ILLINOIS			FED. AID PROJECT	

Guided Horizontal Drilling System (HDD) (Continued)

The Contractor shall cause to have prepared in written form, a list of all materials showing quantities, size, and types of materials the Contractor needs to complete the entire Project and present it to the Project Engineer two weeks after the Project is awarded and prior to the start of Work. Failure by the contractor to inventory the materials prior to start of work and inform the City in writing shall indicate to the City of Naperville all materials are correct in size, quantity and type to do all the work required for a complete installed project.

The Contractor shall follow the following material pick up procedures:

- A. Material from the warehouse shall be issued from the "Material Issue Desk" located inside the west service door marked "Water Meter Pickup".
- B. Material shall be issued to the correct WF #. This WF # shall be provided after award. The person picking up material shall have the WF # so we can provide the correct materials to do the work. The person picking up the material shall sign the material ticket indicating materials picked up, condition, quantity and date. The ticket shall be given to the company engineer on the work site.
- C. Material shall be released from the stockyard to the Contractor contacting the warehouse personnel at the "Material Issue Desk".
- D. The Contractor shall be allowed inside the stockyard only when accompanied by warehouse personnel.
- E. Material shall be loaded on trucks, trailers or pickups only with proper restraints to secure material for public safety on the roadways. Warehouse will not supply straps, blocking or other restraints.
- F. Material pick-up - Monday through Friday, 7:00 a.m. to 3:00 p.m. Contractors will not be loaded on Saturdays, Sundays or Holidays.
- G. The warehouse is closed daily from 12:00 p.m. to 12:30 p.m.
- H. Between 7:00 a.m. and 8:00 a.m. City of Naperville crews will be loaded first. After they are loaded, it will be first come, first served.
- J. For any discrepancies in type and quantity of materials to be received, please call the Project Engineer. The Project Engineer will be identified at the preconstruction meeting.
- K. Please call Terry Skala at (630) 420-4136 for questions regarding all warehouse

The contractor is advised this work is located in an area of heavy tree growth, with a high degree of low growing shrubs and vegetation. The lots are fenced in. Also, many lots have dogs which need to be put up before entering. The subdivision is typical for Naperville and the contractor shall work with the people in this subdivision to save and protect all trees and landscaping. The contractor shall develop a plan To work in this environment, the plan shall be reviewed by the city of Naperville.

NAPERVILLE PUBLIC UTILITIES DEPARTMENT	SPECIFICATION FOR THE INSTALLATION OF HDPE CONDUIT BY THE HORIZONTAL DRILLING SYSTEM (HDD)	DATE: 02-19-08
ELECTRIC STANDARDS		PAGE: 10 OF 25
		C30-1950

Guided Horizontal Drilling System (HDD) (Continued)

The directional drilling equipment shall consist of a directional drilling rig of sufficient capacity to perform the bore and pullback the pipe, a drilling fluid mixing, delivery and recovery system of sufficient capacity to successfully complete the drill, a drilling fluid recycling system to remove solids from the drilling fluid so that the fluid can be reused, a guidance system to accurately guide boring operations, a vacuum truck of sufficient capacity to handle the drilling fluid volume, trained and competent personnel to operate the system. All equipment shall be in good, safety operating condition with sufficient supplies, materials and spare parts on hand to maintain the system in good working order for the duration of this project.

The Contractor shall provide a typical drilling system as follows:

Drilling Rig:

The directional drilling machine shall consist of a power system to rotate, push and pull hollow drill pipe into the ground at a variable angle while delivering a pressurized fluid mixture to a guidable drill (bore) head. The power system shall be self contained with sufficient pressure and volume to power drilling operations. Hydraulic system shall be free of leaks. Rig shall have a system to monitor and record maximum pull back pressure during pull back operations. The rig shall be grounded during drilling and pull back operations. There shall be a system to detect electrical current from the drilling string and an audible alarm which automatically sounds when an electrical current is detected.

Drill Head:

The drill head shall be steerable by changing its rotation and shall provide the necessary cutting surfaces and drilling fluid jets.

Mud Motors (if required):

Mud motors shall be a adequate power to turn the required drilling tools.

Drill Pipe:

Shall be constructed of high quality 4130 seamless tubing, grade D or better.

The contractor's supervision assigned to this work must be experienced in work of this nature and must have successfully completed similar work using guided horizontal drilling systems.

NAPERVILLE PUBLIC UTILITIES DEPARTMENT	SPECIFICATION FOR THE INSTALLATION OF HDPE CONDUIT BY THE HORIZONTAL DRILLING SYSTEM (HDD)	DATE: 02-19-08
ELECTRIC STANDARDS		PAGE: 11 OF 25
		C30-1950

Guided Horizontal Drilling System (HDD) (Continued)

As part of the bid submission, the contractor shall submit a description of such and name the supervision that will be on the work site for the duration of the work

A guided horizontal drilling system consists of the following major components:

- Directional/ steering head
- Electronic navigation system which may include an electronic transmitter and above ground locator and/or a remote guidance system that confirms the position and orientation of the steering head.
- Mobile drilling rig
- Power unit
- High pressure water pumps
- Water/slurry mixing tank

The exact size and manufacture of the guided horizontal drilling system is at the discretion of the contractor. Contractor's selection shall consider the overall project requirements and the anticipated ground damage, digging conditions, water conditions, fence locations, tree conflicts, noise abatement, and seasons of the year and restoration of work area.

The contractor shall furnish the following information;

The guided horizontal drilling system provided shall have the following minimum capabilities: (contractor to fill in blanks)

- Thrust and pullback _____
- Spindle torque _____
- Drilling fluid pressure and flow rate _____

GUIDANCE AND LOCATION

Contractor shall keep the drill head on line and within the maximum deviations from the planned installation.

The contractor shall furnish the following information;

- Maximum lateral (horizontal) deviation _____
- Maximum vertical deviation _____

A Magnetic Guidance System (MGS) or proven gyroscopic system shall be used to provide a continuous and accurate determination of the location of the drill head during the drilling operation. The guidance shall be capable of tracking at all depths up to eighty feet and in any soil condition, including hard rock. It shall enable the driller to guide the drill head by providing immediate information on the tool face, azimuth (horizontal direction), and inclination (vertical direction) the guidance system shall be accurate to +/-2% of the vertical depth of the borehole at sensing position at depths up to one hundred feet and accurate within 4 feet horizontally. The guidance system shall be of a proven type and shall be operated by personnel trained and experience with this system. The operator shall be aware of any magnetic anomalies on the surface of the drill path and shall consider such influences in the operation of the guidance system if using a magnetic system.

Bore Tracking and Monitoring:

At all times during the pilot bore the Contractor shall provide and maintain a bore tracking system that is capable of accurately locating the position of the drill head in the x, y, and z axes. The Contractor shall record these data at least once per drill pipe length of every twenty five (25) feet, whichever is most frequent.

NAPERVILLE PUBLIC UTILITIES DEPARTMENT	SPECIFICATION FOR THE INSTALLATION OF HDPE CONDUIT BY THE HORIZONTAL DRILLING SYSTEM (HDD)	DATE: 02-19-08
ELECTRIC STANDARDS		PAGE: 12 OF 25
		C30-1950

PROJECT TITLE				ROUTE 59 ROAD IMPROVEMENTS			
PROJECT DESCRIPTION							
DETAILS AND STANDARDS							
ENGINEER	DRAFTING DATE	MAP #	SCALE				
BCC	5-11-12	4211,4212,4223	N.T.S.				
GIS DESIGN BY	DRAFTED BY	REVISIONS DATE	AT&T JOINT AGREEMENT #	PROJECT #			
DL	PSM		N/A	EU-12			
CHECKED BY	APPROVED BY	CAD FILE	SHEET #				
		0060648001D46.DWG	46 OF 63				
Naperville			Department of Public Utilities			ELECTRIC DIVISION	
						WORK REQUEST #	
						60468	

F.A.P. RTE.	SECTION	COUNTY	TOTAL SHEETS	SHEET NO.
338/IL 59	-2011-035-1-	DUPAGE		
			CONTRACT 60P42	
FED.ROAD.DIST.NO.	ILLINOIS	FED. AID PROJECT		

Guided Horizontal Drilling System (HDD) (Continued)

Down hole and Surface Grid Tracking System:

Contractor shall monitor and record x, y, and z coordinate relative to an established surface survey bench mark. The data shall be continuously monitored and recorded at least once per drill pipe-length or at twenty five (25) feet, whichever is more frequent.

Deviations between the recorded and design bore path shall be calculated and reported on the daily log. If the deviations exceed plus or minus 5 feet (horizontal or vertical deviation) from the design path, such occurrences shall be reported immediately to DPU-E. The Contractor shall undertake all necessary measures to correct deviations and return to design line and grade.

Drilling Fluid Pressures and Flow Rates:

Drilling fluid pressures and flow rates shall be continuously monitored and recorded by the Contractor. The pressures shall be monitored at the pump. These measurements shall be made during pilot bore drilling, reaming and pullback operations.

Drill Path:

Prior to drilling Contractor shall utilize all verified locate information to determine drill pathway. Marked up drawings (see site preparation paragraph) shall be on site at all times, and referred to during the drill operation.

Guidance System:

Contractor shall provide and maintain instrumentation necessary to accurately locate the pilot hole (both horizontal and vertical displacements), measure pilot string tensional and axial and measure drilling fluid discharge rate and pressure. The DPU-E Representative shall have access to instrumentation and reading at all times during operation.

Pilot Hole:

The pilot hole shall be drilled along the path shown on the plans and profile drawings or as directed by the DPU-E Representative in the field. Unless approved otherwise by DPU-E, the pilot hole tolerances shall be as follows:

Elevation:

As shown on the plans.

Alignment:

±5 feet and within 3 feet of right-of-way or easement boundary.

Curve Radius:

The pilot hole radius shall be no less than 80% of the maximum bending radius as recommended by the pipe manufacturer of the pipe being installed. In no case shall the bending radius be less than 30 pipe diameter, unless approved otherwise by DPU-E.

Entry Point Location:

The exact pilot hole entry point shall be within ±5 feet of the location shown on the drawing or as directed by the DPU-E Representative in the field.

Exit Point Location:

The exit point location shall be within ±5 feet of the location shown on the drawing or as directed by the DPU-E Representative in the field.

Limitations on Depth:

If not noted on the plans, 5" and 6" HDPE pipe and smaller shall be installed with a depth of 6 feet and 3" HDPE pipe shall be installed with a depth of 3 feet to 6 feet unless it is required to install the pipe deeper due to utility conflicts. Where utilities cross under roads, the depth of cover shall be a minimum of 7' to top of conduit.

Water Main and Non-Water Main Separation Requirements:

The minimum separation requirement between HDPE conduit and a water main shall be 18" minimum.

NAPERVILLE PUBLIC UTILITIES DEPARTMENT	SPECIFICATION FOR THE INSTALLATION OF HDPE CONDUIT BY THE HORIZONTAL DRILLING SYSTEM (HDD)	DATE: 02-19-08 PAGE: 13 OF 25 C30-1950
--	--	--

Guided Horizontal Drilling System (HDD) (Continued)

Pull Back:

After successfully reaming bore hole to the required diameter, Contractor will pull the pipe through the bore hole. In front of the pipe will be a swivel and reamer to compact bore hole walls. Once pull-back operations have commenced, operations must continue without interruption until pipe is completely pulled into bore hole. During pull-back operations Contractor will not apply more than the maximum safe pipe pull pressure at any time. Maximum allowable tensile force imposed on the pull section shall be equal to 80% of the pipe manufacturer's safety pull (or tensile) strength.

Torsional stress shall be minimized by using a swivel to connect a pull section to the reaming assembly. The pull-back section of the pipeline shall be supported during pull-back operations so that it moves freely and the pipe is not damaged. External pressure shall be minimized during installation of the pull-back section in the reamed hole. Damaged pipe resulting from external pressure shall be replaced at no cost to the DPU-E. Buoyancy modification shall be at the discretion of the Contractor and shall be approved by the DPU-E Representative. The Contractor shall be responsible for any damage to the pull section resulting from such modifications. In the event that pipe becomes stuck, Contractor will cease pulling operations to allow any potential hydro-lock to subside and will commence pulling operations. If pipe remains stuck, Contractor will notify DPU-E Representative. DPU-E Representative and Contractor will discuss options and then work will proceed accordingly. For HDPE pipe with a pulling length greater the 500 LF, the Contractor shall utilize a break-away link. Contractor shall provide a break-away link between the swivel and the pipe or a combination swivel and break link. Break-away link shall be rated at 80% of pipe manufacturer's safe pull (tensile) strength. Break pins shall be color coded for easy identification. Contractor shall provide rated break-away link for each material and pipe size(s) for the project.

Drilling Operation:

The alignment for drilling the pilot hole and installing the conduit are as specified on the drawing. (Size of conduit, length, location and number of duct in pull) the allowable lateral and vertical deviations are as specified by the contractor above. A boring/drilling head shall be used that is compatible with the expected soil conditions and as specified above.

Entrance and exit angles for drilling operation can be whatever the contractor desires such that the elevation profile for the conduit is maintained. See limit of conduit bend radius

The pilot shall be backed reamed to a diameter suitable for the installation of the various conduit sections required

The contractor to furnish the following information;

Reamed diameter for one 3, 5, or 6 inch HDPE conduit _____

Reamed diameter for two 3, 5 or 6 inch HDPE conduit _____

Reamed diameter for three 3, 5, or inch HDPE conduit _____

Reamed diameter for four 3, 5 or 6 inch HDPE conduit _____

Reamed diameter for six 3, 5 or 6 inch HDPE conduit _____

Drilling Fluids:

The composition of the drilling fluids shall be submitted to the owner for approval prior to utilization. No fluid will be approved or utilized that does not comply with permit requirements and environmental regulations.

Composition of Drilling Fluids with MSD sheets _____

NAPERVILLE PUBLIC UTILITIES DEPARTMENT	SPECIFICATION FOR THE INSTALLATION OF HDPE CONDUIT BY THE HORIZONTAL DRILLING SYSTEM (HDD)	DATE: 02-19-08 PAGE: 14 OF 25 C30-1950
--	--	--

Guided Horizontal Drilling System (HDD) (Continued)

Mixing system:

a self-contained, closed, drilling fluid mixing system shall be of sufficient size to mix and deliver drilling fluid. Mixing system shall continually agitate the drilling fluid during operations.

Drilling Fluids:

Drilling fluid shall be composed of clean water, appropriate additives and clay. Water shall be from an authorized source with a minimum pH of 6.0. Water of a lower pH or with excessive calcium shall be treated with the appropriate amount of sodium carbonate or equal. The water and additives shall be mixed thoroughly and be absent of any clumps or clods. No potentially hazardous material maybe used in drilling fluid.

Delivery System:

The delivery system shall have filters in-line to prevent solids from being pumped into the drill pipe. Connections between the pump and drill pipe shall be relatively leak-free. Used drilling fluid and drilling fluid spilled during drilling operations shall be contained and conveyed to the drilling fluid recycling system. A berm, minimum of 12" high, shall be maintained around drill rigs, drilling fluid mixing system entry and exit pits and drilling fluid cycling system to prevent spills into the surrounding environment. Pumps and or vacuum truck(s) of sufficient size shall be in place to convey excess drilling fluid from containment areas to storage and recycling facilities.

Drilling Fluid Recycling System:

The drilling fluid recycling system shall separate sand, dirt and other solids from the drilling fluid to render the drilling fluid re-usable. Spoils separated from the drilling fluid will be stockpiled for later use or disposal.

Control of Drilling fluids:

The Contractor shall follow all requirements of the Frac-Out and Surface Spill Contingency Plan as submitted and approved and shall control operational pressures, drilling mud weights, drilling speeds, and any other operational factors required to avoid hydro fracture fluid losses to formations, and control drilling fluid spillage. This includes any spillages or returns at entry and exit locations or at any intermediate point. All inadvertent returns or spills shall be promptly contained and cleaned up. The Contractor shall maintain on-site mobile spoil removal equipment during all drilling, pre-reaming, reaming and pull-back operations and shall be capable of quickly removing spoils. The Contractor shall immediately notify DPU-E of any inadvertent returns or spills and immediately contain and clean up the return or spill.

Disposal

Disposal of drilling fluids shall be the responsibility of the contractor and shall be conducted in compliance with all relative environmental regulations, right of way, work space agreements and permit requirements.

Drilling fluid returns shall be collected within the entrance pit, exit pit or spoils recovery pit. The contractor shall immediately clean up any inadvertent drilling fluid spills or overflows from these pits or equipment.

NAPERVILLE PUBLIC UTILITIES DEPARTMENT	SPECIFICATION FOR THE INSTALLATION OF HDPE CONDUIT BY THE HORIZONTAL DRILLING SYSTEM (HDD)	DATE: 02-19-08 PAGE: 15 OF 25 C30-1950
--	--	--

PROJECT TITLE					ROUTE 59 ROAD IMPROVEMENTS				
PROJECT DESCRIPTION					DETAILS AND STANDARDS				
ENGINEER	DRAFTING DATE	MAP #	SCALE						
BCC	5-11-12	4211,4212,4223	N.T.S.						
DESIGN BY	DRAFTED BY	REVISIONS DATE	AT&T JOINT AGREEMENT #	PROJECT #					
DL	PSM		N/A	EU-12					
CHECKED BY	APPROVED BY	CAD FILE	SHEET #						
		0060648001D147.DWG	47 OF 63						
Naperville			Department of Public Utilities			Electric Division		WORK REQUEST #	
						60468			

F.A.P. RTE.	SECTION	COUNTY	TOTAL SHEETS	SHEET NO.
338/IL 59	2011-035-1	DUPAGE		
FED.ROAD.DIST.NO.			ILLINOIS	
			CONTRACT 60P42	
			FED. AID PROJECT	

Guided Horizontal Drilling System (HDD) (Continued)

HDPE CONDUIT PREPARATION AND INSTALLATION:

Contractor shall install the HDPE conduit in accordance with the plans for a complete job and meet the completion date as defined by the city of Naperville.

Contractor to provide sketches of each staging area required to install the conduit, store materials, and setup equipment

All sketches shall be submitted to the city of Naperville for review prior to start of work. This sketch should include approximate square feet of area to be damaged by your construction work force.

The following parameters shall be recorded during the drilling, reaming, and installation, for each push, to ensure design limits are not exceeded.

- Calibrate electronic locator or guidance instrumentation before start of project.

- Locate drill head every 10 feet (minimum)

Depth _____
 Alignment _____
 Azimuth _____
 Pitch _____

- Record the following drilling information every 15 minutes or as necessary

Drilling fluid pressure _____
 Flow rate _____
 Mud weight in _____
 Mud weight out _____
 Rate of penetration _____
 Thrust _____
 Torque _____

- Pre-ream pilot hole

Record the following information every 15 minutes or as necessary

Mud weight in _____
 Mud weight out _____
 Rate of penetration _____
 Torque _____
 Depth _____
 Alignment _____

- Conduit installation

Record the following information every 15 minutes or as necessary

Fluid pressure _____
 Flow rate _____
 Mud weight in _____
 Mud weight out _____
 Rate of penetration _____
 Torque _____
 Depth _____
 Alignment _____

NAPERVILLE PUBLIC UTILITIES DEPARTMENT	SPECIFICATION FOR THE INSTALLATION OF HDPE CONDUIT BY THE HORIZONTAL DRILLING SYSTEM (HDD)	DATE: 02-19-08 PAGE: 16 OF 25 C30-1950
--	--	--

Guided Horizontal Drilling System (HDD) (Continued)

- Conduit quality check of conduit

Broken pieces _____
 Out of round, Oval _____
 End frayed _____
 Slit cracked or cut _____
 Belled end distorted _____
 Check specification identification on HDPE conduit _____

- Verify location and depth of HDPE conduit

Record data _____

Show detail with sufficient information _____

Contractor to submit for the owner's review the following 4 items with his bid:

A. Technical specifications and manufacture of guide horizontal drilling system, fluid handling system, guidance and locator system, reamed diameters for various duct configurations, maximum deviations from vertical and horizontal and minimum capabilities of thrust and pullback, spindle torque, drilling fluid pressure and flow rate, provide a schedule using Microsoft Project soft ware of latest edition

B. A work plan showing details and proposed method of construction, number of feet of one ,two ,three , four duct sections, or six duct sections to be installed in an eight hour day., sequence of operations to be performed, number , size and schedule of construction crew, time and hours and days to be worked in a week. Number of calendar days to complete work, pilot hole drilling procedure, reaming procedure, pulls back/conduit installation procedure, method of monitoring the drilling head and method of verifying conduit location and depth for as built drawings, plus restoration and landscaping plan

C. The contractor shall video tape the entire work area prior to starting the work. The video should document all vegetation condition of the easement and visual obstructions that the contractor will or temporarily move plus delineate with pictures the route with street names right of way and electrical equipment, address, time and date. This video shall be used to restore the work area landscaping to its original/or better condition

D The Contractor shall identify the following:
 Materials and quantities to be supplied,
 Vendor names supplying materials, equipment, tools and expertise.

After the pipe is in place, cleaning pig/mandrel shall be used to remove residual water and debris. After the cleaning operation, the Contractor shall provide and run a sizing pig/mandrel to check for anomalies in the form of buckles, dents, excessive out-of-roundness, and any other deformations. The sizing pig/mandrel run shall be considered acceptable if the survey results indicate that there are no sharp anomalies (e.g. dens, buckles, gouges, and internal obstructions) greater than 5 percent of the nominal pipe diameter. For gauging purposes, dent location is those defined above which occur within a span of five feet or less. Pipe ovality shall be measured as the percent difference between the maximum and minimum pipe diameter. For gauging purposes, ovality locations are those defined above which exceed a span of five feet

See mandrel requirements at end of this specification. The Contractor shall fabricate, purchase and use mandrel to proof rod all ducts for the entire project..

All conduits shall be subject to television inspection prior to acceptance. Television inspection may be identified at the preconstruction meeting, or later during the project if the inspector has any concerns about the proper installation of the pipe. If television inspection is required by the City, Contractor shall bear all costs incurred in making the inspection and shall bear all costs incurred correcting any deficiencies found during television inspection.

NAPERVILLE PUBLIC UTILITIES DEPARTMENT	SPECIFICATION FOR THE INSTALLATION OF HDPE CONDUIT BY THE HORIZONTAL DRILLING SYSTEM (HDD)	DATE: 02-19-08 PAGE: 17 OF 25 C30-1950
--	--	--

Guided Horizontal Drilling System (HDD) (Continued)

Deficiencies that will require pipe removal and replacement include, but are not limited to:

- Visible damage to the pipe.
- Failure of mandrel test.
- Oval pipe.
- Open joints.
- Foreign material that cannot be removed by other means.

After installation, contractor shall mark the plan drawings or provide new drawings to accurately show the actual installation and alignment of the conduit installed. This information shall be provided to the owner.

The Contractor shall satisfy himself as to all local conditions affecting the Work, including the location of underground facilities. He shall make a thorough examination of the Drawings, Specifications, and premises so that he will be entirely familiar with the details and construction of the installation. No charge for an extra shall be allowed where such extra is due to the Contractor's lack of observation or knowledge of local conditions.

The Contractor shall give his personal attention to the faithful prosecution of the Work and shall keep the same under his personal control. He shall maintain sufficient competent supervisory personnel at the job site at all times to represent the Contractor and to supervise and be responsible for the Work and conduct it in cooperation and in coordination with all other work being done on the premises. He shall maintain on the job as many competent foremen as are required to supervise the various operations. The Contractor shall correct at his own expense all errors in the Work arising from his inaccuracy or from the inaccuracy of his employees.

Directional drilling and pipe installation shall be done only by an experienced Contractor specializing in directional drilling and whose key personnel have at least five (5) years experience in this work. Furthermore, the Contractor shall have installed directionally drilled pipe at least as large as 20 inches in diameter, have performed crossings at least 2,000 feet in length, and successfully installed at least 100,000 feet in length.

All Work shall be executed by workmen or artisans who are skilled in their work or trade, and must be done in a neat and skillful manner as specified or detailed in the Contract and in accordance with the best construction practice.

The Contractor shall furnish and be responsible for all the equipment and methods used in the construction Work. The Contractor shall supply the documentation necessary to provide a permanent record of pulling tensions and all other items as related to the installation of the HDPE conduit. The Contractor shall develop a plan that will be reviewed by the engineer.

All roadways that are humped or sunk due to directional boring work shall be fixed immediately. The Contractor is advised to use a registered surveyor to shoot street elevation grade along the Conduit route crossing the street. The surveyor should establish at least 3 elevation points prior to installing any HDPE conduit in the street. The Contractor shall submit a paving plan and a Traffic Control plan along with the Company's name that will repair the street to the City of Naperville for approval. The Contractor is advised the MINIMUM REQUIREMENT is that the entire trench width of 4 feet from curb to curb shall be removed as if it was open cut. The contractor shall repair by removing all unsuitable soil and backfilling with compacted CA6. Replace the street with 12 inches of B.A.M, tact coat, and then with a 2 inch wearing surface or 10 inches of 4500 psi concrete, tact coat and 2 inches of wearing surface. Then the area 35 feet either side of the repair area for the width of the Street for a depth of 2 inches shall be removed by milling and cutting all edges square. The area is then prepared for an application of a 2 inch thick asphalt-wearing surface with tact coat and finished to level and grade. The street is marked to match the previous stripping and markings The curb and gutter on both sides of the street shall be removed and reinstalled for a length to the first control joint in either direction or 20 feet total on each side or which ever is smaller. However, the final acceptance and requirements shall come from the City of Naperville's Department of Public works. The Contractor is advised the work shall be inspected and approved and the field paving work completed prior to submitting the conduit work for payment.

NAPERVILLE PUBLIC UTILITIES DEPARTMENT	SPECIFICATION FOR THE INSTALLATION OF HDPE CONDUIT BY THE HORIZONTAL DRILLING SYSTEM (HDD)	DATE: 02-19-08 PAGE: 18 OF 25 C30-1950
--	--	--

PROJECT TITLE						ROUTE 59 ROAD IMPROVEMENTS					
PROJECT DESCRIPTION						DETAILS AND STANDARDS					
ENGINEER	DRAFTING DATE	MAP #	SCALE								
BCC	5-11-12	4211,4212,4223	N.T.S.								
DESIGN BY	DRAFTED BY	AT&T JOINT AGREEMENT #	PROJECT #								
DL	PSM	N/A	EU-12								
CHECKED BY	APPROVED BY	CAD FILE	SHEET #								
		0060648001D148.DWG	48 OF 63								
Naperville						Department of Public Utilities Electric Division					
						WORK REQUEST # 60468					

F.A.P. RTE.	SECTION	COUNTY	TOTAL SHEETS	SHEET NO.
338/IL 59	2011-035-1	DUPAGE		
			CONTRACT 60P42	
FED.ROAD.DIST.NO.		ILLINOIS	FED. AID PROJECT	

Guided Horizontal Drilling System (HDD) (Continued)

The Contractor when installing HDPE conduit is to limit the amount of conduit being ovoid by the installation process. The Conduit being pulled out from an installation at the exit pit shall be controlled so as not to oval the conduit. The conduit is required to be round to allow the installation of couplings, steel pipe, bends or schedule 40 PVC conduit. Force fitting of round conduit on to oval conduit is not acceptable. To provide a round connection for the HDPE, the HDPE has to be cut back to where the conduit is round. In the process of cutting the HDPE back a large amount of scrape can be generated. The Contractor is advised the Conduit supplied by the city is furnished 3% over the required amount to allow for some ovaling. In the event the amount of conduit scraped exceeds 3% the Contractor shall furnish and install all remaining HDPE conduit at the Contractors cost to finish the Project. The use of straight 40-foot lengths of HDPE is not acceptable.

Since some of the construction along the route shall be done in close proximity to existing energized conductors as well as lower voltage distribution circuits now in operation, due caution shall be taken to prevent accidental contact with or damage to any part of these lines, or any other overhead conductors or underground utilities encountered along the right-of-way. It shall be the Contractor's responsibility to locate all facilities by hand digging and /or machine aided digging as deemed necessary. The Contractor shall consider all electric lines overhead or underground Energized at all times.

The Contractor shall comply with the Occupational Safety and Health Act of 1970 (OSHA). The Contractor may obtain copies from the Regional Administrator of the Department of Labor, Dirksen Federal Office Building Chicago, Illinois 60690

Construction Drawings, showing the route of the HDPE conduit installation are attached and are part of this specification and no deviation from these shall be made without written approval from the Engineer.

The Contractor shall be responsible for all damages occurring on or off the right-of-way, including, fence, grass, flowers, vegetables, drain tile, drainage or lack of drainage, shrubs, sheds, buildings, tree, sidewalk, driveway and, crop damage, when such damage was necessary or not a necessary incident to the execution of the work or was occasioned by carelessness or neglect on the part of the Contractor. The Contractor shall obtain signed releases and waiver of liens from all property Owner's along the route of the conduit runs. The Contractor shall provide a completed and signed release form to the City of Naperville's for file. The form shall be used for this project. The Contractor shall submit a waiver of lien from every entity who could lawfully and/or possibly file a lien in excess of \$75 arising out of the Contract and related work. The City of Naperville reserves the right to designate which entities involved in the work must submit waivers

Where soil and sod has been removed, it shall be replaced as soon as possible after the backfilling is completed. All areas disturbed by work shall be restored to its original or better condition. The restoration shall include any necessary top soiling, fertilizing, liming, seeding, or mulching, as shown on the plans as removed/damaged. All such work shall be performed in accordance with the specifications as directed by the Engineer. The Contractor shall be held responsible for maintaining all disturbed surfaces and replacements until final acceptance. Restoration shall be considered incidental to the pay item of which it is a component part.

The Contractor will settle damages and obtain releases, releasing Company as well as Contractor, for damages as outlined above.

The approximate locations of existing roads in the vicinity of the work are shown on the drawings furnished by the Company. Any improvement, maintenance, repair or construction required on roads or easements by the Contractor in performing the work covered by the specification, or in traveling to and from the site of the work, shall be at the expense of the Contractor. Access to the work is from existing roads and easements. All other means of egress and ingress shall be provided by and at the expense of the Contractor.

NAPERVILLE PUBLIC UTILITIES DEPARTMENT	SPECIFICATION FOR THE INSTALLATION OF HDPE CONDUIT BY THE HORIZONTAL DRILLING SYSTEM (HDD)	DATE: 02-19-08 PAGE: 19 OF 25 C30-1950
--	--	--

Guided Horizontal Drilling System (HDD) (Continued)

High density polyethylene pipe is subject to conformance testing of fusion welds performed in the field. The Contractor shall ensure the field set-up and operation of the fusion equipment, and the fusion procedure used by the Contractor's fusion operator while on site. Upon request by the Engineer, the Contractor shall verify field fusion quality by making and testing a trial fusion weld. The trial fusion weld shall be allowed to cool completely; then test straps shall be cut out and bent strap tested in accordance with ASTM D2657. If the bent strap test of the trial fusion fails at the joint, the field fusions represented by the trial fusion shall be rejected. The Contractor shall make all necessary corrections to equipment, set-up, operation and fusion procedure, and shall re-make the rejected fusions at Contractor's expense.

The quantities shown on the "Unit Pricing Sheet" is approximations/estimates for comparing bids, and no claim shall be made against the Company for excess or deficiency therein, actual or relative. The Company shall be the final judge on completion and acceptance of the work. Within the first fifteen (15) days of each calendar month, the Company shall make partial payments to the Contractor for construction accomplished during the preceding calendar month or period on the basis of completed assembly units furnished and certified to by the Contractor, recommended by the Engineer and approved by the Company solely for the purposes of payment. However, that such approval by the Company shall not be deemed approval of the workmanship or materials. Ninety percent (90%) of each estimate approved for payment shall be paid by the Company to the Contractor of the work. However, that any time after work, which in the sole determination of the engineer, amounts to fifty percent (50%) of the maximum contract price has been completed, the Company may elect, in lieu of paying ninety percent (90%) of each subsequent estimate, to pay each subsequent estimate in full. The Invoice as submitted shall contain the following information:

- 1 Field record of work accomplished, horizontal drilling log sheet with item types, quantities, sketches, signed, dated, and attached to the invoice with WF#
- 2 Purchase order # and date
- 3 Vendor #
- 4 Project #
- 5 Project description.
- 6 Account #
- 7 Period of time invoice covers
- 8 Partial Payment number
- 9 Contractors name, address, telephone #, pager#, fax#, name of person submitting invoice, invoice number, invoice date, number of pages
- 10 Update resources paid and resources remaining on each invoice (a running total)
- 11 Update number of items installed and the number of items remaining. On each invoice (a running total)
- 12 Indicate quantities of each item, price per item, and price extension of each item
- 13 Include total payment in bottom portion of invoice. (A running total is also required.)
- 14 Include WF #
- 15 The invoice shall be supplied in triplicate to the Department of Public Utilities-Electric
- 16 The invoice shall be submitted on Contractors letterhead stationary.
- 17 Completed Signed Waivers of Lien shall accompany all invoices. Include material tickets.
- 18 A copy of the certified payroll for the period covered on the invoice shall be provided
- 19 The Invoice shall have attached an authorization letter, signed and dated of any work required but Not covered in the estimated units.
- 20 The Invoice shall include an address box showing payment to:
Bill To:
Accounts Payable P.O. Box 3020
Naperville ILL 60566-7020
Phone (630) 420-6111

NAPERVILLE PUBLIC UTILITIES DEPARTMENT	SPECIFICATION FOR THE INSTALLATION OF HDPE CONDUIT BY THE HORIZONTAL DRILLING SYSTEM (HDD)	DATE: 02-19-08 PAGE: 20 OF 25 C30-1950
--	--	--

Guided Horizontal Drilling System (HDD) (Continued)

Upon completion by the Contractor of the construction of the work, the Engineer with the assistance of the Contractor, if deemed necessary by the Engineer, shall prepare a final inventory of the work completed showing the total number, description, type of electrical equipment installed, lengths in feet, location and character of assembly units and, after checking such inventory with the Contractor, shall certify it to the Company, together with the total cost of the construction work performed. All invoices shall clearly state full assembly units installed, quantities, types, sizes, percentage of work completed and date completed.

Upon approval of such invoices by the Company, the Company shall make payment to the Contractor of all amounts to which the Contractor shall be entitled there under which shall not have been paid previously. Final payment shall be made not later than ninety (90) days after the completion of construction of the work, as specified, unless withheld because of the fault of the Contractor.

The Contractor shall be paid on the basis of the number of units actually installed at the direction of the Company shown by the inventory on the material tickets, specifications, and lists provided. However, the total cost shall not exceed the maximum contract price for the construction of the work as set forth in the bid award, unless such excess shall have been approved in writing by the Engineer and approved by the Company. The Company shall pay for no work under a verbal agreement or understanding that is not documented in writing and approved. No exceptions. This documentation shall accompany all payment requests for additional, less work or modifications to the work and performed and completed by the Contractor. Failure to document your claim of work with a signed city authorized employee's signature affixed to the invoice or document or approval letter will result in rejecting your invoice.

NAPERVILLE PUBLIC UTILITIES DEPARTMENT	SPECIFICATION FOR THE INSTALLATION OF HDPE CONDUIT BY THE HORIZONTAL DRILLING SYSTEM (HDD)	DATE: 02-19-08 PAGE: 21 OF 25 C30-1950
--	--	--

PROJECT TITLE				ROUTE 59 ROAD IMPROVEMENTS			
PROJECT DESCRIPTION				DETAILS AND STANDARDS			
ENGINEER	DRAFTING DATE	MAP #	SCALE				
BCC	5-11-12	4211,4212,4223	N.T.S.				
DESIGN BY	DRAFTED BY	REVISIONS DATE	AT&T JOINT AGREEMENT #	PROJECT #			
DL	PSM		N/A	EU-12			
CHECKED BY	APPROVED BY	CAD FILE	SHEET #				
		0060648001D149.DWG	49 OF 63				
Naperville			Department of Public Utilities Electric Division			WORK REQUEST #	
						60468	

GUIDED HORIZONTAL DRILLING SYSTEM (HDD) (CONTINUED)

HORIZONTAL DRILLING LOG SHEET

CITY OF NAPERVILLE DEPARTMENT OF ELECTRIC UTILITIES-ELECTRIC

DATE _____

LOCATION _____

LENGTH OF PUSH _____ FEET

DRILLER NAME _____ COMPANY

CONTRACTOR'S NAME _____ COMPANY

NUMBER AND SIZE OF HDPE CONDUIT IN PUSH _____

DRILLING EQUIPMENT TYPE AND SIZE _____

INSPECTOR'S NAME _____

WEATHER _____

W.F. _____

BRAND OF DRILLING FLUID _____

PUSH	STATION START	STATION FINISH	TIME HR/MIN	GUIDANCE				DRILLING FLUID				DRILLING PARAMETERS			COMMENTS (NOTES)		
				DISTANCE FT/IN	ANGLE DEGREE	DEPTH FT/IN	LEFT/RIGHT	FLUID	PRESSURE	FLOWRATE	MUD WEIGHT IN	MUD WEIGHT OUT	RPM	THRUST/PULL LBS		ROP	TORQUE FT-LBS
1																	
2																	
SIGNED BY CONTRACTOR _____

DATE _____

SIGNED BY INSPECTOR _____

DATE _____

R.O.P. - RATE OF PENETRATION

NOTES:

- 1) CONTRACTOR TO FILL OUT FORM FOR EACH PUSH AND DOCUMENT ALL WORK AND RETURN FILLED OUT FORM TO CITY.
- 2) IDENTIFY ALL FRAC' OUT, DOWN TIME, UNUSUAL DRILLING CONDITIONS, SOLID ROCK WORK ETC.
- 3) MSDS SHEET FOR DRILLING MUD SHALL BE SUPPLIED TO THE CITY PRIOR TO DRILLING.
- 4) THE CONTRACTOR SHALL LAYOUT THE ROUTE IN THE EASEMENT AND WITH IN THE PROPERTY LINES PRIOR TO STARTING WORK. ALL LAYOUT IS TO BE DOCUMENTED AND GIVEN TO THE CITY. THE CONTRACTOR SHALL ENGAGE A LICENSED LAND SURVEYOR TO PROVIDE ROUTE, RIGHT WAY OF WAY LIMITS, ELEVATIONS, LINE AND GRADE AND MEASUREMENTS OF DUCT INSTALLED.
- 5) THE ABOVE BORING LOG SHALL SHOW ALL UTILITY CROSSING, EXISTING STRUCTURES, OBSTRUCTION ENCOUNTERED OR OTHER LAND FEATURES.

NAPERVILLE PUBLIC UTILITIES DEPARTMENT ELECTRIC STANDARDS	SPECIFICATION FOR THE INSTALLATION OF HDPE CONDUIT BY THE HORIZONTAL DRILLING SYSTEM (HDD)	DATE: 02-19-08 PAGE: 22 OF 25 C80-1950
--	--	--

F.A.P. RTE. 338/IL 59	SECTION 2011-035-1	COUNTY DUPAGE	TOTAL SHEETS	SHEET NO.
FED.ROAD.DIST.NO.		ILLINOIS	CONTRACT 60P42 FED. AID PROJECT	

PROJECT TITLE ROUTE 59 ROAD IMPROVEMENTS				
PROJECT DESCRIPTION DETAILS AND STANDARDS				
ENGINEER BCC	DRAFTING DATE 5-11-12	MAP # 4211,4212,4223	SCALE N.T.S.	
GIS DESIGN BY DL	DRAFTED BY PSM	REVISIONS DATE	AT&T JOINT AGREEMENT # N/A	PROJECT # EU-12
CHECKED BY	APPROVED BY	CAD FILE 0060648001D150.DWG	SHEET # 50 OF 63	WORK REQUEST # 60468
Naperville Department of Public Utilities Electric Division				

F.A.P. RTE.	SECTION	COUNTY	TOTAL SHEETS	SHEET NO.
338/IL 59	2011-035-1	DUPAGE		
FED.ROAD.DIST.NO.			ILLINOIS	
			CONTRACT 60P42	
			FED. AID PROJECT	

GUIDED HORIZONTAL DRILLING SYSTEM (HDD) (CONTINUED)

PVC AND HDPE MATERIAL SPECIFICATION

**TABLE 1
RESIN PROPERTIES
(THE RESIN PROPERTIES SHALL BEET OR EXCEED THE VALUES LISTED BELOW FOR HDPE.)**

SDR 13.5-ASTM D3035/F2160/NEMA TC-7

ASTM TEST	DESCRIPTION	VALUES HDPE
D-1505	DENSITY g/cm ³	.941-.951
D-1238	MELT INDEX, g/10 MIN CONDITION E	.05-.50
D-790	FLEXURAL MODULUS, MPa (PSI)	80,000 MIN
D-638	TENSILE STRENGTH AT YIELD (PSI)	3000 MIN
D-1693	ENVIRONMENTAL STRESS CRACK RESISTANCE CONDITION B,F ₁₀	96 HR.MIN.
D-746	BRITTLINESS TEMPERATURE	-75°C

**TABLE 2
HDPE SPECIFICATION
STANDARD LENGTH AND SIZE - REELS AND COILS FOR HDPE**

NOM. SIZE	NOM. ID	NOM.OD OD	MIN.WALL OD	WEIGHT 100 FT.	PULL TENSILE SAFE LBS.	COLOR	TYPE	WALL	REEL SIZE	REEL LENGTH (FT.) NOTE 5	FULL WT./EA. (LBS.) REEL
3"	2.982	3.500	0.259	113.120	2945	BLACK	S/S	SDR 13.5	96X45X68	1000	1364
									102X54X64	1500	1945
									114X45X85	1500	2100
5"	4.738	5.562	0.412	285.394	7444	BLACK	S/S	SDR 13.5	114X45X85	480	1842
									120X45X78	550/750	2067/2637
6"	5.643	6.625	0.491	405.869	10566	BLACK	S/S	SDR 13.5	120X45X85	450/500	2296/2525

**TABLE 3
SCHEDULE 40 PVC SPECIFICATION**

NOM. SIZE	NOM. ID	NOM.OD OD	MIN.WALL WALL	WEIGHT 100 FT.	PULL TENSILE SAFE LBS.
3"	3.068	3.500	0.216	95.591	2488
5"	5.046	5.562	0.258	184.410	4801
6"	6.065	6.625	0.280	239.415	6233


- NOTES:**
- 1) HDPE DUCT IS SMOOTH WALL TYPE. SMOOTH INTERIOR AND SMOOTH EXTERIOR.
 - 2) ALL REELS AND NON-RETURNABLE STEEL REELS
 - 3) ASTM F 2160 - SOLID WALL HIGH DENSITY POLYETHYLENE (HDPE) CONDUIT BASED ON CONTROLLED OUTSIDE DIAMETER (OD).
ASTM D 2239 - POLYETHYLENE (PE) PLASTIC PIPE (SIDR) BASED ON CONTROLLED INSIDE DIAMETER.
ASTM D 3035 - POLYETHYLENE (PE) PLASTIC PIPE (SDR) BASED ON CONTROLLED OUTSIDE DIAMETER.
NEMA TC-7 - SMOOTH WALL COILABLE POLYETHYLENE ELECTRICAL PLASTIC CONDUIT.
 - 4) S/S - SMOOTH INSIDE SURFACE AND SMOOTH OUTSIDE SURFACE.
 - 5) LENGTHS ARE ±10%.

PULL TENSILE SAFE-BASED ON PLASTIC PIPE INSTITUTE TENSILE CALCULATIONS AND MAXI MAXIMUM TENSILE STRESS RECOMMENDATION OF 1/3 YIELD TENSILE FOR PULLS OF 30 TO 60 MINUTES APPLICATIONS AND PULLING.

NAPERVILLE PUBLIC UTILITIES DEPARTMENT	SPECIFICATION FOR THE INSTALLATION OF HDPE CONDUIT BY THE HORIZONTAL DRILLING SYSTEM (HDD)	DATE: 02-19-08 PAGE: 23 OF 25 C30-1950
--	--	--

GUIDED HORIZONTAL DRILLING SYSTEM (HDD) (CONTINUED)

MANDREL
CONTRACTOR TO PROVIDE THE FOLLOWING MANDREL.
CONTRACTOR TO FABRICATE OR PURCHASE MANDREL PER THIS DRAWING

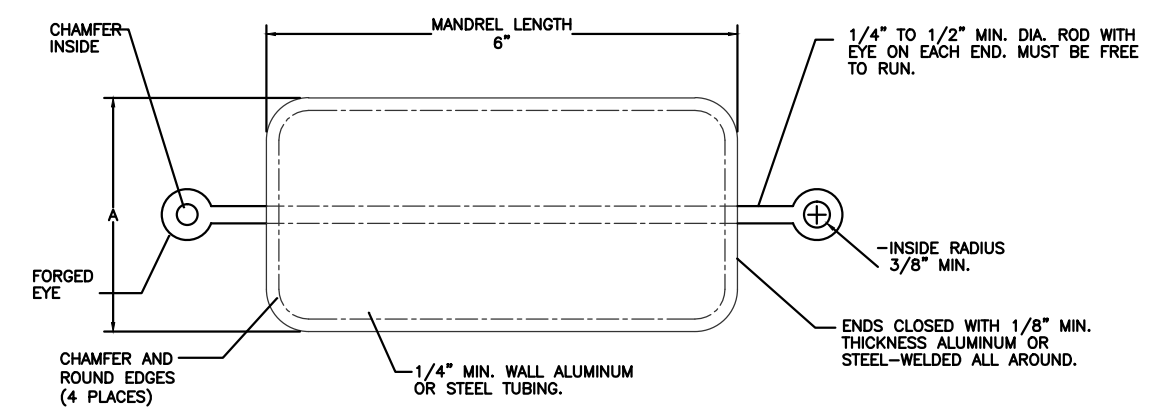

CONDUIT MANDREL DATA

NOM. CONDUIT SIZE	DIMENSION "A" (MANDREL LENGTH)		WEIGHT (LBS)
	TYPE I	TYPE II	
3"	2-3/4"	2.375"	2
5"	4-3/4"	4.400"	3
6"	5-3/4"	5.263"	4

- 1) TYPE I MANDRELS ARE USED IN SCHEDULE 40 PLASTIC CONDUITS.
- 2) TYPE II MANDRELS ARE ONLY TO BE USED IN SCHEDULE 80 AND HDPE PLASTIC CONDUITS.
- 3) CONTRACTOR TO FURNISH 3", 5" OR 6" MANDRELS IN THE QUANTITY REQUIRED TO COMPLETE THE PROJECT.

AVAILABLE FROM:
INWESCO, INC.
746 N. CONEY AV.
AZUSA, CA 91702
PHONE: (626) 334-9304
FAX: (626) 969-3404
CONTACT: DON SWEETAPPLE


NAPERVILLE PUBLIC UTILITIES DEPARTMENT	SPECIFICATION FOR THE INSTALLATION OF HDPE CONDUIT BY THE HORIZONTAL DRILLING SYSTEM (HDD)	DATE: 02-19-08 PAGE: 24 OF 25 C30-1950
--	--	--

PROJECT TITLE				ROUTE 59 ROAD IMPROVEMENTS			
PROJECT DESCRIPTION				DETAILS AND STANDARDS			
ENGINEER	DRAFTING DATE	MAP #	SCALE				
BCC	5-11-12	4211,4212,4223	N.T.S.				
DESIGN BY	DRAFTED BY	REVISIONS DATE	AT&T JOINT AGREEMENT #	PROJECT #			
DL	PSM		N/A	EU-12			
CHECKED BY	APPROVED BY	CAD FILE	SHEET #				
		0060648001D151.DWG	51 OF 63				
Naperville			Department of Public Utilities Electric Division			WORK REQUEST #	
						60468	

F.A.P. RTE.	SECTION	COUNTY	TOTAL SHEETS	SHEET NO.
338/IL 59	2011-035-1	DUPAGE		
FED.ROAD.DIST.NO.			ILLINOIS	
			CONTRACT 60P42	
			FED. AID PROJECT	

GUIDED HORIZONTAL DRILLING SYSTEM (HDD) (CONTINUED)

TYPICAL BORE FOR A CROSSING RIVER

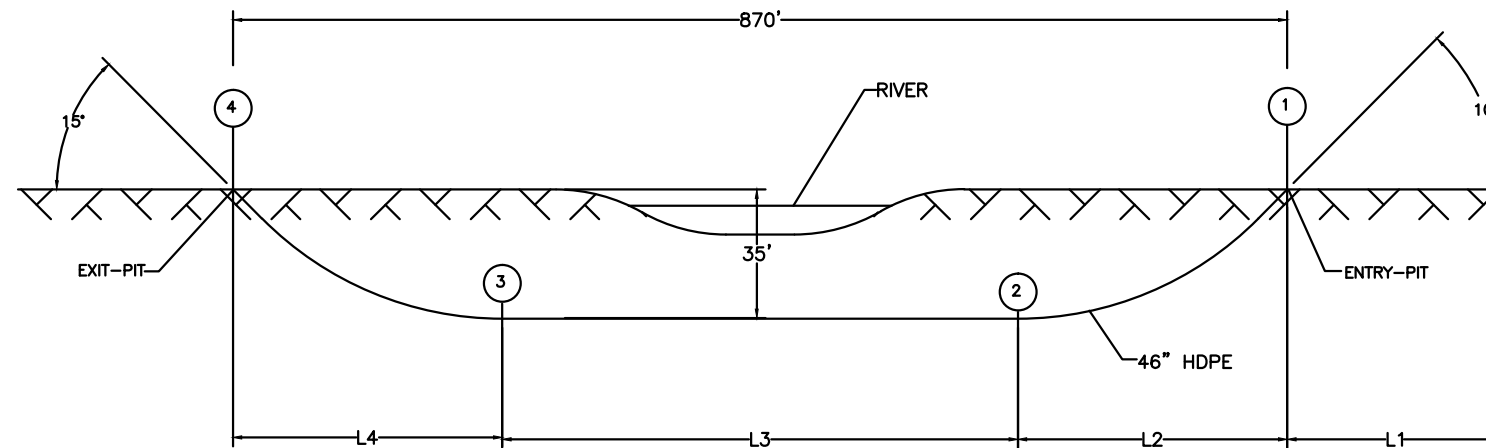

TYPICAL RIVER CROSSING, ASSUME THE HDPE PIPE IS 35' DEEP AND APPROXIMATELY 870' LONG WITH A 10 DEG. ENTRY ANGLE AND A 15 DEG. EXIT ANGLE. ACTUAL PULL BACK FORCE WILL VARY DEPENDING ON HACKREAMER SIZE SELECTION, AND USE; BORE HOLE STAYING OPEN; SOIL CONDITIONS; LUBRICATION WITH BENTONITE, DRILLER EXPERTISE, AND OTHER APPLICATION CIRCUMSTANCES.

- L1 = 100' DRAG.
- L2 = DISTANCE TO ACHIEVE DEPTH
- L3 = 870-L2-L4
- L4 = DISTANCE TO ACHIEVE DEPTH

MINIMUM BEND RADIUS AS A FUNCTION OF DIAMETER AND STANDARD DIMENSION RATIO

SDR 13.5				
SIZE	OD in.	WALL in.	MIN. RADIUS in.	WALL in.
3	3.500	.259	40.9	.226
5	-	-	-	-
6	6.625	.491	54.4	.427


OVALIZATION IS INDEPENDENT OF TENSILE STRENGTH OF MODULUS, BUT IS CONTROLLED BY DIAMETER, WALL THICKNESS AND BENDING RADIUS. THE RADIUS LISTED ABOVE ARE ESTIMATED, AS THE MINIMUM UNSUPPORTED BENDING RADIUS REQUIRED PRODUCING A 5% OVALIZATION. THE VALUES IN THE ABOVE TABLE ARE CALCULATED BASED ON MINIMUM WALL THICKNESS AND ARE A FIRST APPROXIMATION TO OVALITY IN THE BENDING CONDUIT (ACTUAL BENDING RADIUS MAY BE SLIGHTLY SMALLER).

OVALITY IS CALCULATED AS: OVALITY = [(MAX. OD-MIN. OD)/AVG. OD] X 100.

NAPERVILLE PUBLIC UTILITIES DEPARTMENT ELECTRIC STANDARDS	SPECIFICATION FOR THE INSTALLATION OF HDPE CONDUIT BY THE HORIZONTAL DRILLING SYSTEM (HDD)	DATE: 02-19-08 PAGE: 25 OF 25 C30-1950
--	--	--

PROJECT TITLE					ROUTE 59 ROAD IMPROVEMENTS									
PROJECT DESCRIPTION										DETAILS AND STANDARDS				
ENGINEER	BCC	DRAFTING DATE	5-11-12	MAP #	4211,4212,4223	SCALE	N.T.S.							
GIS DESIGN BY	DL	DRAFTED BY	PSM	REVISIONS DATE		AT&T JOINT AGREEMENT #	N/A		PROJECT #	EU-12				
CHECKED BY		APPROVED BY		CAD FILE	0060648001D152.DWG	SHEET #	52 OF 63							
Naperville					Department of Public Utilities Electric Division					WORK REQUEST # 60468				

EXISTING TRANSFORMER CONNECTION DETAIL

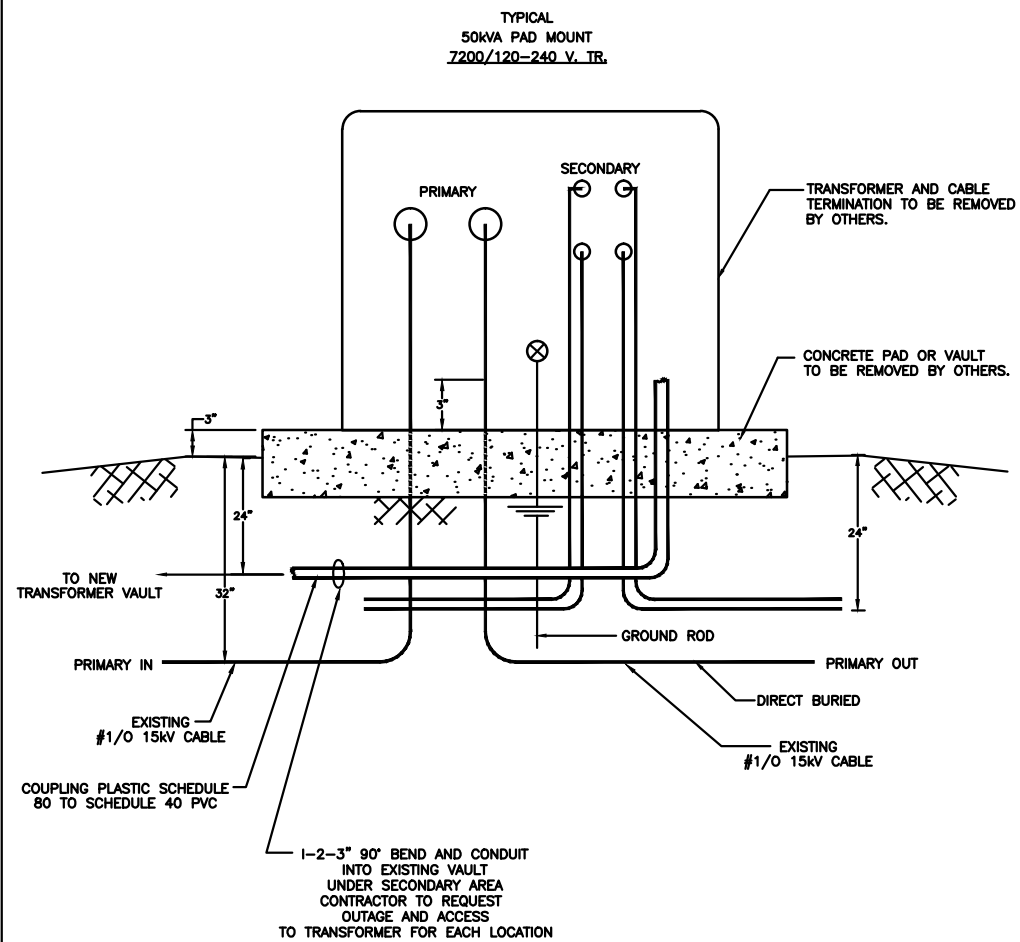


NOTES:

- THIS DRAWING SHOWS AN EXISTING TRANSFORMER WITH CABLE INSTALLED WITH MATERIAL LIST.
- CONTRACTOR TO OBTAIN OUTAGE OF TRANSFORMER PRIOR TO DOING ANY WORK.
- CONTRACTOR TO INSTALL 3", 5" AND 6" CONDUIT INTO EXISTING AS SPECIFIED IN SPECIFICATIONS CAP AND PLUGS ALL CONDUITS.
- ALL GROUNDING CONNECTIONS AND TERMINATORS SHALL BE INSPECTED TO DETERMINE CONDITION OF CONNECTIONS BY THE CONTRACTOR REPORT FINDING.

NAPERVILLE PUBLIC UTILITIES DEPARTMENT	EXISTING TRANSFORMER CONNECTION DETAIL	DATE: 04-04-06 Page 1 of 1 60468-600
--	---	--

INSTALL NEW TRANSFORMER VAULT (TYPICAL)

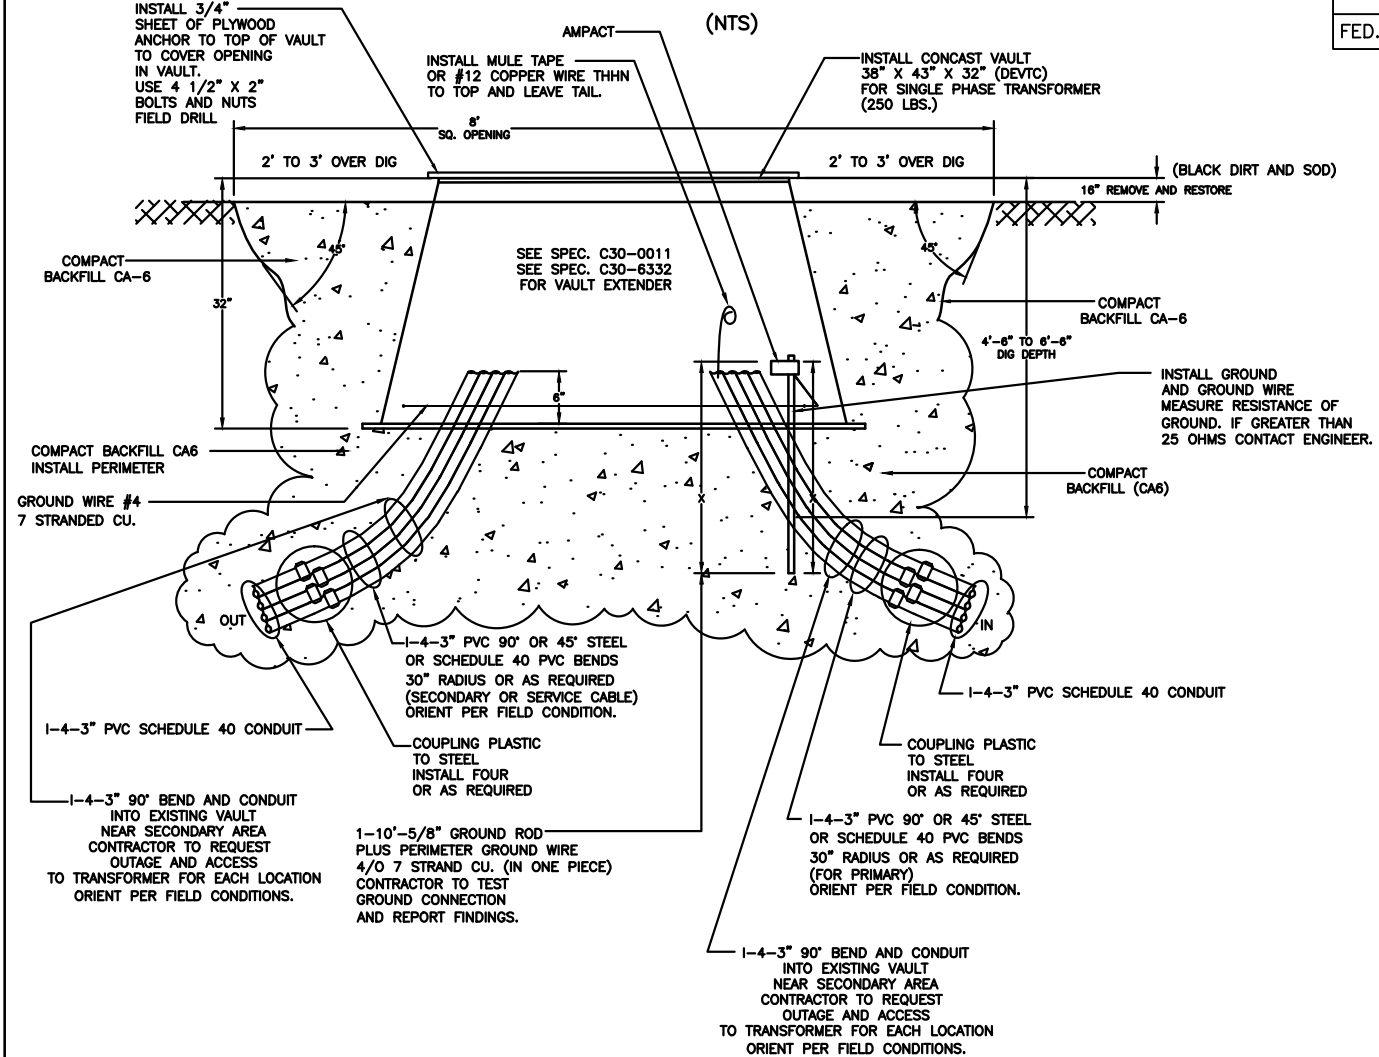

NOTES:

- INSTALL 3/4" CUT TO FIT PLYWOOD OVER OPENING HOLD DOWN WITH 4 BOLTS & NUTS 1/2" HOLES. FIELD DRILL VAULT AND POLYWOOD.
- ESTIMATED WEIGHT - 300 LBS.
- VAULT MATERIAL - FIBERCRETE FORMED.
- INSTALL TOP OF VAULT 6" ABOVE FINAL GRADE.
- INSTALL 2 TO 7 (3" DIA) SCHEDULE 40 90° ELBOWS OR 3" DIA GALVANIZED ELBOWS INTO VAULT. CONTACT CITY ELECTRICAL ENGINEER (630) 420-6190 FOR LOCATION OF THE ELBOWS IN THE VAULT AND ORIENTATION OF VAULT.
- INSTALL 1-5/8" DIA. X 10'-0" LONG GROUND RODS FOR EACH VAULT. LOCATE ONE ROD AT A CORNER. INSTALL 6" FROM THE CORNER. GROUND ROD TO BE DRIVEN 6" BELOW FINISHED GRADE.
- INSTALL PERIMETER GROUND WIRE #4/0, 7 STRANDS COPPER AND ATTACH TO ONE ROD. (ONE CONTINUOUS PIECE. APPROXIMATELY 16' OF WIRE).
- CONTRACTOR TO ESTABLISH ELEVATION AND LEVEL.
- CONTRACTOR SHALL SUPPORT AND REROUTE UTILITIES AS REQUIRED.
- CA-6 BACKFILL TO BE PLACED 360° AROUND TRANSFORMER VAULT MINUS SURFACE RESTORATION.
- ALL EXCAVATED MATERIAL TO BE REMOVED OFF SITE.
- BENDS TO BE INSTALLED PER FIELD CONDITIONS.
- CUT HOLE IN VAULT AS REQUIRED TO INSTALL CONDUIT.
- INSTALL PLUG FITTING AND TAPE ON ALL CONDUIT BENDS.
- INSTALL VAULT EXTENDER PER C30-6332 (DEVAE).

NAPERVILLE PUBLIC UTILITIES DEPARTMENT	INSTALL NEW TRANSFORMER VAULT (TYPICAL)	DATE: 04-04-06 Page 1 of 1 60468-610
--	--	--

PROJECT TITLE				ROUTE 59 ROAD IMPROVEMENTS			
PROJECT DESCRIPTION				DETAILS AND STANDARDS			
ENGINEER	DRAFTING DATE	MAP #	SCALE				
BCC	5-11-12	4211,4212,4223	N.T.S.				
GIS DESIGN BY	DRAFTED BY	AT&T JOINT AGREEMENT #	PROJECT #				
DL	PSM	N/A	EU-12				
CHECKED BY	APPROVED BY	CAD FILE	SHEET #				
		0060648001D153.DWG	53 OF 63				
Naperville			Department of Public Utilities Electric Division		WORK REQUEST #		
					60468		

A. APPLICABLE STANDARDS FOR SUBSTATION GROUNDING DESIGN


- ANSI/IEEE Std 80-1986 IEEE Guide for Safety in AC Substation Grounding
- NESC (NATIONAL ELECTRIC SAFETY CODE) All Applicable Sections.

B. TYPICAL GROUND GRID INFORMATION (taken from ANSI/IEEE Std 80-1986)

- Typical conductor spacing 10-50 ft. Grid should be equally spaced.
- Typical grids depths 12-18 inches.

C. SUBSTATION GROUND GRID STANDARD MATERIAL

IN STOCK ITEM	4/0 BARE CU WIRE	28010700070
IN STOCK ITEM	5/8" X 10'	28315600010
NOT STOCK ITEM	EXOTHERMAL WELD	N/A

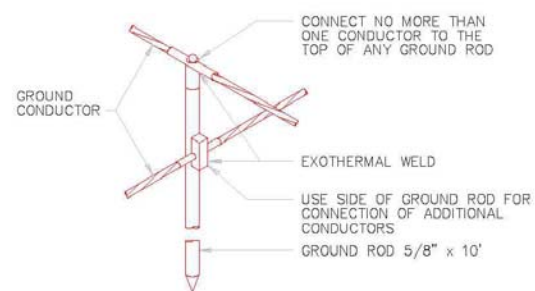

GROUND GRID TO GROUND ROD EXOTHERMAL CONNECTION
NO SCALE

D. EQUIPMENT GROUNDING STANDARD MATERIAL


- CONNECTORS ARE NON-STOCK ITEMS
 BURNDY HYGROUND SYSTEM OR EVALUATED EQUIVALENT
 REQUIRED TOOLS & DIES DPUE HAS PURCHASED
 BURNDY HYPRESS Y750BH
 BURNDY Y700DC-1B
 BURNDY Die#U289RT
 BURNDY Die # U997
 BURNDY UPRECRIMP 58

NOTE: If specified connectors cannot be crimped with the above noted tools and dies the necessary tools and dies will need to be purchased.

E. FENCE GROUNDING STANDARD MATERIAL AND INSTALLATION

NAPERVILLE PUBLIC UTILITIES DEPARTMENT ELECTRIC STANDARDS	GENERAL SUBSTATION GROUNDING REQUIREMENTS	DATE: 11/13/96 Page 1 of 2 C60-1110
--	--	--

IN STOCK ITEM	#2 BARE CU WIRE	28011200030
NOT STOCK ITEM	SPLIT BOLT CONNECTOR	N/A
NOT STOCK ITEM	TOP RAIL CONNECTOR	N/A
NOT STOCK ITEM	PERIMETER GATE CONNECTOR	N/A
NOT STOCK ITEM	GATE POST CONNECTOR	N/A
NOT STOCK ITEM	COPPER BRAID	N/A
NOT STOCK ITEM	LINE POST CONNECTOR	N/A
NOT STOCK ITEM	EXOTHERMAL WELD	N/A

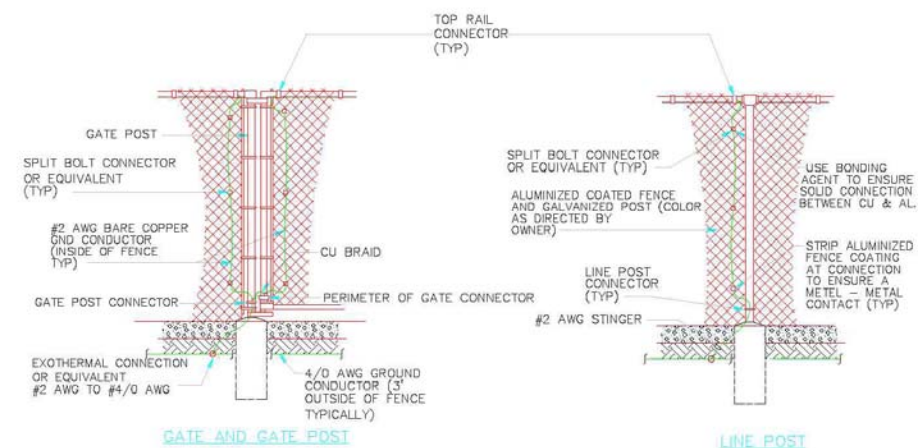

NOTE: GROUND LINE POSTS EVERY 30 FEET. CORNER POSTS ARE NOT GROUNDED. ALL GROUND CONNECTORS SHALL BE CONSTRUCTED TO ACCOMMODATE THE CU GROUND WIRE AND THE ALUMINIZED FENCE FABRIC. ALL CONNECTORS TO BE TIN PLATED.

GATE AND GATE POST

LINE POST

FENCE GROUNDING
NO SCALE

NAPERVILLE PUBLIC UTILITIES DEPARTMENT ELECTRIC STANDARDS	GENERAL SUBSTATION GROUNDING REQUIREMENTS	DATE: 11/13/96 Page 2 of 2 C60-1110
--	--	--

PROJECT TITLE					ROUTE 59 ROAD IMPROVEMENTS				
PROJECT DESCRIPTION					DETAILS AND STANDARDS				
ENGINEER	BCC	DRAFTING DATE	5-11-12	MAP #	4211,4212,4223	SCALE	N.T.S.		
GIS DESIGN BY	DL	DRAFTED BY	PSM	REVISIONS DATE	N/A	PROJECT #	EU-12		
CHECKED BY		APPROVED BY		CAD FILE	0060648001D154.DWG	SHEET #	54 OF 63		
Naperville					Department of Public Utilities Electric Division				
					WORK REQUEST # 60468				

F.A.P. RTE.	SECTION	COUNTY	TOTAL SHEETS	SHEET NO.
338/IL 59	2011-035-1	DUPAGE		
			CONTRACT 60P42	
FED.ROAD.DIST.NO.	ILLINOIS	FED. AID PROJECT		

FOUNDATION AGGREGATE
ILLINOIS DEPARTMENT OF TRANSPORTATION
(CAB OR CA9)

1. SCOPE

1.1 THIS SPECIFICATION COVERS FOUNDATION AGGREGATE CONSISTING OF CRUSHED STONE OR GRAVEL FOR USE IN STABILIZING OR SUSTAINING POLES AND STRUCTURES.

2. GENERAL

2.1 AGGREGATE SUPPLIED UNDER THE SPECIFICATION SHALL COMPLY WITH ILLINOIS DEPARTMENT OF TRANSPORTATION SPECIFICATION, FOR GRADE CAB (OR GRADE CA9 COARSE AGGREGATE) LATEST REVISION.

3. PHYSICAL PROPERTIES

3.1 GRADATION - THE AGGREGATE SHALL BE MIXED UNIFORMLY, SHALL BE WELL GRADED FROM THE MAXIMUM TO MINIMUM SIZE BETWEEN THE LIMITS SPECIFIED, AND WHEN TESTED WITH LABORATORY SIEVES (SQUARE OPENINGS), SHALL CONFORM TO THE GRADATION GIVEN IN THE FOLLOWING TABLE, WHICH SHOWS THE TOTAL PERCENTAGE PASSING EACH SIEVE.

	PERCENTAGE BY WEIGHT PASSING SIEVE				
	1"	1/2"	#4	#16	#200
CAB	97±3	55±10	10±5	3±3	-
CA9	97±3	60±15	30±15	10±10	6±6

3.2 DELETERIOUS SUBSTANCES - THE AGGREGATE SHALL CONSIST OF TOUGH, DURABLE PARTICLES, REASONABLY FREE FROM AN EXCESS OF SOFT AND UNSOUND MATERIAL AND OTHER OBJECTIONABLE MATTER.

3.3 OTHER PROPERTIES - AGGREGATE SUPPLIED UNDER THIS SPECIFICATION SHALL BE CAPABLE OF PASSING THE REQUIREMENTS FOR SOUNDNESS, RESISTANCE TO ABRASION, FREEZING AND THAWING AND LACK OF EXCESSIVE REACTIVE MATERIALS AS LISTED IN ASTM SPECIFICATION C33. THESE TESTS WILL BE ORDERED ON AGGREGATE OF QUESTIONABLE QUALITY ONLY WHEN THE SIZE OF THE SQUARE OF THE AGGREGATE AND THE POSSIBILITY OF IDENTIFYING FUTURE DELIVERIES FROM THIS SQUARE JUSTIFY SUCH TESTS.

NAPERVILLE PUBLIC UTILITIES DEPARTMENT ELECTRIC STANDARDS	FOUNDATION AGGREGATE ILLINOIS DEPARTMENT OF TRANSPORTATION (MATERIAL SPECIFICATION)	DATE: 06-01-05 Page 1 of 2 60468-900
--	---	--

4. SAMPLING

4.1 SEPARATE SAMPLES SHALL BE TAKEN FROM DIFFERENT PARTS OF THE STOCK PILE. THIS SHOULD BE DONE TO OBTAIN A COMPOSITE SAMPLE REPRESENTING THE AVERAGE OF THE PILE. AFTER THOROUGHLY MIXING THE COMPOSITE SAMPLE, IT SHALL BE Poured THROUGH THE SAMPLE CUTTER TO REDUCE ITS SIZE TO THAT REQUIRED FOR THE TESTS. THE BALANCE SHALL BE DISCARDED.

5. TESTING

5.1 THE PROPERTIES SPECIFIED IN THIS SPECIFICATION SHALL BE DETERMINED BY TESTS LISTED IN ASTM SPECIFICATION C33 OF LATEST ISSUE.

6. PACKAGING

6.1 THIS MATERIAL WILL BE PURCHASED EITHER IN BULK OR WEATERPROOF BAGS. "50 LBS. BAGS".

7. SUPPLEMENTARY SPECIFICATIONS

7.1 ASTM SPECIFICATION C33-90 OR LATEST REVISION.

8. ACCEPTANCE

8.1 ALL PROVISIONS OF THE PURCHASE ORDER SHALL APPLY.

9. CONSTRUCTION INFORMATION

9.1 THE CONTRACTOR SHALL FURNISH ALL ITEMS ON THIS SPECIFICATION.

NAPERVILLE PUBLIC UTILITIES DEPARTMENT ELECTRIC STANDARDS	FOUNDATION AGGREGATE ILLINOIS DEPARTMENT OF TRANSPORTATION (MATERIAL SPECIFICATION)	DATE: 06-01-05 Page 2 of 2 60468-900
--	---	--

INSTRUCTION FOR INSTALLING AND FURNISHING RIP-RAP

THE CONTRACTOR SHALL FURNISH, INSTALL, REMOVE AND REPLACE RIP RAP OF THE TYPE AND SEE AT THE LOCATION SHOWN ON THE PLANS, OR AS DIRECTED BY THE ENGINEER. PROPOSED RIP RAP SHALL BE GRADATION #3, 12" MINIMUM THICKNESS. RIP RAP SHALL BE IN ACCORDANCE WITH SECTION 281 OF THE IDOT STANDARD SPECIFICATIONS OF LATEST ISSUE.

RIP RAP INSTALLATION REMOVAL AND REPLACEMENT WILL BE MEASURED FOR PAYMENT IN PLACE, AND THE AREA COMPUTED IN SQUARE YARDS.

THE WORK FOR RIP RAP IN PLACE OF THE TYPE SHOWN ON THE PLANS AND SPECIFIED HEREIN OR AS SHOWN ABOVE SHALL INCLUDE ALL MATERIAL, LABOR, EQUIPMENT RESTORATION AND APPURTENANCES REQUIRED FOR A COMPLETE ITEM PLUS LEVELING AND GRADING.

NAPERVILLE PUBLIC UTILITIES DEPARTMENT ELECTRIC STANDARDS	INSTRUCTION FOR INSTALLING AND FURNISHING RIP-RAP	DATE: 06-01-05 Page 1 of 1 60468-910
--	---	--

COARSE AGGREGATE

1. SCOPE

1.1 THIS SPECIFICATION COVERS COARSE AGGREGATE CONSISTING OF CRUSHED STONE OR GRAVEL FOR USE IN CONCRETE.

2. GENERAL

2.1 COARSE AGGREGATE SUPPLIED UNDER THIS SPECIFICATION SHALL COMPLY WITH ASTM SPECIFICATION C33-90 OF LATEST REVISION.

3. PHYSICAL PROPERTIES

3.1 GRADING - THE COARSE AGGREGATE SHALL BE WELL GRADED BETWEEN THE FOLLOWING LIMITS:

SIZE NO.	NOMINAL SIZE	PERCENTAGE BY WEIGHT PASSING SIEVE						
		1"	3/4"	1/2"	3/8"	#4	#8	#16
8	3/8" TO #8	-	-	100	85 TO 100	10 TO 30	0 TO 10	0 TO 5
7	1/2" TO #4	-	100	90 TO 100	40 TO 70	0 TO 15	0 TO 5	-
67	3/4" TO #4	100	90 TO 100	-	20 TO 55	0 TO 10	0 TO 5	-

3.2 DELETERIOUS SUBSTANCES (CLASS 3S) - THE AMOUNT OF DELETERIOUS SUBSTANCES IN COARSE AGGREGATE SHALL NOT EXCEED THE FOLLOWING ITEM.

ITEM	MAXIMUM PERMISSIBLE PERCENTAGE BY WEIGHT OF TOTAL SAMPLE
CLAY LUMPS AND FRIABLE PARTICLES	5.0
SUM OF CLAY LUMPS, FRIABLE PARTICLES AND CHERT	7.0
COAL AND IGNITE	0.5
MATERIAL FINER THAN #200 SIEVE	1.0

3.3 OTHER PROPERTIES - COARSE AGGREGATE SUPPLIED UNDER THIS SPECIFICATION SHALL BE CAPABLE OF PASSING THE REQUIREMENTS FOR SOUNDNESS, RESISTANCE TO ABRASION, FREEZING AND THAWING AND LACK OF EXCESSIVE REACTIVE MATERIALS AS LISTED IN ASTM SPECIFICATION C33. THESE TESTS WILL BE ORDERED ON COARSE AGGREGATE OF QUESTIONABLE QUALITY ONLY WHEN THE SIZE OF THE SOURCE OF THE AGGREGATE AND THE POSSIBILITY OF IDENTIFYING FUTURE DELIVERIES FROM THIS SOURCE JUSTIFY SUCH TESTS.

3.4 WEIGHT - THE QUANTITY IS IN TONS. UNIT OF ISSUE IS POUNDS. THE WEIGHT SHOULD BE DETERMINED AS LOADED IN THE HAULING UNIT, INCLUDING ANY NATURAL MOISTURE PRESENT. DO NOT ADD WATER.

NAPERVILLE PUBLIC UTILITIES DEPARTMENT ELECTRIC STANDARDS	COARSE AGGREGATE (MATERIAL SPECIFICATION)	DATE: 06-01-05 Page 1 of 2 60468-920
--	--	--

4. SAMPLING

4.1 SEPARATE SAMPLES SHALL BE TAKEN FROM DIFFERENT PARTS OF THE STOCK PILE. THIS SHOULD BE DONE TO OBTAIN A COMPOSITE SAMPLE REPRESENTING THE AVERAGE OF THE PILE. AFTER THOROUGHLY MIXING THE COMPOSITE SAMPLE, IT SHALL BE Poured INTO A PILE AND QUARTERED IN FOUR EQUAL PARTS. OPPOSITE QUARTERS SHALL BE DISCARDED, AND THE QUARTERING REPEATED UNTIL THE DESIRED SAMPLE REMAINS.

5. TESTING

5.1 THE PROPERTIES SPECIFIED IN THIS SPECIFICATION SHALL BE DETERMINED BY TESTS LISTED IN ASTM SPECIFICATION C33 OF LATEST REVISION.

5.2 ALL TEST RESULTS AND SAMPLES SHALL BE DELIVERED TO THE DEPARTMENT OF PUBLIC UTILITIES (ELECTRIC) 1392 AURORA AV, NAPERVILLE, IL. 60540.

6. SUPPLEMENTARY SPECIFICATIONS

6.1 ASTM SPECIFICATION C33-90 OR LATEST REVISION.

7. ESTIMATED WEIGHT

7.1 WEIGHT PER CUBIC FOOT.

COARSE AGGREGATE - 90 LBS. - 95 LBS. LOOSE
130 LBS. DRY COMPACTED
140 LBS. WET COMPACTED
OPTIMUM MOISTURE

NOTE: THE ABOVE WEIGHTS ARE FOR ESTIMATING PURPOSES ONLY. FOR EXACT WEIGHTS USE LABORATORY TEST RESULTS.

8. ACCEPTANCE

8.1 ALL PROVISIONS OF THE PURCHASE ORDER SHALL APPLY.

9. CONSTRUCTION INFORMATION

9.1 THE CONTRACTOR SHALL FURNISH ALL ITEMS ON THIS SPECIFICATION.

NAPERVILLE PUBLIC UTILITIES DEPARTMENT ELECTRIC STANDARDS	COARSE AGGREGATE (MATERIAL SPECIFICATION)	DATE: 06-01-05 Page 2 of 2 60468-920
--	--	--

INSTRUCTION FOR INSTALLING, REMOVAL AND REPLACEMENT OF BITUMINOUS PAVEMENT (TYPE-II)

THIS ITEM SHALL CONSIST OF SAW CUTTING THE EXISTING PAVEMENT; THE REMOVAL OF EXISTING BITUMINOUS PAVEMENT (12" TO 18" MINIMUM) ABOVE THE MILLING SURFACE THE INSTALLATION OF BITUMINOUS SURFACE MIX THAT MATCHES THE EXISTING TYPICAL SECTION OF THE ROADWAY IN CONFORMANCE WITH PROVISIONS SET FORTH IN THESE DOCUMENTS, AT LOCATIONS WHERE THE PROPOSED IMPROVEMENT CROSSES OR PARALLELS BITUMINOUS ROADWAYS, AS DETAILED IN THESE PLANS.

BITUMINOUS MATERIAL USED TO COMPLETE THIS ITEM OF WORK SHALL CONFORM TO SECTION 406 OF THE STANDARD SPECIFICATIONS, MORE SPECIFICALLY THE BITUMINOUS CONCRETE SHALL BE CLASS 1 SURFACE COURSE, TYPE 2, MIXTURE D.

AFTER SAW CUTTING, ALL LOOSE AND UNSOUND MATERIAL SHALL BE REMOVED FROM THE REPLACEMENT AREA BY MEANS OF PNEUMATIC, MECHANICAL, OR OTHER TOOLS AS WELL BE ACCEPTABLE TO THE ENGINEER. MATERIALS REMOVED FROM THE REPAIR AREA SHALL BE DISPOSED OF BY THE CONTRACTOR OFF THE JOBSITE, UNLESS OTHERWISE DIRECTED BY THE ENGINEER.

AREAS OF UNSOUND BASE OR SUB-BASE SHALL BE IDENTIFIED, MEASURED, AND THE ENGINEER SHALL BE NOTIFIED A TEMPORARY PATCH MAY BE REQUIRED.

THE OPENINGS SHALL BE PROTECTED WITH TYPE I OR TYPE II BARRICADES WITH LIGHTING FOR THE PERIOD BEGINNING IMMEDIATELY AFTER REMOVAL IS COMPLETED UNTIL THE OPENINGS HAVE BEEN FILLED WITH BITUMINOUS MIXTURE AND ALL DEBRIS IS CLEARED AWAY, OR WITH SAFETY STEEL PILING TO ALLOW TRAFFIC TO PASS. PROTECTION OF THE EXCAVATION SHALL BE IN ACCORDANCE WITH THESE SPECIAL PROVISIONS NOTED HEREIN AS TRAFFIC CONTROL.

PRIOR TO PLACING BITUMINOUS CONCRETE, ALL SURFACES OF THE REPAIR AREA SHALL BE BLOWN FREE OF DUST AND LOOSE AGGREGATE PARTICLES WITH COMPRESSED AIR. A TACK COAT CONFORMING TO SECTION 406 OF THE STANDARD SPECIFICATIONS SHALL BE APPLIED TO ALL SURFACES OF THE REPLACEMENT AREA AT A RATE OF 0.10 GAL. OF RESIDUAL BITUMEN PER SQUARE YARD. THE OPENING SHALL THEN BE FILLED IN LIFTS OF SURFACE COURSE MIXTURE AND COMPACTED BY MEANS OF A SELF-PROPELLED STEEL WHEEL ROLLER TO NOT LESS THAN 95 PERCENT OF THE MODIFIED PROCTOR DENSITY.

THE FINISHED SURFACE OF THE FINAL REPLACEMENT SHALL BE FLUSH, SMOOTH AND LEVEL TO THE SURROUNDING PAVEMENT SURFACE.

THE FINISHED SURFACE OF THE FINAL REPLACEMENT SHALL MEASURE 2 INCHES IN DEPTH.

WHEN IN THE OPINION OF THE ENGINEER, BITUMINOUS SURFACE COURSE MIXTURE DELIVERED TO THE WORK SITE FOR PATCHING HAS COOLED TO THE POINT OF BEING UNSATISFACTORY, IT SHALL NOT BE USED IN THE WORK.

THE METHOD OF MEASUREMENT FOR THIS ITEM OF WORK SHALL BE IN SQUARE YARDS, WHICH WILL BE CALCULATED BY THE FIELD MEASUREMENT. MEASUREMENT SHALL BE CONSIDERED FULL COMPENSATION FOR SAW CUTTING, REMOVAL AND DISPOSAL OF EXCAVATED MATERIALS, REMOVAL AND INSTALLATION OF BITUMINOUS MATERIALS TO WATCH EXISTING PAVEMENT SECTIONS, PLACING OF TACK COAT AND BITUMINOUS SURFACE COURSE, TEMPORARY ASPHALT PATCHES, TRAFFIC CONTROL AND ANY OTHER LABOR, EQUIPMENT, TOOLS OR MATERIALS NECESSARY TO COMPLETE THIS ITEM TO THE SATISFACTION OF THE ENGINEER.

PAYMENT SHALL BE MADE AT THE CONTRACT UNIT PRICE PER SQUARE YARD FOR BITUMINOUS PAVEMENT REPLACEMENT, TYPE II, WHICH SHALL BE FULL COMPENSATION FOR ALL MATERIALS, LABOR, EQUIPMENT AND APPURTENANT NECESSARY FOR A COMPLETE JOB.

NAPERVILLE PUBLIC UTILITIES DEPARTMENT ELECTRIC STANDARDS	INSTRUCTION FOR INSTALLING, REMOVAL AND REPLACEMENT OF BITUMINOUS PAVEMENT (TYPE II)	DATE: 06-01-05 Page 1 of 1 60468-930
--	--	--

PROJECT TITLE				ROUTE 59 ROAD IMPROVEMENTS			
PROJECT DESCRIPTION				DETAILS AND STANDARDS			
ENGINEER	BCC	DRAFTING DATE	5-11-12	MAP #	4211,4212,4223	SCALE	N.T.S.
DESIGNED BY	DL	DRAFTED BY	PSM	AT&T JOINT AGREEMENT #	N/A	PROJECT #	EU-12
CHECKED BY		APPROVED BY		CAD FILE	0060648001D155.DWG	SHEET #	55 OF 63
Naperville				Department of Public Utilities Electric Division			
				WORK REQUEST # 60468			

F.A.P. RTE.	SECTION	COUNTY	TOTAL SHEETS	SHEET NO.
338/IL 59	2011-035-I	DUPAGE		
			CONTRACT 60P42	
FED.ROAD.DIST.NO.	ILLINOIS	FED. AID PROJECT		

**TRANSMISSION LINE LANDSCAPING
OVERHEAD OR UNDERGROUND**

THIS SPECIFICATION COVERS THE REQUIREMENTS FOR THE INSTALLATION FLOWERS, PLANTS, TREES, SHRUBS, EVERGREENS AS PART OF THE ELECTRICAL LANDSCAPE WORK ASSOCIATED WITH OVERHEAD AND UNDERGROUND LINES AND RELATED FACILITIES IN ACCORDANCE WITH THE JOB DRAWINGS.

I. GENERAL

- THE NUMBER, TYPE AND LOCATION OF PLANTINGS SHALL BE AS SHOWN ON THE JOB OR DIRECTED BY THE ENGINEER.
- THE CONTRACTOR SHALL GIVE HIS PERSONAL ATTENTION TO THE FAITHFUL CARRYING OUT THE WORK. COMPETENT AND SKILLFUL MEN SHALL BE EMPLOYED TO EXECUTE THE WORK WHICH SHALL BE SUPERVISED BY AN EXPERIENCED ARBORIST FOREMAN AT ALL TIMES.
- THE CONTRACTOR SHALL HAVE AVAILABLE AND IN GOOD CONDITION ALL EQUIPMENT NECESSARY FOR THE SAFE TRANSPORTING OF PLANTINGS TO THE SITE AND FOR SETTING PLANTINGS IN FINAL POSITION.
- THE CONTRACTOR SHALL CONTAIN HIS OPERATION WITHIN THE OWNER'S PROPERTY AND SHALL AVOID OR MINIMIZE ANNOYANCE OR DISTURBANCE TO THE PUBLIC.
- CARE SHALL BE TAKEN TO AVOID DISTURBANCE OF ALL AREAS OUTSIDE OF THE WORK AREAS AND ANY DAMAGE THERE TO SHALL BE IMMEDIATELY REPAIRED AND RESTORED TO THE ORIGINAL CONDITION.
- WHEN THE WORK IS COMPLETED, THE CONTRACTOR SHALL RESTORE THE SURFACE OF OWNER'S PROPERTY AND/OR ANY OTHER LAND USED BY THE CONTRACTOR TO ITS ORIGINAL CONDITION. ALL DEBRIS, EXCESS EXCAVATED MATERIAL, AND ALL OTHER MATERIAL WHICH COLLECTS AS A RESULT OF THE CONTRACTOR'S OPERATION, SHALL BE REMOVED IMMEDIATELY.
- ALL BRICKS, MORTAR, DECORATIVE STONE, CONCRETE, STONE, SAND GRAVEL, MODULAR BRICK FORMS, MULCH OF ALL TYPES, PULVERIZED BLACK DIRT, TREES, FENCE INSTALLATION AND REMOVAL, FLOWERS, SHRUBS, EVERGREEN TREES AND TO BE FURNISHED BY THE CONTRACTOR WITH LABOR TO INSTALL.
- THE CONTRACTOR SHALL REMOVE ONLY THOSE TREES AND SHRUBS SO DESIGNATED ON THE PLANS OR AS DIRECTED BY THE ENGINEER, OR THOSE THAT DIRECTLY INTERFERE WITH THE SAFETY OR QUALITY OF CONSTRUCTION PRACTICES. THE CONTRACTOR SHALL NOTIFY THE ENGINEER A MINIMUM OF TWO DAYS IN ADVANCE OF REMOVAL OF TREES THAT AFFECT SAFETY. THE CONTRACTOR SHALL EXERCISE EXTREME CARE WHEN WORKING NEAR EXISTING TREES AND SHRUBS TO AVOID DAMAGING THOSE NOT SCHEDULED FOR REMOVAL AND SHALL REPLACE ANY DAMAGED PLANTS AT HIS OWN EXPENSE. THE CONTRACTOR SHALL PROTECT ALL OTHER TREES, BUSHES AND LANDSCAPING FEATURES. TREES REMOVED OR DAMAGED BY THE CONTRACTOR THAT HAVE NOT BEEN DESIGNATED FOR REMOVAL, SHALL BE REPLACED BY THE CONTRACTOR AT NO COST TO THE CITY. TREES TO HAVE BRANCHES OR ROOTS PRUNED SHALL BE DONE IN A NEAT AND CLEAN MANNER (I.E., WITH A SAW DESIGNED FOR PRUNING OR SHEARS OR LOPPERS) AND NOT TORN, PULLED, OR BROKEN WITH CONSTRUCTION EQUIPMENT. THE CONTRACTOR SHALL HAVE THE SERVICES OF A REGISTERED AND CERTIFIED ARBORIST ON SITE DURING THE TREE REMOVAL, TRIMMING AND PRUNING WORK. THE ARBORIST SHALL IDENTIFY THE TYPE, SIZE, DIAMETER AND CONDITION OF ALL TREES AND EVERGREENS PRIOR TO REMOVAL, TRIMMING AND/OR PRUNING AND PROVIDE A REPORT FOR EACH TREE OR EVERGREEN WORKED ON. THE REPORT SHALL BE PROVIDED IN DUPLICATE AND GIVEN TO THE ENGINEER FOR REVIEW. SEE DETAILS OF TREE REQUIREMENTS IN PLAN DRAWINGS OR AS DIRECTED BY THE ENGINEER.

NAPERVILLE PUBLIC UTILITIES DEPARTMENT ELECTRIC STANDARDS	TRANSMISSION LINE LANDSCAPING OVERHEAD OR UNDERGROUND (CONSTRUCTION SPECIFICATION)	DATE: 06-01-06 Page 1 of 11 60468-1000
--	--	--

I. GENERAL (CONTINUED)

- TREES SHALL BE INSTALLED A MINIMUM OF FIVE FEET HORIZONTALLY FROM SANITARY SEWERS, SANITARY SERVICES, WATER MAINS, AND WATER SERVICES. TREES SHALL BE INSTALLED A MINIMUM OF TEN FEET HORIZONTALLY FROM UTILITY STRUCTURES AND APPURTENANCES, INCLUDING, BUT NOT LIMITED TO, MANHOLES, VALVE VAULTS, VALVE BOXES AND FIRE HYDRANTS.
- THE CONTRACTOR SHALL PROVIDE THE SERVICES OF A LICENSED AND REGISTERED ARBORIST, A REGISTERED LANDSCAPER ARCHITECT, PLUS A STATE AND COUNTY LICENSED, CERTIFIED AND APPROVED LANDSCAPING SERVICE ASSIGNED AND PERFORM SERVICES FOR THE DURATION OF THE PROJECT. THE ARBORIST AND REGISTERED LANDSCAPER ARCHITECT SHALL OVERSEE ALL RESTORATION REQUIRED ON THE PROJECT AS IT RELATES TO SURFACE RESTORATION, VEGETATION, DECORATIVE FEATURES, PROVIDE LANDSCAPING DESIGNS, GARDENS, AND TREES AND SHRUBS AND EVERGREENS AND SODDING, SEEDING AND BLACK DIRT INSTALLATION, AND SHALL DIRECT PRUNING AND TRIMMING OPERATIONS TO FOLLOW THE BEST PRACTICES AND METHODS WHEN IT COMES TO SURFACE RESTORATION, VEGETATION, TREES AND PLANTS. THE ARBORIST AND/OR ARCHITECT SHALL WRITE REPORTS WITH RECOMMENDATIONS, CAUSE AND EFFECT RELATION SHIPS, PROVIDE LANDSCAPING DESIGNS FOR CUSTOMER APPROVAL AND PROVIDE POSSIBLE SOLUTIONS WITH OPTIONS OF ALL WORK BEING DONE OR PROPOSED WHEN REQUESTED TO DO SO BY THE OWNER. THE REGISTRATION NUMBER AND NAME OF THE REGISTERED LANDSCAPE ARCHITECT SHALL BE PROVIDED PRIOR TO STARTING WORK. IN ADDITION, THE CONTRACTOR SHALL PROVIDE THE ARBORIST NAME AND CREDENTIALS. THE COST OF PROVIDING THIS SERVICE IS INCIDENTAL TO THE COST OF THE CONTRACT.
- ALL RESTORATION SHALL NOT BE DONE EXCEPT FOR PREP WORK OF THE AREA, PRUNING OR TRIMMING WHEN THE SUMMER SEASON TEMPERATURE SHALL EXCEED 85 DEGREES FAHRENHEIT OR BELOW 40 DEGREES FAHRENHEIT WINTER TEMPERATURE. ALL RESTORATION SHALL START BY APRIL 1 AND STOP BY NOVEMBER 15, OR SOONER AS WEATHER PERMITS. IF WINTER CONDITIONS PREVENT RESTORATION WORK, FOLLOWING THE WINTER SEASON THE CONTRACTOR SHALL RESUME RESTORATION WORK BY APRIL 1, WEATHER PERMITTING, OF THE NEXT YEAR OR IN ACCORDANCE WITH LOCAL AGENCIES. THE OWNER SHALL RETAIN FUNDS OF A MINIMUM EQUAL TO THE WORK TO BE DONE OR MORE, AND SHALL BE PAID WHEN THE WORK IS COMPLETED. THE GUARANTEE SHALL BE FROM THE DATE THE ENGINEER HAS SIGNED THAT ALL SURFACE RESTORATION IS COMPLETED.
- THIS WORK SHALL CONSIST OF THE CUTTING, GRUBBING, REMOVAL AND DISPOSAL OF TREES AND EVERGREENS AT THE LOCATIONS SHOWN ON THE PLANS OR SPECIFIED BY THE ENGINEER. NO TREES SHALL BE REMOVED WITHOUT THE APPROVAL OF THE ENGINEER. TREE REMOVAL METHODS SHALL BE IN CONFORMANCE WITH IDOT ARTICLE 201.04 OF THE STANDARD SPECIFICATIONS.
- CLEARING WILL NOT BE PAID FOR SEPARATELY BUT SHALL BE CONSIDERED AS INCLUDED IN THE UTILITY INSTALLATION REQUIRED IN THE CONTRACT.
- THE CONTRACTOR SHALL REMOVE ALL STUMPS, TREES AND EVERGREENS AND DISPOSE OFF SITE, PLUS RESTORE SURFACE WITH A 6" LAYER OF BLACK DIRT AND SOD.
- THE CONTRACTOR SHALL REQUIRE THAT AN ARBORIST AND ARCHITECT LANDSCAPER LOOK AT EACH TREE FOR DISEASE, FUNGUS OR BEETLE INFESTATION AND SOUND TREE FOR STRUCTURAL SUITABILITY AND GENERAL CONDITION OF TREE BEFORE CLIMBING OR SAWING. A REPORT SHALL BE GIVEN TO THE ENGINEER INDICATING THEIR FINDINGS.
- TREES TO BE REMOVED OR INSTALLED WILL BE MEASURED IN INCH-DIAMETER. THE DIAMETER WILL BE MEASURED AT A POINT FOUR FEET ABOVE THE HIGHEST GROUND LEVEL AT THE BASE OF THE TREE AND WILL BE DETERMINED BY ASSURING THE CIRCUMFERENCE OF THE TREE AND DIVIDING THIS MEASURE CIRCUMFERENCE BY 3.1416.
- TREE REMOVAL OR INSTALLATION WILL BE PAID FOR AT THE CONTRACT UNIT PRICES PER UNIT DIAMETER FOR TREE REMOVAL/INSTALLATION, 6-12 INCH DIAMETER, AND 13-30 INCH DIAMETER, WHICH SHALL BE FULL COMPENSATION FOR ALL MATERIALS, LABOR, EQUIPMENT AND APPURTENANCES NECESSARY TO COMPLETE THE WORK.
- CONTRACTOR IS ADVISED TREE REMOVAL OR INSTALLATION REQUIRES THAT ALL UTILITIES ARE TO BE IDENTIFIED PRIOR TO REMOVAL AND PROVIDE PROPER PROTECTION (WOOD LAGGING GROUND TREES).

NAPERVILLE PUBLIC UTILITIES DEPARTMENT ELECTRIC STANDARDS	TRANSMISSION LINE LANDSCAPING OVERHEAD OR UNDERGROUND (CONSTRUCTION SPECIFICATION)	DATE: 06-01-06 Page 2 of 11 60468-1000
--	--	--

II. PLANT MATERIAL

- THE CONTRACTOR SHALL INVESTIGATE SOURCES OF SUPPLY TO ENSURE THAT ALL THE PLANTS DESIGNATED ON THE PLANTING LIST IN THE SIZE, VARIETY, AND QUALITY NOTED AND SPECIFIED ARE AVAILABLE. FAILURE TO TAKE THIS PRECAUTION WILL NOT RELIEVE THE CONTRACTOR FROM RESPONSIBILITY TO FURNISH AND INSTALL ALL THE PLANT MATERIAL IN STRICT ACCORDANCE WITH THE CONTRACT REQUIREMENTS, AND WITHOUT ADDITIONAL EXPENSE TO THE OWNER.
 - ALL STOCK FURNISHED SHALL BE WELL SHAPED PLANTS AND MUST BETRUE TO NAME. ONE OF EACH SIZE SHALL BE LEGIBLY TAGGED WITH A WEATHER PROOF TAG STATING THE SIZE AND STANDARD BOTANICAL NAME AS RECOMMENDED BY THE AMERICAN ASSOCIATION OF NURSERYMEN.
 - ALL BALLED AND BURLAPPED STOCK SHALL CONFORM FULLY TO THE SPECIFICATIONS AS SET FORTH BY THE AMERICAN NURSERYMEN'S ASSOCIATION AND THE ILLINOIS LANDSCAPE CONTRACTOR'S ASSOCIATION.
 - THE CALIPER OF TREE TRUNKS SHALL BE TAKEN SIX INCHES ABOVEGROUND LEVEL FOR TREES UP TO AND INCLUDING FOUR INCHES CALIPER AND 12 INCHES ABOVE GROUND LEVEL FOR TREES OF LARGER CALIPER.
 - NO SUBSTITUTION SHALL BE MADE WITHOUT WRITTEN AUTHORIZATION BY THE OWNER'S REPRESENTATIVE.
 - UPON NOTICE FROM THE OWNER'S REPRESENTATIVE, ALL PLANTS NOT TRUE TO SIZE, QUALITY, VARIETY AND COLOR SPECIFIED SHALL BE REMOVED BY THE CONTRACTOR AND IMMEDIATELY REPLACED AT THE CONTRACTOR'S EXPENSE WITH PLANTS MEETING THE REQUIREMENTS OF THE PLANS AND SPECIFICATIONS. THE DECISION OF THE OWNER'S REPRESENTATIVE SHALL BE FINAL.
 - ALL PLANTS SHALL BE DUG WITH REASONABLE CARE AND SKILL IMMEDIATELY PREVIOUS TO SHIPMENT, OR, IF DUG IN ADVANCE, ROOTS MUST BE CAREFULLY PROTECTED AT ALL TIMES TO PREVENT EXCESSIVE DRYING. ROOTS SHALL NOT BE SPLIT AND SHALL NOT BE BROKEN. ANY ROOTS OVER ONE-HALF INCH DIAMETER BE CUT OR BROKEN. SPECIAL PRECAUTIONS SHALL BE TAKEN TO AVOID ANY UNNECESSARY INJURY TO OR REMOVAL OF FIBROUS ROOTS.
 - EACH SPECIES OR VARIETY SHALL BE HANDLED AND PACKED IN THE APPROVED MANNER FOR THAT PLANT, HAVING REGARD TO THE SOIL AND CLIMATIC CONDITIONS AT THE TIME AND PLACE OF DIGGING, THE TYPE OF TRANSIT, THE DELIVERY SITE, AND THE TIME THAT WILL BE CONSUMED IN TRANSIT OR DELIVERY. THE ALL PRECAUTIONS THAT ARE CUSTOMARY IN GOOD TRADE PRACTICE SHALL BE TAKEN TO ENSURE THAT UPON ARRIVAL AT THE DESTINATION THE PLANTS ARE IN GOOD CONDITION FOR SUCCESSFUL GROWTH.
- III. TREES AND EVERGREENS
- IDENTIFY SPECIES USING AN ARBORIST. INSTALL ALL WORK USING A REGISTERED, LICENSED, LANDSCAPING SERVICE. REMOVE, FURNISH, DELIVER, MAKE READY WORK, GRADE, LEVEL, DISPOSE OF EXCAVATED MATERIALS OFF SITE, AND PLANT A TREE OR EVERGREEN OF THE SAME SPECIES, VARIETY AND SAME SIZE. INSTALL SUITABLE BLACK DIRT FILL, GRADE, INSTALL WITH MULCH AND WATER. THIS IS NOT POSSIBLE FOR TREE REPLACEMENT DO THE FOLLOWING: FURNISH, DELIVER AND PLANT WITH THE SAME AT LOCATIONS DESIGNATED BY THE ENGINEER, A NUMBER OF TREES OF THE SAME SPECIES AND VARIETY HAVING A MINIMUM DIAMETER OF 4 INCHES, WHOSE TOTAL INCH DIAMETER EQUALS THE INCH DIAMETER OF THE TREE REMOVED. DIAMETER OF THE PRESENT TREE 4" AND LESS IN DIAMETER SHALL BE MEASURED AT 6 INCHES FROM THE TOP OF ROOT BALL OR AS DENOTED ON THE DRAWINGS, TREES 4" AND LARGER IN DIAMETER SHALL BE MEASURED AT 12 INCHES FROM TOP OF ROOT BALL OR AS DENOTED ON THE DRAWINGS. THE EXCAVATION FOR THE TREE OR EVERGREEN SHALL BE THREE TIMES THE DIAMETER SIZE OF THE ROOT BALL, PLUS 3 TO 4 FEET DEEP AND THE ALL EXCAVATED EXISTING GROUND MATERIAL FROM THE SITE AND DISPOSED OF OFF SITE. DECORATIVE EDGING INSTALLED, AND NEW PULVERIZED DIRT WITH THE PROPER NUTRIENTS ADDED, SUPPORTED BY ROPE TIE DOWNS, AND 3 INCH THICK BED OF MULCH AROUND THE TREE COVERING THE EXCAVATED AREA, PLUS WATERING FOR 2 MONTHS UNDER THE DIRECTION OF AN ARBORIST ENGINEER. ALL TREES AND EVERGREENS PLANTED SHALL BE LOCATED AND IDENTIFIED AND DATED AND PUT ON A DRAWING AND THE TREE OR EVERGREEN IDENTIFIED BY SPECIES AND SIZE WITH THE STREET ADDRESS AND GIVEN TO THE ENGINEER FOR THE RECORD. ALL TREES OR EVERGREENS SHALL BE GUARANTEED TO GROW FOR ONE YEAR AND 6 MONTHS FROM THE DATE OF THE AS BUILT DRAWING, WHICH IS SIGNED AND DATED BY THE ENGINEER.

NAPERVILLE PUBLIC UTILITIES DEPARTMENT ELECTRIC STANDARDS	TRANSMISSION LINE LANDSCAPING OVERHEAD OR UNDERGROUND (CONSTRUCTION SPECIFICATION)	DATE: 06-01-06 Page 3 of 11 60468-1000
--	--	--

III. TREES AND EVERGREENS (CONTINUED)

- THE CONTRACTOR, UPON APPROVAL OF THE ENGINEER, MAY ERECT TO AUGUR UNDER ANY TREE OR EVERGREEN WITH A TRUNK SIZE OF 6 INCHES OR LARGER. HOWEVER, ALL TREES OR EVERGREENS WITH A TRUNK SIZE OF 12 INCHES AND LARGER SHALL BE AUGURED. AUGURING SHALL EXTEND THE FULL LENGTH OF THE DRIP LINE OF THE TREE AND PASS NO CLOSER THAN 4 FEET TO THE OUTSIDE DIAMETER OF THE TRUNK. DEVIATION TO FROM THE CONDUIT CENTERLINE TO AVOID TREE TRUNKS WILL BE PERMITTED WHERE POSSIBLE, BUT AT NO ADDITIONAL COST TO THE OWNER. THE DRILLING TECHNIQUE MAY BE CONSIDERED AND PERFORMED WITH THE ENGINEER'S APPROVAL AT NO COST TO THE OWNER. ALL WORK TO REMOVE THE TREES OR EVERGREENS ARE UNDER THE SUPERVISION OF AN ARBORIST PROVIDED BY THE CONTRACTOR ALL EXCAVATION SHALL BE BACKFILLED WITH 6 INCHES OF BLACK DIRT AND LEVELLED AND GRADED.
- SHRUBS, BUSHES, FLOWERS, PLANTS, SMALL TREES AND SMALL EVERGREENS SHALL BE FURNISHED, DELIVERED, AREA PREPARED, BLACK DIRT BACK FILL MADE LEVEL, GRADE, AND COMPACT AND PROMOTE DRAINAGE, AND PLANT A PLANT OF THE SAME SPECIES VARIETY, SAME SIZE IN HEIGHT, SAME SIZE IN WIDTH, AS COVERED BY ARTICLE 1081.01 (c), TYPES 1, 2, 3 AND 4, OF THE ILLINOIS DEPARTMENT OF TRANSPORTATION STANDARD SPECIFICATION FOR ROAD AND BRIDGE CONSTRUCTION OR FURNISH, DELIVER AND PLANT, AT LOCATIONS DESIGNATED BY THE ENGINEER. A NUMBER OF PLANTS OF THE SAME SPECIES AND VARIETY WHOSE TOTAL MEASUREMENTS SHALL EQUAL THE MEASUREMENT OF THE PLANT TO BE REPLACED, MEASURED ABOVE. THE EXCAVATION FOR THE SHRUBS, BUSHES, FLOWERS, PLANTS, SMALL TREES AND SMALL EVERGREENS SHALL BE TWICE THE SIZE OF THE ROOT BALL AND THE EXISTING GROUND MATERIALS REMOVED FROM THE SITE AND NEW PULVERIZED DIRT WITH THE PROPER NUTRIENTS ADDED, SUPPORTED BY ROPE THE DOWNS, STICKS AND 3 INCH THICK BED OF MULCH AROUND THE PLANT COVERING THE EXCAVATED AREA, PLUS WATERING FOR 2 MONTHS UNDER THE DIRECTION OF AN ARBORIST. ALL SHRUBS, BUSHES, FLOWERS, PLANTS, SMALL TREES, SMALL EVERGREENS PLANTED SHALL BE LOCATED AND IDENTIFIED AND DATED ON A DRAWING AND THE SHRUBS, BUSHES, FLOWERS, PLANTS, OR SMALL EVERGREENS AND SMALL TREES SHALL BE IDENTIFIED BY SPECIES AND SIZE WITH THE STREET ADDRESS AND GIVEN TO THE ENGINEER FOR THE RECORD. ALL SHRUBS, BUSHES, FLOWERS, PLANTS, SMALL EVERGREENS SHALL BE GUARANTEED TO GROW FOR ONE YEAR FROM THE DATE OF THE AS BUILT DRAWING, WHICH IS SIGNED AND DATED BY THE ENGINEER.
- THE CONTRACTOR SHALL REPLACE ALL EXISTING LANDSCAPING SUCH AS: BLACK DIRT, GRASS, PLANTS, TREES, SHRUBS, EVERGREENS, GARDENS, VEGETABLE GARDENS, WINES, BUSHES, FLOWERS AND ROCK GARDENS REMOVED OR DAMAGED. THE CONTRACTOR SHALL VIDEO THE ENTIRE PROJECT TO DETERMINE ALL THE TYPES OF LANDSCAPING PRIOR TO STARTING THE WORK. FAILURE TO DO SO SHALL REQUIRE THAT ALL LANDSCAPING CLAIMED TO BE DAMAGED SHALL BE CONSIDERED DAMAGED AND REPLACED AT THE CONTRACTORS COST. THE CONTRACTOR SHALL BE RESPONSIBLE FOR LANDSCAPING CARE OF ALL TYPES AND VARIETY OF LANDSCAPING DURING THE PERIOD OF ESTABLISHMENT FOR INITIAL AND REPLACED LANDSCAPING AND SHALL COMPLY WITH REQUIREMENTS FOR REMOVAL AND REPLACEMENT OF UNACCEPTABLE AND/OR DEAD LANDSCAPING MATERIALS.
- ALL LANDSCAPING MATERIALS SHALL CARRY A ONE YEAR AND SIX MONTHS GUARANTY FROM FINAL PAYMENT AND/OR FROM THE DATE THE ENGINEER SIGNS THE AS BUILT DRAWING ACCEPTING THE WORK.
- AT THE TIME OF SELECTION AT THE NURSERY THE LANDSCAPING MATERIALS MUST BE:
 - IN A LIVE HEALTHY CONDITION.
 - CHECK AND RECORD THE DIAMETER FROM TOP OF ROOT BALL.
 - BALANCED AND SYMMETRICAL APPEARANCE.
 - REPRESENTATIVE OF ITS THE SPECIES IN COLOR, SIZE AND STRAIGHTNESS.
 - SUFFICIENT DIRT TO PROMOTE GROWTH.
 - NOT INFECTED WITH INSECTS OR FUNGI.
 - ALL LANDSCAPING MATERIALS SHALL BE APPROVED FOR PLANTING BY THE ARBORIST AND/OR LANDSCAPE ARCHITECT
- ALL LANDSCAPING PLANTS, ETC., THAT DO NOT MEET THE REQUIREMENTS FOR ACCEPTANCE SHALL BE REPLACED AT THE CONTRACTORS COST AT ITS OWN EXPENSE AND SHALL CARRY THE SAME GUARANTEE. TREES, PLANTS, GRASS, SHRUBS, EVERGREENS, GARDENS, VEGETABLE GARDENS, BUSHES, FLOWERS, AND WINES RESTORATION IDENTIFIED ON THE CONSTRUCTION DRAWINGS SHALL BE PAID BY UNIT PRICING, HOWEVER ALL DISTURBED AREAS CAUSED DURING CONSTRUCTION AND/OR NOT SHOWN ON THE DRAWINGS SHALL BE RESTORED BY THE CONTRACTOR AND IS INCIDENTAL TO THE WORK. THE CONTRACTOR IS ADVISED THE WORK AREA IS ON THE ROADWAY PROPERTY AND SHALL BE DONE TO THE DUPAGE COUNTY DEPARTMENT OF TRANSPORTATION REQUIREMENTS; THE ELECTRICAL CONTRACTOR IS RESPONSIBLE FOR ALL AREAS.

NAPERVILLE PUBLIC UTILITIES DEPARTMENT ELECTRIC STANDARDS	TRANSMISSION LINE LANDSCAPING OVERHEAD OR UNDERGROUND (CONSTRUCTION SPECIFICATION)	DATE: 06-01-06 Page 4 of 11 60468-1000
--	--	--

III. TREES AND EVERGREENS (CONTINUED)

- THE CONTRACTOR SHALL NOTE THAT SOME LANDSCAPING MATERIALS MAY BE REQUIRED TO BE REPLANTED THEN ALL RULES, REGULATIONS, PAYMENT, GUARANTEES, WATERING FOR 2 MONTHS, CARE OF TREES, BASS SIZE, PREP AREA SHALL HAVE THE SAME REQUIREMENTS AS IF INSTALLING NEW LANDSCAPING MATERIAL. ALL TRANSFERRED LANDSCAPING MATERIALS ACTIVITIES SHALL BE DIRECTED AND PERFORMED UNDER THE SUPERVISION OF THE ARBORIST AND LANDSCAPE ARCHITECT. SEE DRAWING FOR PARTICULARS. TRANSPLANTING SHOWN ON THE DRAWING AND NOT IDENTIFIED UNDER A UNIT PRICE SHALL BE CONSIDERED INCIDENTAL TO THE COST OF THE PROJECT AND SHALL NOT BE PAID FOR SEPARATELY.
- IV. PLANTING
- IF THE SOIL AT HAND IS NOT SUITABLE FOR PLANTING, A SUITABLE LIGHT RICH SOIL SHALL BE SUPPLIED. THE BACKFILL SOIL SHALL BE FREE OF SOD, LUMPS, CLODS, STONES, AND ALL OTHER TYPES OF FOREIGN MATERIALS AND SHALL BE APPROVED BY THE OWNER'S REPRESENTATIVE PRIOR TO DELIVERY ON THE SITE. BACKFILL SHALL BE MIXED WITH PEAT MOSS, OR EQUIVALENT, AND SHALL BE WELL COMPACTED BY TAMPING AND WATERING ACCORDING TO ACCEPTED PRACTICE SO THAT ALL VOIDS AND AIR POCKETS ARE ELIMINATED. SLIGHT DEPRESSION SHALL BE LEFT AROUND THE PLANTING TO FACILITATE WATERING.
 - PLANTING PITS FOR BALLED AND BURLAPPED TREES SHALL BE PREPARED AT THE TIME THE STOCK IS DUG SO THAT NO DELAY WILL OCCUR WHEN THE STOCK IS READY TO BE PLANTED. ALL PITS SHALL BE DUG AT LEAST ONE FOOT WIDER THAN THE DIAMETER OF THE BALL. THE PLANTING PIT SHALL BE DEEP ENOUGH TO PROVIDE PROPER DRAINAGE. TO ALLOW FOUR INCHES OF SOIL BENEATH THE BALL, AND TO PERMIT THE PLANTING WHEN IT HAS SETTLED TO STAND AT THE ESTABLISHED GRADE AT THE SAME DEPTH AS IT ORIGINALLY GREW. IF THE SOIL CONDITION IN THE PITS ARE SUCH THAT ADDITIONAL DRAINAGE IS REQUIRED TO ENSURE SUCCESSFUL GROWTH, SUITABLE DRAINAGE SHALL BE PROVIDED BY THE CONTRACTOR. WHATEVER TYPE OF DRAINAGE IS PROVIDED SHALL ELIMINATE SUPERFLUOUS WATER IN THE PIT AND DRAIN AWAY FROM THE PLANTING SITE. EACH TREE SHALL BE PLANTED SO AS TO STAND DIRECTLY WHERE STAKED AND AT THE ESTABLISHED GRADE. IMMEDIATELY AFTER BEING PLANTED, THE TRUNKS OF ALL DECIDUOUS TREES SHALL BE WRAPPED SPIRALLY WITH CREPE PAPER MANUFACTURED FOR THIS PURPOSE. WRAPPING SHALL BE APPLIED FROM TOP DOWN AND STARTED AT A POINT FAR ENOUGH UP IN THE TREE TO BE WELL SHADED BY BRANCHES ABOVE. LARGE LOWER LIMBS SHALL BE BOUND AND REINFORCED WITH STOUT CORD WOUND SPIRALLY IN THE OPPOSITE DIRECTION OF THE WRAPPING PAPER.
 - ALL BALLED AND BURLAPPED SHRUBS SHALL BE PLANTED IN HOLES TWELVE INCHES LARGER IN DIAMETER THAN THE BALL OF ADEQUATE DEPTH, AND WITH PERPENDICULAR WALLS. THE BALL SHALL BE COVERED TO APPROXIMATELY THREE QUARTERS OF THE DEPTH AND THOROUGHLY WATERED IN PLACE. THE REMAINING ONE QUARTER FILL SHALL BE DRY SOIL WELL COMPACTED INTO PLACE.
 - IN AREAS WHERE THE PLANTING OF BALLED STOCK HAS RESULTED IN AN EXCESSIVE AMOUNT OF EXTRA SOIL, SUCH EXCESS SHALL BE REMOVED IMMEDIATELY BY THE CONTRACTOR AND DISPOSSED OF OFF SITE.
 - PLANTING PITS FOR BARE ROOTED STOCK SHALL BE AMPLE TO RECEIVE THE ROOTS WITHOUT CROWDING. AFTER PLACING THE PLANTS IN THE HOLES, THE LATTER SHOULD BE FILLED WITH TOP SOIL, WATERED AND THEN FILLED WITH COMPACTED DRY EARTH TO THE LEVEL OF THE FINISHED GRADE. THE PLANTS SHALL BE PLANTED PLUMB AND STRAIGHT. ALL DECIDUOUS BARE ROOTED STOCK SHALL BE PROPERLY ROOT PRUNED BEFORE PLANTING TO REMOVE UNDESIRABLE ROOT GROWTH AND TO IMPROVE GROWTH CHARACTERISTICS.

NAPERVILLE PUBLIC UTILITIES DEPARTMENT ELECTRIC STANDARDS	TRANSMISSION LINE LANDSCAPING OVERHEAD OR UNDERGROUND (CONSTRUCTION SPECIFICATION)	DATE: 06-01-06 Page 5 of 11 60468-1000
--	--	--

IV. PLANTING (CONTINUED)

- THIS WORK SHALL CONSIST OF PLANTING TREES AND EVERGREENS OF VARIOUS SIZES AND TRUNK DIAMETER. THE CONTRACTOR SHALL CAREFULLY EXAMINE THE PROPOSED LOCATION FOR FOREIGN UTILITIES, ROOM FOR GROWTH, SUITABLE DRAINAGE AND SUNLIGHT OR SHADE. THE ARBORIST SHALL BE ON THE PROJECT DURING THE ENTIRE PROCESS AND SHALL DIRECT THE PLANTING.
 - PRIOR TO PLANTING, EXAMINE THE AREA FOR OVERHEAD OBSTRUCTIONS WHEN DIGGING AND MOVING. CONTRACTOR SHALL UNDERTAKE ANY PRUNING REQUIRED TO REMOVE POORLY POSITIONED OR DAMAGED LIMBS. THE CONTRACTOR SHALL IDENTIFY IF THE SPECIES, OR SOME PORTION THEREOF, IS DISEASED. THE CONTRACTOR SHALL DETERMINE IF THE TREE OR EVERGREEN IS A SAFETY CONCERN PRIOR TO PERFORMING ANY WORK. FOR EXAMPLE, IF IT CREATES A LINE OF SIGHT PROBLEM FOR VEHICLES, IF IN THE OPINION OF THE ARBORIST THE TREE OR EVERGREEN IS NOT PLANTABLE THEN THE TREE SHALL NOT BE PLANTED.
 - CONTRACTOR SHALL EXAMINE THE NEW SITE FOR THE TREE'S HABITAT REQUIREMENTS, FOR EXAMPLE: WIND PROTECTION; TIME OF YEAR, SOIL PH, SUNLIGHT AND MOISTURE REQUIREMENTS. PLANT IN EARLY FALL, BEFORE FIRST FREEZE OR IN THE SPRING BEFORE THE BUDS ON THE TREES OR EVERGREENS BEGIN TO SWELL.
 - CONTRACTOR SHALL BE REQUESTED TO PLANT THE FOLLOWING TREE OR EVERGREEN SPECIES: USE 15 GALLON SIZE OR 4" HIGH ON 4" DIA. AS MEASURES (DWARF RED BUCK EYE).
- | | |
|--------------------------|----------------------|
| RIVER BIRCH | SARGENT CRAB TREE |
| HACKBERRY | NINE BARK DARTS GOLD |
| HAWTHORN | SUMAC SMOOTH |
| AMERICAN LINDEN | ARROW WOOD VIBURNUM |
| SILVER MAPLE | WIEDELA FLORIDA |
| PIN OAK | JAPANESE YEW |
| RED OAK | SUMATRAN YEW |
| GREEN ASH | ARBORVITAE GLOBE |
| SUMAC | ARBORVITAE TECHNY |
| COLORADO SPRUCE | ARBORVITAE AMERICAN |
| BALSAM SPRUCE | MUGHO PINE |
| SPRUCE | BOWWOOD WINTERGREEN |
| PINES OF VARIOUS SPECIES | DWARF RED BUCK EYE |
| CRAB MYRTLE TREE | CRANBERRY VIBURNUM |
| EMERALD ARBORVITAE | |
- THE CONTRACTOR SHALL PREPARE A DESIGN OF THE PLANTED TREE AS IT FITS ON THE PROPERTY BY AN ARCHITECT LANDSCAPER. THE DRAWING SHALL BE GIVEN TO THE ENGINEER.
 - THE CONTRACTOR SHALL GET APPROVAL FOR PLANTING FROM THE CITY OF NAPERVILLE PRIOR TO PLANTING.
 - THE CONTRACTOR SHALL IDENTIFY WHAT TYPE OF TREE SHALL BE PLANTED AND PREPARE TREE FOR SHIPPING AND PLANTING.
 - THE CONTRACTOR SHALL MAINTAIN ALL ACTIVITIES WITHIN THE EASEMENTS OR PUBLIC WAYS ANY AND ALL OTHER MEANS TO PERFORM THE WORK IS AT THE CONTRACTORS EXPENSE AND SHALL OBTAIN PERMISSION FROM ALL LAND OWNERS TO USE THEIR PROPERTY.
 - THE CONTRACTOR UNDER THE DIRECTION OF AN ARBORIST SHALL PREPARE THE SITE FOR THE PLANTING, FERTILIZE, WATER, TRIM ADD MULCH, STAKE AS NECESSARY, PROVIDE DRAINAGE AND MAINTAIN FOR ONE YEAR. TREES AND EVERGREENS TO BE PLANTED SHALL BE MEASURED IN INCH DIAMETER. THE DIAMETER WILL BE MEASURED AT A POINT FOUR FEET ABOVE THE HIGHEST GROUND LEVEL AT THE BASE OF THE TREE OR EVERGREEN AND WILL BE DETERMINED BY ASSURING THE CIRCUMFERENCE OF THE TREE AND DIVIDING THIS MEASURE CIRCUMFERENCE BY 3.1416.
 - SEE SPECIFICATION 56270-1210 FOR ADDITIONAL REQUIREMENTS AND BASIS OF PAYMENTS. CONTRACTOR SHALL FOLLOW SPECIFICATION OF TREE, SHRUB AND EVERGREEN PRESERVATION REQUIREMENTS, CONTRACTOR TO PROVIDE TREE SURVEY.

NAPERVILLE PUBLIC UTILITIES DEPARTMENT ELECTRIC STANDARDS	TRANSMISSION LINE LANDSCAPING OVERHEAD OR UNDERGROUND (CONSTRUCTION SPECIFICATION)	DATE: 06-01-06 Page 6 of 11 60468-1000
--	--	--

PROJECT TITLE		ROUTE 59 ROAD IMPROVEMENTS						
PROJECT DESCRIPTION		DETAILS AND STANDARDS						
ENGINEER	BCC	DRAFTING DATE	5-11-12	MAP #	4211,4212,4223	SCALE	N.T.S.	
DESIGN BY	DL	DRAFTED BY	PSM	REVISIONS DATE		PROJECT #	EU-12	
CHECKED BY		APPROVED BY		CAD FILE	06468001D156.DWG	SHEET #	56 OF 63	
Naperville							Department of Public Utilities	WORK REQUEST #
							Electric Division	60468

F.A.P. RTE.	SECTION	COUNTY	TOTAL SHEETS	SHEET NO.
338/IL 59	-2011-035-1-	DUPAGE		
FED.ROAD.DIST.NO.		ILLINOIS	CONTRACT 60P42	
		FED. AID PROJECT		

IV. PLANTING (CONTINUED):

- ALL TREES AND SHRUBS SHALL BE TOP THINNED OR PRUNED TO THE SATISFACTION OF THE OWNER'S REPRESENTATIVE. PRUNING SHALL BE ONLY FOR THE PURPOSE OF BALANCING THE TREE AND FOR THE REMOVAL OF INTERFERING BRANCHES AND BAD CROTCHES, BUT SHALL NOT CHANGE THE NATURAL GROWTH OR APPEARANCE OF THE PLANT.
- ALL TOP THINNING OR PRUNING SHALL BE PERFORMED WITH THE PROPER TOOLS. PRUNING SHEARS OR LOPPING TOOLS. NORMAL TOP PRUNING OF BALLED STOCK WILL REQUIRE REMOVAL OF APPROXIMATELY ONE QUARTER OF THE BRANCHES; OF BARE ROOTED STOCK APPROXIMATELY ONE THIRD OF THE BRANCHES. ALL PRUNING WOUNDS SHALL BE PAINTED WITH AN APPROVED TREE WOUND DRESSING.

V. FERTILIZER

- FERTILIZER SHALL BE A CONTROLLED RELEASE TYPE, SUCH AS MAGAMP, DISTRIBUTED BY JIFFY PRODUCTS OF AMERICA, P.O. BOX 336, WEST CHICAGO, ILLINOIS 60185, OR APPROVED EQUAL. THE FERTILIZER SHALL BE PLACED DIRECTLY INTO PLANTING PITS IN QUANTITIES AND METHOD AS SHOWN ON PLAN.

APPLICATION RATES AND METHODS FOR MAGAMP

a) 10 IN. BALL	2 OZS. COARSE	PLACE IN BOTTOM OF PLANTING PIT PRIOR TO PLANTING.
b) 12-16 IN. BALL	4 OZS. COARSE	PLACE IN BOTTOM OF PLANTING PIT PRIOR TO PLANTING.
c) 16-20 IN. BALL	8 OZS. COARSE	PLACE IN BOTTOM OF PLANTING PIT PRIOR TO PLANTING.
d) 2 FT. BALL	10-12 OZS. COARSE	PLACE IN BOTTOM OF PLANTING PIT PRIOR TO PLANTING.
e) 3 FT. BALL	1 TO 2 LBS. COARSE	PLACE IN BOTTOM OF PLANTING PIT PRIOR TO PLANTING.
f) BARE ROOT PLANTING 12 IN. TO 8 FT. TALL	2 OZS. TO 2 LBS. COARSE	PLACE IN BOTTOM OF PLANTING PIT AND COVER WITH 1/2 TO 1 IN. SOIL BARRIER.

VI. INSPECTION

- INSPECTION OF ALL STOCK MAY BE MADE AT POINT OF ORIGIN OR POINT OF DELIVERY, OR BOTH BY OWNER'S REPRESENTATIVE. STOCK WHICH CANNOT BE SHOWN FOR INSPECTION ON TWENTY-FOUR HOUR NOTICE MAY BE REJECTED. AN INSPECTION DURING DIGGING WILL BE MADE WHENEVER SUCH EXAMINATION IS DEEMED DESIRABLE. FINAL INSPECTION WILL BE MADE BY THE SAME REPRESENTATIVE WHEN THE MATERIAL IS DELIVERED. THE OWNER RESERVES THE RIGHT TO REJECT ALL STOCK WHICH IS FOUND UNSATISFACTORY UPON DELIVERY.

VII. DELIVERY

- ALL PLANTS SHALL BE PACKED FOR DELIVERY TO ENSURE ADEQUATE PROTECTION AGAINST CLIMATIC, SEASONAL, OR ANY OTHER INJURY DURING TRANSIT. THE ROOTS OF BARE-ROOTED STOCK SHALL BE CAREFULLY PROTECTED WITH WET STRAW, MOSS OR OTHER SUITABLE PACKING MATERIAL WHICH WILL ENSURE THE ARRIVAL OF PLANTS AT THE DESTINATION IN GOOD CONDITION. SPECIAL ATTENTION SHALL BE GIVEN TO ENSURE PROMPT DELIVERY, CAREFUL HANDLING IN LOADING, PROTECTION BY CANVAS OR OTHER ACCEPTED METHODS IN TRANSIT, AND UNLOADING AT THE POINT OF DELIVERY.
- THE CONTRACTOR SHALL PROVIDE ADEQUATE PROTECTION FOR ALL UNPLANTED STOCK ON THE SITE BY CAREFULLY HEELING IN OR BY OTHER STANDARD APPROVED PRACTICES.

VIII. ROOT PRUNING

- THE CONTRACTOR SHALL FURNISH ALL LABOR, MATERIALS, A REGISTERED ARBORIST, A REGISTERED LANDSCAPE ARCHITECT, AND APPURTENANCES NECESSARY TO PERFORM TREE AND EVERGREEN ROOT PRUNING WORK SHALL BE COMPLETED IN CONFORMANCE WITH SECTION 201 OF THE "STANDARD ROAD SPECIFICATIONS" LATEST EDITION. THIS SHALL BE COMPLETED FOR ALL TREES ENCRANCHING UPON THE CONSTRUCTION AREA. ANY ROOTS ENCOUNTERED SHALL BE TREATED WITH THIS METHOD AS DIRECTED BY THE CITY.
- ROOT PRUNING USING AN APPROVED MECHANICAL ROOT PRUNING SAW, OR LOPPER AS DIRECTED BY A REGISTERED ARBORIST, SHALL BE PERFORMED PRIOR TO DIGGING WHERE NOTED ON THE PLANS. PER CUSTOMER REQUEST OR AS DIRECTED BY THE ENGINEER, WHENEVER ROOTS OF PLANT MATERIAL ARE TO REMAIN EXPOSED DURING CONSTRUCTION, THE DAMAGED ROOTS ARE TO BE REMOVED BY CUTTING THEM OFF CLEARLY. PRUNING SHALL BE DONE IN THE PRESENCE OF THE ENGINEER AND/OR REGISTERED ARBORIST AND IN SUCH A MANNER AS TO PRESERVE THE NATURAL GROWTH HABIT.
- ANY DAMAGE TO THE ROOT ZONE AS DETERMINED BY THE ENGINEER AND/OR ARBORIST SHALL BE COMPENSATED BY PRUNING AN EQUIVALENT AMOUNT OF THE TOP VEGETATIVE GROWTH OF THE PLANT MATERIAL WITHIN 1 WEEK FOLLOWING ROOT DAMAGE. FERTILIZER NUTRIENTS SHALL BE APPLIED WITHIN 48 HOURS AFTER ROOT DAMAGE OCCURS. A FERTILIZER WITH A 1:1:1 RATION SHALL BE APPLIED AT THE RATE OF 5 LBS. OF NUTRIENTS PER 1000 SQ. FT.
- APPLICATION SHALL BE ACCOMPLISHED BY PLACING DRY FERTILIZER IN HOLES IN THE SOIL. HOLES SHALL BE 8 TO 12 INCHES DEEP AND SPACED 2 FEET APART IN AN AREA BEGINNING 30 INCHES FROM THE BASE OF THE PLANT. HOLES CAN BE PUNCHED WITH A PUNCH BAR, DUG WITH A SPADE, DRILLED WITH AN AUGER OR ANY METHOD APPROVED BY THE ENGINEER. APPROXIMATELY 0.02 LB. OF FERTILIZER NUTRIENTS SHALL BE PLACED BY IN EACH HOLE (250 HOLES PER 1000 SQ. FT.).
- IF THE ENGINEER OR ARBORIST DETERMINE THAT THE HOLE METHOD OF FERTILIZER PLACEMENT IS NOT PRACTICAL OR DESIRABLE, AN APPROVED METHOD OF UNIFORM SURFACE APPLICATION WILL BE ALLOWED.
- IN THE CASE OF INADEQUATE RAINFALL, AS DETERMINED BY THE ENGINEER, SUPPLEMENTAL WATER SHALL BE APPLIED WITHIN 48 HOURS OF ANY ROOT DAMAGE. THE WATER SHALL BE APPLIED AT THE RATE OF 2 GALLONS PER SQ. YD. OF SURFACE WITHIN THE ROOT ZONE OF PLANT MATERIAL HAVING SUSTAINED DAMAGE TO THE ROOT ZONE. THREE SUBSEQUENT WEEKLY WATERING AT 2 GALLONS PER SQ. YD. SHALL BE APPLIED IF DEEMED NECESSARY BY THE ENGINEER. ADDITIONAL WATERING MAY BE REQUIRED. THE ENGINEER SHALL DIRECT THIS WORK.

IX. SUPPLEMENTAL WATERING

- THIS WORK SHALL CONSIST OF FURNISHING SUPPLEMENTAL WATERING IN CONFORMANCE WITH IDOT ARTICLE 252.09 OF THE STANDARD SPECIFICATIONS.
- SUPPLEMENTAL WATERING WILL BE MEASURED FOR PAYMENT IN UNITS OF 1000 GALLONS OF WATER APPLIED ON THE SODDED AREAS.
- CONTRACTOR IS ADVISED SUPPLEMENTAL WATERING IS INCLUDED IN THE UNIT PRICING PER STRUCTURES, ERECTION, OR OTHER REMOVAL AND/OR FOUNDATION INSTALLATION. SUPPLEMENTAL WATERING IS AT THE DIRECTION OF THE ENGINEER.

X. MULCHING

- THIS ITEM OF WORK SHALL INCLUDE THE MULCHING OF SEEDED AREAS ALONG THE PROPOSED IMPROVEMENTS AT THE LOCATIONS SHOWN ON THE PLAN OR AS DIRECTED BY THE ENGINEER.
- MATERIALS AND CONSTRUCTION METHODS SHALL BE IN CONFORMANCE WITH SECTION 251 OF THE STANDARD SPECIFICATIONS. MULCH SHALL BE APPLIED AS HYDRAULIC MULCH AS SPECIFIED IN IDOT ARTICLE 251.03 (C), METHOD 3 OF THE STANDARD SPECIFICATIONS. MULCH SHALL BE APPLIED TO ALL SEEDED AREAS WITHIN 24 HOURS FROM THE TIME SEED HAS BEEN APPLIED.
- CONTRACTOR IS ADVISED MULCHING IS INCLUDED IN THE UNIT PRICING PER FOOT FOR INSTALLING CONDUIT, FOUNDATION POLE OR REMOVAL.
- MULCHING WILL BE MEASURED IN PLACE IN ACRES OF SURFACE AREA MULCHED. THE PRICE SHALL INCLUDE ALL MATERIALS, LABOR, EQUIPMENT FOR PLACING THE MULCH OVER SEEDED AREAS AS SPECIFIED. MULCHING SHALL BE AT THE DIRECTION OF THE ENGINEER.

XI. CONTRACTOR'S RESPONSIBILITY AND GUARANTEE


- THE CONTRACTOR SHALL BE RESPONSIBLE FOR THE MAINTENANCE OF ALL PLANTS FOR ONE YEAR FOLLOWING THE DATE OF PLACEMENT INCLUDING WATERING ALL PLANTS AT THE TIME OF PLANTING AND AS NEEDED THROUGHOUT THE GROWING SEASON. HE SHALL VISIT THE SITE MONTHLY DURING THE GROWING SEASON TO CHECK THE PLANT'S CONDITION, AND SHALL REPORT HIS FINDINGS TO THE OWNER'S REPRESENTATIVE. IF AT THE TIME OF HIS VISIT, OR DURING A ROUTINE CHECK BY THE OWNER'S REPRESENTATIVE, IT IS DETERMINED THE PLANTS NEED WATER, THE PLANTS SHALL BE WATERED WITHIN THREE DAYS FROM THAT DATE. NOTICE WILL BE GIVEN THE CONTRACTOR BY THE OWNER'S REPRESENTATIVE BY TELEPHONE AND BY LETTER.
- ALL PLANTS, WHICH WITHIN EIGHTEEN MONTHS FOLLOWING THE DATE OF THE PLANTING AND ACCEPTANCE BY THE OWNER, ARE IN AN UNHEALTHY CONDITION OR ARE UNSHAPELY DUE TO DEAD OR DYING PARTS, EXCEPT THOSE PLANTS WHOSE CONDITION IS CAUSED BY VANDALISM OR BY RABBITS, SHALL BE REPLACED AT NO EXTRA COST TO THE OWNER. ALL REPLACEMENT PLANTS SHALL BE SELECTED, DELIVERED AND PLANTED IN ACCORDANCE WITH THIS SPECIFICATION. ALL REPLACEMENT PLANTS SHALL BE GUARANTEED FOR EIGHTEEN MONTHS FROM TIME OF REPLACEMENT AND SHALL RECEIVE THE SAME CARE AND TREATMENT AS THE ORIGINAL PLANTING. THE CONTRACTOR WITH THE WRITTEN REPORT FROM THE ARBORIST, AND THE OWNER'S REPRESENTATIVE WILL DETERMINE, AND WILL AGREE IN WRITING, THE CAUSES OF THE PLANT'S DEATH OR DISFIGURATION. THE CONTRACTOR WILL RECEIVE IN WRITING A LIST OF ALL PLANTS THAT SHALL BE REPLACED. UPON RECEIPT OF THIS LIST, THE CONTRACTOR SHALL, WITHIN THE SAME PLANTING SEASON AS THE DATE OF THE LIST, REMOVE ALL PLANTS ON THE LIST AND REPLACE THEM WITH HEALTHY PLANTS. THE CONTRACTOR SHALL FURNISH AND HAVE AVAILABLE DURING THE LENGTH OF THE PROJECT A LICENSED, CERTIFIED ARBORIST FOR RECOMMENDATIONS, PURCHASE OF PLANT MATERIALS, DIRECTIONS, SUGGESTION AND GENERAL OVER SIGHT OF ALL ROOT PRUNING AND PLANTING OPERATIONS.
- CONTRACTOR SHALL FURNISH, DELIVER, INSTALL STORE, AND MAINTAIN ALL PLANT MATERIALS INCLUDING TREES, SHRUBS AND FLOWERS FOR THE DURATION OF THE CONTRACT AND GUARANTEE PERIOD. ALL WATERING AND WINTER PROTECTION AT THE CONTRACTOR'S COST AND IS INCLUDED IN THE PRICING.
- THE CONTRACTOR SHALL FURNISH ALL MATERIALS, FEES, TOOLS, FERTILIZER, WATER AND PLANT MAINTENANCE ON THIS SPECIFICATION PLUS ALL LANDSCAPING MATERIALS AND LABOR.
- CONTRACTOR SHALL PROVIDE FOR PROTECTION OF TREES, SHRUBS AND EVERGREENS.

NAPERVILLE PUBLIC UTILITIES DEPARTMENT	TRANSMISSION LINE LANDSCAPING OVERHEAD OR UNDERGROUND (CONSTRUCTION SPECIFICATION)	DATE: 06-01-05 Page 7 of 11 60468-1000
--	--	--

NAPERVILLE PUBLIC UTILITIES DEPARTMENT	TRANSMISSION LINE LANDSCAPING OVERHEAD OR UNDERGROUND (CONSTRUCTION SPECIFICATION)	DATE: 06-01-05 Page 8 of 11 60468-1000
--	--	--


NAPERVILLE PUBLIC UTILITIES DEPARTMENT	TRANSMISSION LINE LANDSCAPING OVERHEAD OR UNDERGROUND (CONSTRUCTION SPECIFICATION)	DATE: 06-01-05 Page 9 of 11 60468-1000
--	--	--

TREE PLANTING "DETAIL"

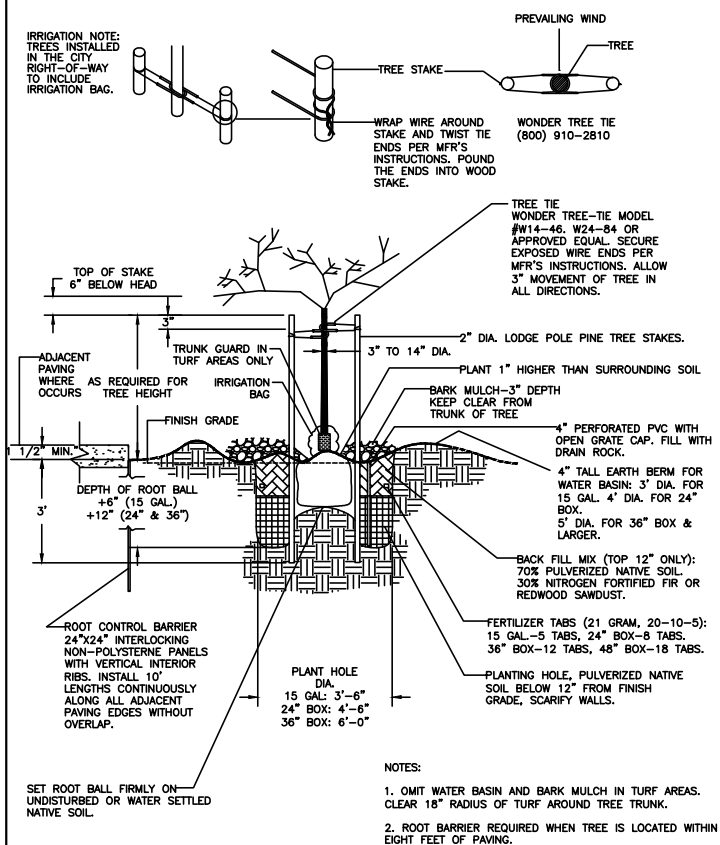

NAPERVILLE PUBLIC UTILITIES DEPARTMENT	TRANSMISSION LINE LANDSCAPING OVERHEAD OR UNDERGROUND (CONSTRUCTION SPECIFICATION)	DATE: 06-01-05 Page 10 of 11 60468-1000
--	--	---

EVERGREEN AND SHRUB PLANTING "DETAIL"

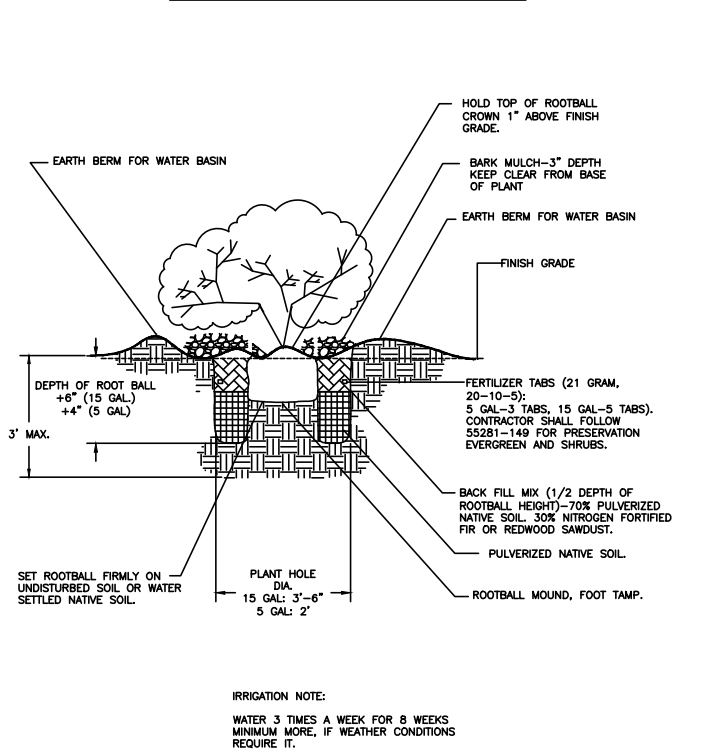

NAPERVILLE PUBLIC UTILITIES DEPARTMENT	TRANSMISSION LINE LANDSCAPING OVERHEAD OR UNDERGROUND (CONSTRUCTION SPECIFICATION)	DATE: 06-01-05 Page 11 of 11 60468-1000
--	--	---

PROJECT TITLE				ROUTE 59 ROAD IMPROVEMENTS			
PROJECT DESCRIPTION				DETAILS AND STANDARDS			
ENGINEER	DRAFTING DATE	MAP #	SCALE				
BCC	5-11-12	4211,4212,4223	N.T.S.				
GIS DESIGN BY	DRAFTED BY	AT&T JOINT AGREEMENT #	PROJECT #				
DL	PSM	N/A	EU-12				
CHECKED BY	APPROVED BY	CAD FILE	SHEET #				
		0060648001D157.DWG	57 OF 63				
Naperville		Department of Public Utilities		Electric Division		WORK REQUEST #	
						60468	

F.A.P. RTE.	SECTION	COUNTY	TOTAL SHEETS	SHEET NO.
338/IL 59	2011-035-1	DUPAGE		
FED.ROAD.DIST.NO.			ILLINOIS	
			CONTRACT 60P42	
			FED. AID PROJECT	

INSTRUCTION FOR INSTALLING AND REMOVING A SILT FENCE

THE CONTRACTOR SHALL FURNISH AND INSTALL AND LINEAR FEET IN PLACE WITH ALL MATERIAL, EQUIPMENT AND LABOR FOR THE INSTALLATION OF A GEOTECHNICAL SILT FENCE FOR TEMPORARY EROSION CONTROL.

GEOTECHNICAL FABRIC FABRIC FOR SILT FENCE SHALL CONSIST OF WOVEN OR NONWOVEN FILAMENTS OF POLYPROPYLENE, POLYESTER OR POLYETHYLENE. NONWOVEN FABRIC MAY BE NEEDLE PUNCHED, HEAT-BONDED, RESIN-BONDED OR COMBINATION THEREOF. THE FILAMENTS IN THE SILT FENCE FABRIC MUST BE DIMENSIONALLY STABLE (I.E., TO EACH OTHER), RESISTANT TO DELAMINATION, AND MUST BE FREE FROM ANY CHEMICAL TREATMENT OR COATING THAT MIGHT SIGNIFICANTLY REDUCE POROSITY AND PERMEABILITY. BOTH FABRICS SHALL BE RESISTANT TO ULTRAVIOLET RADIATION. THE FABRIC SHALL COMPLY WITH THE FOLLOWING PHYSICAL PROPERTIES:

PHYSICAL PROPERTIES	SILT FILTER FABRIC
GRAB TENSILE STRENGTH (LBS.) ASTM D 4632	200 (MIN) †
GRAB ELONGATION @ BREAK (%) ASTM D 4632	12 (MIN) †
BURST STRENGTH (PSI) - ASTM D 751	250 (MIN) †
TRAPEZOIDAL TEAR STRENGTH (LBS.) ASTM D 4533	-----
WIDTH (FT.)	3.5 (MIN)
WEIGHT (OZ/SQ) - ASTM D 3776	4.0 (MIN)
EQUIVALENT OPENING SIZE (EOS) SIEVE NO. CORRESPONDING CS-02215	30 (MIN)(NON-WOVEN) † 50 (MIN)(WOVEN) †

† FOR WOVEN FABRIC, TEST RESULTS SHALL BE REFERENCED TO ORIENTATION WITH WARP OR WEAVE, AND WHICHEVER CASE MAY BE BOTH WOVEN AND NONWOVEN FABRIC SHALL BE TESTED WET.
‡ TEST RESULTS MAY BE OBTAINED BY MANUFACTURER'S CERTIFICATION.

STAKES MAY BE EITHER WOODEN OR METAL POSTS.

THE FILTER BLANKET SHALL BE DELIVERED TO THE JOBSITE IN SUCH A MANNER AS TO FACILITATE HANDLING AND INCORPORATION INTO THE WORK WITHOUT DAMAGE. IN NO CASE SHALL THE FABRIC BE STORED OR EXPOSED TO DIRECT SUNLIGHT THAT MIGHT SIGNIFICANTLY DIMINISH ITS STRENGTH OR TOUGHNESS PRIOR TO ITS INTENDED USE AS A SILT FENCE. THE FABRIC SHALL BE RESISTANT TO ULTRAVIOLET RADIATION FOR THE DURATION OF THE CONSTRUCTION PROJECT.

INSTRUCTION FOR INSTALLING AND REMOVING A SILT FENCE

EXISTING WOODEN OR METAL POSTS SPACED AT ABOUT 1.5M (5FT.) INTERVALS MAY BE UTILIZED TO SUPPORT THE FILTER FABRIC. IN NEW CONSTRUCTION WHERE THERE ARE NO EXISTING POSTS AVAILABLE FOR SUPPORT, 1.8 M (6 FT.) LENGTHS OF TREATED 50 MM X 100 MM (2 INCH X 4 INCH) TIMBER OR GALVANIZED METAL POSTS SPACED AT ABOUT 1.5 M (5 FT.) SHALL BE INSTALLED. THE TIMBER OR METAL POSTS SHALL BE SET IN PREVIOUSLY DUG HOLES AND BACKFILLED TO FORM A STABLE SUPPORT FOR THE FABRIC, OR MAY BE DRIVEN PROVIDED THEY ARE PROTECTED BY A SUITABLE DRIVING CAP AND NO DAMAGE IS DONE TO ANY PORTION OF THE POST. THE POSTS SHALL BE SET PLUMB TO THE REQUIRED DEPTH AND ALIGNMENT WITH ADEQUATE MATERIAL STABILITY. A SMALL TRENCH OF ABOUT 150 MM (6 INCH) WIDTH AND 150 MM (6 INCH) DEPTH SHALL THEN BE EXCAVATED ON THE UPSTREAM SIDE OF THE SILT FENCE TO BURY AND ANCHOR THE LOWER PORTION ON THE FABRIC. THE FABRIC SHALL FIRST BE ATTACHED TO THE POSTS BY AN APPLICABLE MEANS. METAL STAPLES OR NAILS CAN BE USED TO ATTACH THE FABRIC TO WOODEN POSTS WITH THE MINIMUM WIDTH OF THE FABRIC OF 1.1 M (3 FT.), ABOUT 300 MM (12 INCHES) SHALL BE BURIED IN THE TRENCH AND THEN BACKFILLED WITH NATURAL MATERIAL, TAMPING THE BACKFILL TO PROVIDE GOOD ANCHORAGE AND PREVENT SURFACE WATER RUNOFF FROM UNDERMINING THE FENCE.

THE SILT FILTER FENCE SHALL BE SATISFACTORILY MAINTAINED SO AS TO KEEP FUNCTIONING DURING THE LIFE OF THE PROJECT. THIS SHALL INCLUDE REMOVAL OF TRAPPED SEDIMENT AND CLEANING THE FABRIC OF TRAPPED SEDIMENT.

SILT FENCE WILL BE MEASURED IN LINEAR FEET OF FENCE IN PLACE.

THE WORK INCLUDES ALL MATERIALS, EQUIPMENT AND LABOR REQUIRED MAINTENANCE OF THE FENCE, REMOVAL OF THE FENCE WHEN NO LONGER NEEDED, AND RESTORATION OF THE AREA.

INSTRUCTION FOR REMOVAL AND REPLACEMENT OF P.C.C. SIDEWALK

THIS ITEM SHALL CONSIST OF THE REMOVAL OF EXISTING AND INSTALLATION OF NEW P.C.C. SIDEWALK OF VARIOUS TYPES AT THE LOCATIONS SHOWN ON THE PLANS, OR AS DIRECTED BY THE ENGINEER. THIS ITEM SHALL ALSO INCLUDE THE PREPARATION OF 4 INCHES CA-4 SUB-GRADE AND BASE, AND THE PLACEMENT OF A P.C.C. SIDEWALK OF 4 INCHES THICKNESS OR AS SPECIFIED ON THE PLANS, IN ACCORDANCE WITH SECTIONS 423 AND 446 OF THE STANDARD SPECIFICATIONS. CONCRETE SHALL BE IDOT CLASS 51.

SIDEWALK TO BE REMOVED SHALL BE AS INDICATED ON THE PLANS AND MARKED BY THE ENGINEER IN THE FIELD. WHEN THE SIDEWALK IS DAMAGED BY THE CONTRACTOR AND THAT ARE NOT MARKED FOR REMOVAL SHALL BE REPLACED AT THE CONTRACTOR'S EXPENSE.

CONTRACTOR IS ADVISED SIDEWALK REMOVAL AND REPLACEMENT IS INCLUDED IN THE APPROPRIATE UNIT PRICING FOR SWITCH GEAR VAULTS, SIDE WALK SPLICE BOXES, MANHOLES TRENCHES AND HANDHOLES.

P.C.C. SIDEWALK REMOVAL AND REPLACEMENT WILL BE MEASURED FOR PAYMENT IN PLACE, AND THE AREA COMPUTED IN SQUARE FEET. THE SIDEWALK IS 5 FEET WIDE BY 4 INCHES THICK WITH 5 INCHES OF CA-4 COMPACTED BACKFILL UNDER THE SIDEWALK. SIDEWALK INSTALLATION SHALL BE DONE FROM APRIL 15 TO NOVEMBER 15. ALL SIDEWALKS REMOVED AND/OR NOT COMPLETED BEFORE NOVEMBER 15 ARE TO BE TEMPORARILY PATCHED FOR WINTER SERVICE AND MAINTAINED BY THE CONTRACTOR. MEASUREMENT SHALL BE CONSIDERED FULL COMPENSATION FOR SAW CUTTING, EXCAVATING, STEEL PLATING, FLASHING SIGNBOARDS, REMOVAL AND DISPOSAL OF EXCAVATED MATERIALS, REMOVAL AND INSTALLATION OF TRENCH BACKFILL TO PREPARE SIDEWALK TO MATCH EXISTING SIDEWALK, PAVEMENT AND CURB AND GUTTER, CONCRETE PLACING AND FINISHING, 6 INCHES OF BLACK DIRT AND SOIL, PEDESTRIAN TRAFFIC CONTROL, PLACING OF TEMPORARY COLD PATCH AND/OR CA-4 FOR WINTER USE OF STEEL PLATES ACROSS DRIVEWAYS, ARROW BOARDS, 7 COATS OF CURINGS/SEALING COMPOUND, TRAFFIC CONTROL, LINE AND GRADE, PRESSURE WASHING OF ADJACENT SIDEWALKS TO REMOVE GREASE, STAINS OR OTHER MATERIALS NECESSARY TO COMPLETE THIS ITEM TO THE SATISFACTION OF THE ENGINEER. ALL SIDEWALKS INSTALLED SHALL BE USABLE AS INTENDED. ALL WANDALISM OR DAMAGE OF ANY KIND SHALL BE CAUSE FOR REPLACEMENT AT CONTRACTOR'S COST.

SIDEWALK THICKNESS INCREASES TO 6 INCHES WHEN IT IS PART OF A RESIDENTIAL DRIVEWAY AND 9 INCHES THICK WHEN IT IS PART OF A COMMERCIAL DRIVEWAY.

THE CONTRACTOR SHALL BE PAID FOR ALL SIDEWALK REPLACEMENT SHOWN ON THE DRAWINGS AND OR DIRECTED BY THE ENGINEER. THE ALL OTHER SIDEWALKS DAMAGED OR REMOVED BY THE CONTRACTOR IS INCIDENTAL TO THE CONTRACT.

ALL SIDEWALKS UNDERMINED OR DAMAGED OR MADE UNUSABLE OR CRACKED, IN ANY WAY BY THE CONSTRUCTION ACTIVITY SHALL BE REMOVED IN THE ENTIRETY AND INSTALLED NEW BY THE CONTRACTOR AT NO COST TO THE OWNER.

THIS WORK SHALL BE PAID FOR AT THE CONTRACT UNIT PRICE PER LINEAR FOOT FOR P.C.C. SIDEWALK REMOVAL AND REPLACEMENT, OF THE THICKNESS SPECIFIED, WHICH PRICE SHALL INCLUDE ALL REQUIRED EXPANSION JOINTS, SPECIAL TEXTURING, VARIABLE HEIGHT EDGE TREATMENTS AT SIDEWALK RAMP, DISPOSAL AND SUB-GRADE PREPARATION, FINISHING, PROTECTION OF THE WORK, ALL MATERIALS, LABOR, EQUIPMENT AND APPURTENANCES REQUIRED FOR A COMPLETE ITEM.

NAPERVILLE PUBLIC UTILITIES DEPARTMENT ELECTRIC STANDARDS	INSTRUCTION FOR INSTALLING AND REMOVING A SILT FENCE	DATE: 05-01-06 Page 1 of 2 60468-1100
--	--	---

NAPERVILLE PUBLIC UTILITIES DEPARTMENT ELECTRIC STANDARDS	INSTRUCTION FOR INSTALLING AND REMOVING A SILT FENCE	DATE: 05-01-06 Page 2 of 2 60468-1100
--	--	---

NAPERVILLE PUBLIC UTILITIES DEPARTMENT ELECTRIC STANDARDS	INSTRUCTION FOR REMOVAL AND REPLACEMENT OF P.C.C. SIDEWALK	DATE: 05-01-06 Page 1 of 1 60468-1110
--	--	---

RESTORATION OF WORK AREA AND ADJACENT AREA

THE CONTRACTOR IS ADVISED THE CUSTOMER MUST BE SATISFIED WITH ALL ASPECTS OF THE RESTORATION. THE CONTRACTOR SHALL START ALL AREAS THAT HAVE BEEN DISRUPTED DUG OR COMPACTED OR OTHER WISE USED BY THE CONTRACTOR'S ACTIVITY. ALL RESTORATION SHALL BEGIN WITHIN THREE WEEKS AFTER THE INITIAL ENTRY ONTO THE CUSTOMER'S PROPERTY. THE CONTRACTOR SHALL MAKE EVERY EFFORT TO FINISH EACH PARCEL OF PROPERTY IN AN ORDERLY AND CONTINUOUS EFFORT TO THE FINISH. LARGE LAPSES OF TIME FROM STARTING TO FINISH ARE NOT ACCEPTABLE. THE CONTRACTOR SHALL BE REQUESTED TO INCREASE THE WORK FORCE AT NO COST TO SPEED UP THE RESTORATION PROCESS WHEN THE RESTORATION PROCESS TAKES LONGER THAN 6 WEEKS AT ANY LOCATION.

THE WORK AREA SHALL BE KEPT CLEAN AND GOOD HOUSEKEEPING IS THE RULE OF THE DAY. THE STORING STOCK PILING OR LEAVING MATERIALS IN THE WORK AREA OVER NIGHT IS NOT ACCEPTABLE. THE EQUIPMENT SHALL BE RETURNED TO THE STAGING AREAS AT THE END OF EACH DAY. ALL PERSONAL VEHICLES SHALL NOT BE PARKED ON ANY OF THE CITY OF NAPERVILLE STREETS.

THE LANDSCAPING PERIOD IS USUALLY APRIL 1 TO NOVEMBER 1. THE CONTRACTOR SHALL FINISH ALL LANDSCAPING STARTED IN THE WORK YEAR BY NOVEMBER 15 OF THE YEAR STARTED OR SOONER.

THE CONTRACTOR SHALL INSTALL ONLY SALT TOLERANT SOD AND 4 INCHES OF BLACK DIRT IN GREEN AREAS, AND GRASS AREAS OF ALL TYPES, AND/OR DIRT AREAS THAT HAVE BEEN DUG, EXCAVATED, DISRUPTED OR DAMAGED OR WORN BY USE. ALL LANDSCAPING SHALL BE FURNISHED, INSTALLED, ROLLED, STAKED, SUPPLIED AND APPLIED WITH SUFFICIENT QUANTITIES OF WATER AND FERTILIZER TO PROMOTE GROWTH.

THE CONTRACTOR SHALL GUARANTEE ALL WORK AND MATERIALS SUPPLIED AND INSTALLED BY THE CONTRACTOR FOR ONE YEAR FROM THE COMPLETION DATE OF THE CONTRACT. ALL MATERIALS INSTALLED SHALL BE REPLACED WITH NEW MATERIAL IN THE ENTIRETY IF AFTER ONE YEAR THE MATERIALS FAIL.

THE CONTRACTOR SHALL BE SUPPLIED WITH A TREE SURVEY PERFORMED BY THE CONTRACTOR'S ARBORIST AND WILL THE BENCHMARK USED TO RESTORE THE MINIMUM AMOUNT OF LANDSCAPING. THE CONTRACTOR SHALL TAKE A VIDEO OF THE ENTIRE RIGHT-OF-WAY PRIOR TO PERFORMANCE WORK. THIS VIDEO ALSO SHALL BE USED AS A BENCHMARK FOR RESTORATION.

THE CONTRACTOR SHALL PROVIDE A UNIT THAT IS THE TOTAL COST OF ALL LANDSCAPING AND RESTORATION OF THE CITY OF NAPERVILLE'S RIGHTS OF WAYS AND EASEMENTS TO BE DONE AND REQUIRED BUT NOT COVERED UNDER ANOTHER PRICE ITEM AS REQUIRED FOR A COMPLETE THE JOB. THIS UNIT INCLUDES, BUT NOT LIMITED TO, ALL LABOR, TRANSPORTATION, MATERIALS, HAULING, LOADING, UNLOADING, PLACING, INSTALLING, REMOVAL AND DISPOSAL OF ALL MATERIALS OFF-SITE FOR A COMPLETE JOB.

THIS WORK WILL BE PAID FOR AT THE CONTRACT PRICE OF A LUMP SUM AND SHALL INCLUDE ALL LABOR MATERIALS EQUIPMENT TRANSPORTATION AND INCIDENTALS REQUIRED TO PERFORM THE WORK AND MEETS ALL THE GOVERNMENTAL AND CUSTOMER REQUIREMENTS.

RESTORATION OF WORK AREA AND ADJACENT AREA

THE CONTRACTOR IS ADVISED THE CUSTOMER MUST BE SATISFIED WITH ALL ASPECTS OF THE RESTORATION. THE CONTRACTOR SHALL START ALL AREAS THAT HAVE BEEN DISRUPTED DUG OR COMPACTED OR OTHER WISE USED BY THE CONTRACTOR'S ACTIVITY. ALL RESTORATION SHALL BEGIN WITHIN THREE WEEKS AFTER THE INITIAL ENTRY ONTO THE CUSTOMER'S PROPERTY. THE CONTRACTOR SHALL MAKE EVERY EFFORT TO FINISH EACH PARCEL OF PROPERTY IN AN ORDERLY AND CONTINUOUS EFFORT TO THE FINISH. LARGE LAPSES OF TIME FROM STARTING TO FINISH ARE NOT ACCEPTABLE. THE CONTRACTOR SHALL BE REQUESTED TO INCREASE THE WORK FORCE AT NO COST TO SPEED UP THE RESTORATION PROCESS WHEN THE RESTORATION PROCESS TAKES LONGER THAN 6 WEEKS AT ANY LOCATION.

THE WORK AREA SHALL BE KEPT CLEAN AND GOOD HOUSEKEEPING IS THE RULE OF THE DAY. THE STORING STOCK PILING OR LEAVING MATERIALS IN THE WORK AREA OVER NIGHT IS NOT ACCEPTABLE. THE EQUIPMENT SHALL BE RETURNED TO THE STAGING AREAS AT THE END OF EACH DAY. ALL PERSONAL VEHICLES SHALL NOT BE PARKED ON ANY OF THE CITY OF NAPERVILLE STREETS.

THE LANDSCAPING PERIOD IS USUALLY APRIL 1 TO NOVEMBER 1. THE CONTRACTOR SHALL FINISH ALL LANDSCAPING STARTED IN THE WORK YEAR BY NOVEMBER 15 OF THE YEAR STARTED OR SOONER.

THE CONTRACTOR SHALL INSTALL ONLY SALT TOLERANT SOD AND 4 INCHES OF BLACK DIRT IN GREEN AREAS, AND GRASS AREAS OF ALL TYPES, AND/OR DIRT AREAS THAT HAVE BEEN DUG, EXCAVATED, DISRUPTED OR DAMAGED OR WORN BY USE. ALL LANDSCAPING SHALL BE FURNISHED, INSTALLED, ROLLED, STAKED, SUPPLIED AND APPLIED WITH SUFFICIENT QUANTITIES OF WATER AND FERTILIZER TO PROMOTE GROWTH.

THE CONTRACTOR SHALL GUARANTEE ALL WORK AND MATERIALS SUPPLIED AND INSTALLED BY THE CONTRACTOR FOR ONE YEAR FROM THE COMPLETION DATE OF THE CONTRACT. ALL MATERIALS INSTALLED SHALL BE REPLACED WITH NEW MATERIAL IN THE ENTIRETY IF AFTER ONE YEAR THE MATERIALS FAIL.

THE CONTRACTOR SHALL BE SUPPLIED WITH A TREE SURVEY PERFORMED BY THE CONTRACTOR'S ARBORIST AND WILL THE BENCHMARK USED TO RESTORE THE MINIMUM AMOUNT OF LANDSCAPING. THE CONTRACTOR SHALL TAKE A VIDEO OF THE ENTIRE RIGHT-OF-WAY PRIOR TO PERFORMANCE WORK. THIS VIDEO ALSO SHALL BE USED AS A BENCHMARK FOR RESTORATION.

THE CONTRACTOR SHALL PROVIDE A UNIT THAT IS THE TOTAL COST OF ALL LANDSCAPING AND RESTORATION OF THE CITY OF NAPERVILLE'S RIGHTS OF WAYS AND EASEMENTS TO BE DONE AND REQUIRED BUT NOT COVERED UNDER ANOTHER PRICE ITEM AS REQUIRED FOR A COMPLETE THE JOB. THIS UNIT INCLUDES, BUT NOT LIMITED TO, ALL LABOR, TRANSPORTATION, MATERIALS, HAULING, LOADING, UNLOADING, PLACING, INSTALLING, REMOVAL AND DISPOSAL OF ALL MATERIALS OFF-SITE FOR A COMPLETE JOB.

THIS WORK WILL BE PAID FOR AT THE CONTRACT PRICE OF A LUMP SUM AND SHALL INCLUDE ALL LABOR MATERIALS EQUIPMENT TRANSPORTATION AND INCIDENTALS REQUIRED TO PERFORM THE WORK AND MEETS ALL THE GOVERNMENTAL AND CUSTOMER REQUIREMENTS.

NAPERVILLE PUBLIC UTILITIES DEPARTMENT ELECTRIC STANDARDS	RESTORATION OF WORK AREA AND ADJACENT AREA	DATE: 05-01-06 Page 1 of 2 60468-1130
--	--	---

NAPERVILLE PUBLIC UTILITIES DEPARTMENT ELECTRIC STANDARDS	RESTORATION OF WORK AREA AND ADJACENT AREA	DATE: 05-01-06 Page 2 of 2 60468-1130
--	--	---

PROJECT TITLE				ROUTE 59 ROAD IMPROVEMENTS			
PROJECT DESCRIPTION				DETAILS AND STANDARDS			
ENGINEER	DRAFTING DATE	MAP #	SCALE				
BCC	5-11-12	4211,4212,4223	N.T.S.				
DESIGN BY	DRAFTED BY	REVISIONS DATE	AT&T JOINT AGREEMENT #	PROJECT #			
DL	PSM		N/A	EU-12			
CHECKED BY	APPROVED BY	CAD FILE	SHEET #				
		0060648001D158.DWG	58 OF 63				
Naperville			Department of Public Utilities Electric Division			WORK REQUEST #	
						60468	

F.A.P. RTE.	SECTION	COUNTY	TOTAL SHEETS	SHEET NO.
338/IL 59	2011-035-1	DUPAGE		
			CONTRACT 60P42	
FED.ROAD.DIST.NO.	ILLINOIS	FED. AID PROJECT		

PLANTING TREES, SHRUBS, AND EVERGREENS 3" TO 5" DIA., 6" TO 8" DIA., 9" TO 11" DIA. AND 12" TO 15" DIA.

THIS WORK SHALL CONSIST OF PLANTING TREES, SHRUBS AND EVERGREENS OF VARIOUS SIZES AND TRUNK DIAMETERS. THE CONTRACTOR SHALL CAREFULLY EXAMINE THE PROPOSED LOCATION FOR FOREIGN UTILITIES, ROOM FOR GROWTH, SUITABLE DRAINAGE AND SUNLIGHT OR SHADE. THE ARBORIST SHALL BE ON THE PROJECT DURING THE ENTIRE PROCESS AND SHALL DIRECT THE PLANTING.

PRIOR TO PLANTING, EXAMINE THE AREA FOR OVERHEAD OBSTRUCTIONS WHEN DIGGING AND MOVING. CONTRACTOR SHALL UNDERTAKE ANY PRUNING REQUIRED REMOVING POORLY- POSITIONED OR DAMAGED LIMBS. THE CONTRACTOR SHALL IDENTIFY IF THE SPECIES, OR SOME PORTION THEREOF, IS DISEASED. THE CONTRACTOR SHALL DETERMINE IF THE TREE OR EVERGREEN IS A SAFETY CONCERN PRIOR TO PERFORMING ANY WORK. FOR EXAMPLE, IF IT CREATES A LINE OF SIGHT PROBLEM FOR VEHICLES. IF IN THE OPINION OF THE ARBORIST THE TREE OR EVERGREEN IS NOT PLANTABLE THEN THE TREE SHALL NOT BE PLANTED. CONTRACTOR SHALL EXAMINE THE NEW SITE FOR THE TREE'S HABITAT REQUIREMENTS. FOR EXAMPLE: WIND PROTECTION; TIME OF YEAR, SOIL PH, SUNLIGHT, DRAINAGE AND MOISTURE REQUIREMENTS. PLANT IN EARLY FALL, BEFORE FIRST FREEZE OR IN THE SPRING BEFORE THE BUDS ON THE TREES OR EVERGREENS BEGIN TO SWELL.

THE CONTRACTOR SHALL BE REQUESTED TO PLANT THE FOLLOWING TREE SPECIES:

USE IS GALLON SIZE OR 4 FEET HIGH OR 4" DIAMETER AS APPLICABLE.

RIVER BIRCH	SARGENT CRAB TREE
HACKBERRY	NINE BARK DARTS GOLD
HAWTHORN	SUMAC SMOOTH
LINDEN AMERICAN	ARROW WOOD VIBURNUM
MAPLE SILVER	WIEGELA FLORIDA
MAPLE NORWAY	CLEVELAND PEAR
OAK PIN	JAPANESE YEW
RED OAK	SUMATRAN YEW
ASH GREEN	ARBORVITAE GLOBE
SUMAC	ARBORVITAE TECHNY
COLORADO SPRUCE	ARBORVITAE AMERICAN
BALSAM	MUGHO PIVE
SPRUCE	BOXWOOD WINTERGREEN
PINES OF VARIOUS SPECIES	DWARF RED BUCK EYE

THE CONTRACTOR SHALL PREPARE A DESIGN OF THE PLANTED TREE AS IT FITS ON THE PROPERTY BY AN ARCHITECT LANDSCAPER. THE DRAWING SHALL BE GIVEN TO THE ENGINEER.

THE CONTRACTOR SHALL GET APPROVAL FOR PLANTING FROM THE CITY OF NAPERVILLE PRIOR TO PLANTING.

THE CONTRACTOR SHALL IDENTIFY WHAT TYPE OF TREE SHALL BE PLANTED AND PREPARE TREE FOR SHIPPING AND PLANTING

THE CONTRACTOR SHALL MAINTAIN ALL ACTIVITIES WITHIN THE EASEMENTS OR PUBLIC WAYS ANY AND ALL OTHER MEANS TO PERFORM THE WORK IS AT THE CONTRACTORS EXPENSE AND SHALL OBTAIN PERMISSION FROM ALL LAND OWNERS TO USE THEIR PROPERTY.

THE CONTRACTOR UNDER THE DIRECTION OF AN ARBORIST SHALL PREPARE THE SITE FOR THE PLANTING, FERTILIZE, WATER, TRIM ADD MULCH, STAKE AS NECESSARY, PROVIDE DRAINAGE AND MAINTAIN FOR ONE YEAR.

TREES, SHRUBS AND EVERGREENS TO BE PLANTED SHALL BE MEASURED IN INCH-DIAMETER. THE DIAMETER WILL BE MEASURED AT A POINT FOUR (4) FEET ABOVE THE HIGHEST GROUND LEVEL AT THE BASE OF THE TREE OR EVERGREEN AND WILL BE DETERMINED BY ASSURING THE CIRCUMFERENCE OF THE TREE AND DIVIDING THIS MEASURED CIRCUMFERENCE BY 3.1416.





THE BASIS OF PAYMENT:

THIS WORK SHALL BE PAID FOR AT THE CONTRACT PRICE FOR EACH TREE SPECIES INSTALLED COMPLETE AND PLANTED, 3 INCHES TO 5 INCHES, 6 INCHES TO 8 INCHES OR 9 INCHES TO 11 INCHES OR 12 INCHES TO 15 INCHES, THIS INCLUDES EXCAVATING, REMOVING BALL, FERTILIZERS, EQUIPMENT OF ALL TYPES, HAULING, LOADING, UNLOADING, TRAFFIC CONTROL, STORAGE, NEW 6" INCH LAYER OF BLACK DIRT, MULCH, EDGING, STAKING, REMOVE ALL EXCAVATED MATERIAL OFF SITE, REMOVING AND INSTALLING FENCES, TEMPORARY WORK TO GET TO SITE, SETTING AND ALIGNING, PROVIDE TREES WITH ALL WATERING AND FERTILIZER AS REQUIRED , WITH MAINTENANCE AND ONE-YEAR GUARANTEE FROM LAST PAYMENT FOR THE ENTIRE PROJECT.

NAPERVILLE PUBLIC UTILITIES DEPARTMENT	PLANTING TREES, SHRUBS, AND EVERGREENS 3" TO 5" DIA., 6" TO 8" DIA., 9" TO 11" DIA. AND 12" TO 15" DIA.	DATE: 05-01-05
ELECTRIC STANDARDS		Page 1 of 1 60468-1210








PROJECT TITLE				ROUTE 59 ROAD IMPROVEMENTS			
PROJECT DESCRIPTION				DETAILS AND STANDARDS			
ENGINEER	DRAFTING DATE	MAP #	SCALE				
BCC	5-11-12	4211,4212,4223	N.T.S.				
GIS DESIGN BY	DRAFTED BY	AT&T JOINT AGREEMENT #	PROJECT #				
DL	PSM	N/A	EU-12				
CHECKED BY	APPROVED BY	CAD FILE	SHEET #				
		0060648001D159.DWG	59 OF 63				
Naperville			Department of Public Utilities Electric Division			WORK REQUEST # 60468	

F.A.P. RTE.	SECTION	COUNTY	TOTAL SHEETS	SHEET NO.
338/IL 59	2011-035-1	DUPAGE		
CONTRACT 60P42				
FED.ROAD.DIST.NO.	ILLINOIS	FED. AID PROJECT		

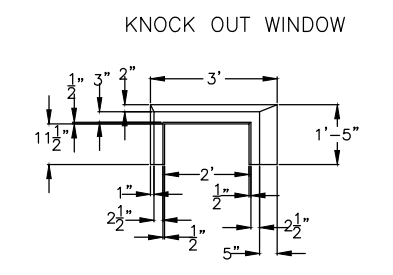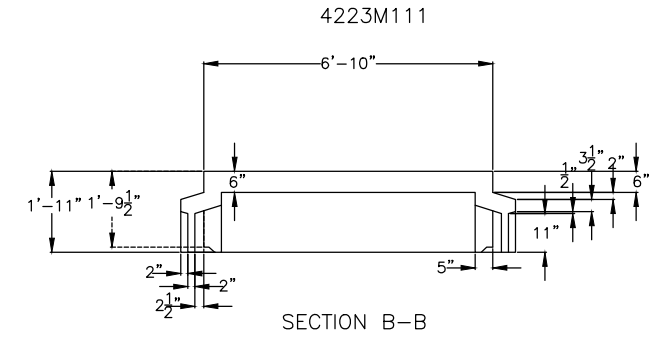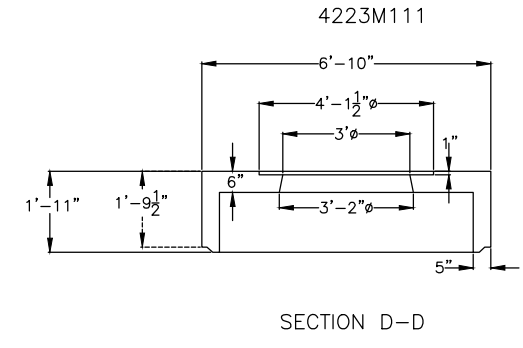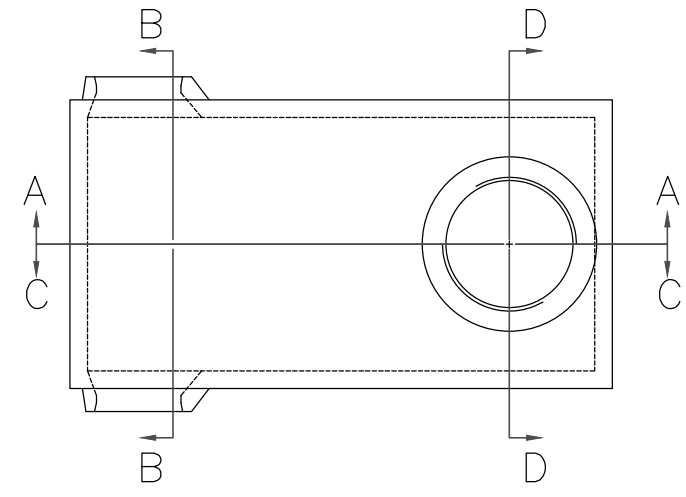











CONSTRUCTION NOTE:
CONTRACTOR TO REMOVE
KEY WAY FROM EXISTING BARREL
SECTION PRIOR TO NEW TOP
SECTION INSTALLATION.

PROPOSED NEW LOCATION
OF EXISTING CONDUIT
GROUT CONDUITS AFTER
TOP SECTION INSTALLATION.

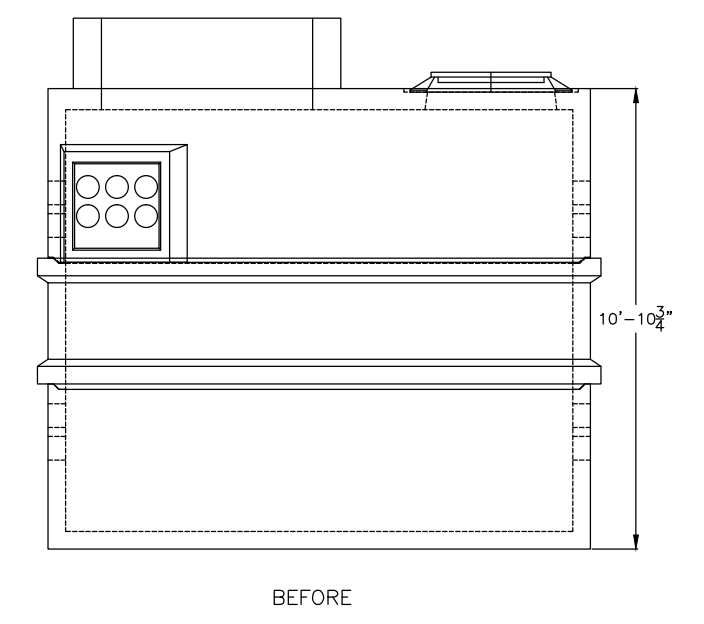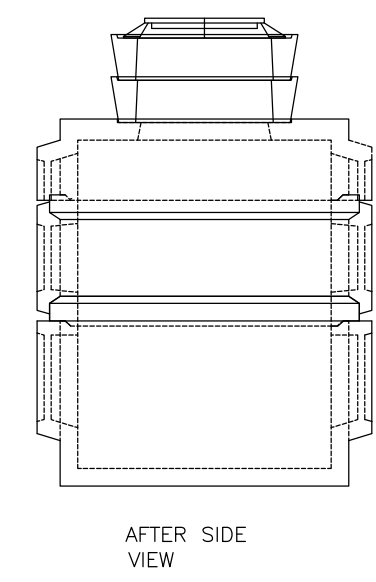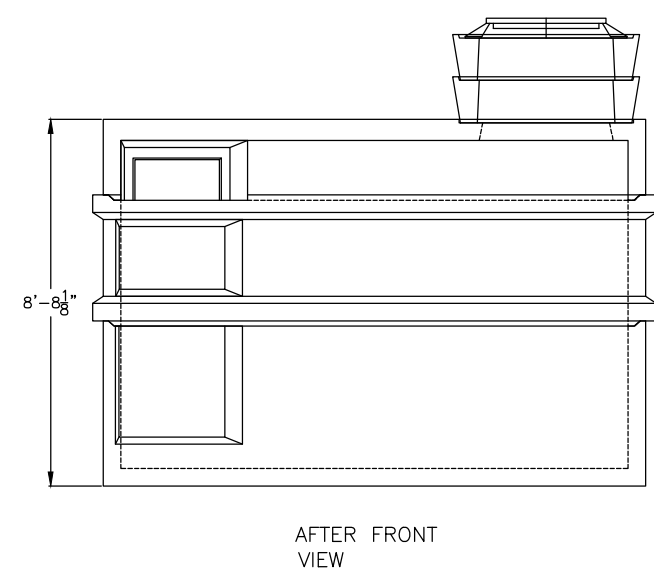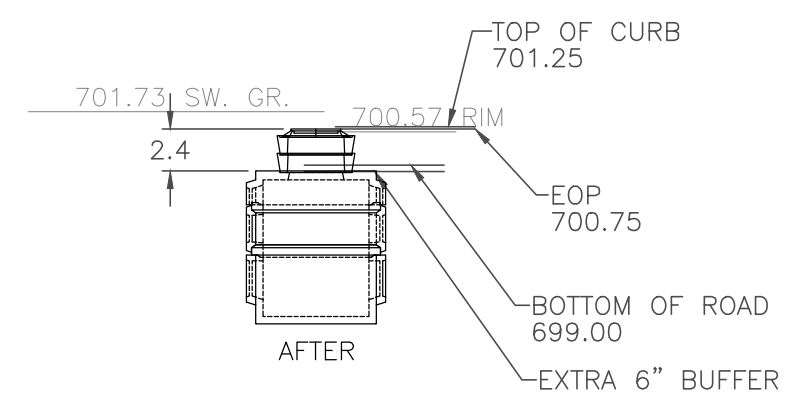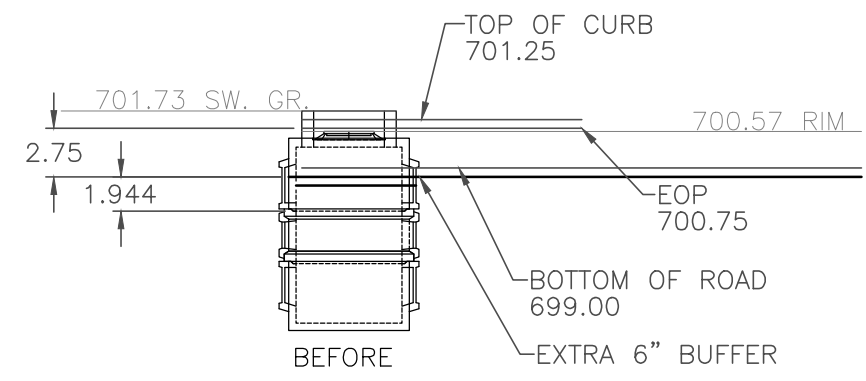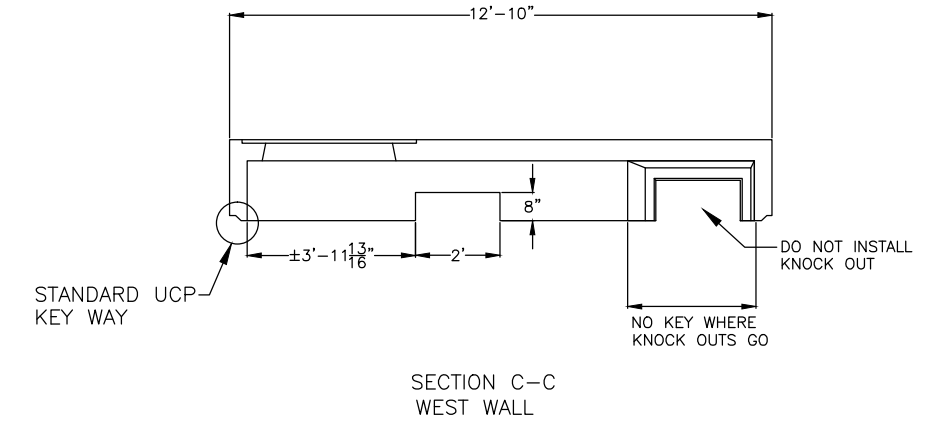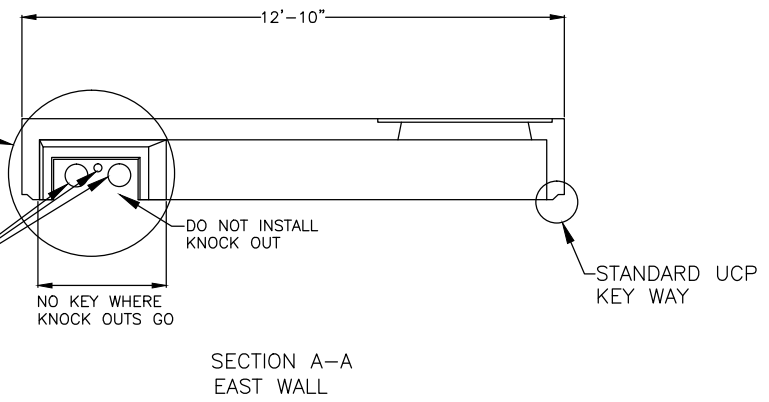

PROJECT TITLE					ROUTE 59 ROAD IMPROVEMENTS					
PROJECT DESCRIPTION					DETAILS AND STANDARDS					
ENGINEER	BCC	DRAFTING DATE	5-11-12	MAP #	4211,4212,4223	SCALE	N.T.S.			
GIS DESIGN BY	DL	DRAFTED BY	PSM	REVISIONS DATE	N/A	PROJECT #	EU-12			
CHECKED BY		APPROVED BY		CAD FILE	0060648001D160.DWG	SHEET #	60 OF 63			
Naperville				Department of Public Utilities Electric Division				WORK REQUEST # 60468		





F.A.P. RTE.	SECTION	COUNTY	TOTAL SHEETS	SHEET NO.
338/IL 59	2011-035-1	DUPAGE		
FED.ROAD.DIST.NO.			CONTRACT 60P42	
ILLINOIS			FED. AID PROJECT	

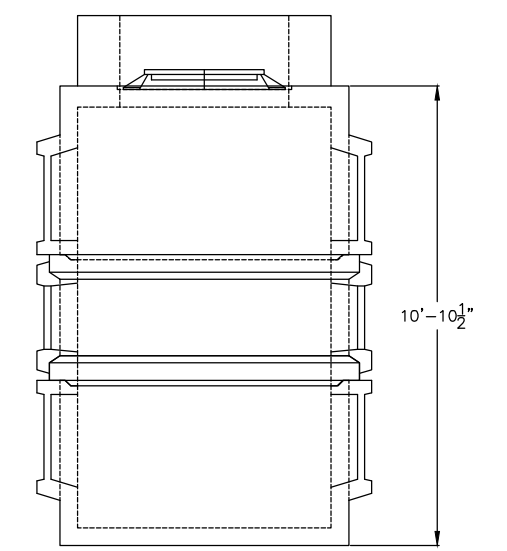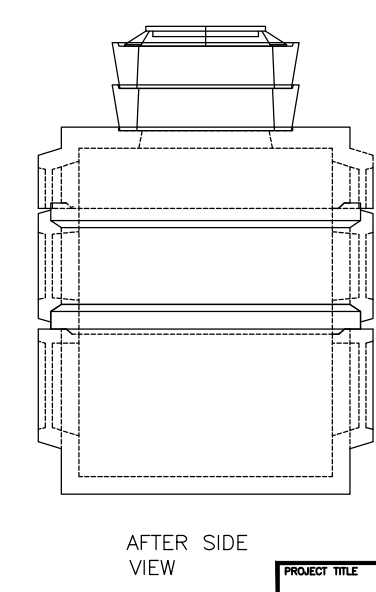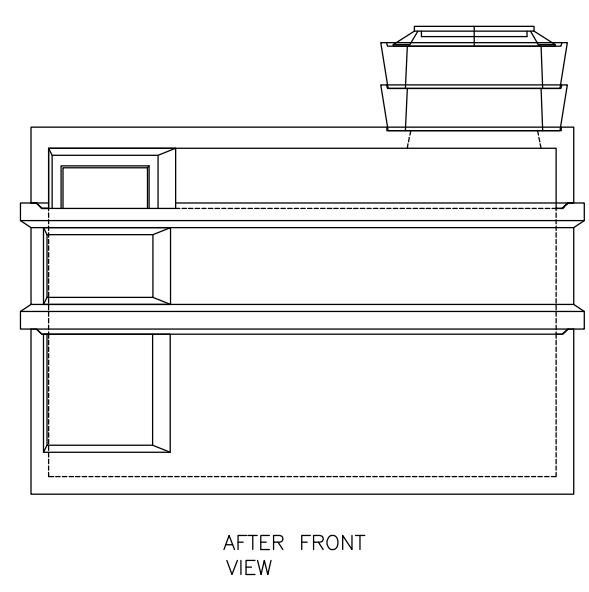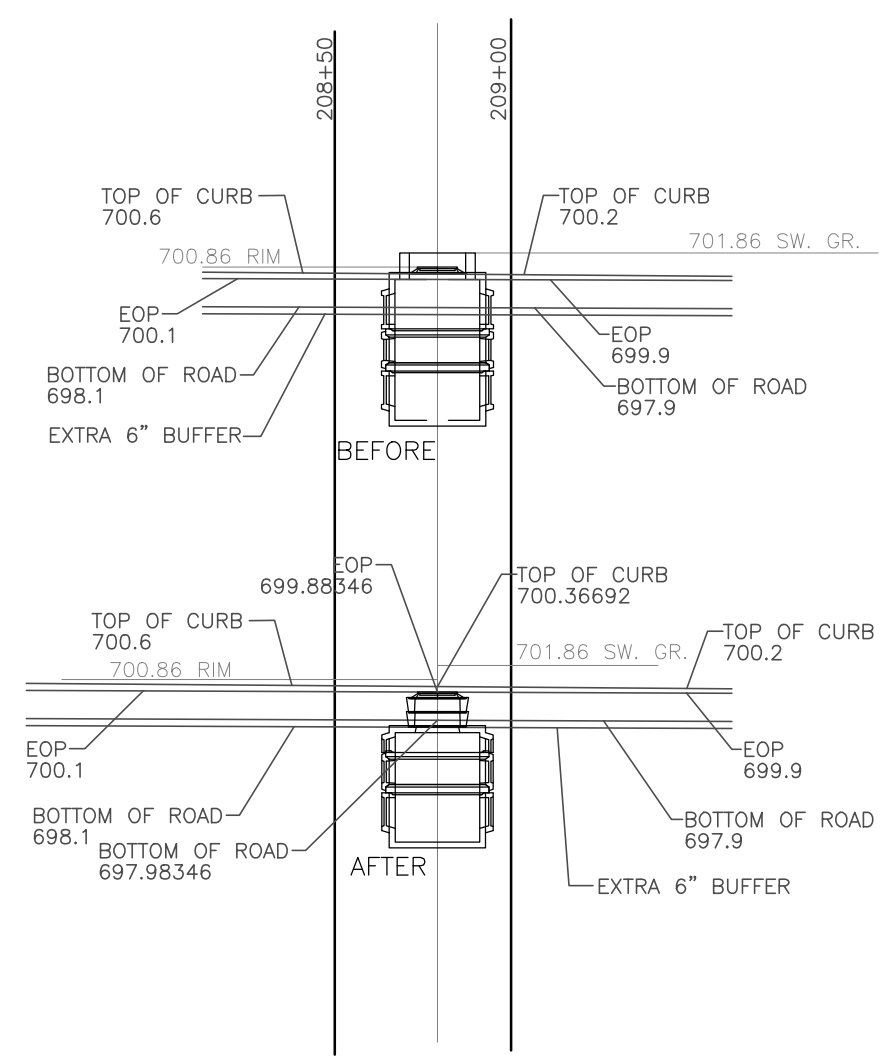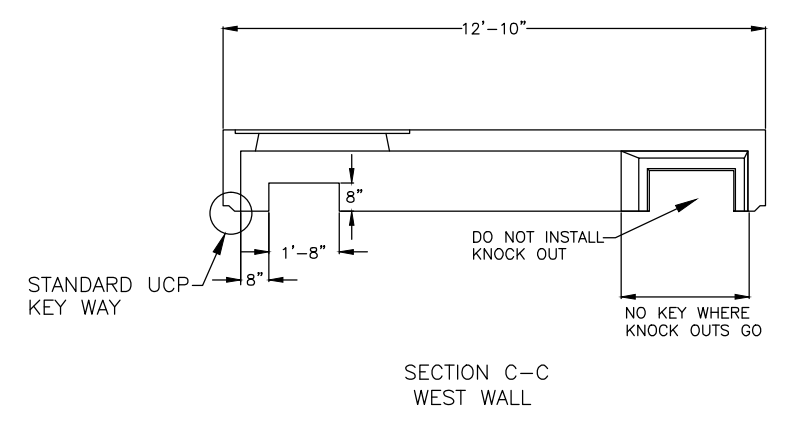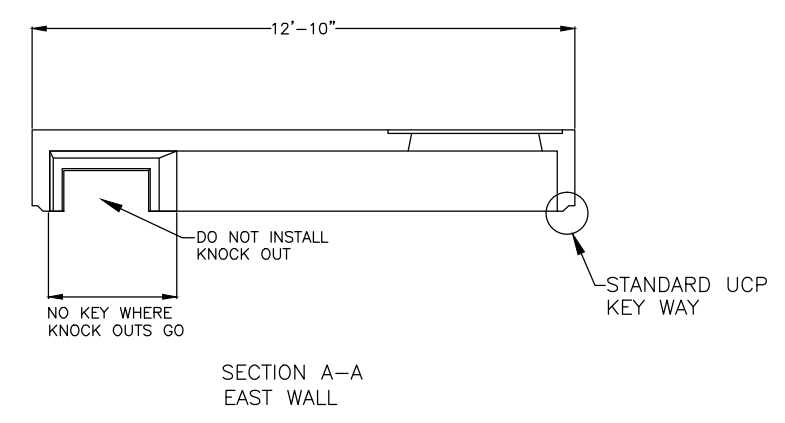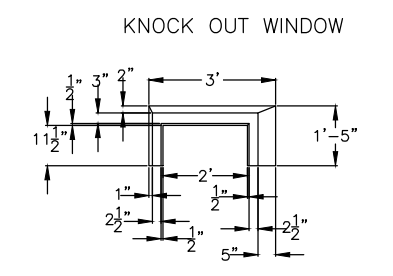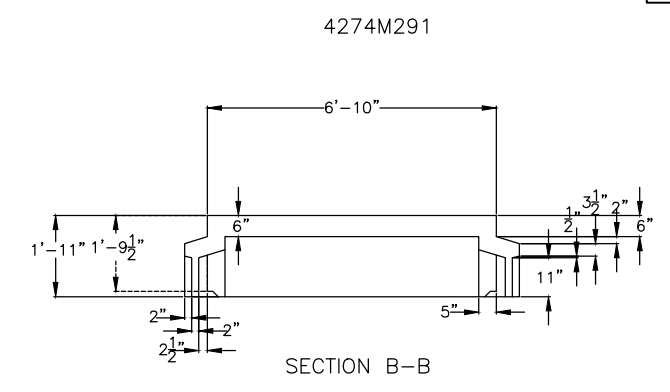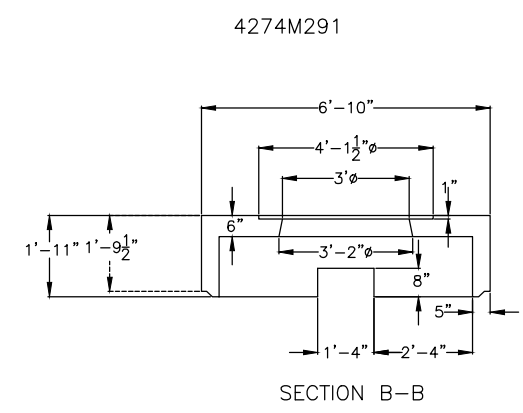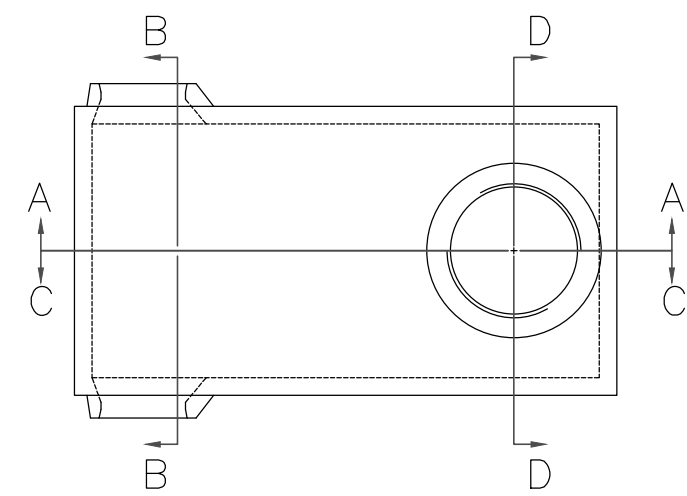

PROJECT TITLE					ROUTE 59 ROAD IMPROVEMENTS				
PROJECT DESCRIPTION									
DETAILS AND STANDARDS									
ENGINEER	DRAFTING DATE	MAP #	SCALE						
BCC	5-11-12	4211,4212,4223	N.T.S.						
GIS DESIGN BY	DRAFTED BY	REVISIONS DATE	AT&T JOINT AGREEMENT #	PROJECT #					
DL	PSM		N/A	EU-12					
CHECKED BY	APPROVED BY	CAD FILE	SHEET #						
		0060648001D161.DWG	61 OF 63						
Naperville			Department of Public Utilities			ELECTRIC DIVISION			
						WORK REQUEST #			
						60468			

F.A.P. RTE.	SECTION	COUNTY	TOTAL SHEETS	SHEET NO.
338/IL 59	2011-035-1	DUPAGE		
FED. ROAD. DIST. NO.			CONTRACT 60P42	
ILLINOIS			FED. AID PROJECT	

- 1) CONTRACTOR TO DIG DOWN AND EXPOSE TOP SECTION OF MANHOLE.
- 2) CUT OUT CONDUITS FROM EXISTING KNOCK OUT WINDOWS, AND REMOVE KEY WAY FROM UNDER KNOCK WINDOW OF TOP SECTION.

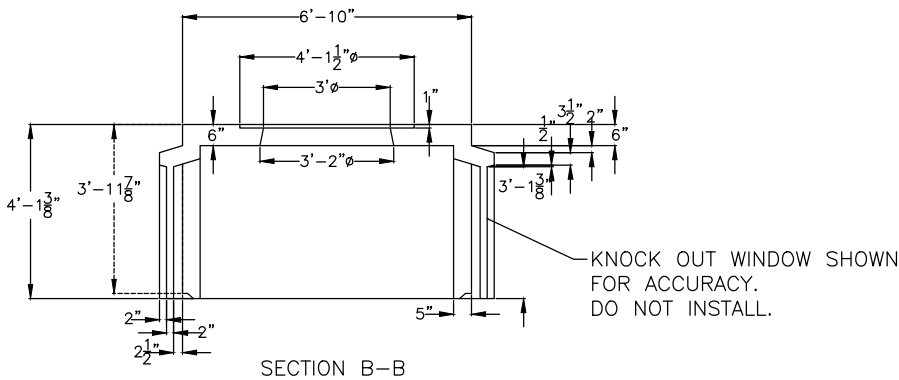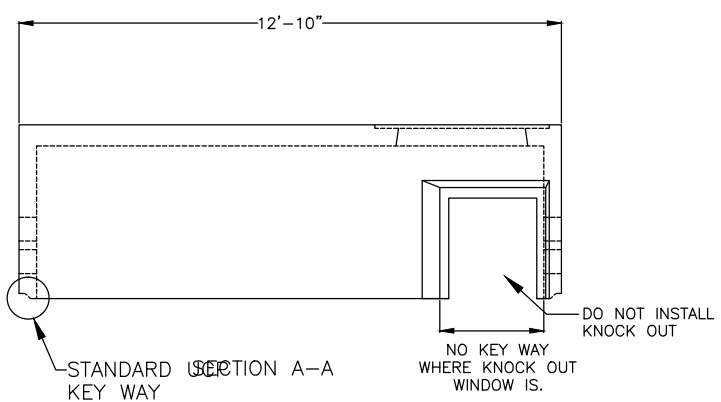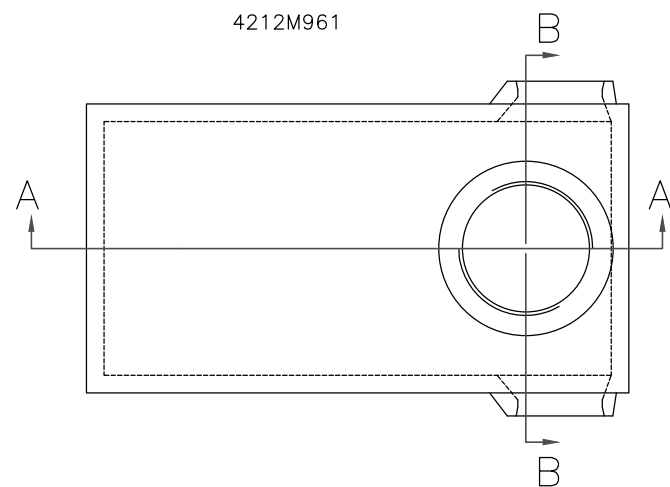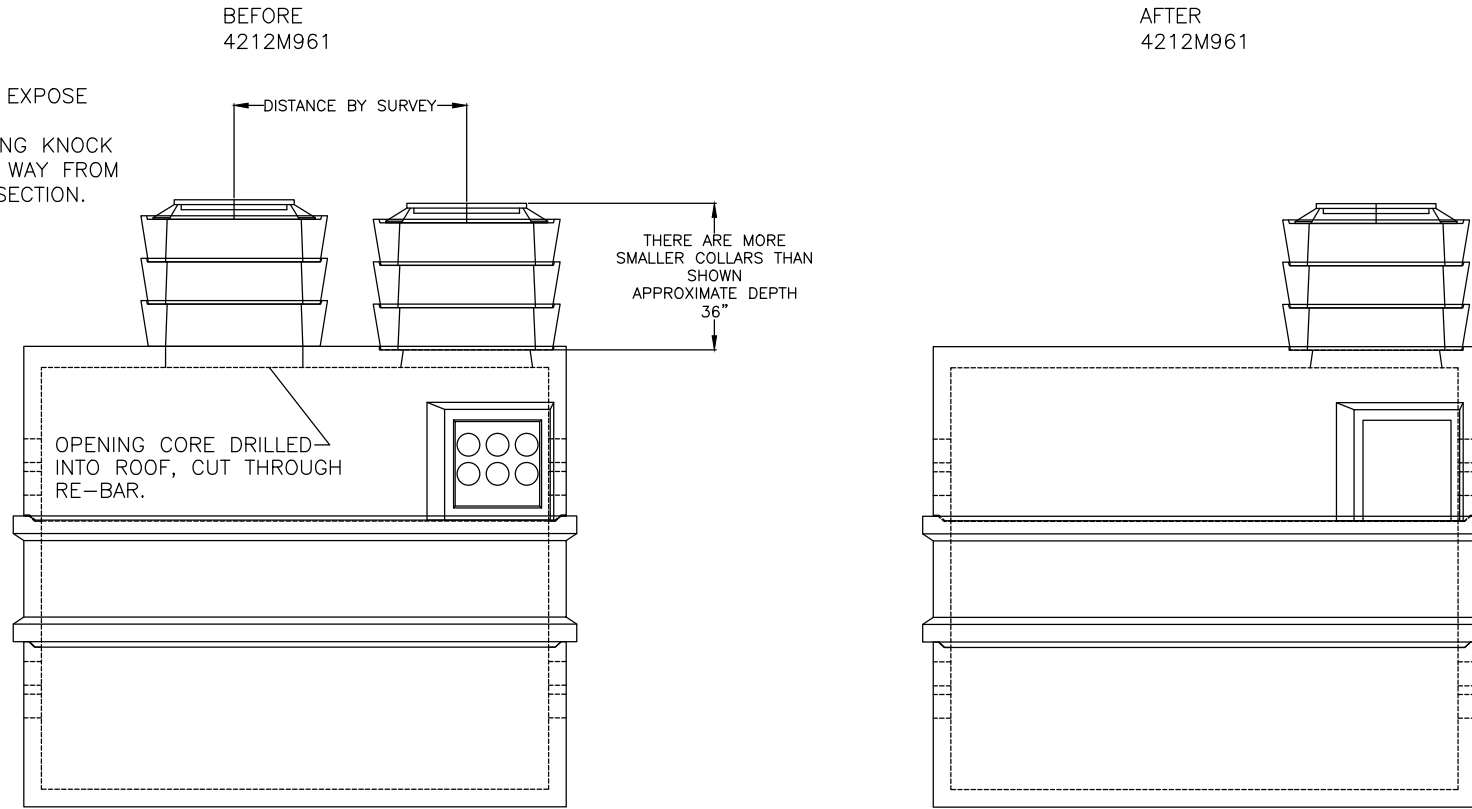

PROJECT TITLE					ROUTE 59 ROAD IMPROVEMENTS				
PROJECT DESCRIPTION					DETAILS AND STANDARDS				
ENGINEER	BCC	DRAFTING DATE	5-11-12	MAP #	4211,4212,4223	SCALE	N.T.S.		
GIS DESIGN BY	DL	DRAFTED BY	PSM	REVISIONS DATE		AT&T JOINT AGREEMENT #	N/A		
CHECKED BY		APPROVED BY		CAD FILE	0060648001D62.DWG	SHEET #	62 OF 63		
Naperville					Department of Public Utilities Electric Division				
					WORK REQUEST # 60468				

F.A.P. RTE.	SECTION	COUNTY	TOTAL SHEETS	SHEET NO.
338/IL 59	2011-035-1	DUPAGE		
			CONTRACT 60P42	
FED.ROAD.DIST.NO.	ILLINOIS	FED. AID PROJECT		

ELECTRIC DUCT BANK MATERIALS SUPPLIED BY THE CITY OF NAPERVILLE

Item Description	Part No.	HTE Code	Qty.	Unit
Encap. Conc. 1/3 Neutral 1000mcm cu	280-112-00140		22080	Each
Crossarm, Wood 10 foot	282-105-00030		4	Each
Brace Crossarm 60" Span 18" Drop	282-106-00030		4	Each
Manhole Type "A" PRECAST UCP	284-103-00140	DEMA	1	Each
Manhole Type "E" PRECAST UCP	284-103-00160	DEME	3	Each
Manhole Type "G" PRECAST UCP	284-103-00170	DEMG	4	Each
Anchor System 7"x1" Rodtriple eyenut	283-101-00040		4	Each
Vault, Switchgear, 74"x76" Fibercrete	284-101-00010	DEVA	3	Each
Bolt, Double Arms 8" x 22"	283-104-00050		6	Each
Guy Plate 3/4"	283-123-00010		4	Each
Clamp, De Wedge 4 / 0 -477 44.93	283-128-00050		3	Feet
Conduit 6" Dia Schedule 40 PVC Pipe	285-100-00070	D6C	22420	Feet
Guy Guard, Yellow 8"	283-133-00010		4	Feet
Bolt, Machine 8" x 12"	283-106-00110		5	Each
Bolt Machine 3/4" x 12"	283-106-00210		8	Each
Elbow 6" Steel 48" Radius, 22°	285-101-00188	D6B22S	64	Each
Elbow 6" Steel 48" Radius, 30°	285-101-00190	D6B30S	46	Each
Elbow 6" Steel 48" Radius, 11°	285-101-00186	D6B11S	34	Each
Elbow 5" Steel 36" Radius, 30°	285-101-00080	D5B30S	4	Each
Elbow 3" Sch. 40 PVC 36" Radius, 90°	285-100-00040	D3B90P	39	Each
Screw Lag 1/2" x 4"	283-112-00010		4	Each
Coupling Sleeve 6" PVC Long Line	285-102-00130	D6V	120	Each
Coupling 6" Long Line Schedule 40 PVC	285-102-00140	D6L	295	Each
Coupling 6" Schedule 40 PVC 5°	285-102-00150	D6L5	124	Each
Bolt, Carriage 1/2" x 6"	283-108-00030		4	Each
Washer, Square 2"x 2"x 11/16"/H	283-117-00050		25	Each
Washer, Curved 4"x4"x 15/16"	283-117-00090		8	Each
Washer, DBL Coil Springs 1/2"	283-117-00100		4	Each
Washer, DBL Coil Springs 8"	283-117-00110		15	Each
Molding, Ground Wire 1/2" Plastic x 8'	283-134-00010		3	Each
Staple, cu 1/2"	283-15-00120		16	Each
Grip, Dead End Pref 3/6" Steel Wire	283-138-00110		16	Each
Insulator, Guy Strain 18" Fiberglass Roller	283-144-00010		4	Each
Insulator, Guy Strain 35" Fiberglass Rod	283-144-00020		4	Each
Eyelet, Standard 5/8" Slot	283-159-00010		3	Each
Ring, Adjusting, Concrete 36"	284-103-00080		6	Each
Cement PVC Quarts with Brush 24hr Dry Summer	285-199-00090	DMG	2.85	Each

NAPERVILLE PUBLIC UTILITIES DEPARTMENT	LIST OF ELECTRIC DUCT BANK MATERIALS	DATE: 05-01-05 Page 1 of 3 60468-1320
--	--------------------------------------	---

ELECTRIC DUCT BANK MATERIALS SUPPLIED BY THE CITY OF NAPERVILLE

Item Description	Part No.	HTE Code	Qty.	Unit
Spacer, Base PVC, 6"	285-199-00170	D6R	2122	Each
Spacer, Intermediate PVC 6"	285-199-00180	D6R1	2140	Each
Splice, 35kV 1000mcm cu, 345 MIL	284-115-00175		36	Each
Shrink Wrap, Heat, 48" 1.65 - 4.95	284-117-00410		36	Each
UG Cable Wall Rack 24" 8 Holes	284-199-00390		40	Each
UG Cable Wall Rack Arm 23.5"	284-199-00410		40	Each
Cable Rack Saddles Plastics 5"	284-199-00420		120	Each
Elbow, 48" PVC 30 Deg 6" Sch 40	285-101-00220		6	Each
Plug, PVC 6" With Pull Tab	285-103-00090		14	Each
Bell Fitting, Pvc 6" Sch 40 & Sch 80	285-103-00100		14	Each
Connector, Wedge AL / CU/0-2, 4/0 STR	286-100-00040		1	Each
Connector, Wedge CU #2 Sol -5/8 Rod	286-100-00290		1	Each
Connector, Wedge Cu 4/0 Str (7) - 2# sol	286-100-00296		76	Each
Grounding #2 solid Copper (500 ft / reel)	280-107-00020	UGMH	670	Feet
Grounding 4/0 Stranded Bare Copper/19 strand (500 ft / reel)	280-107-00070	UGMH	545	Feet
Grounding Rod Copper Clad 5/8"x10'	283-156-00010	UGMH	13	Each
5 Ft ground Rod Copper Clad 5/8" (manholes)	283-156-00030	UGMH	32	Each
Connector, Lug CU#2 SR 1 Hole 3/8" Bolt	286-103-00068		40	Each
Splice Compression CU500 x 500mcm str	286-106-00160		36	Each
Extender Air Switch Vault Fiber	284-101-00100	DEVAE	1	Each
Copper Bare #4 7 Strand (500 ft /reel)	280-107-00050	UGT3	244	Each
Connector Wedge #4 str to 5/8 Rod	286-100-00320	UGMH	28	Each
Frame and Cover for Manholes type "B"	284-103-00050	DEML	15	Each
6" Ring for Manhole	284-103-00090	DEMR6	6	Each
2" Ring for Manhole	284-103-00070	DEMR2	6	FT
Butyl Mastic	892-370-00004		33	Reel
CU Bare SD 4/0 19-STR	280-107-00070		190	Each
Ground Rod, Copper Clads 8" x 10'	283-156-00010		8	Each
Ground Rod, Copper Clads 8" xd 5' for Manholes	283-156-00030		4	Each
Coupling, Bronzes /8" Rod	283-156-00040		2	Each
Pad Vault Fiber -Concrete 74"x76"x36"	284-101-00010		3	Each
Frame Lid Manhole, Steel Type "B"	284-103-00050		2	Each
Manhole, Type G-12 '6L x 10' 9" x 9' H	284-103-00170		1	Each
Conduit, SCH 40 PVC 6"	285-100-00070		4500	Each
Elbow, 48" R STL 30 DEG 6" Gal	285-101-00190		20	Each
Elbow, 48" R STL 90 DEG 6" HW- FG	285-101-00210		16	Each
Elbow 48" R PVC 30 DEG 6" SCH 40	285-101-00220		6	Each
Plug, PVC 6" With Pull Tab	285-103-00090		20	Each
Bell Fitting, PVC 6"			22	Each



NAPERVILLE PUBLIC UTILITIES DEPARTMENT	LIST OF ELECTRIC DUCT BANK MATERIALS	DATE: 05-01-05 Page 2 of 3 60468-1320
--	--------------------------------------	---

ELECTRIC DUCT BANK MATERIALS SUPPLIED BY THE CITY OF NAPERVILLE

Item Description	Part No.	HTE Code	Qty.	Unit
Coupling, PVC 6" Stopping line Sch 40	285-102-00140		36	Each
Spacer, Base PVC 6" x 2"	285-199-00170		302	Each
Spacer, Intermediate PVC 6" x 2"	285-199-00180		578	Each
Connector, Wedge CU 4/0 STR (7)	286-100-00260		9	Each
Connector Wedge CU 4/0 STR (7)	286-100-00320		10	Each

NAPERVILLE PUBLIC UTILITIES DEPARTMENT	LIST OF ELECTRIC DUCT BANK MATERIALS	DATE: 05-01-05 Page 3 of 3 60468-1320
--	--------------------------------------	---

PROJECT TITLE				ROUTE 59 ROAD IMPROVEMENTS			
PROJECT DESCRIPTION				CITY OF NAPERVILLE MATERIAL LIST			
ENGINEER	DRAFTING DATE	MAP #	SCALE				
BCC	5-11-12	4211,4212,4223	N.T.S.				
GS DESIGN BY	DRAFTED BY	REVISIONS DATE	AT&T JOINT AGREEMENT #	PROJECT #			
DL	PSM		N/A	EU-12			
CHECKED BY	APPROVED BY	CAD FILE	SHEET #				
		0060648001D163.DWG	63 OF 63				
Naperville			Department of Public Utilities Electric Division			WORK REQUEST # 60468	

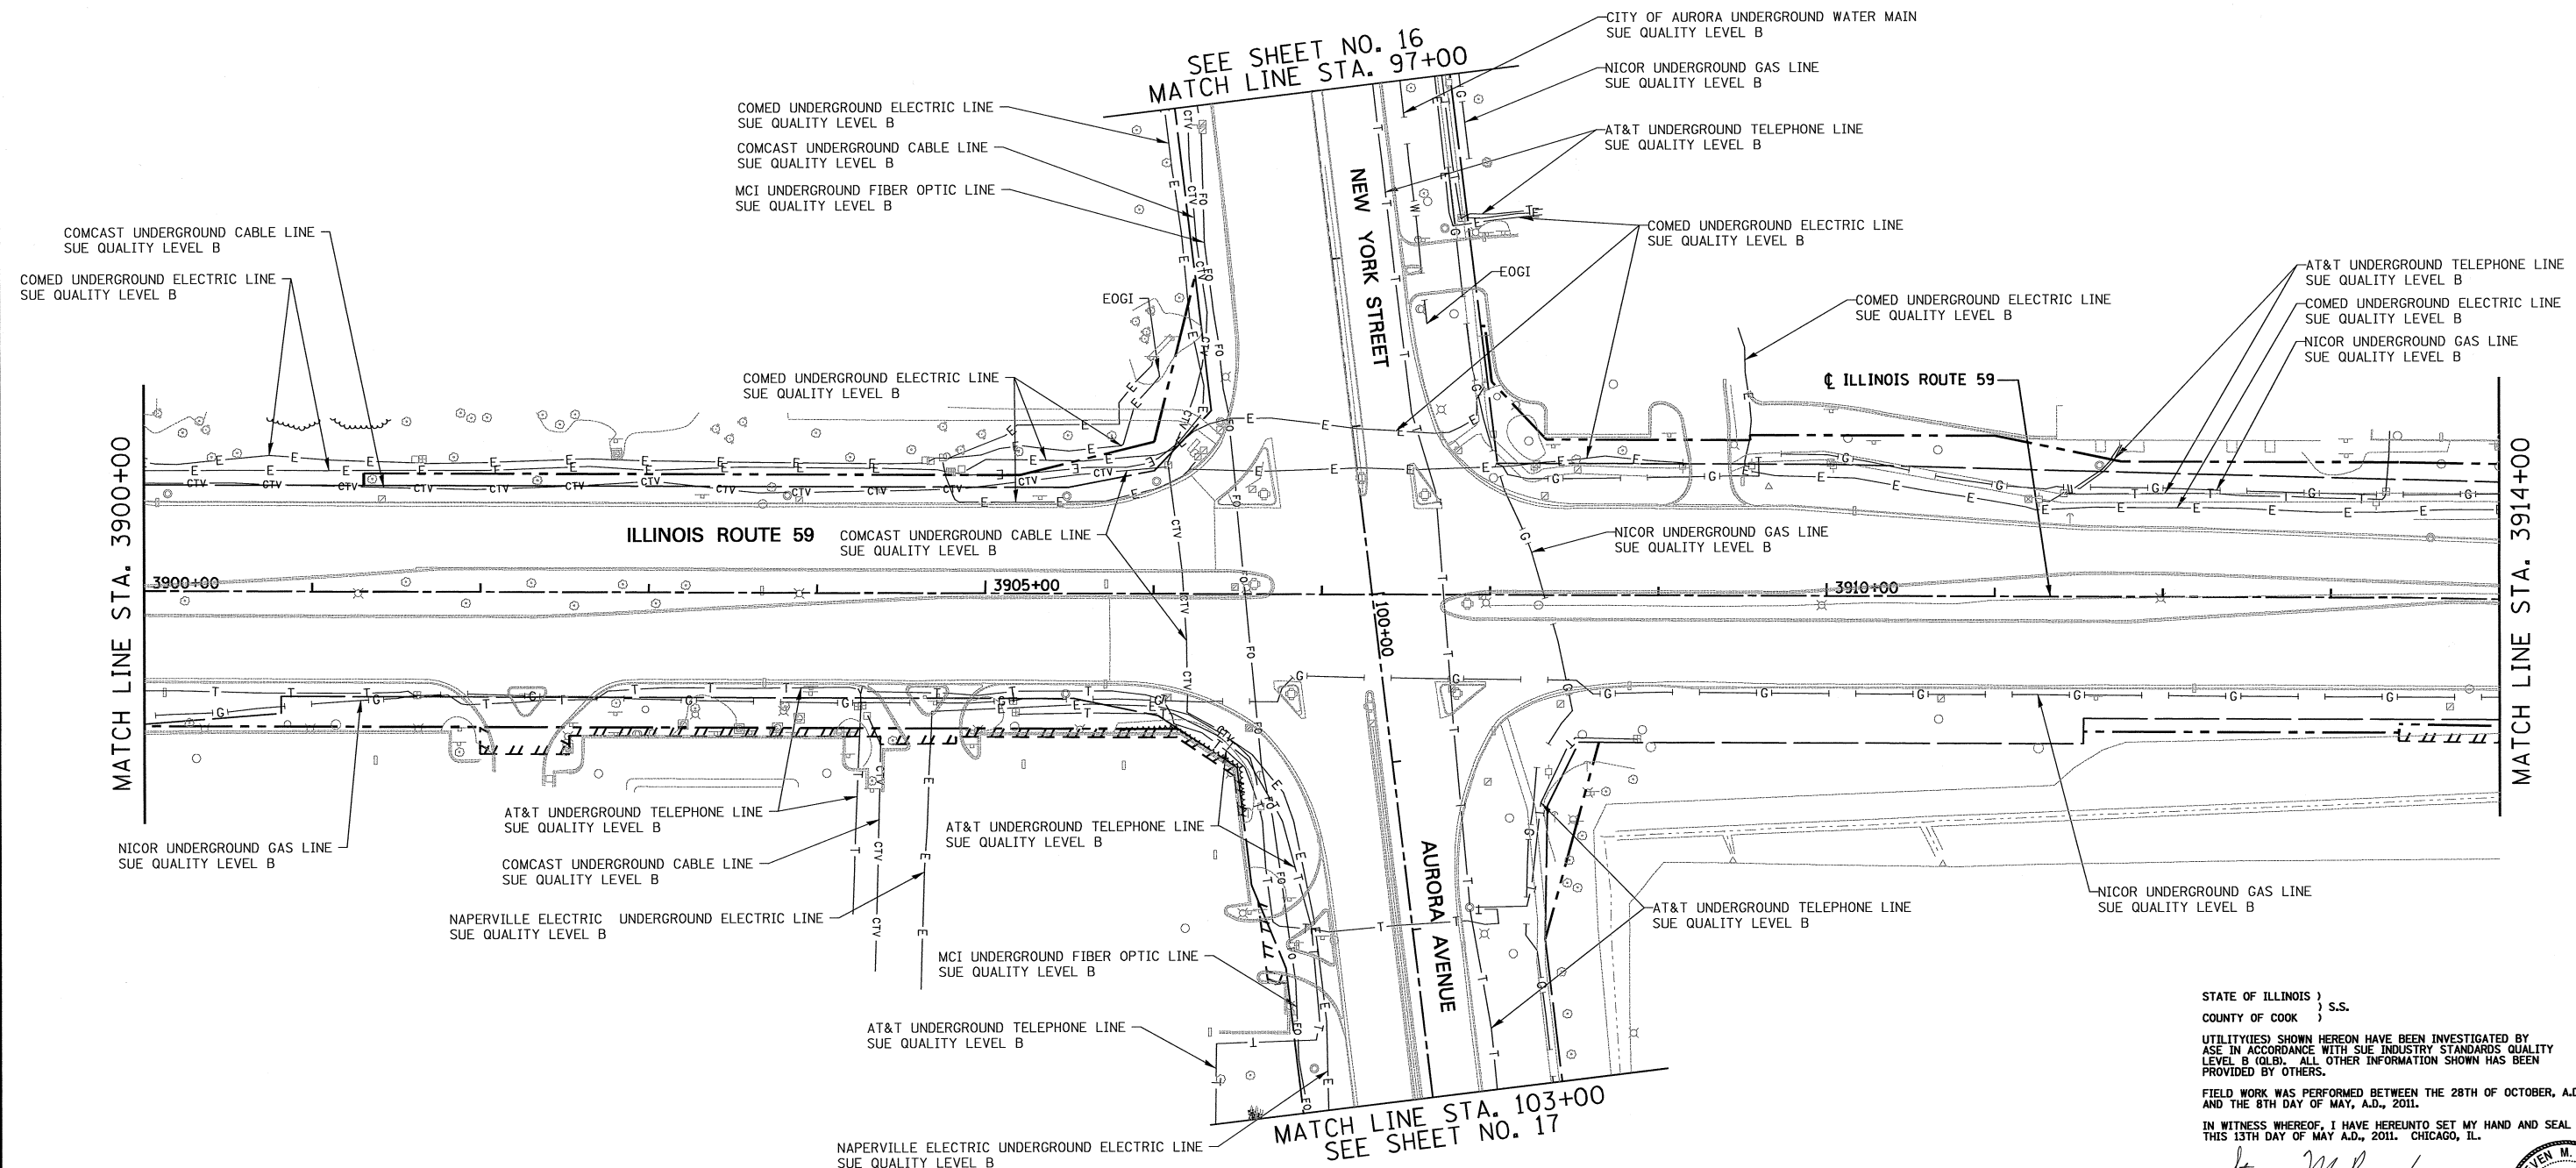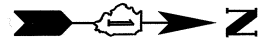

STATE OF ILLINOIS)
) S.S.
 COUNTY OF COOK)

UTILITIES SHOWN HEREON HAVE BEEN INVESTIGATED BY ASE IN ACCORDANCE WITH SUE INDUSTRY STANDARDS QUALITY LEVEL B (QLB). ALL OTHER INFORMATION SHOWN HAS BEEN PROVIDED BY OTHERS.


FIELD WORK WAS PERFORMED BETWEEN THE 28TH OF OCTOBER, A.D., 2010 AND THE 8TH DAY OF MAY, A.D., 2011.

IN WITNESS WHEREOF, I HAVE HEREUNTO SET MY HAND AND SEAL THIS 13TH DAY OF MAY, A.D., 2011. CHICAGO, IL.

Steven M. Rienks
 STEVEN M. RIENKS - ILLINOIS PROFESSIONAL ENGINEER
 ENGINEER NUMBER 62-044619
 MY LICENSE EXPIRES 11/30/2011



- LEGEND**
- T — EXISTING UNDERGROUND TELEPHONE
 - W — EXISTING UNDERGROUND WATER
 - E — EXISTING UNDERGROUND ELECTRIC
 - G — EXISTING UNDERGROUND GAS
 - CTV — EXISTING UNDERGROUND CABLE TV
 - FO — EXISTING UNDERGROUND FIBER OPTIC
 - S — EXISTING UNDERGROUND SANITARY SEWER
 - EOGI END OF SURFACE GEOPHYSICAL INFORMATION

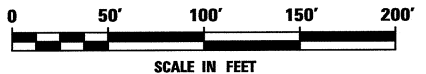

AMERICAN
 SURVEYING & ENGINEERING, P.C.
 SURVEYORS - ENGINEERS
 GEODESISTS - MAPPING SCIENTISTS

Chicago 312-277-2000 / Fax 312-277-2002
 Duane 815-288-6231 / Fax 815-288-6277
 Aurora 630-997-4105 / Fax 630-997-4121
 Illinois Professional Design Firm No. 184-003192

6799-ah-t-SUE-02.dgn

USER NAME = #USER#	DESIGNED T.SANDERSON	REVISED -
PLOT SCALE = 50.00' / IN.	DRAWN B.TRAVER	REVISED -
PLOT DATE = 5/12/2011	CHECKED S.RIENKS	REVISED -
	DATE 5/13/2011	REVISED -

**STATE OF ILLINOIS
 DEPARTMENT OF TRANSPORTATION**


**SUE INVESTIGATION OF UNDERGROUND UTILITIES
 NEW YORK STREET TO FERRY ROAD**

SCALE: AS SHOWN SHEET NO. 2 OF 27 SHEETS STA. 3900+00 TO STA. 3914+00

CONTRACT 60P42 SHEET 196 OF 234

F.A.P. RTE.	SECTION	COUNTY	TOTAL SHEETS	SHEET NO.
338/IL 59	(112 & 113) WRS-5	DUPAGE	27	2

CONTRACT NO. 60131
 ILLINOIS FED. AID PROJECT

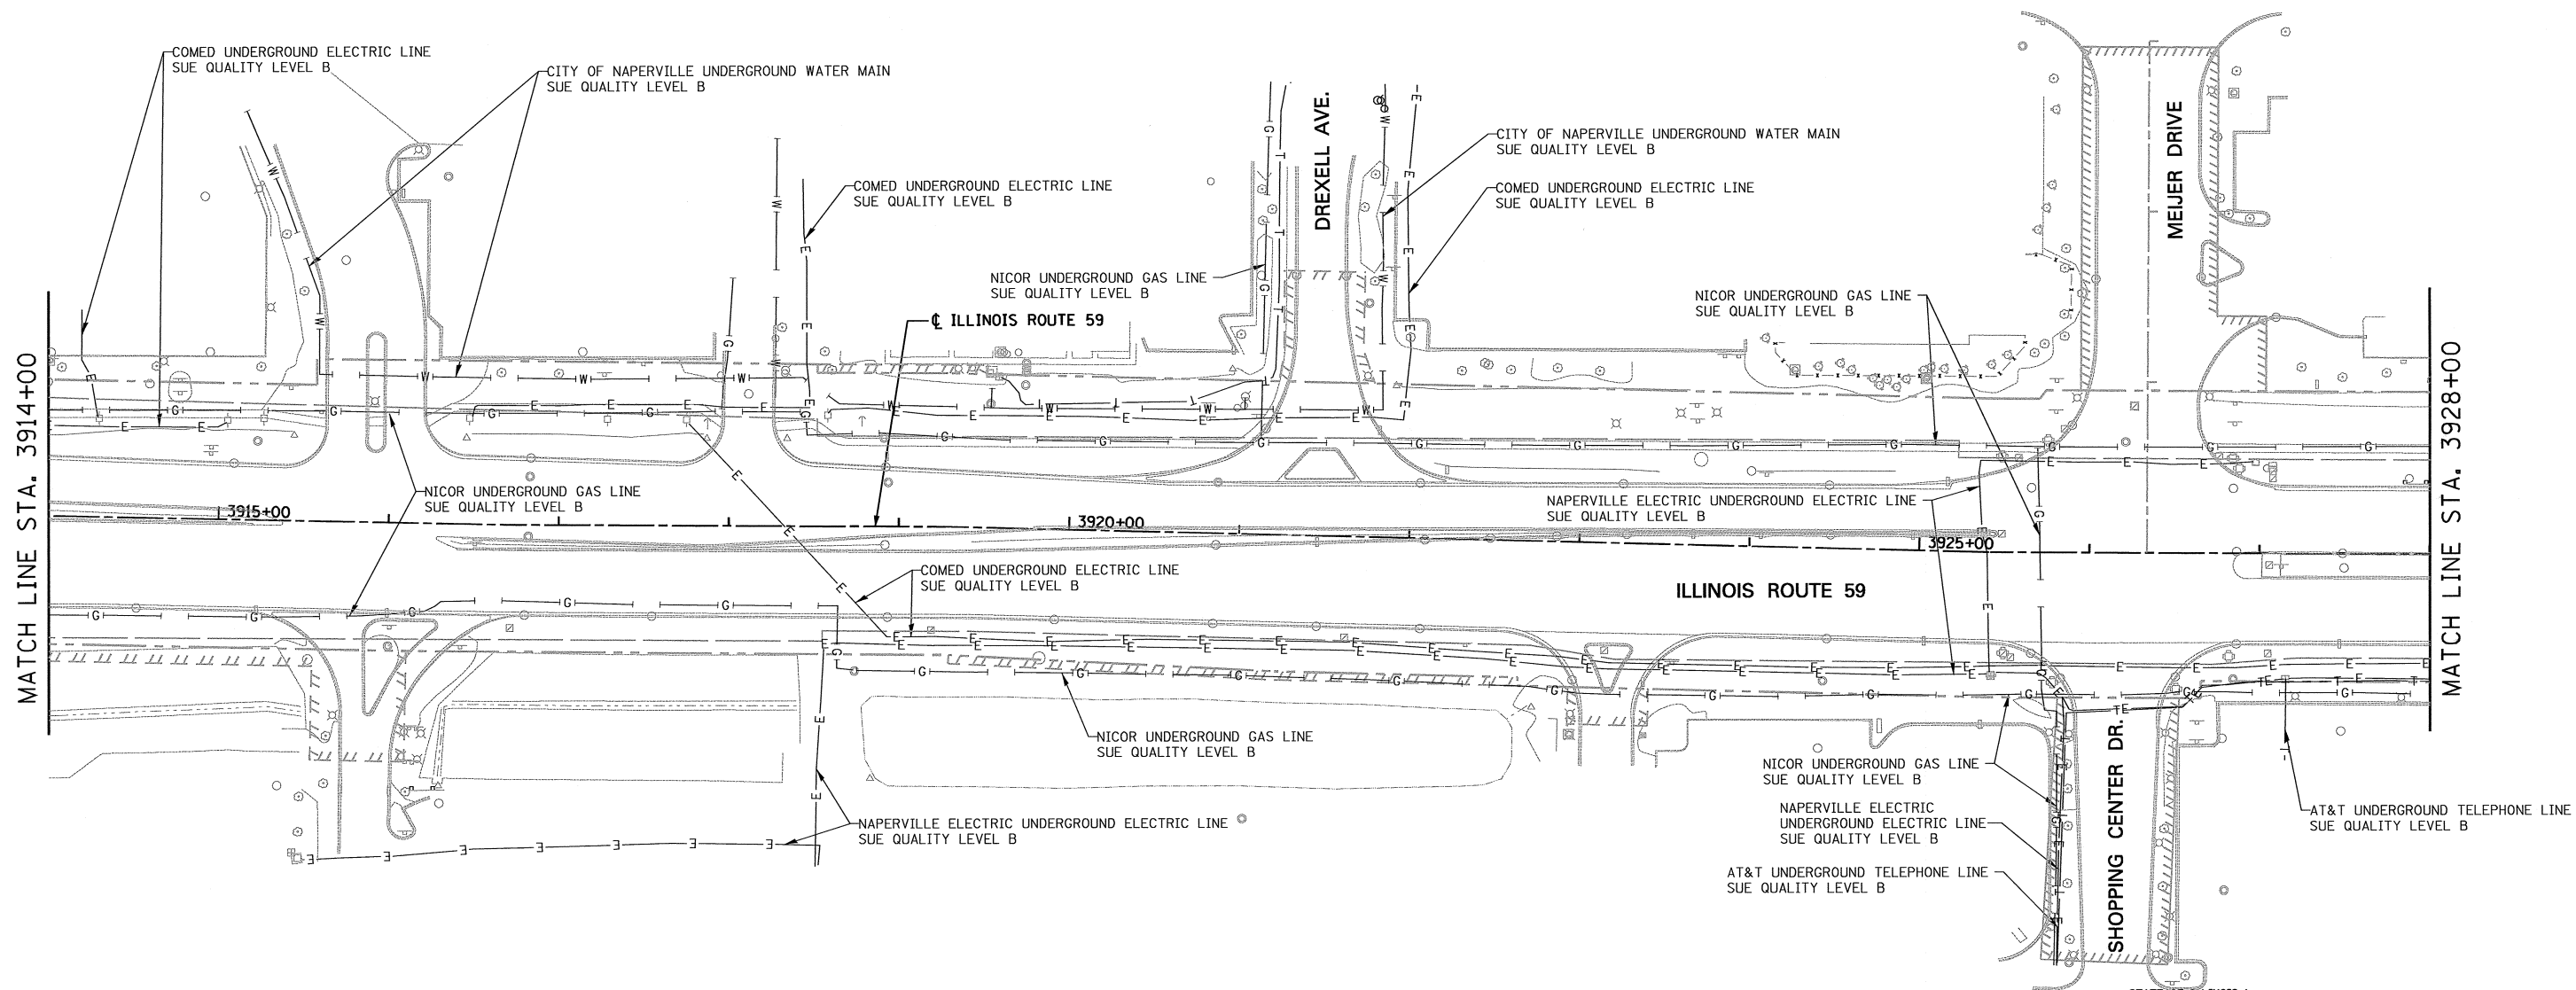

STATE OF ILLINOIS)
COUNTY OF COOK) S.S.


UTILITY(IES) SHOWN HEREON HAVE BEEN INVESTIGATED BY ASE IN ACCORDANCE WITH SUE INDUSTRY STANDARDS QUALITY LEVEL B (QLB). ALL OTHER INFORMATION SHOWN HAS BEEN PROVIDED BY OTHERS.

FIELD WORK WAS PERFORMED BETWEEN THE 28TH OF OCTOBER, A.D., 2010 AND THE 8TH DAY OF MAY, A.D., 2011.

IN WITNESS WHEREOF, I HAVE HEREUNTO SET MY HAND AND SEAL THIS 13TH DAY OF MAY A.D., 2011. CHICAGO, IL.

Steven M. Rienks
STEVEN M. RIENKS - ILLINOIS PROFESSIONAL
ENGINEER NUMBER 62-044619
MY LICENSE EXPIRES 11/30/2011

- LEGEND**
- T — EXISTING UNDERGROUND TELEPHONE
 - W — EXISTING UNDERGROUND WATER
 - E — EXISTING UNDERGROUND ELECTRIC
 - G — EXISTING UNDERGROUND GAS
 - CTV — EXISTING UNDERGROUND CABLE TV
 - FO — EXISTING UNDERGROUND FIBER OPTIC
 - S — EXISTING UNDERGROUND SANITARY SEWER
 - EOGI END OF SURFACE GEOPHYSICAL INFORMATION

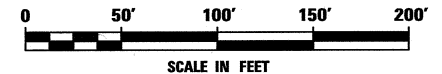

AMERICAN
SURVEYING & ENGINEERING, P.C.
SURVEYORS - ENGINEERS
GEODESISTS - MAPPING SCIENTISTS
Chicago 312-277-2000 / Fax 312-277-2002
Downer 815-288-6231 / Fax 815-288-6277
Aurora 630-897-4105 / Fax 630-897-4121
Illinois Professional Design Firm No. 184-003192

6799-aht-SUE-03.dgn
USER NAME = #USER#
DESIGNED T.SANDERSON
DRAWN B.TRAVER
CHECKED S.RIENKS
DATE 5/13/2011

REVISIONS
REVISED -
REVISED -
REVISED -
REVISED -

**STATE OF ILLINOIS
DEPARTMENT OF TRANSPORTATION**


**SUE INVESTIGATION OF UNDERGROUND UTILITIES
NEW YORK STREET TO FERRY ROAD**

SCALE: AS SHOWN SHEET NO. 3 OF 27 SHEETS STA. 3914+00 TO STA. 3928+00

CONTRACT 60P42 SHEET 197 OF 234

F.A.P. RTE.	SECTION	COUNTY	TOTAL SHEETS	SHEET NO.
338/IL 59	(112 & 113) WRS-5	DUPAGE	27	3

CONTRACT NO. 60I31
ILLINOIS FED. AID PROJECT

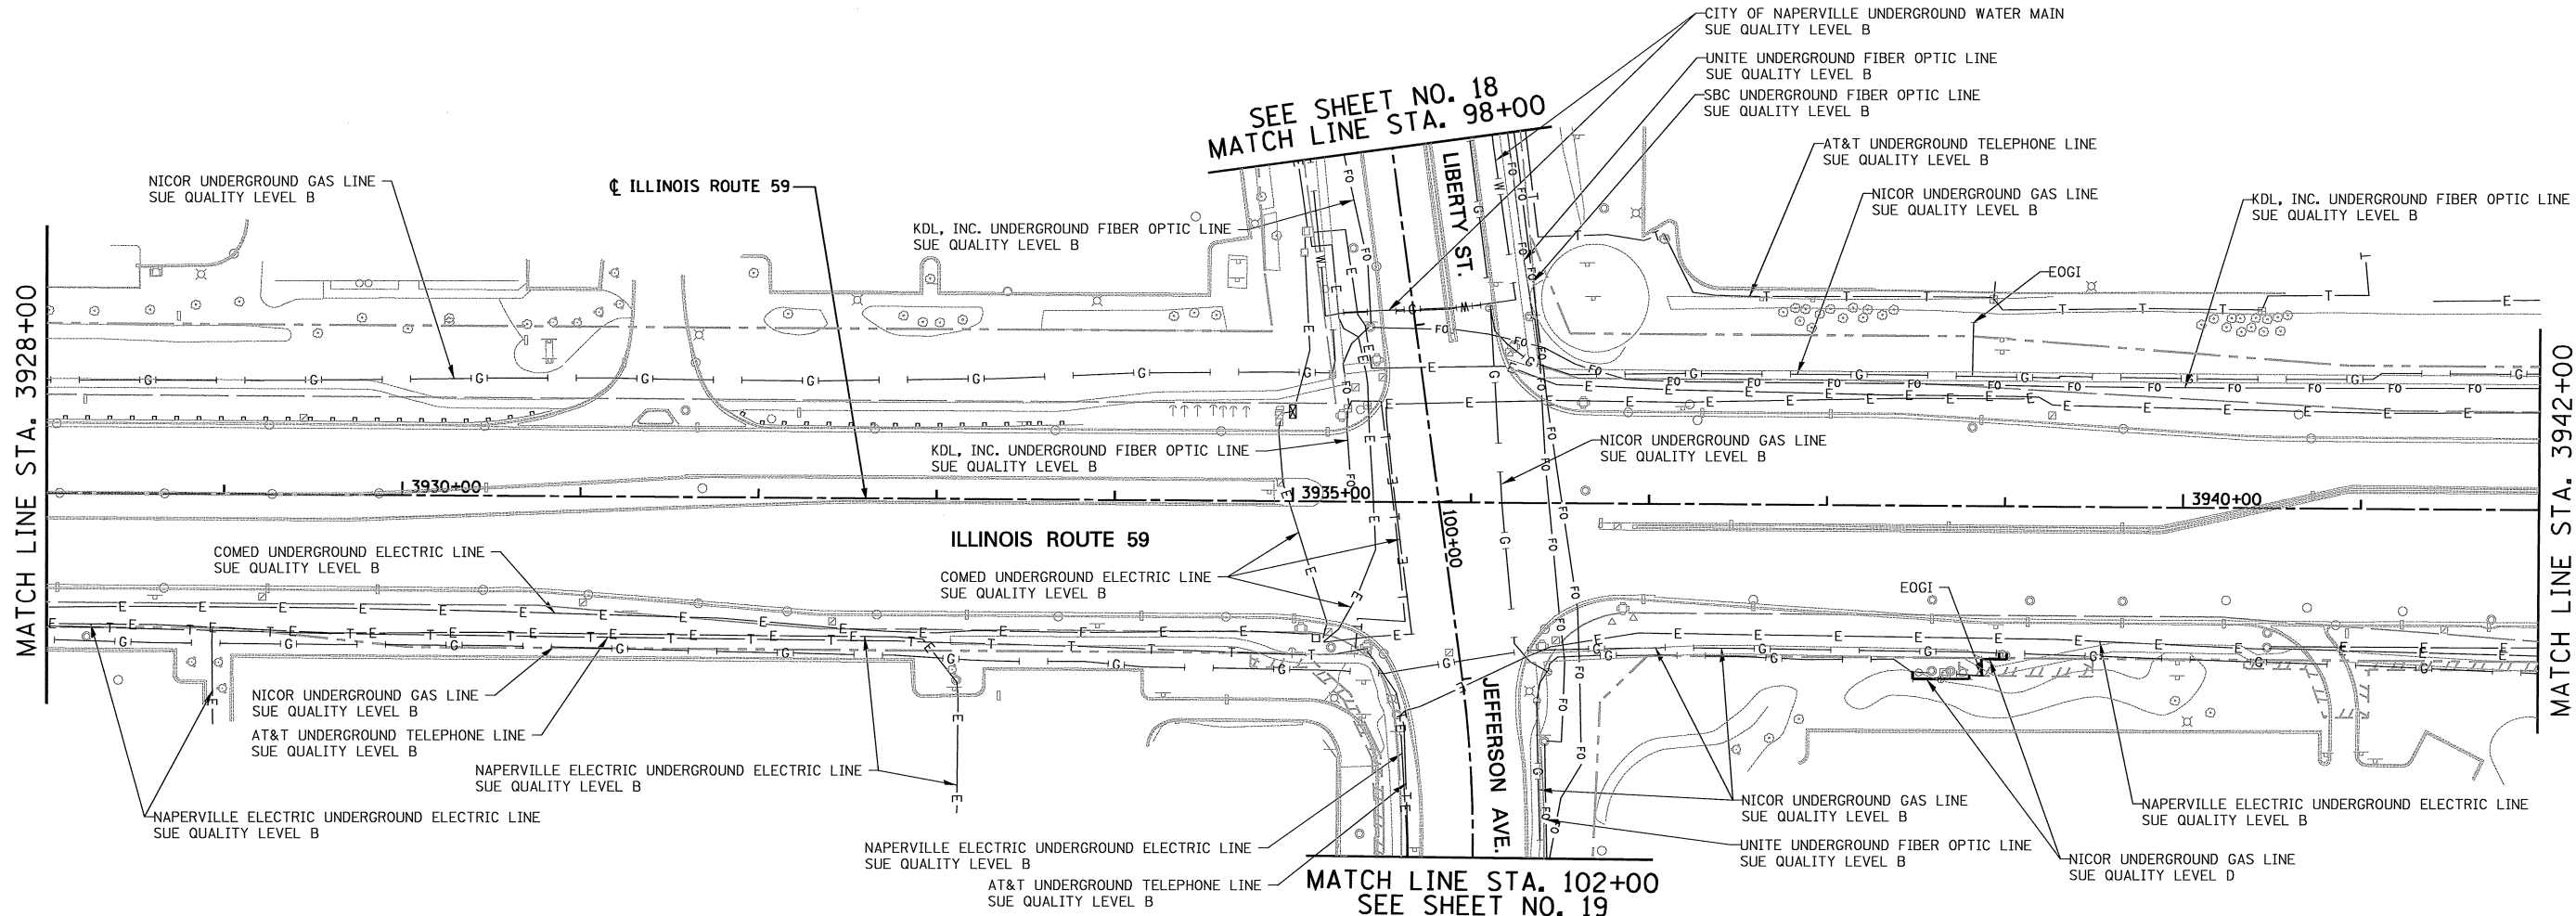

SEE SHEET NO. 18
MATCH LINE STA. 98+00

MATCH LINE STA. 102+00
SEE SHEET NO. 19

STATE OF ILLINOIS)
COUNTY OF COOK) S.S.

UTILITY(IES) SHOWN HEREON HAVE BEEN INVESTIGATED BY ASE IN ACCORDANCE WITH SUE INDUSTRY STANDARDS QUALITY LEVEL B (QLB). ALL OTHER INFORMATION SHOWN HAS BEEN PROVIDED BY OTHERS.


FIELD WORK WAS PERFORMED BETWEEN THE 28TH OF OCTOBER, A.D., 2010 AND THE 8TH DAY OF MAY, A.D., 2011.

IN WITNESS WHEREOF, I HAVE HEREUNTO SET MY HAND AND SEAL THIS 13TH DAY OF MAY A.D., 2011. CHICAGO, IL.

Steven M. Rienks
STEVEN M. RIENKS - ILLINOIS PROFESSIONAL ENGINEER NUMBER 62-044619
MY LICENSE EXPIRES 11/30/2011



- LEGEND**
- T — EXISTING UNDERGROUND TELEPHONE
 - W — EXISTING UNDERGROUND WATER
 - E — EXISTING UNDERGROUND ELECTRIC
 - G — EXISTING UNDERGROUND GAS
 - CTV — EXISTING UNDERGROUND CABLE TV
 - FO — EXISTING UNDERGROUND FIBER OPTIC
 - S — EXISTING UNDERGROUND SANITARY SEWER
 - EOGI END OF SURFACE GEOPHYSICAL INFORMATION

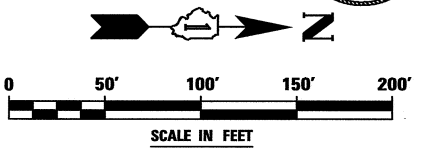

AMERICAN
SURVEYING & ENGINEERING, P.C.
SURVEYORS - ENGINEERS
GEODESISTS - MAPPING SCIENTISTS
Chicago 312-277-2000 / Fax 312-277-2002
Downers Grove 630-997-4105 / Fax 630-997-4121
Illinois Professional Design Firm No. 184-003192

USER NAME = #USER#	DESIGNED T.SANDERSON	REVISED -
	DRAWN B.TRAVER	REVISED -
PLOT SCALE = 50.00' / IN.	CHECKED S.RIENKS	REVISED -
PLOT DATE = 5/12/2011	DATE 5/13/2011	REVISED -

STATE OF ILLINOIS
DEPARTMENT OF TRANSPORTATION

SUE INVESTIGATION OF UNDERGROUND UTILITIES
NEW YORK STREET TO FERRY ROAD


SCALE: AS SHOWN SHEET NO. 4 OF 27 SHEETS STA. 3928+00 TO STA. 3942+00

CONTRACT 60P42 SHEET 198 OF 234

F.A.P. RTE.	SECTION	COUNTY	TOTAL SHEETS	SHEET NO.
338/IL 59	(112 & 113) WRS-5	DUPAGE	27	4

CONTRACT NO. 60131
ILLINOIS FED. AID PROJECT

6799-ahf-SUE-04.dgn

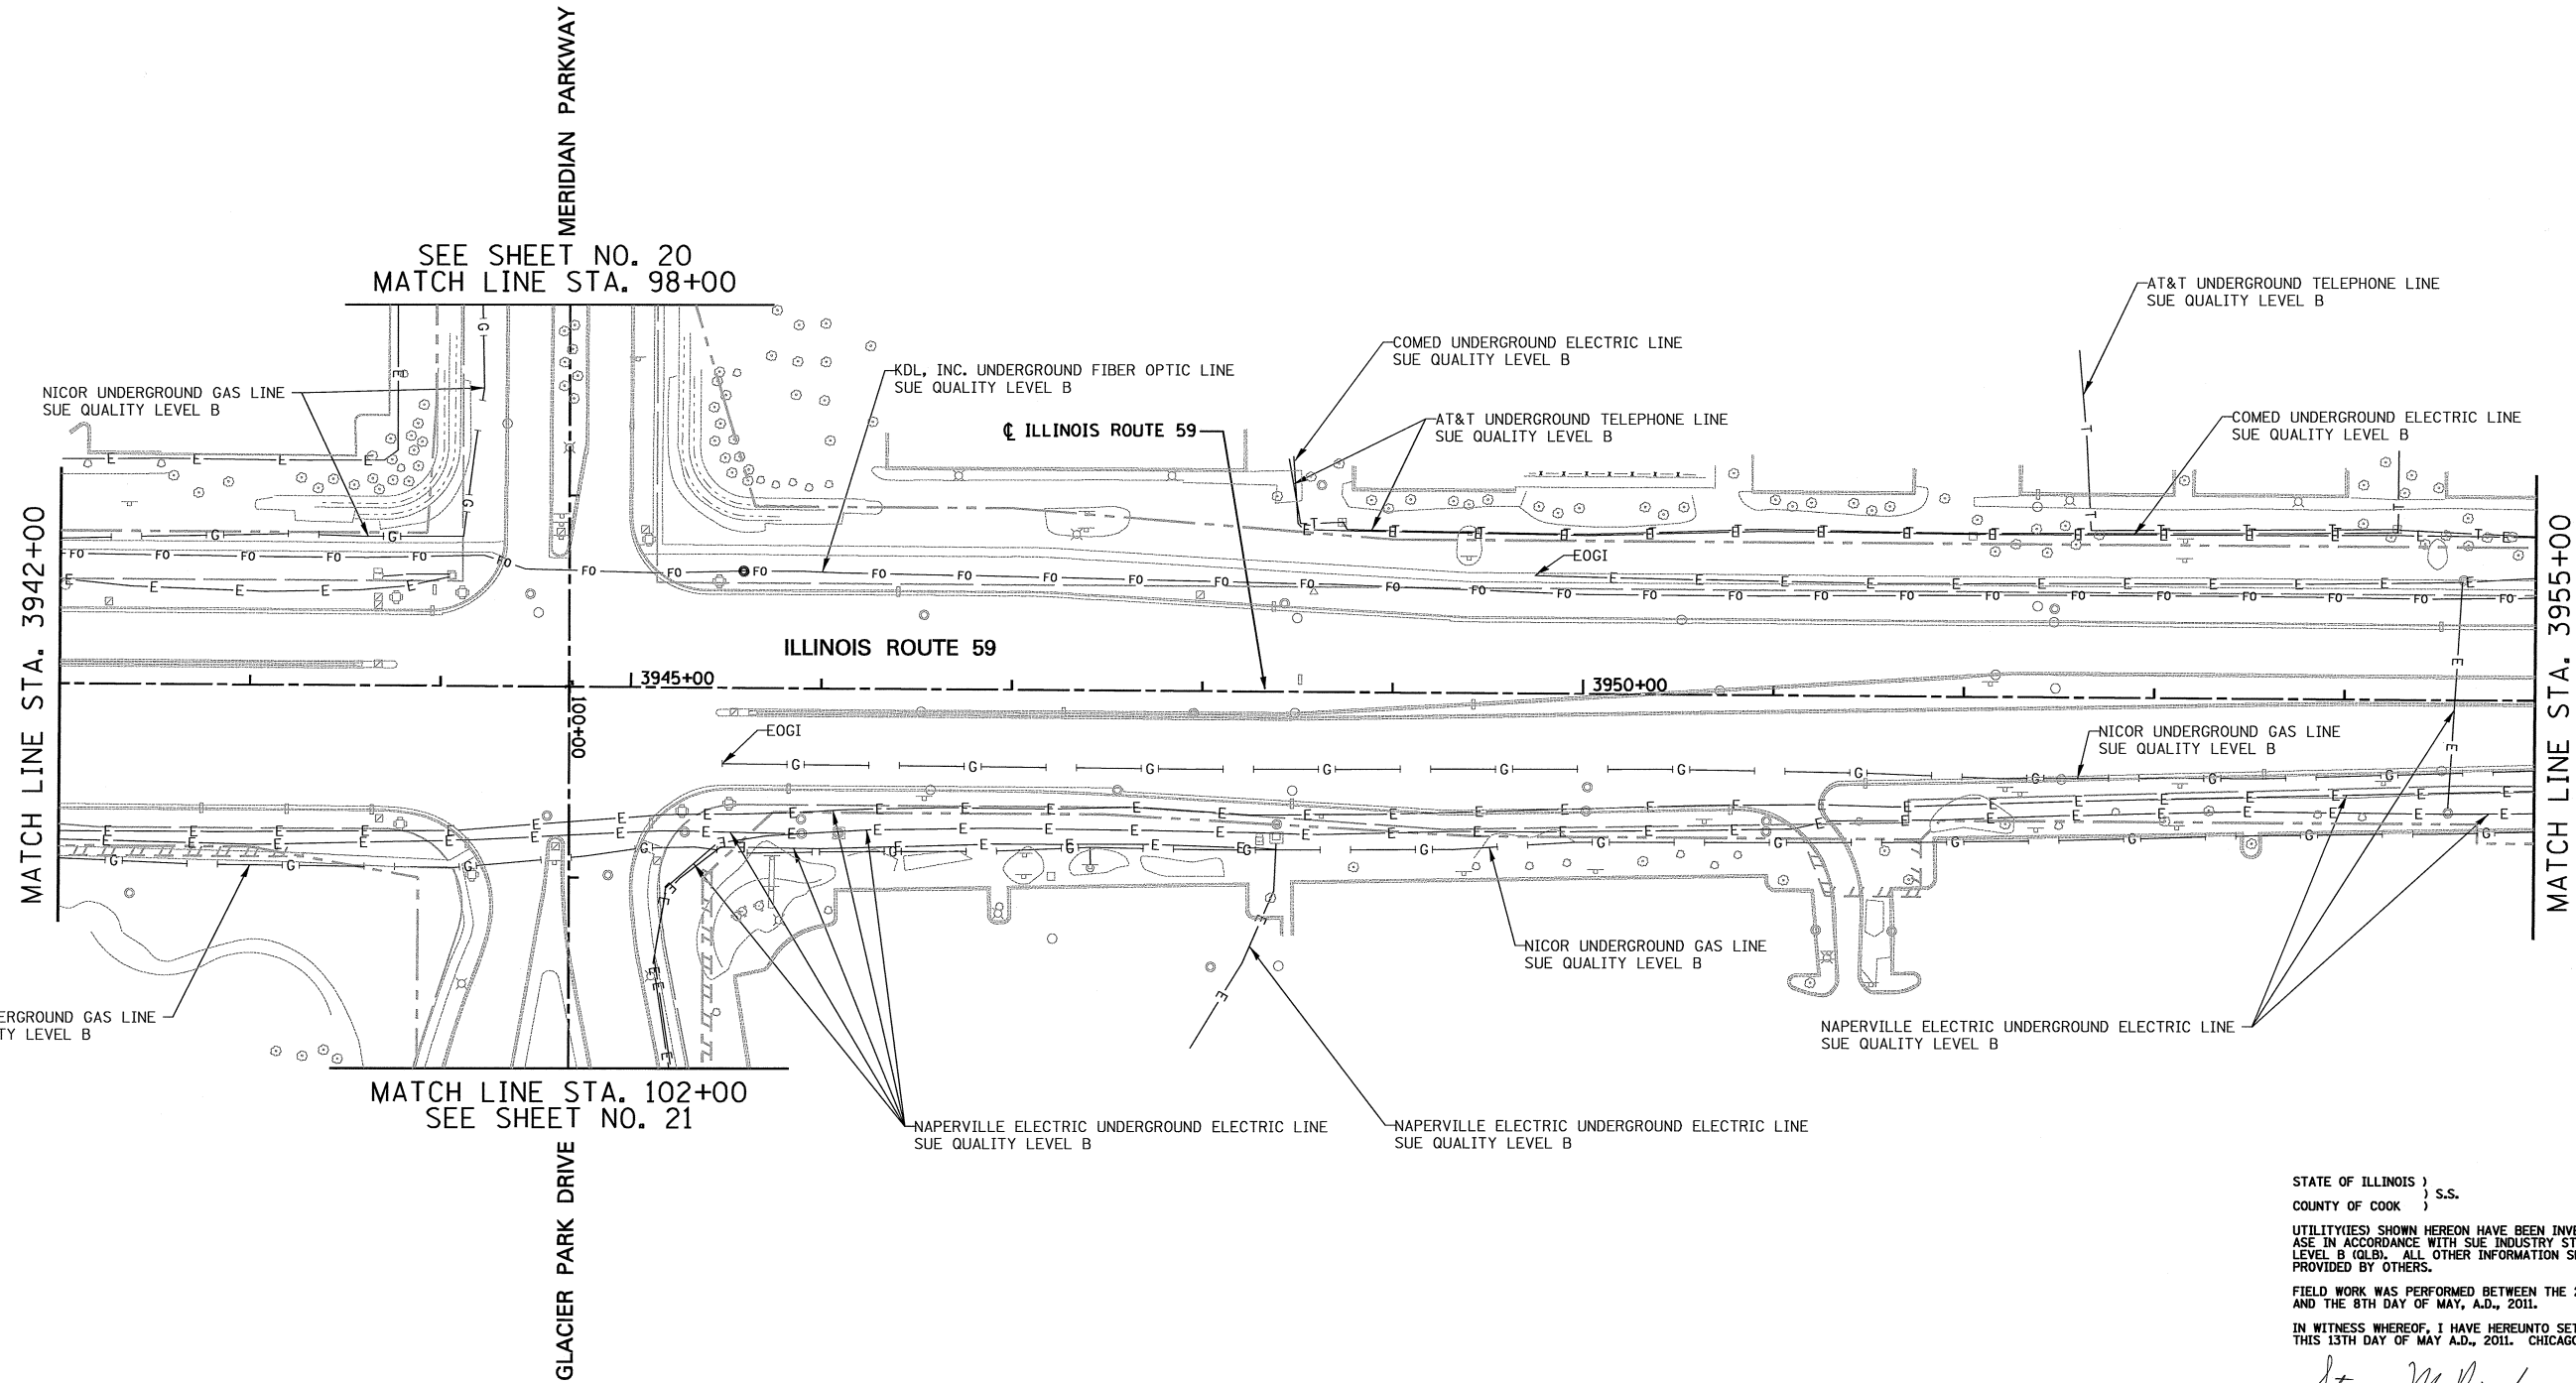

STATE OF ILLINOIS)
 COUNTY OF COOK) S.S.

UTILITY(IES) SHOWN HEREON HAVE BEEN INVESTIGATED BY ASE IN ACCORDANCE WITH SUE INDUSTRY STANDARDS QUALITY LEVEL B (QLB). ALL OTHER INFORMATION SHOWN HAS BEEN PROVIDED BY OTHERS.


FIELD WORK WAS PERFORMED BETWEEN THE 28TH OF OCTOBER, A.D., 2010 AND THE 8TH DAY OF MAY, A.D., 2011.

IN WITNESS WHEREOF, I HAVE HEREUNTO SET MY HAND AND SEAL THIS 13TH DAY OF MAY A.D., 2011. CHICAGO, IL.

Steven M. Rienks
 STEVEN M. RIENKS
 ILLINOIS PROFESSIONAL
 ENGINEER NUMBER 62-044619
 MY LICENSE EXPIRES 11/30/2011



- LEGEND**
- T — EXISTING UNDERGROUND TELEPHONE
 - W — EXISTING UNDERGROUND WATER
 - E — EXISTING UNDERGROUND ELECTRIC
 - G — EXISTING UNDERGROUND GAS
 - CTV — EXISTING UNDERGROUND CABLE TV
 - FO — EXISTING UNDERGROUND FIBER OPTIC
 - S — EXISTING UNDERGROUND SANITARY SEWER
 - EOGI END OF SURFACE GEOPHYSICAL INFORMATION

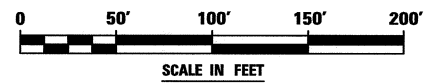

AMERICAN
 SURVEYING & ENGINEERING, P.C.
 SURVEYORS - ENGINEERS
 GEODESISTS - MAPPING SCIENTISTS
 Chicago 312-277-2000 / Fax 312-277-2002
 Dixon 815-288-6231 / Fax 815-288-6277
 Aurora 603-897-4105 / Fax 630-897-4121
 Illinois Professional Design Firm No. 194-003192

USER NAME = #USER#	DESIGNED T.SANDERSON	REVISED -
	DRAWN B.TRAVER	REVISED -
PLOT SCALE = 50.00' / IN.	CHECKED S.RIENKS	REVISED -
PLOT DATE = 5/12/2011	DATE 5/13/2011	REVISED -

**STATE OF ILLINOIS
 DEPARTMENT OF TRANSPORTATION**


**SUE INVESTIGATION OF UNDERGROUND UTILITIES
 NEW YORK STREET TO FERRY ROAD**

SCALE: AS SHOWN SHEET NO. 5 OF 27 SHEETS STA. 3942+00 TO STA. 3955+00

CONTRACT 60P42 SHEET 199 OF 234

F.A.P. RTE.	SECTION	COUNTY	TOTAL SHEETS	SHEET NO.
338/IL 59	(112 & 113) WRS-5	DUPAGE	27	5
CONTRACT NO. 60131			ILLINOIS FED. AID PROJECT	

6799-sh-t-SUE-05.dgn

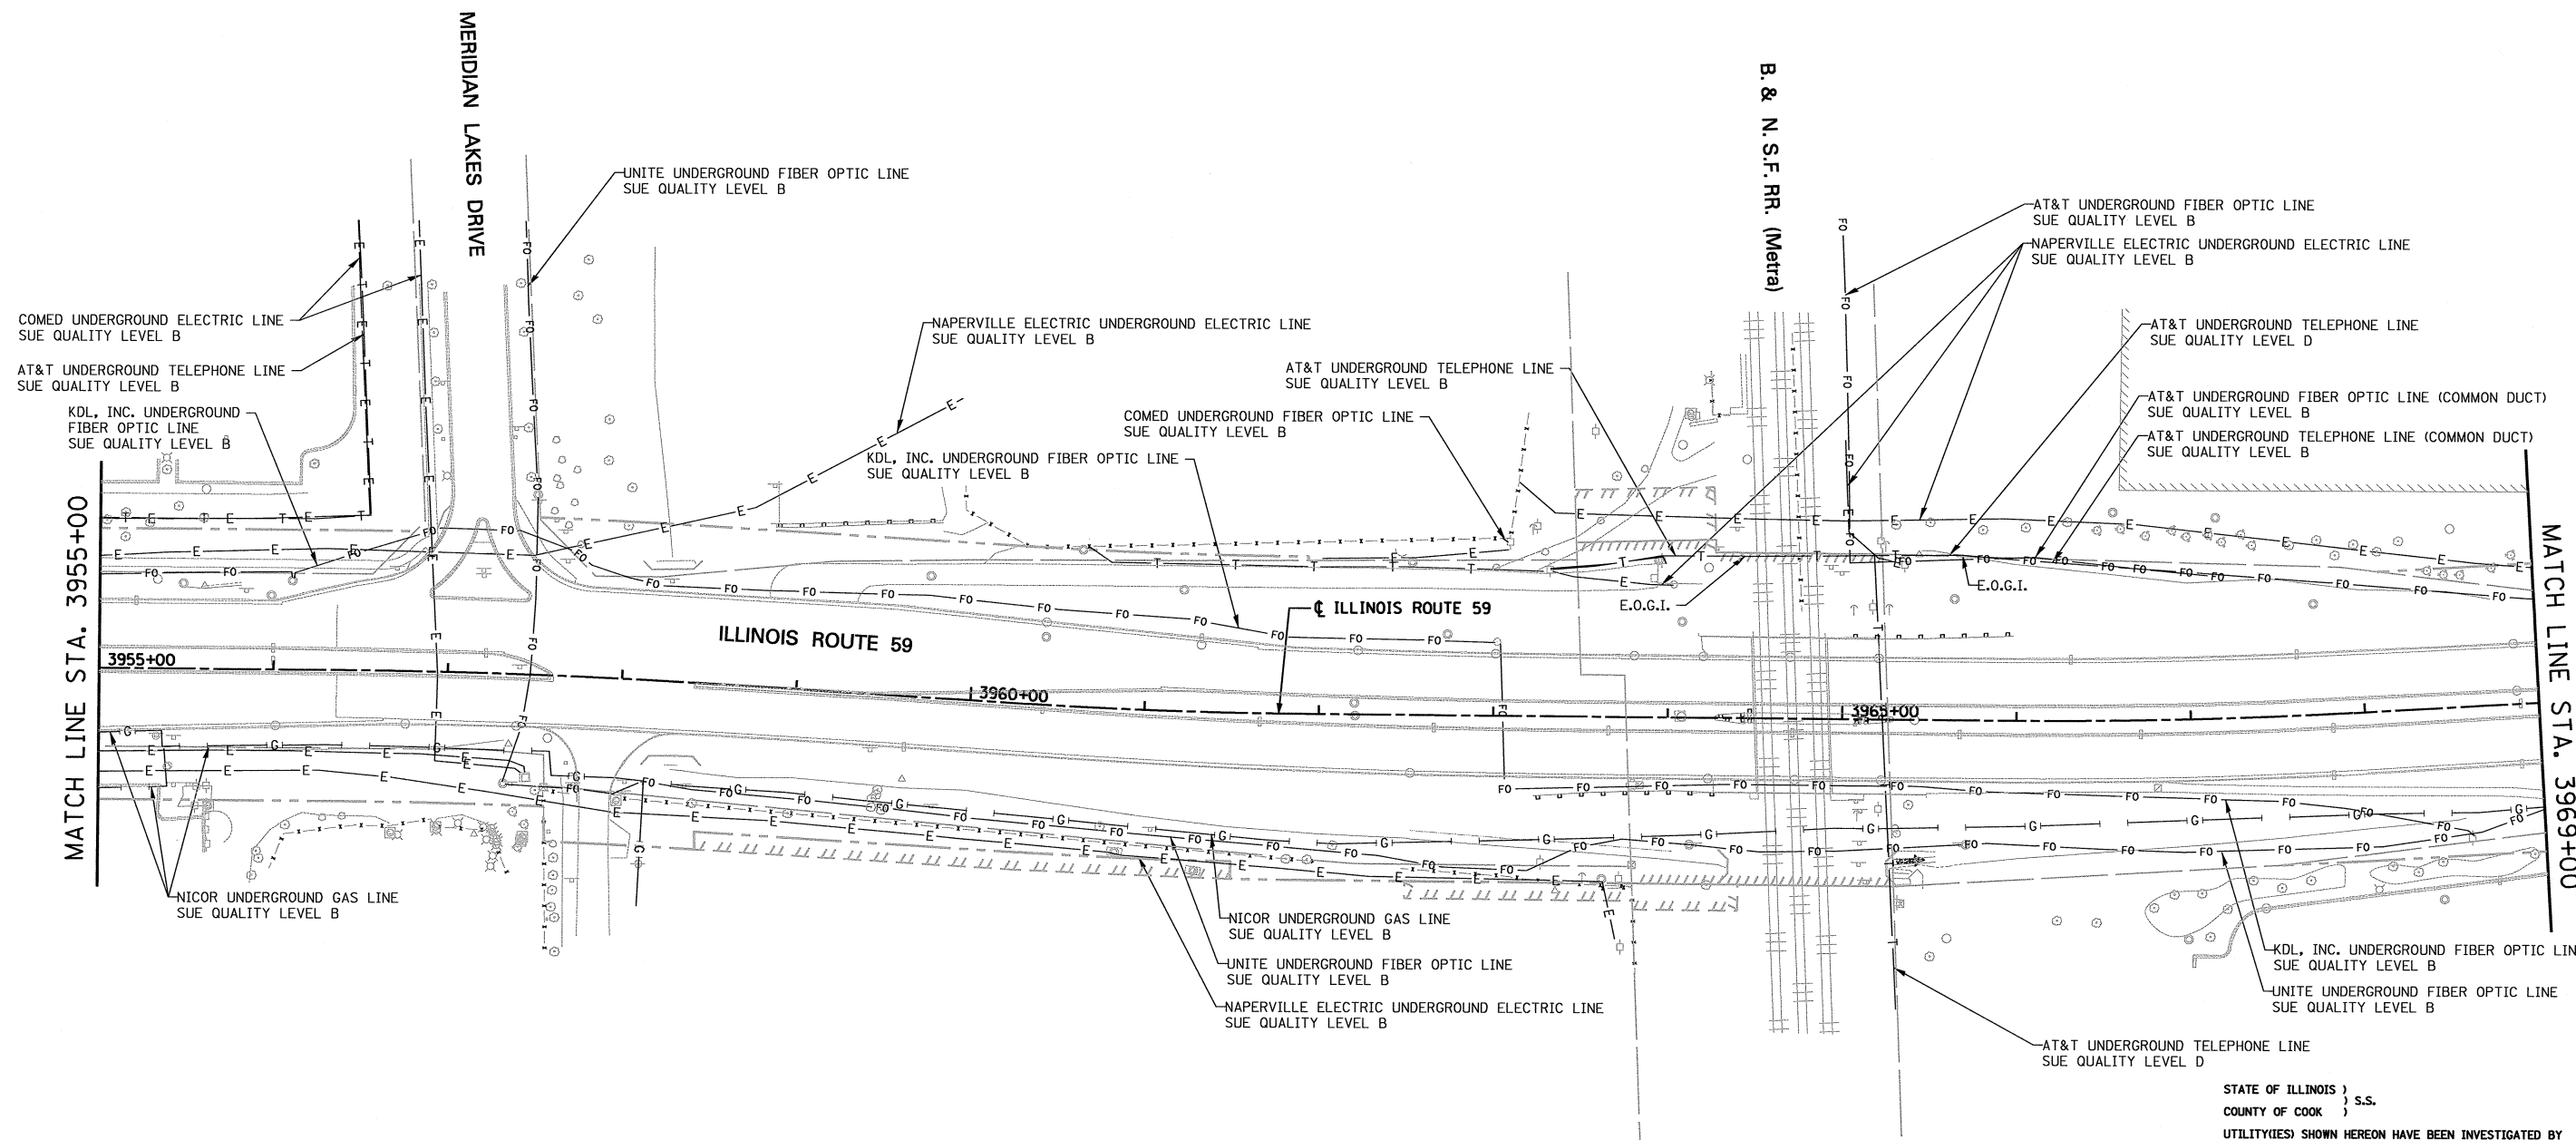

STATE OF ILLINOIS)
) S.S.
 COUNTY OF COOK)


UTILITY(IES) SHOWN HEREON HAVE BEEN INVESTIGATED BY ASE IN ACCORDANCE WITH SUE INDUSTRY STANDARDS QUALITY LEVEL B (QLB). ALL OTHER INFORMATION SHOWN HAS BEEN PROVIDED BY OTHERS.

FIELD WORK WAS PERFORMED BETWEEN THE 28TH DAY OF OCTOBER, A.D., 2010 AND THE 8TH DAY OF MAY, A.D., 2011 AND BETWEEN THE 16TH DAY OF JANUARY, A.D., 2012 AND THE 19TH DAY OF JANUARY, A.D., 2012.

IN WITNESS WHEREOF, I HAVE HERETO SET MY HAND AND SEAL THIS 24TH DAY OF JANUARY A.D., 2012. CHICAGO, IL.

Steven M. Rienks
 STEVEN M. RIENKS - ILLINOIS PROFESSIONAL
 ENGINEER NUMBER 62-044619
 MY LICENSE EXPIRES 11/30/2013

- LEGEND**
- T — EXISTING UNDERGROUND TELEPHONE
 - W — EXISTING UNDERGROUND WATER
 - E — EXISTING UNDERGROUND ELECTRIC
 - G — EXISTING UNDERGROUND GAS
 - CTV — EXISTING UNDERGROUND CABLE TV
 - FO — EXISTING UNDERGROUND FIBER OPTIC
 - S — EXISTING UNDERGROUND SANITARY SEWER
 - EOGI — END OF SURFACE GEOPHYSICAL INFORMATION

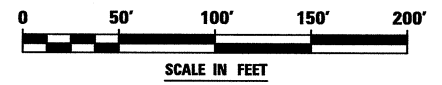

AMERICAN
 SURVEYING & ENGINEERING, P.C.
 SURVEYORS • ENGINEERS
 GEODESISTS • MAPPING SCIENTISTS
 Chicago 312-277-2000 / Fax 312-277-2002
 Olsone 815-288-6231 / Fax 815-288-6277
 Aurora 630-897-4105 / Fax 630-897-4121
 Illinois Professional Design Firm No. 184-003192

6799-ah-t-SUE-06.dgn

USER NAME = #USER#	DESIGNED T.SANDERSON	REVISED - 1/24/2012
PLOT SCALE = 50.00' / IN.	DRAWN B.TRAVER	REVISED -
PLOT DATE = 1/24/2012	CHECKED S.RIENKS	REVISED -
	DATE 5/13/2011	REVISED -

**STATE OF ILLINOIS
 DEPARTMENT OF TRANSPORTATION**

**SUE INVESTIGATION OF UNDERGROUND UTILITIES
 NEW YORK STREET TO FERRY ROAD**

SCALE: AS SHOWN SHEET NO. 6 OF 27 SHEETS STA. 3955+00 TO STA. 3969+00

F.A.P. RTE.	SECTION	COUNTY	TOTAL SHEETS	SHEET NO.
338/IL 59	(112 & 113) WRS-5	DUPAGE	27	6
CONTRACT NO. 60131				
ILLINOIS FED. AID PROJECT				

CONTRACT 60P42 SHEET 200 OF 234