NOTE:

IDOT RECORD PLANS PROVIDED FOR INFORMATIONAL PURPOSES ONLY. THE CONTRACTOR IS RESPONSIBLE FOR VERIFYING THE LOCATION AND EXTENT OF WORK ASSOCIATED WITH REPLACEMENT OF INDUCTION LOOPS, LEAD-IN CABLE AND RELATED WORK.

SUMMARY OF QUANTITIES (THIS SHEET)		
DESCRIPTION	UNIT	QUANTITY
ELECTRIC CABLE IN CONDUIT, LEAD-IN, NO. 18 4/C, TWISTED, SHIELDED	LF	2383
INDUCTION LOOP	LF	330

SYMBOL	LEGEND
▢	INDUCTION LOOP
Q	ROUND INDUCTION LOOP
⊠	TSC CABINET
-o-	TELEPHONE SERVICE
-□-	SERVICE INSTALLATION
▨	JUNCTION BOX
▩	HEAVY DUTY HAND HOLE
------	POLYETHYLENE DUCT
————	GALVANIZED STEEL CONDUIT
(E)	EXISTING
(P)	PROPOSED
(I)	INSTALL
➤	FLASHER

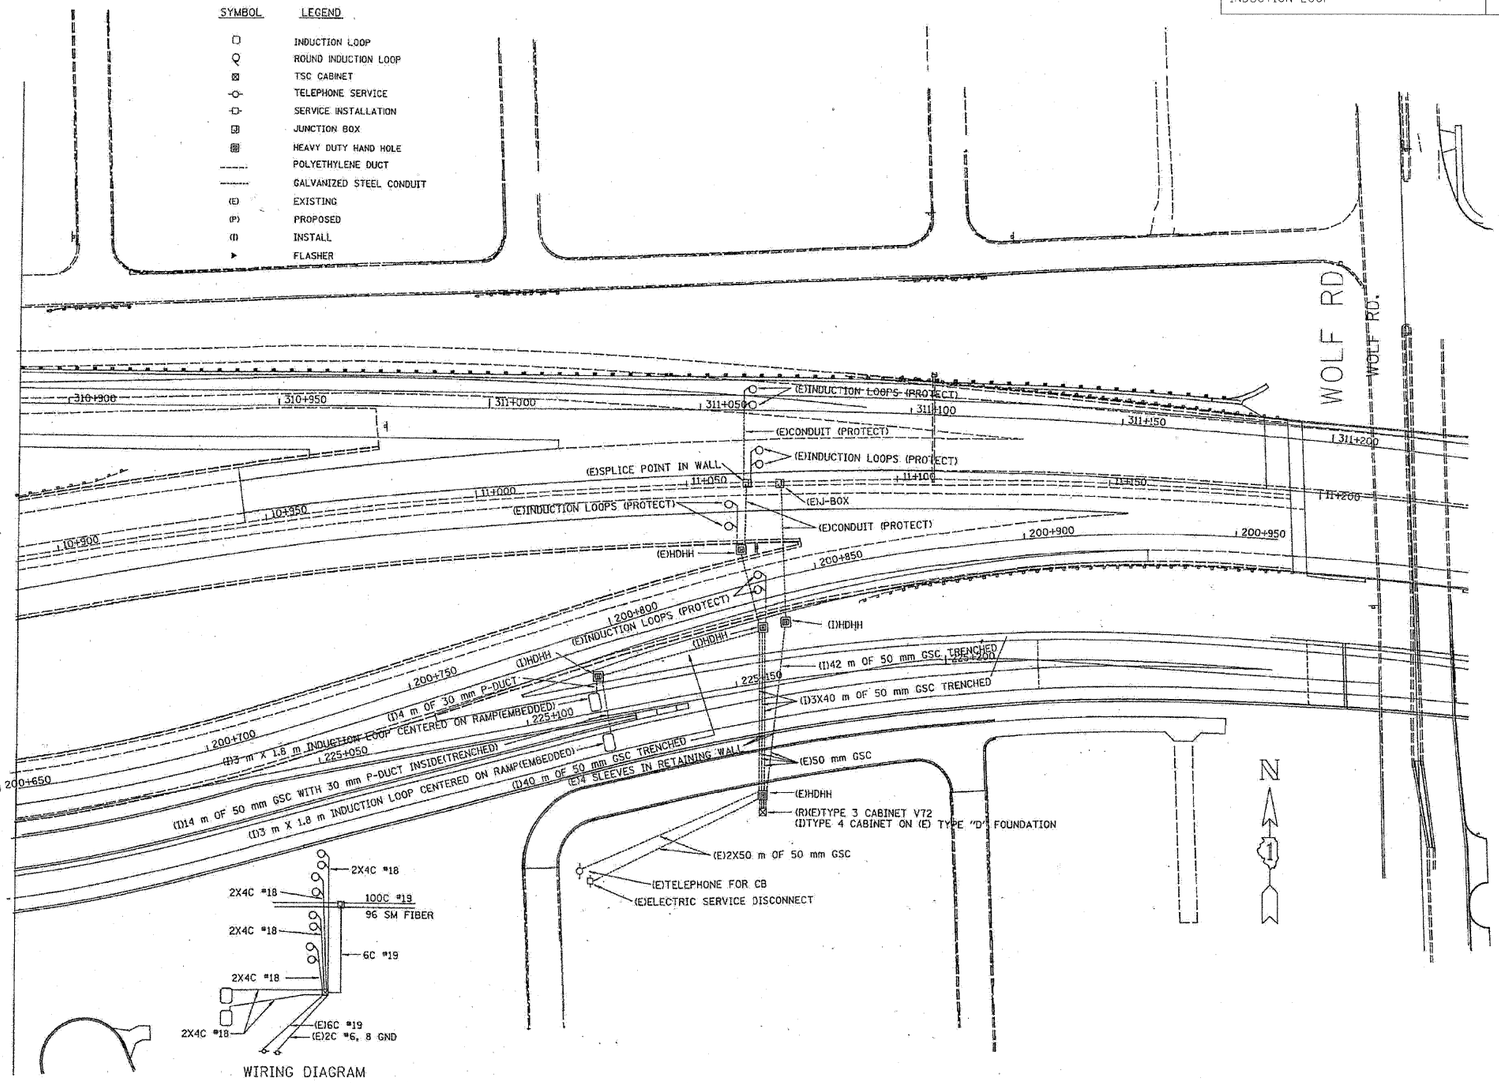

WIRING DIAGRAM

FILE NAME = ...\Signals\prpln_ABC_C2_ts_17.dgn	DESIGNED - GHT	REVISED -	benesch	STATE OF ILLINOIS DEPARTMENT OF TRANSPORTATION	TRAFFIC SURVEILLANCE WOLF RD INSTALLATION
USER NAME = tblank	DRAWN - TMB	REVISED -			
PLOT DATE = 1/25/2010	CHECKED - MPM	REVISED -			
	DATE - 1/25/10	REVISED -			SCALE: N.T.S. SHEET NO. 8 OF 8 SHEETS STA. TO STA.

F.A.I. RTE.	SECTION	COUNTY	TOTAL SHEETS	SHEET NO.
290	(3435, ETC., 3838)RS-5	COOK	264	232
		CONTRACT NO. 60G52		
FED. ROAD DIST. NO.	ILLINOIS	FED. AID PROJECT		