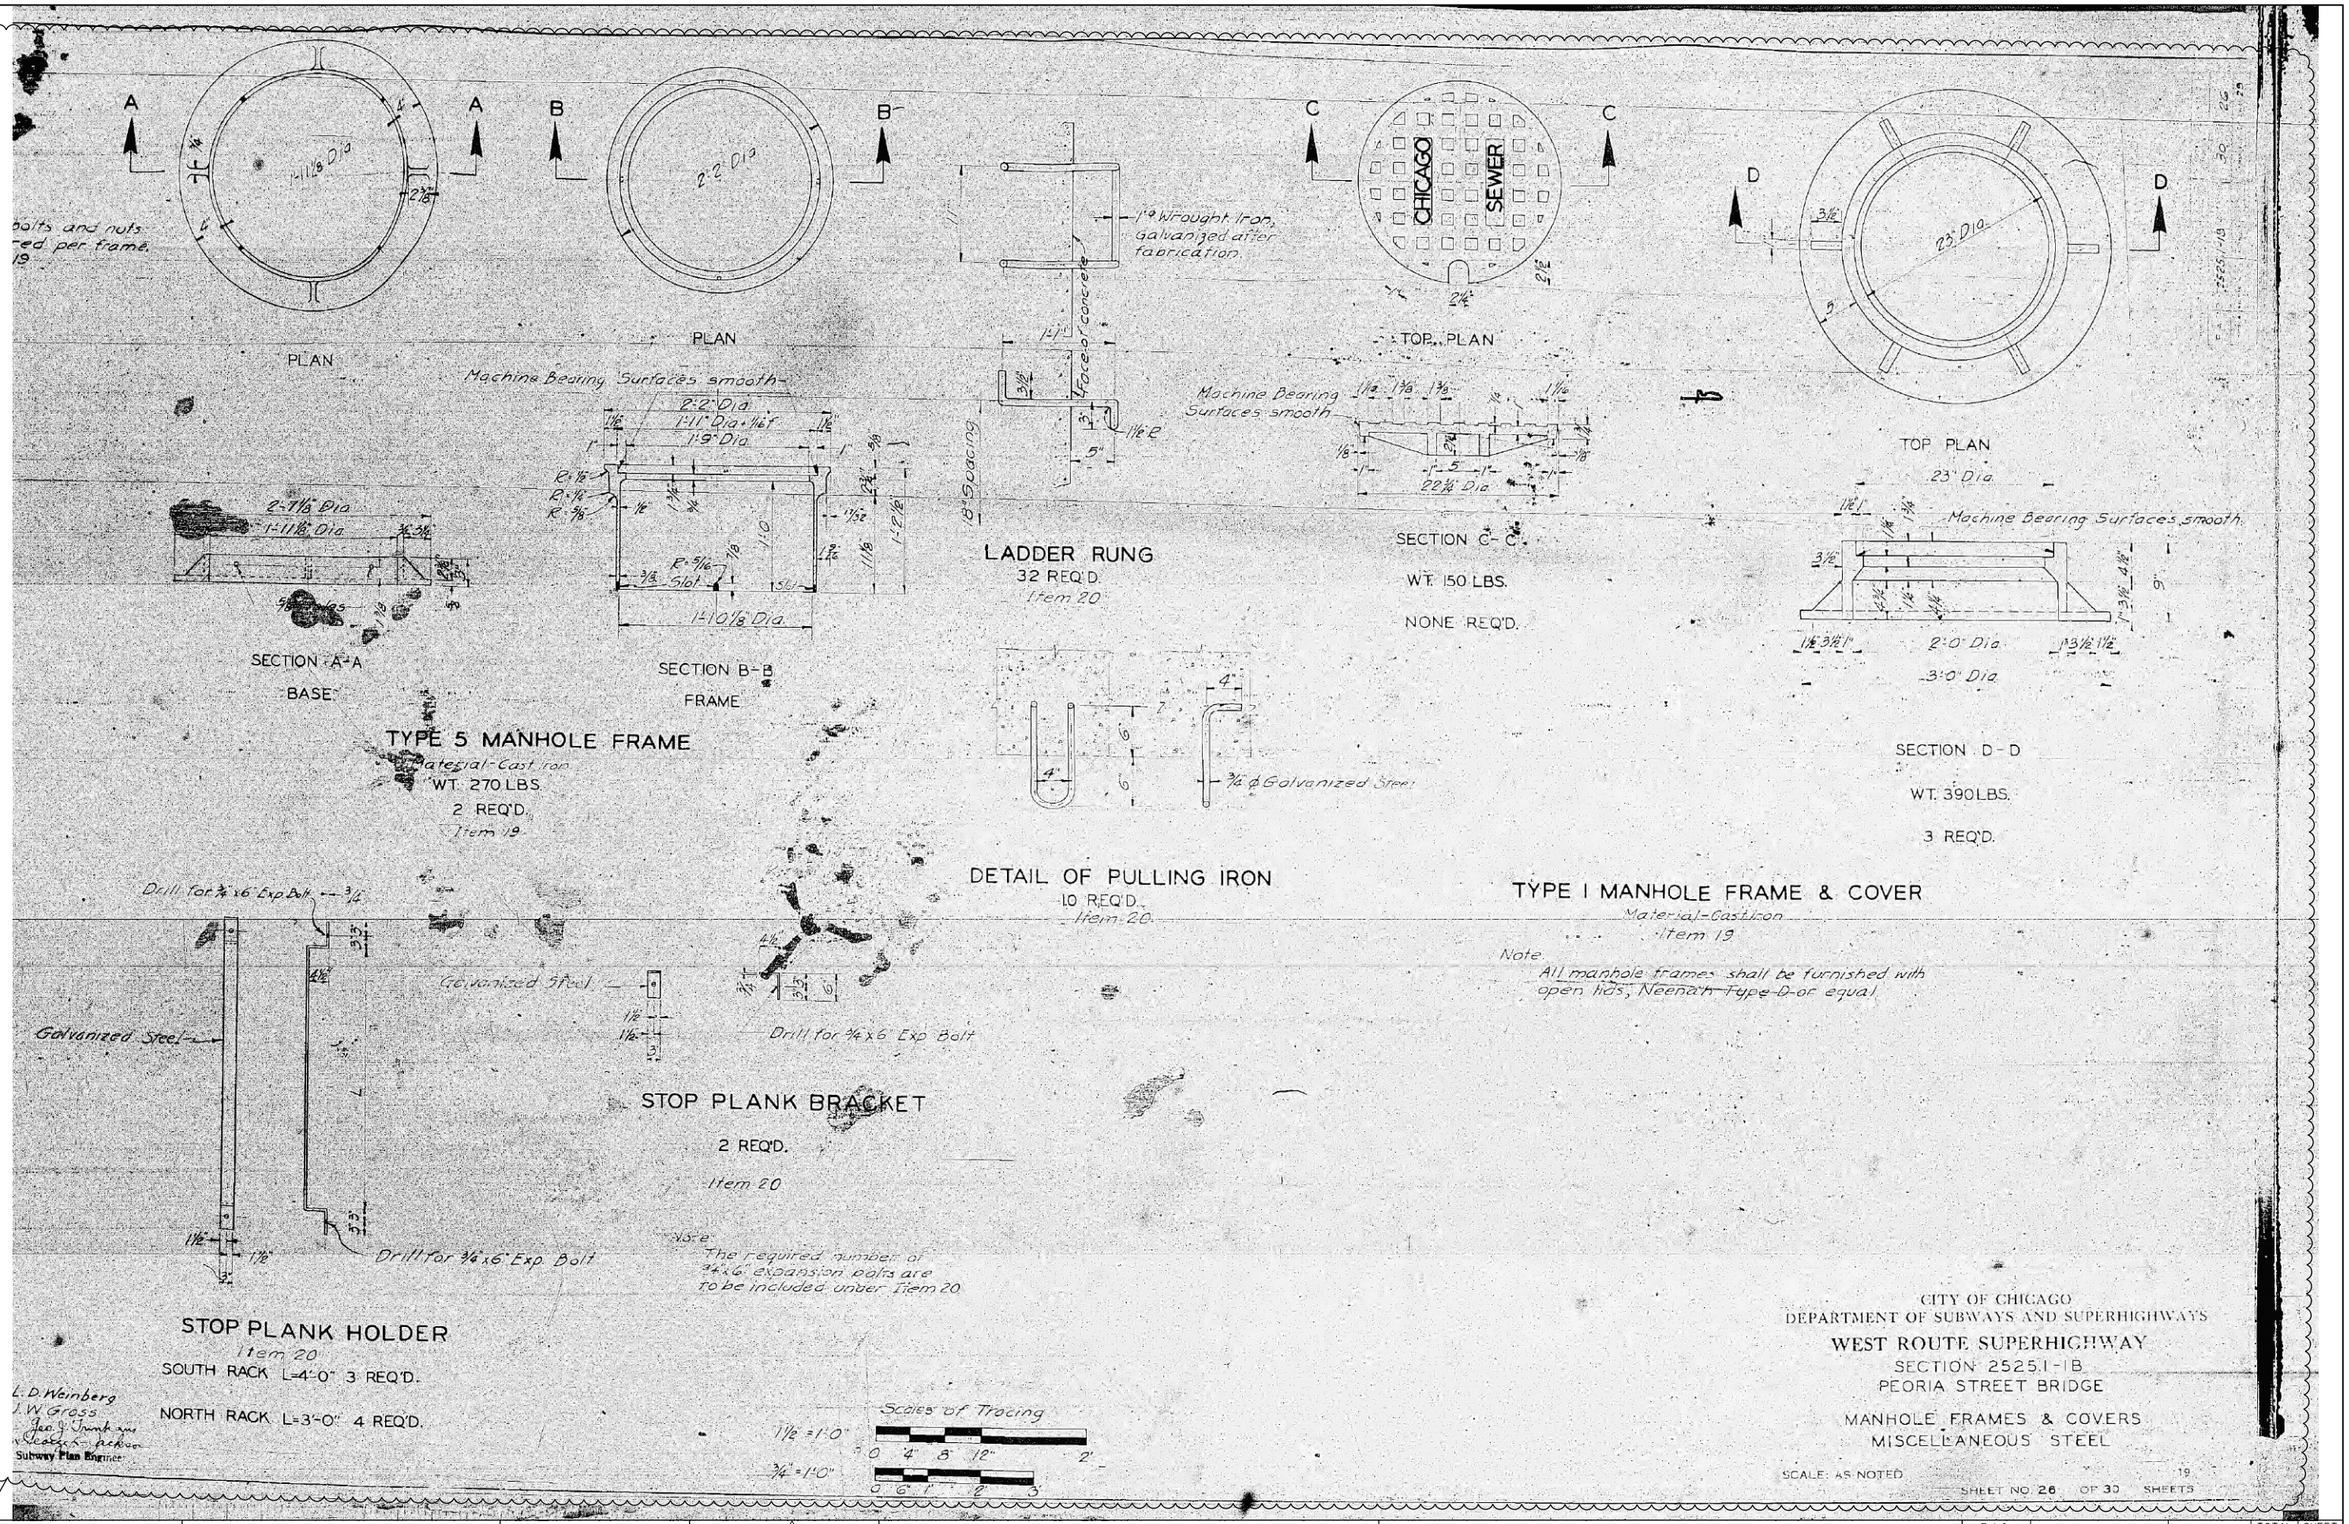


FILE PATH = pw:\\388039-pwintl.aecomonline.local:PWAECOM00\Documents\01 Americas\Transportation\60269938 Circle\Phase II\000_CAD\006_Roadway\Sheets\60W29_Contract\D160W29-sht-Ex-Siphon-10.dgn

| | | | | | |
|---|---|---|---|---|---|
| Tran Systems | D160W29-sht-Ex-Siphon-10.dgn | DESIGNED - | REVISED - A 12/18/2013 | STATE OF ILLINOIS DEPARTMENT OF TRANSPORTATION | AS BUILT SIPHON PLANS PEORIA STREET |
| | USER NAME = BAWistort | DRAWN - BAW | REVISED - | | SCALE: NONE · SHEET 10 OF 14 SHEETS · STA. · TO STA. |
| | PLOT SCALE = 100.0000 ' / in. | CHECKED - JWC | REVISED - | | |
| | PLOT DATE = 12/19/2013 | DATE - 10/30/2013 | REVISED - | | |

| F.A.I. RTE. | SECTION | COUNTY | TOTAL SHEETS | SHEET NO. |
|---|---|---|---|---|
| 90/94/290 | 2013-011R | COOK | 356 | 76K |
| | | CONTRACT NO. 60W29 | | |
| | | ILLINOIS FED. AID PROJECT | | |