NOTE:

THIS PLAN IS FOR THE PURPOSE OF REPLACING THE DETECTOR LOOPS ONLY. ALL OTHER INFORMATION SHOWN IS NOT RELATED AND WILL BE DISREGARDED.

TRAFFIC SIGNAL LEGEND

	PROPOSED	EXISTING
CONTROLLER		
SERVICE INSTALLATION		
SIGNAL HEAD		
SIGNAL HEAD WITH BACKPLATE		
SIGNAL HEAD, PEDESTRIAN		
SIGNAL POST		
MAST ARM ASSEMBLY AND POLE, STEEL		
MAST ARM ASSEMBLY AND POLE, ALUMINUM		
COMMON TRENCH	CT	
UNIT DUCT	UD	
HANDHOLE		
HEAVY DUTY HANDHOLE		"E"
DOUBLE HANDHOLE		
G.S. CONDUIT IN GROUND		
PEDESTRIAN PUSHBUTTON DETECTOR		
DETECTOR LOOP		
CAST IRON JUNCTION BOX		"E"
EMERGENCY VEHICLE SYSTEM DETECTOR		
CONFIRMATION BEACON		
SIGNAL HEAD OPTICALLY PROGRAMMED	"P"	"P"
CONDUIT SPLICE		
WOOD POLE		"E"
RACEWAY FOR MAGNETIC DETECTOR, TYPE I OR TYPE II		"E"
VEHICLE DETECTOR, NON COMPENSATED MAGNETIC TYPE		
RAILROAD CONTROL CABINET		"E"

TRAFFIC SIGNAL LEGEND CONTINUED

ILLUMINATED SIGN, FIBER OPTIC "NO LEFT TURN"		"E"
ILLUMINATED SIGN, FIBER OPTIC "NO RIGHT TURN"		"E"
TELEPHONE CONNECTION	T	T

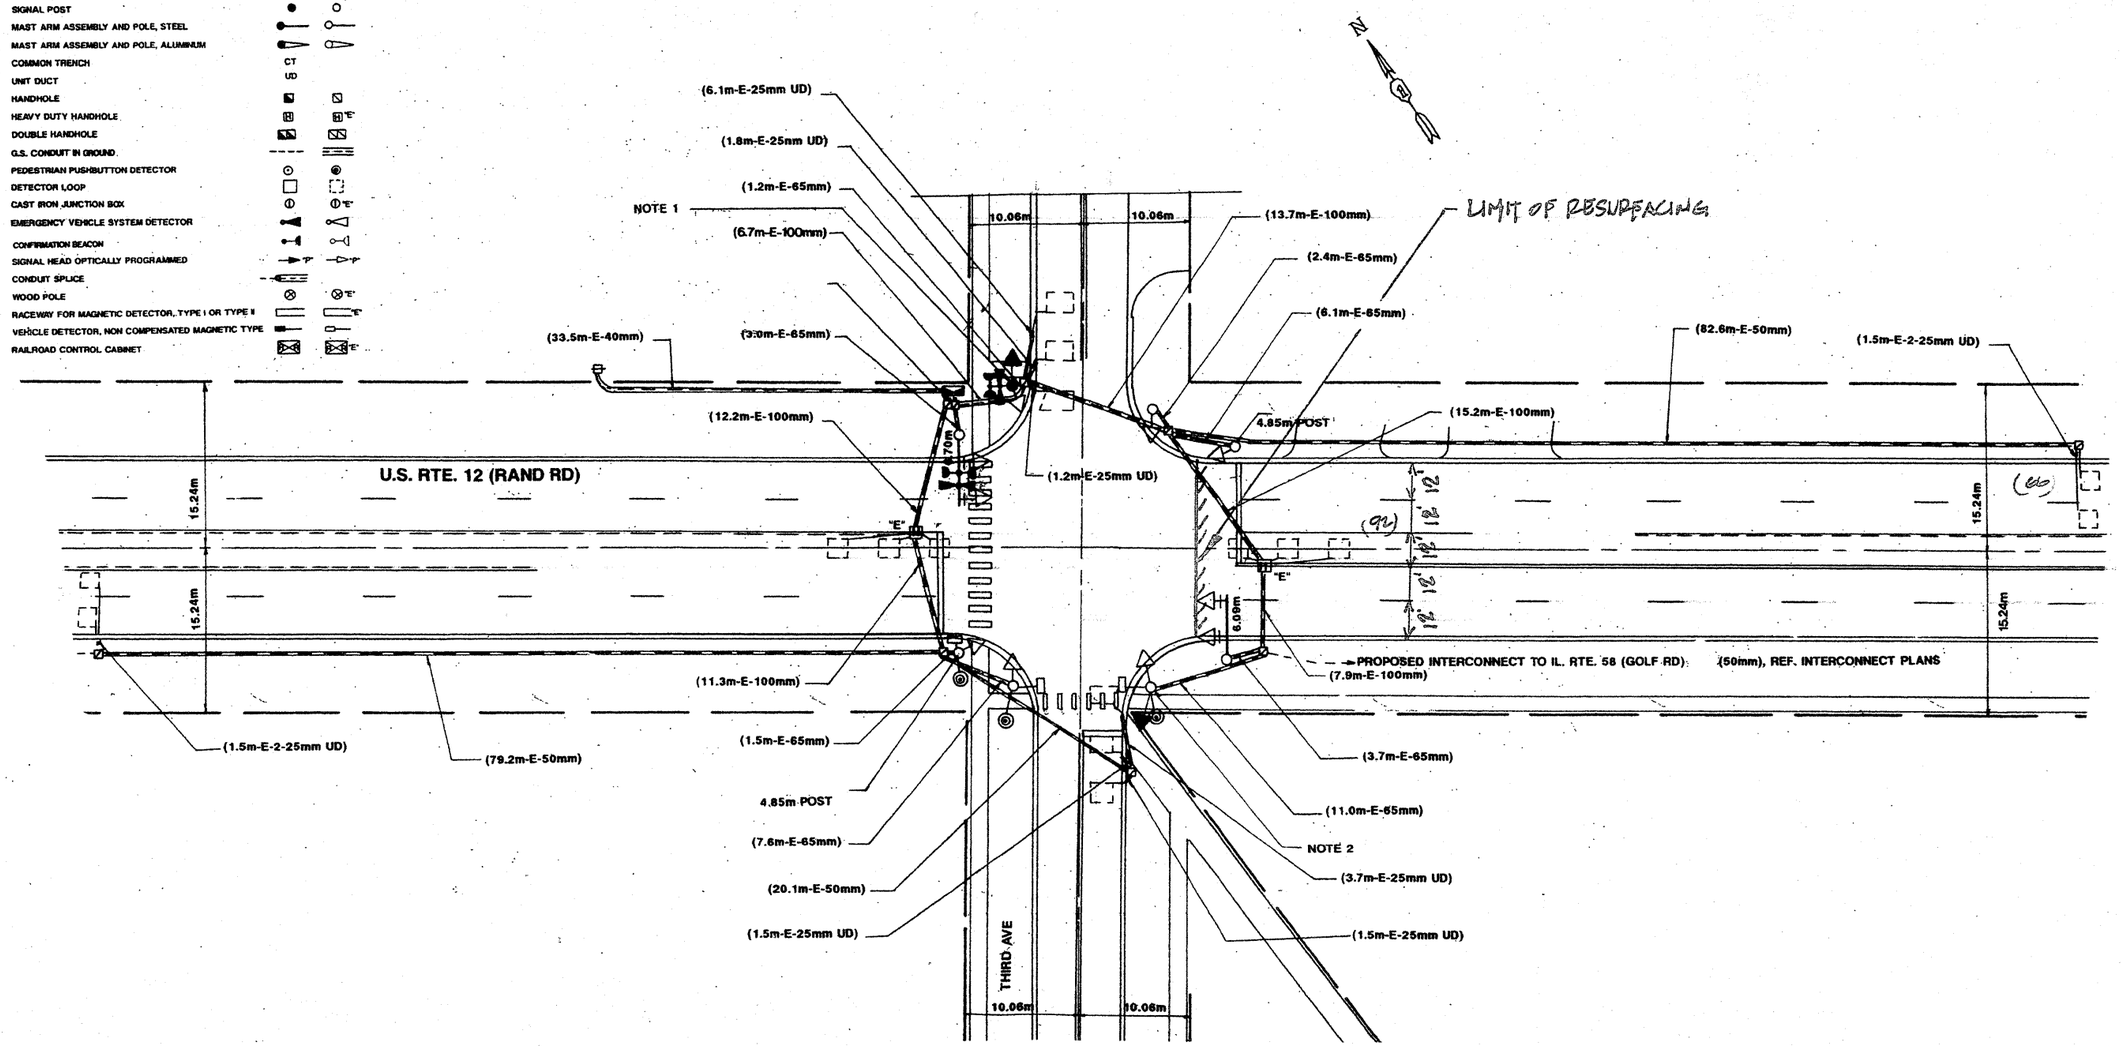

REPLACE ALL DETECTOR LOOPS AS SHOWN

(WITHIN THE RESURFACING LIMITS)

CODE NO.	QUANTITY	UNIT	ITEM
~~80600600~~	158	Foot	Detector Loop Replacement

FILE NAME = c:\projects\traffic\t070022\il68forestpy.dgn	USER NAME = kenthophixaybc	DESIGNED -	REVISED -
		DRAWN - J.E.	REVISED -
	PLOT SCALE = 40.0000 ' / IN.	CHECKED -	REVISED -
	PLOT DATE = 10/5/2007	DATE -	REVISED -

STATE OF ILLINOIS
DEPARTMENT OF TRANSPORTATION

U.S. ROUTE 12 (RAND RD.) @ THIRD AVENUE

SCALE:	SHEET NO. OF SHEETS	STA.	TO STA.

F.A.U./~~Route~~ RTE.	SECTION	COUNTY	TOTAL SHEETS	SHEET NO.
3523	2008-021 RS	COOK	30	15

FED. ROAD DIST. NO.	ILLINOIS	FED. AID PROJECT	CONTRACT NO. 60E81

py.dgn 10/5/2007 12:29:13 PM User=kenthaphixaybc