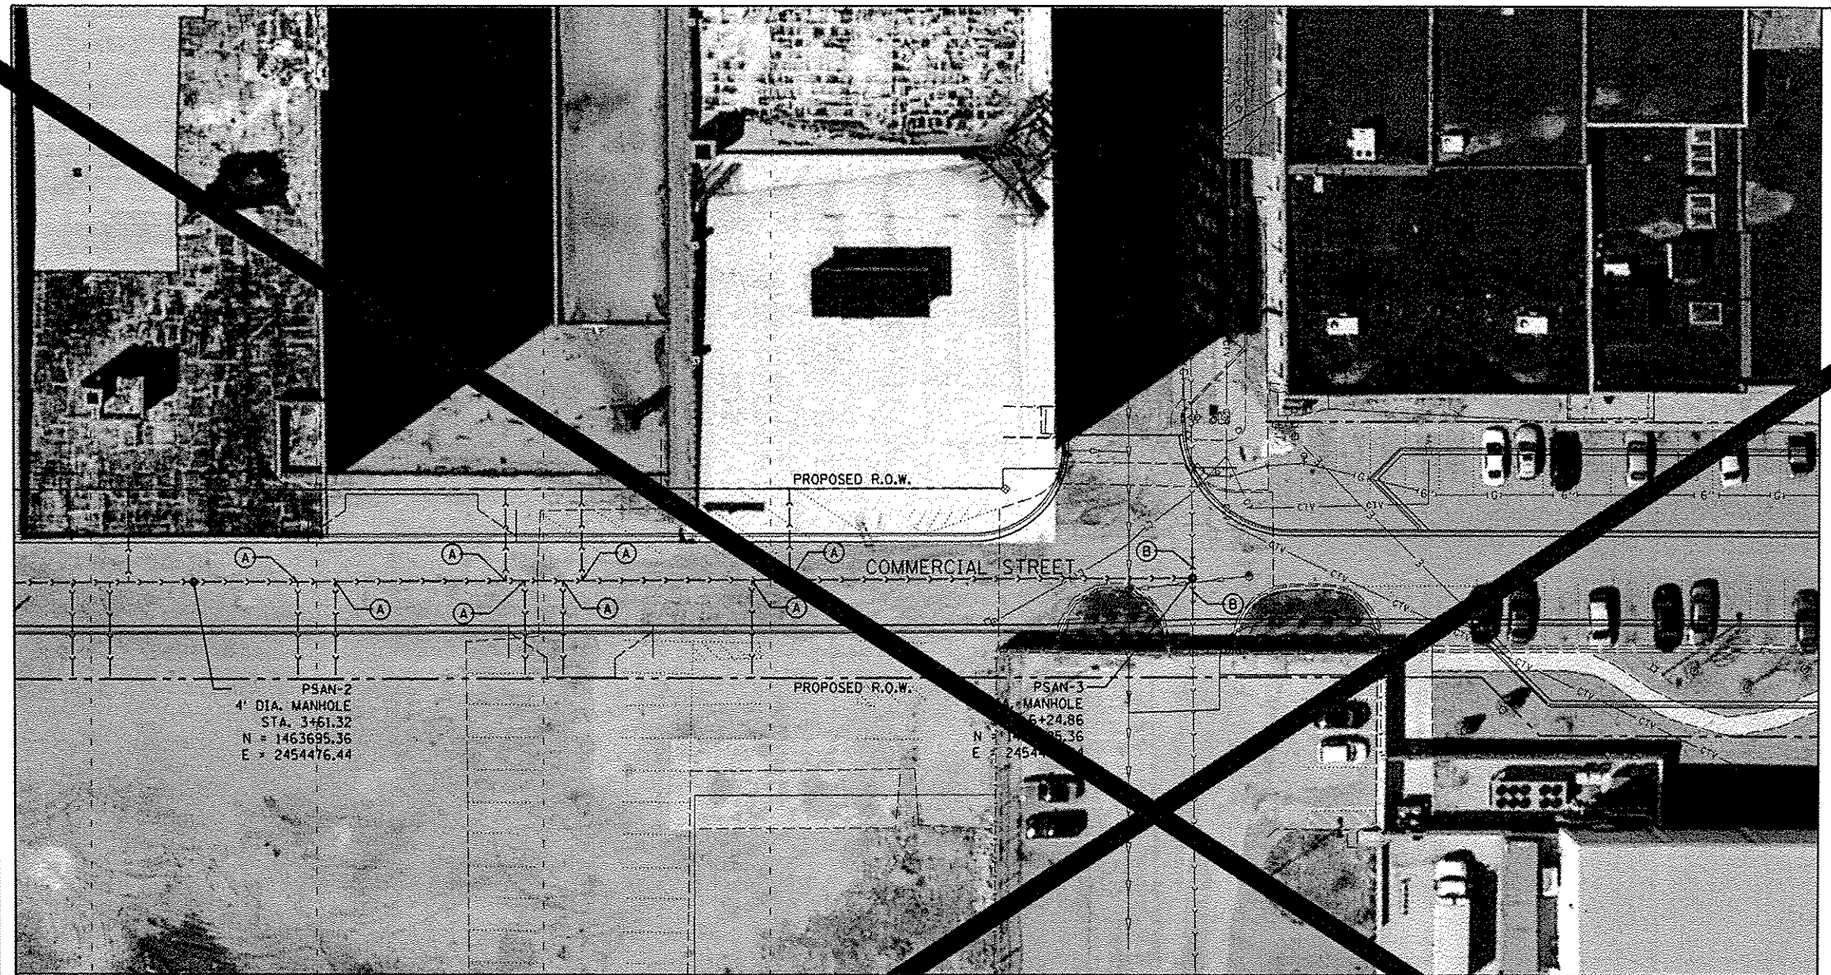

REPAIR DESCRIPTIONS

REPAIR 3746 - CONSTRUCT A NEW MANHOLE AT [illegible] 3+61.32. CONSTRUCT A NEW 8" SANITARY SEWER FROM [illegible] 3+61.32 TO 6+22.64. INCLUDE SEWER SERVICE CONNECT[illegible] CAPPED AT R.O.W. LINE FOR FUTURE CONNECTION [illegible]ATIONS 3+88.99, 3+98.99, 4+43.92, 4+48.92, 4+53.92, [illegible]08.86, AND 5+18.86. CONSTRUCT A NEW MANHOLE ON [illegible]TING 8" PVC SEWER AT STA. 6+22.64. REMOVE A[illegible]PLACE 5' OF EXISTING 8" PVC WITH 8" PVC, SD[illegible] EXTENDING TO THE NORTHWEST AND SOUT[illegible] AND CONNECT TO THE EXISTING SEWER USING SO[illegible]EEVE COUPLERS.

SANITARY SCHEDULE

LOCATION	59300100 CONTROLLED LOW-STRENGTH MATERIAL	60218400 MANHOLES, TYPE A, SANITARY, 4'-DIAMETER, TYPE 1 FRAME, CLOSED LID	X0840000 SANITARY SEWER REMOVAL 8"	XX007503 SANITARY SEWER SERVICE (OPEN CUT), 6"PVC	Z0056900 SANITARY SEWER 8"
REPAIR 3746	328	2	15	200	268
TOTAL	328	2	15	200	268

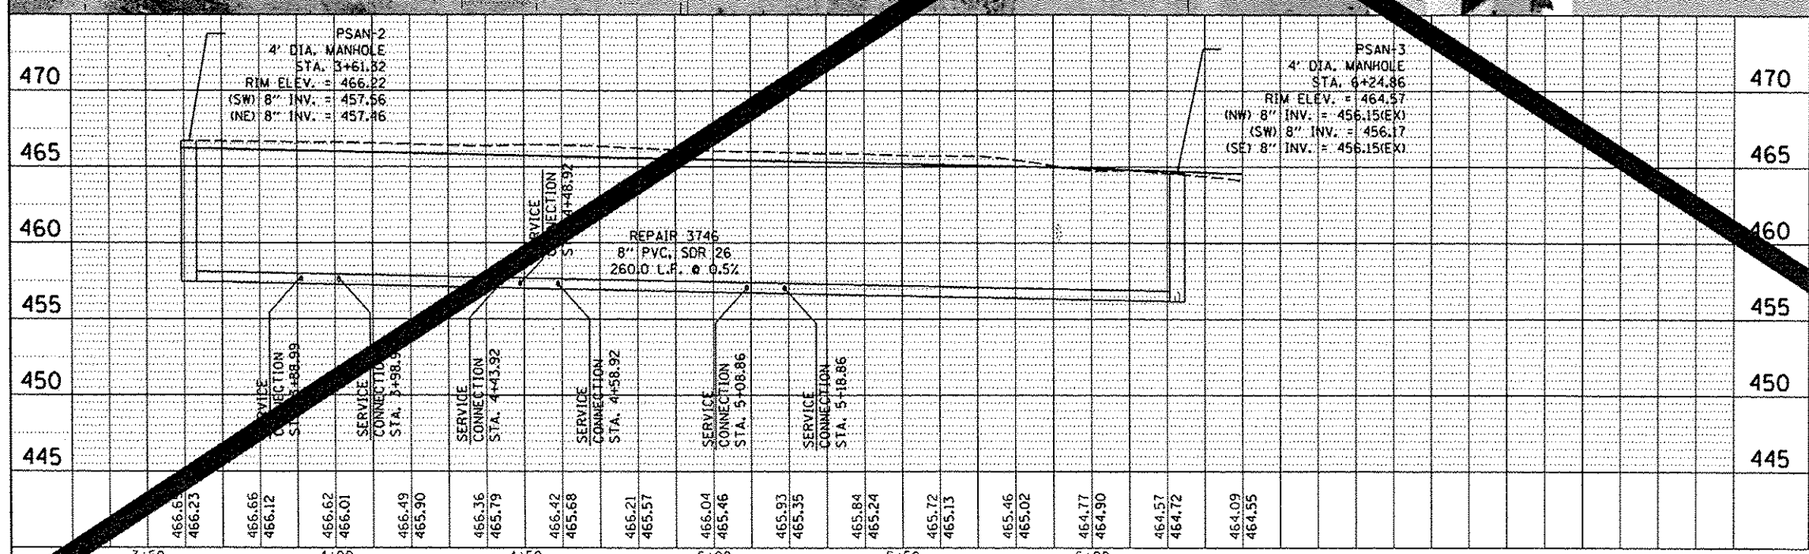

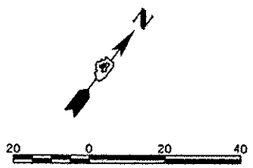

REPAIR KEYNOTES

(A) CONSTRUCT NEW SERVICE AND CAP AT R.O.W. LINE

(B) [illegible]NSTALL 5' OF 8" PVC, SDR 26, SANITARY SEWER [illegible] CONNECT TO EXISTING PIPE USING A SOLID SL[illegible] COUPLER.

HANSON

FILE NAME = [illegible]phase_work\do_not_delete\dms73300\D410[illegible]0155-sht-san006.dgn	USER NAME = kovan01511	DESIGNED - PWM	REVISED -
		DRAWN - RLA	REVISED -
	PLOT SCALE = 39.9999 ' / in.	CHECKED - CAL	REVISED -
	PLOT DATE = 07\23\2012	DATE - 7/18/12	REVISED -

STATE OF ILLINOIS
DEPARTMENT OF TRANSPORTATION

COMMERCIAL STREET
SANITARY SEWER PLANS

SCALE: 1"=20' | SHEET NO. OF SHEETS | STA. TO STA.

F.A.U RTE.	SECTION	COUNTY	TOTAL SHEETS	SHEET NO.
[illegible]	12-00356-01-PV	PEORIA [illegible]	519	215
		CONTRACT [illegible]626		
		ILLINOIS FED. AID PROJECT TIG-509[illegible]		

PLAN — SURVEYED / PLOTTED / ALIGNMENT CHECKED / DRAWN / PLAN CHECKED / CADD FILE NAME / NOTE BOOK / NO. / BY / DATE

PROFILE — SURVEYED / PLOTTED / GRADES CHECKED / B.M. NOTED / STRUCTURE NOTATION CHKD / NOTE BOOK / NO. / BY / DATE